





BM. HYD 178378  
N.E. FL. BOLT

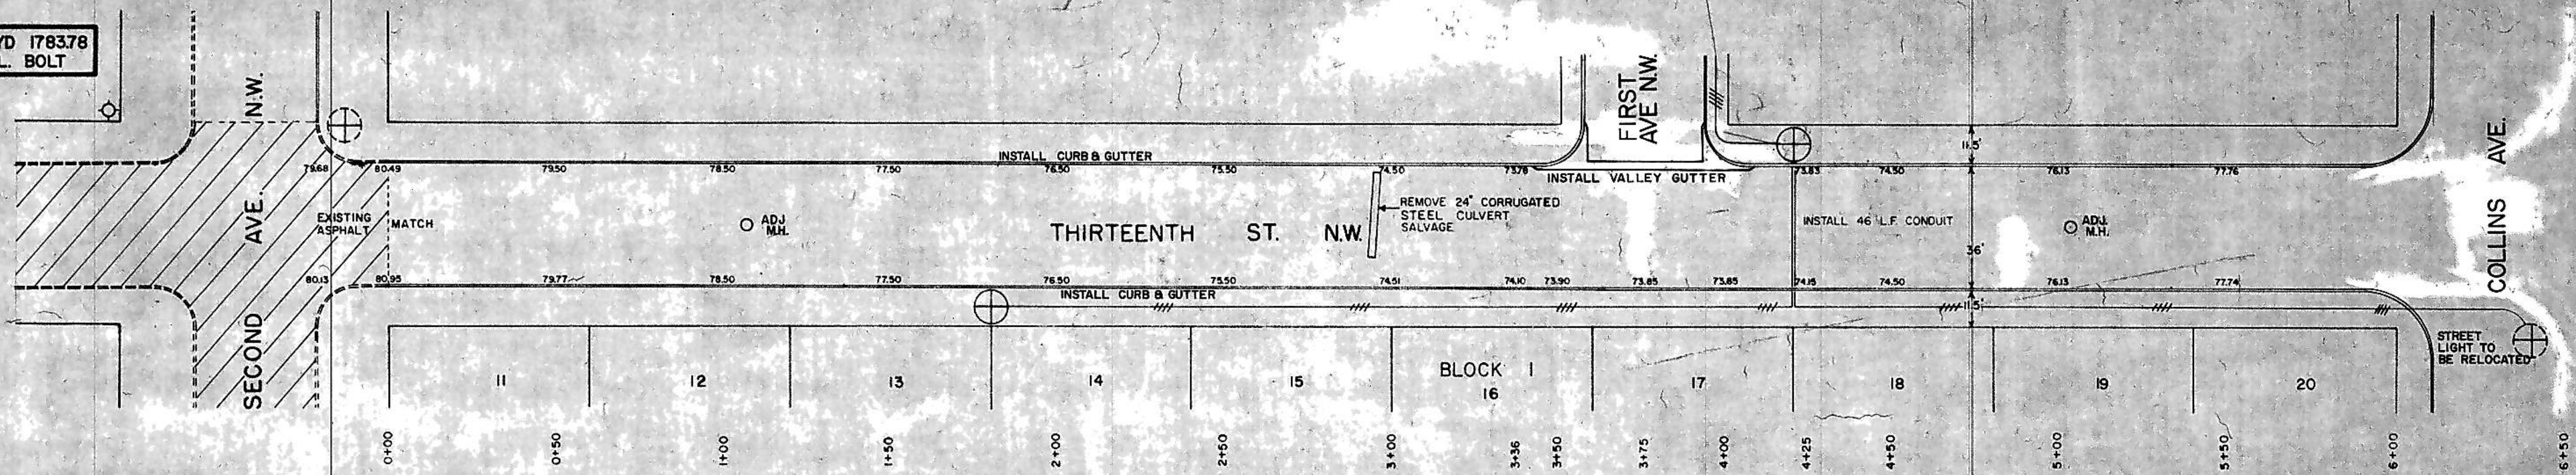

- ⊕ STREET LIGHT TO BE INSTALLED
- ⊙ EXISTING STREET LIGHT

SCALE: HORZ. 1" = 30'  
VERT. 1" = 2'

PLAN	SURVEYED	DATE
	NOTED	
	PLotted	
	Checked	
	RT. OF WAY CHECKED	
	NO.	

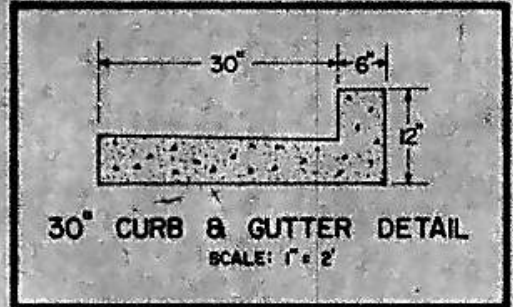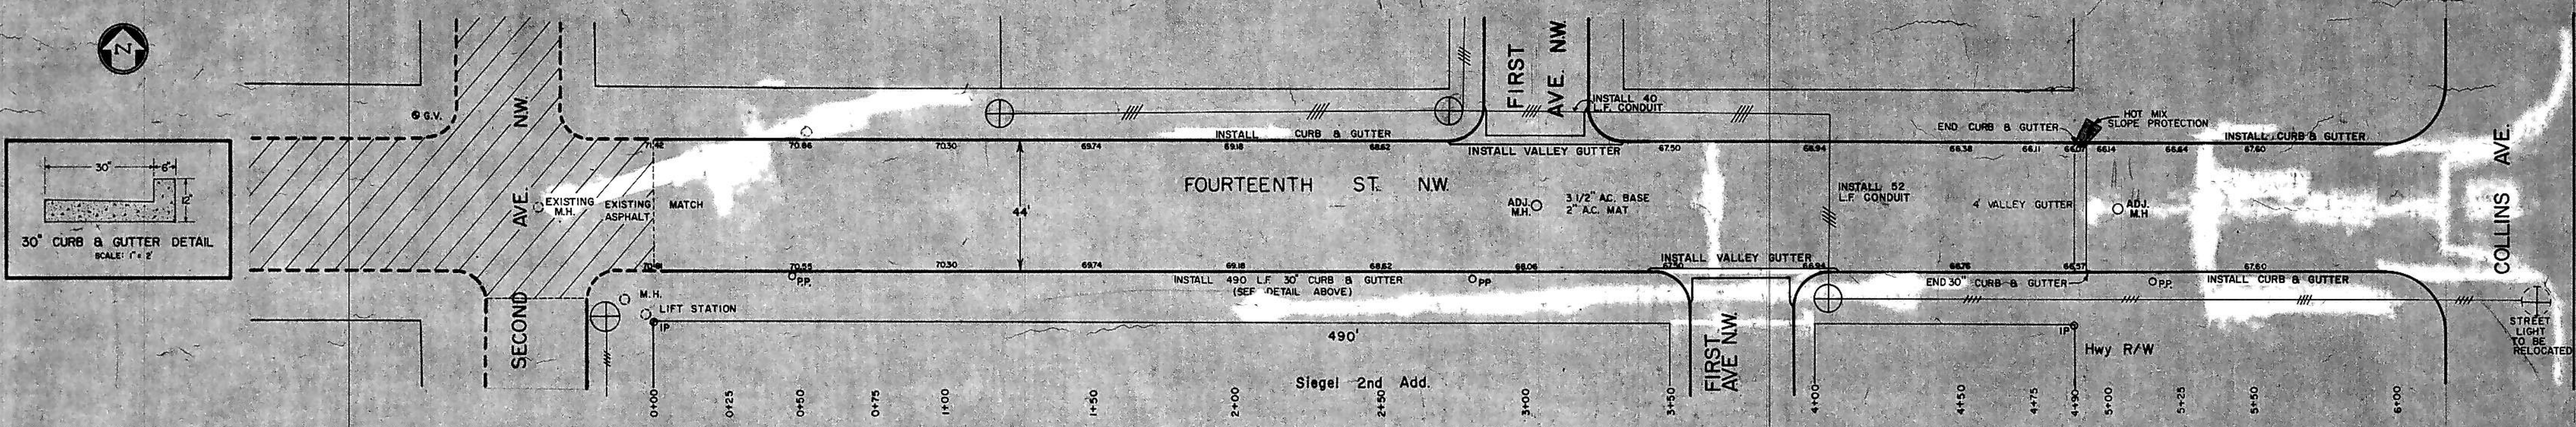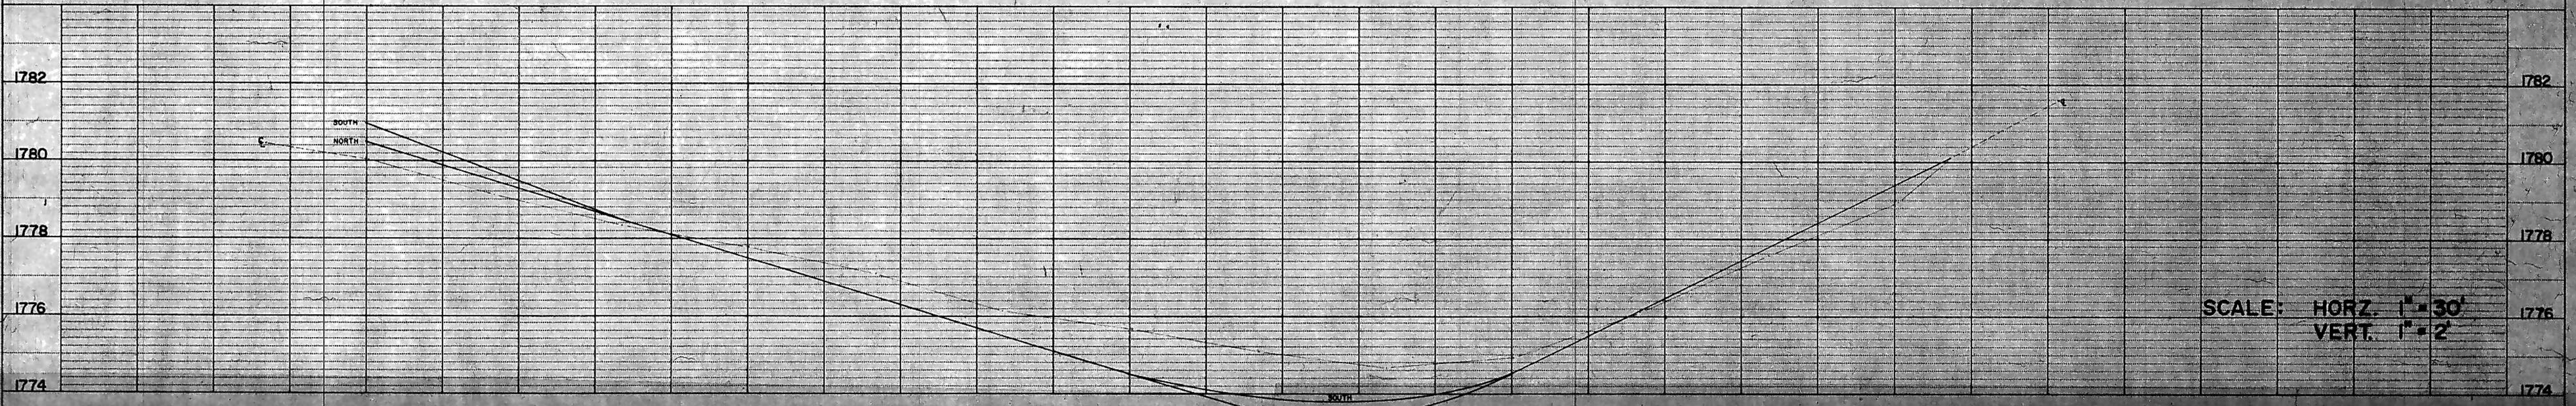

SCALE: HORZ. 1" = 30'  
VERT. 1" = 2'

SHEET NO. 3 OF 16 SHEETS

PLAN	SURVEYED	DATE
	NOTED	
	PLotted	
	Checked	
	RT. OF WAY CHECKED	
	NO.	

