



PLAN
 SURVEYED _____
 NOTE BOOK _____
 ALIGNMENT CHECKED _____
 RT. OF WAY CHECKED _____
 NO. _____

PROFILE
 SURVEYED _____
 PLOTTED _____
 GRADES CHECKED _____
 STRUCTURE NOTATION _____
 NO. _____

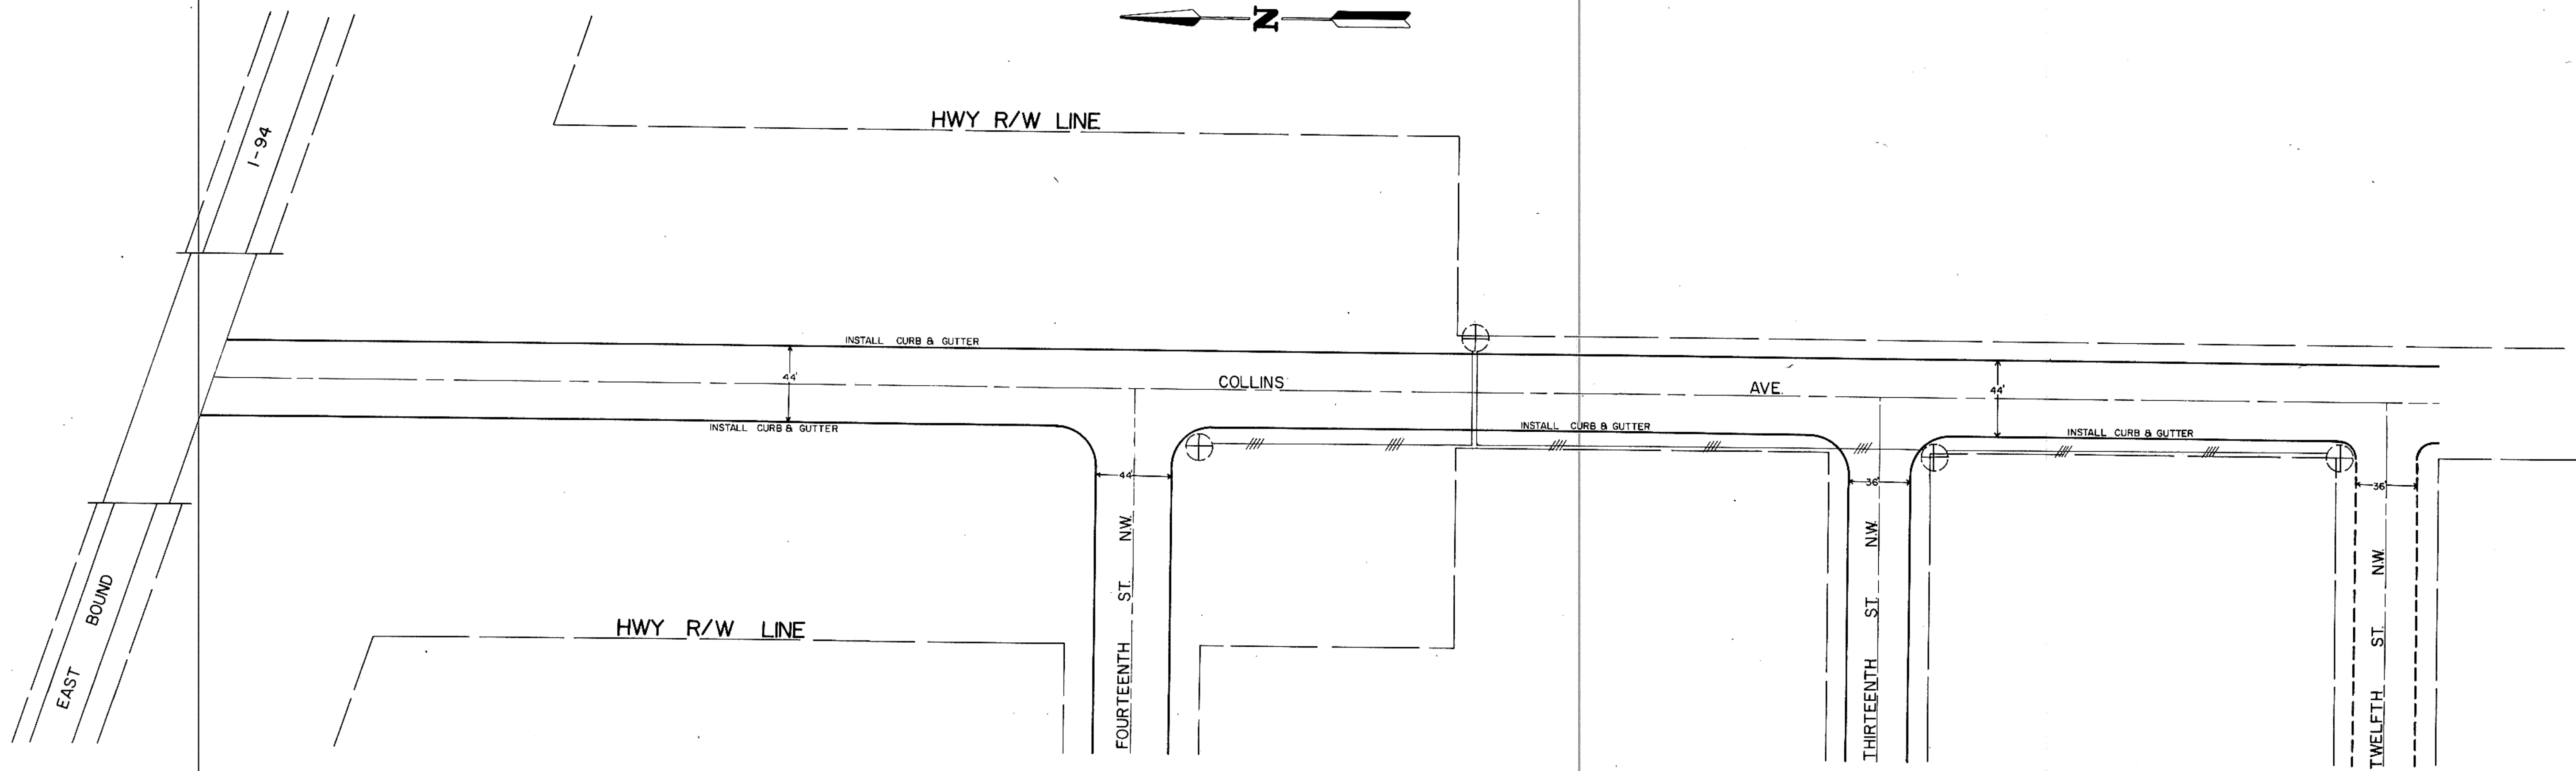

NOTE: COLLINS AVE. TO HAVE 3 1/2" BASE AND 2" MAT

D E L E T E D

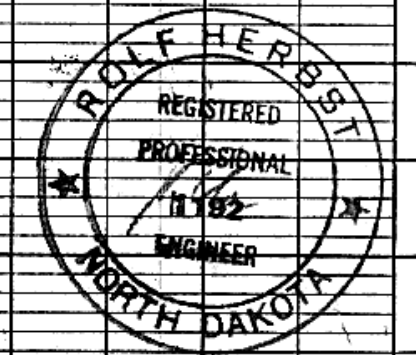

SCALE
 HORZ. 1"=50'