

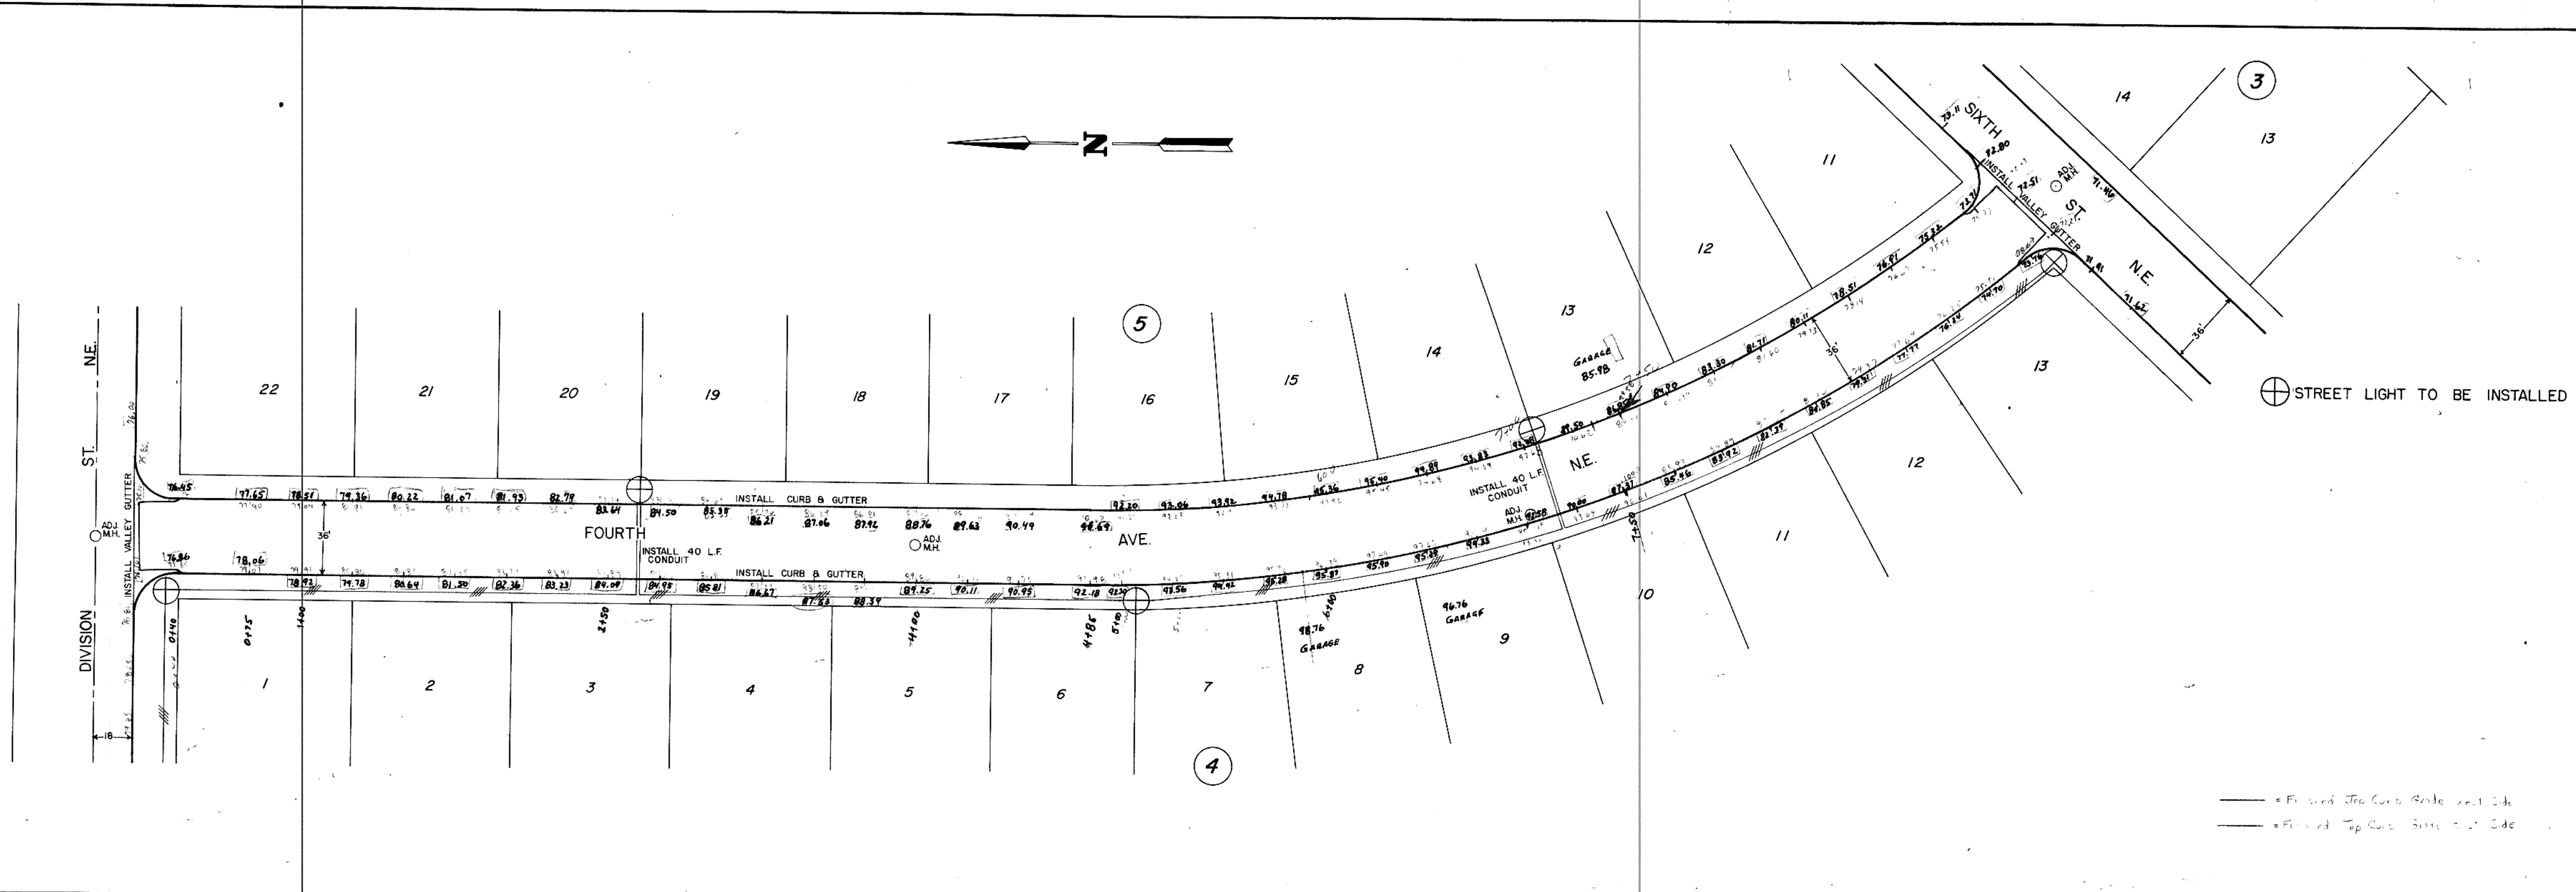


PLAN
 SURVEYED _____
 PLOTTED _____
 NOTE BOOK _____
 NO. _____
 BY _____
 DATE _____
 PLANNING CHECKED _____
 RT. OF WAY CHECKED _____

PROFILE
 SURVEYED _____
 PLOTTED _____
 GRADES CHECKED _____
 NO. _____
 BY _____
 DATE _____
 STATIONING/VERTICALS CHECKED _____

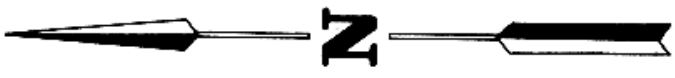

— = Finish Top Curb Grade next Side
 — = Finish Top Curb Street Side

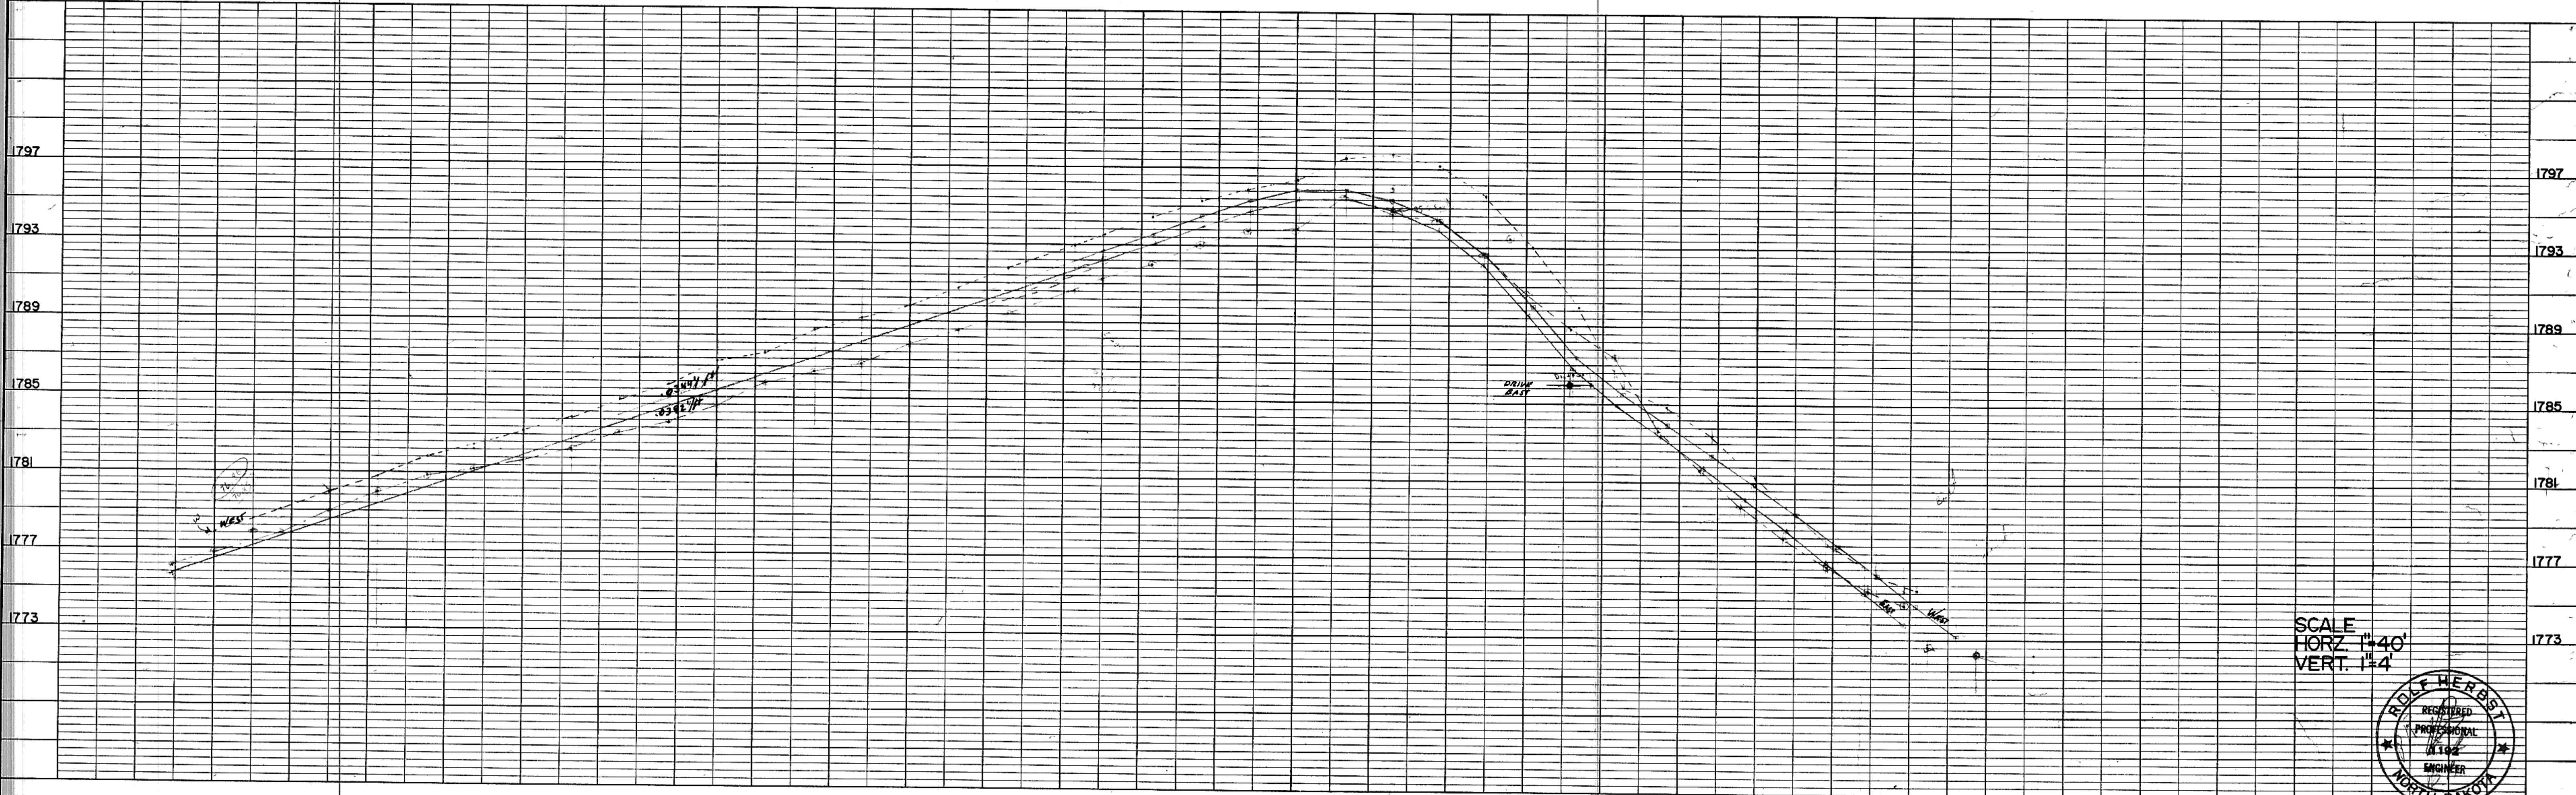

SCALE
 HORZ. 1"=40'
 VERT. 1"=4'

