




1686.61 TBM ON N, S.W. CORNER
DRIVEWAY IN ALLEY BY HOUSE
AT 207-12th AVE. N.E.

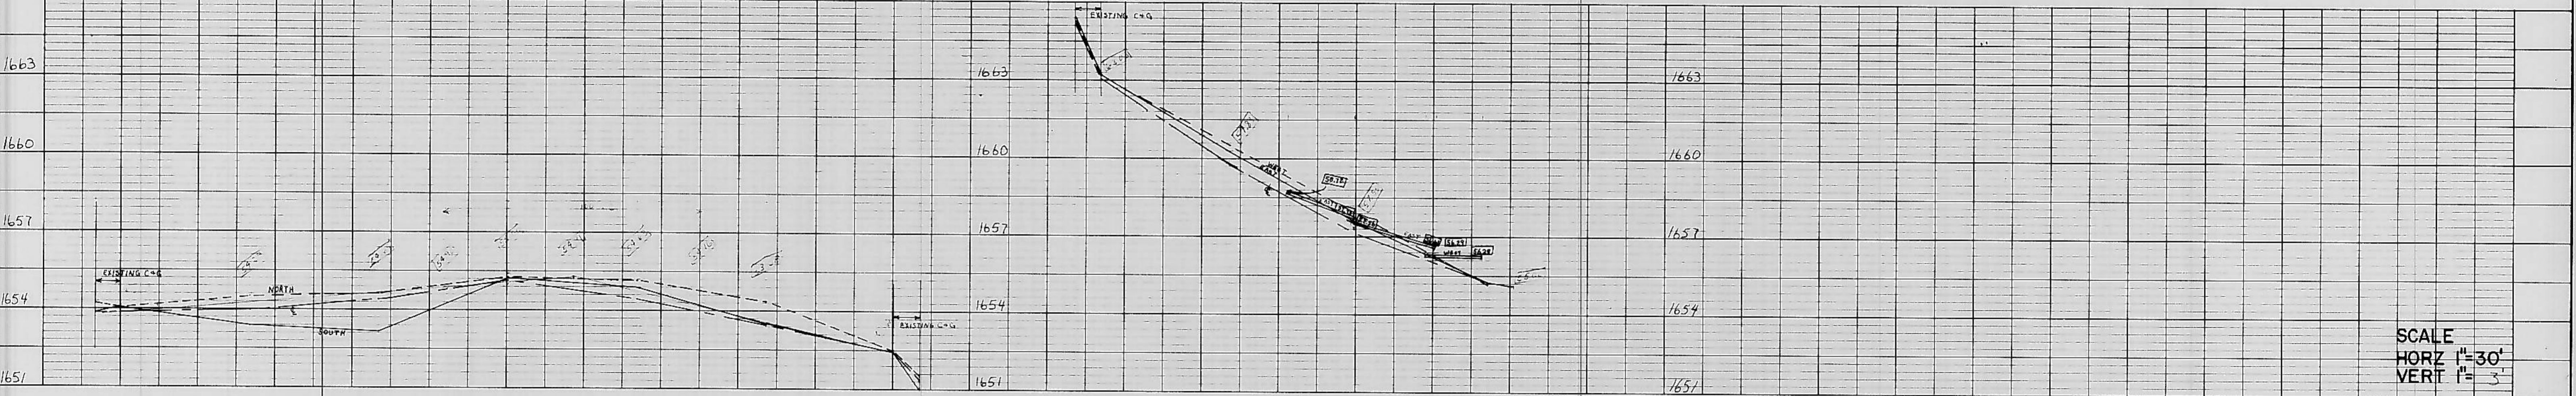

SCALE
HORZ 1"=30'
VERT 1"=5'

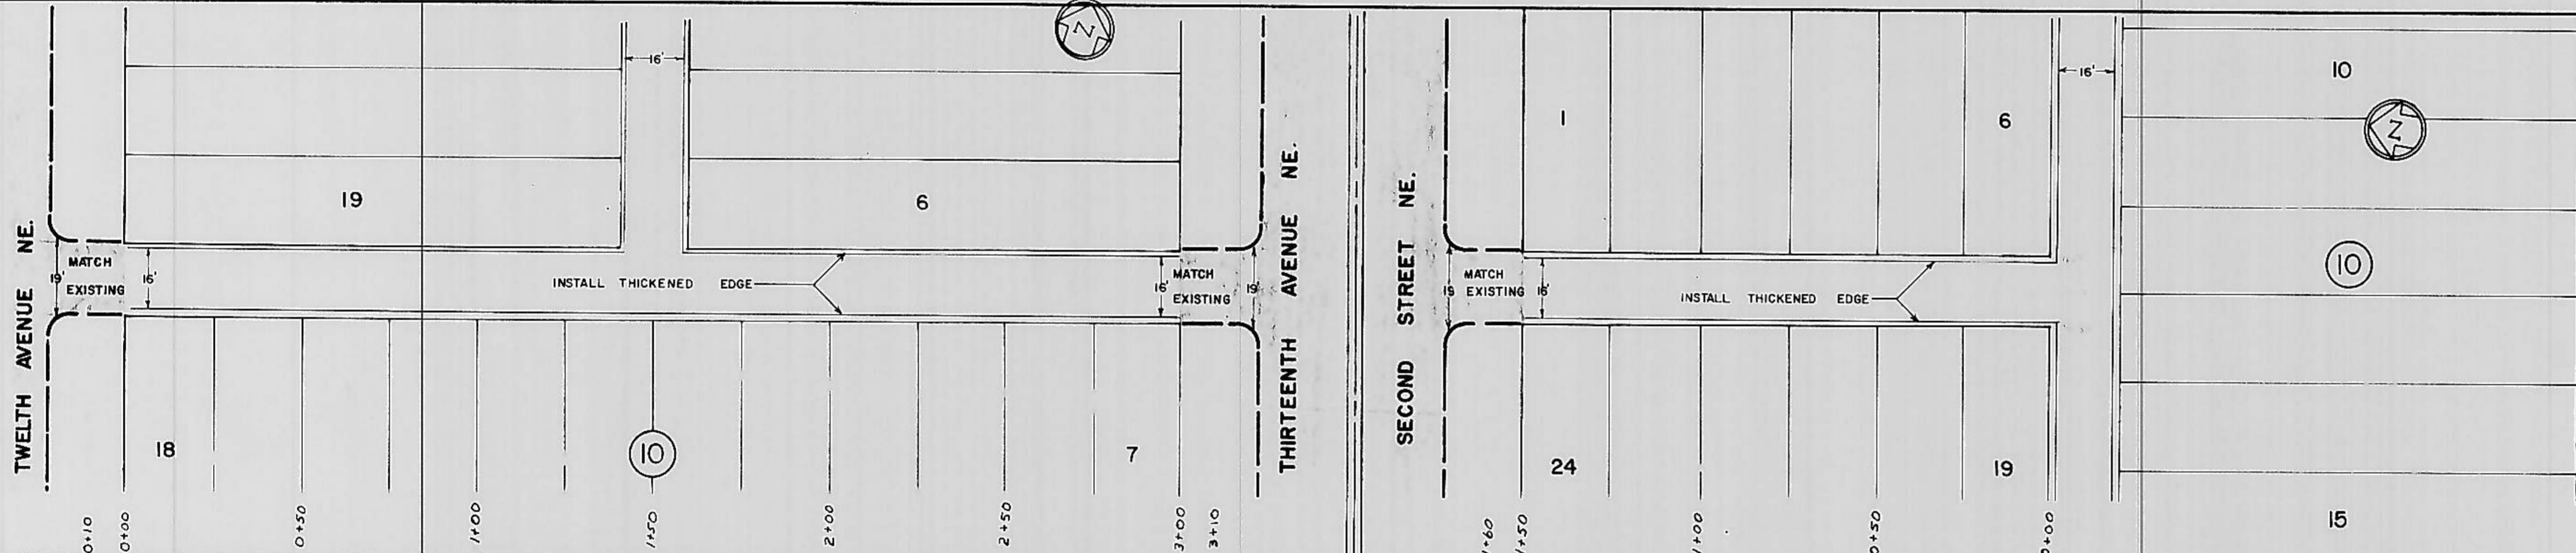

1647.95 TBM, PAINT SPOT TOP RETAINING
WALL BY NORTH E. OF ALLEY BY
HOUSE AT 206-12th AVE. N.E.

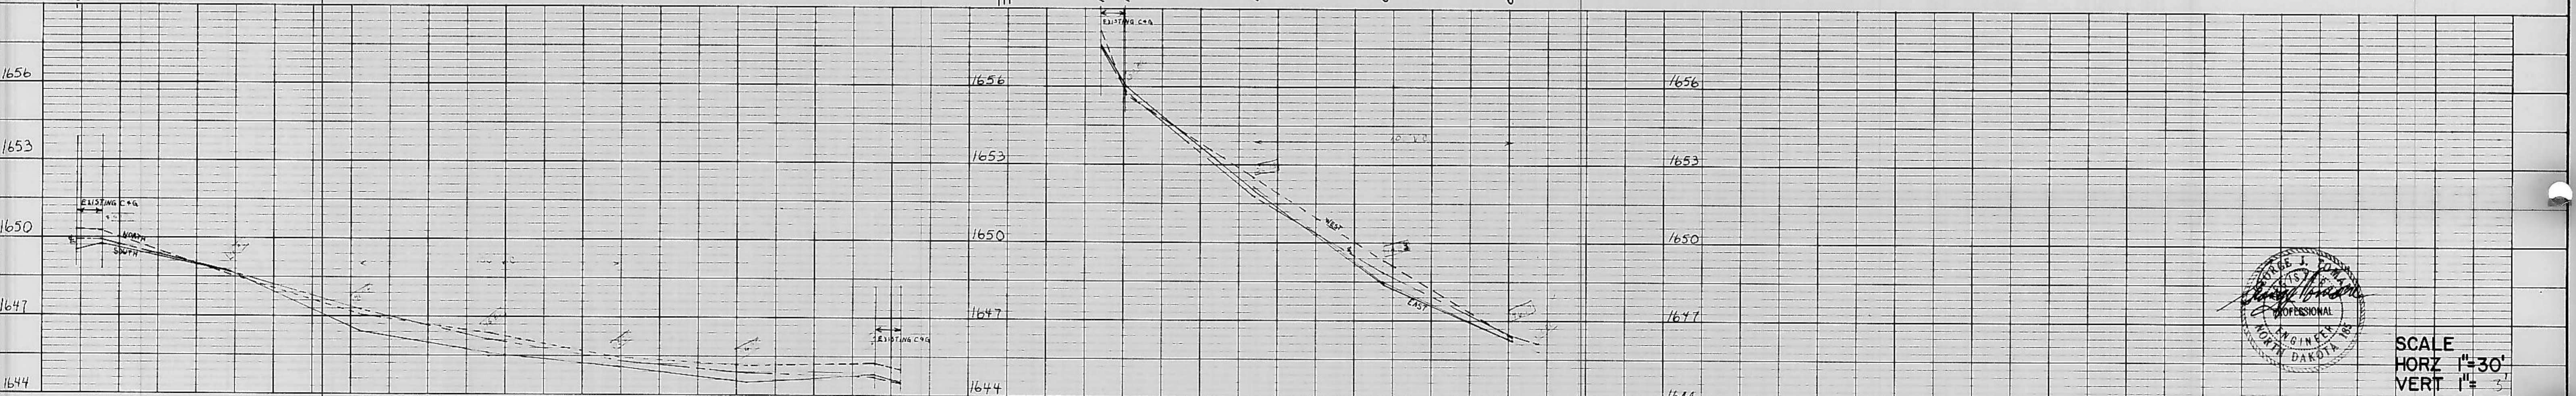

SCALE
HORZ 1"=30'
VERT 1"=5'