

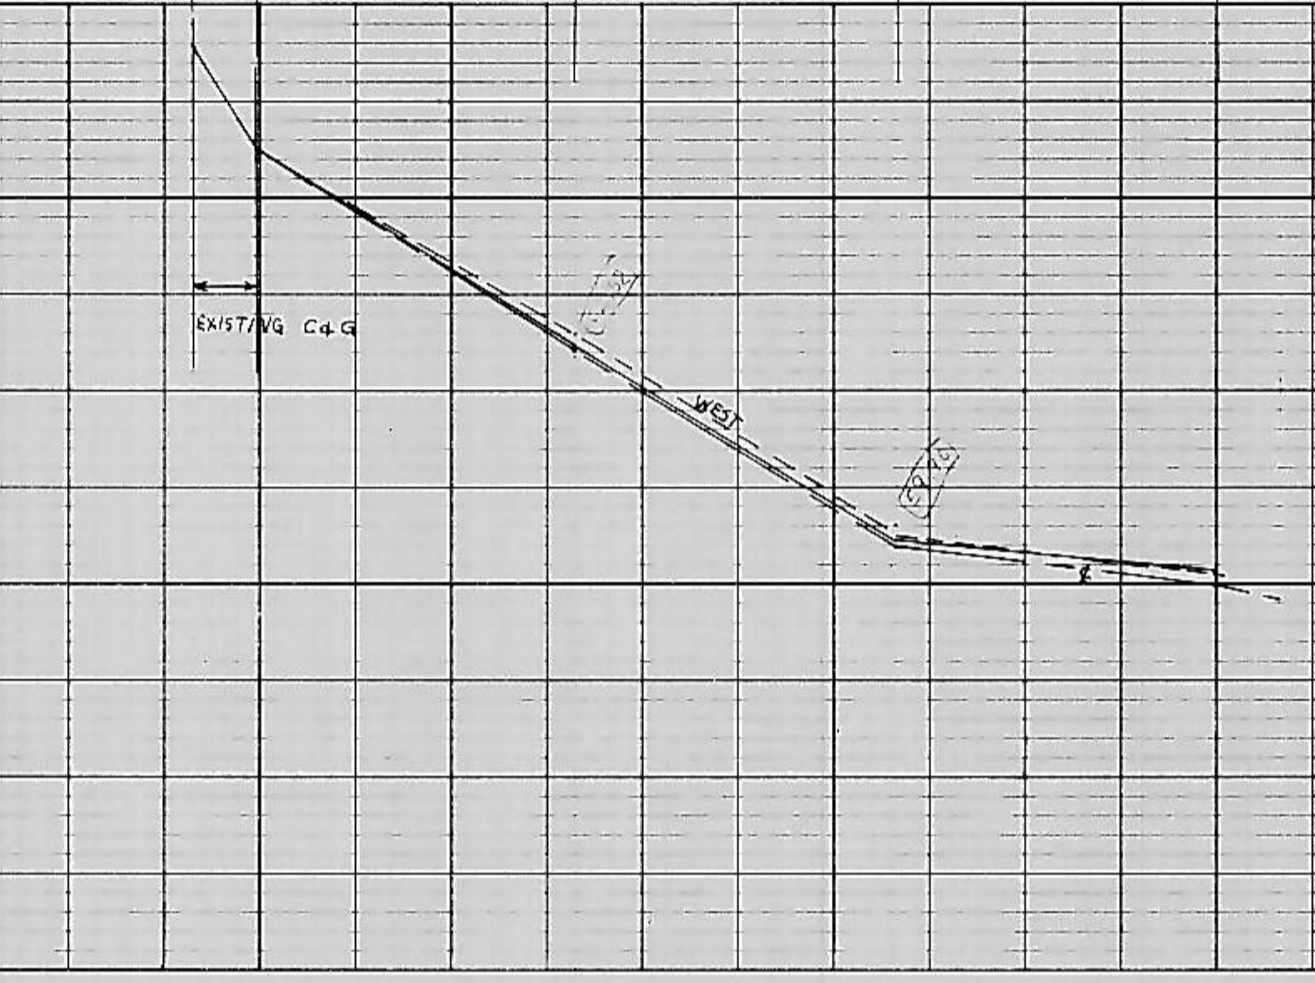
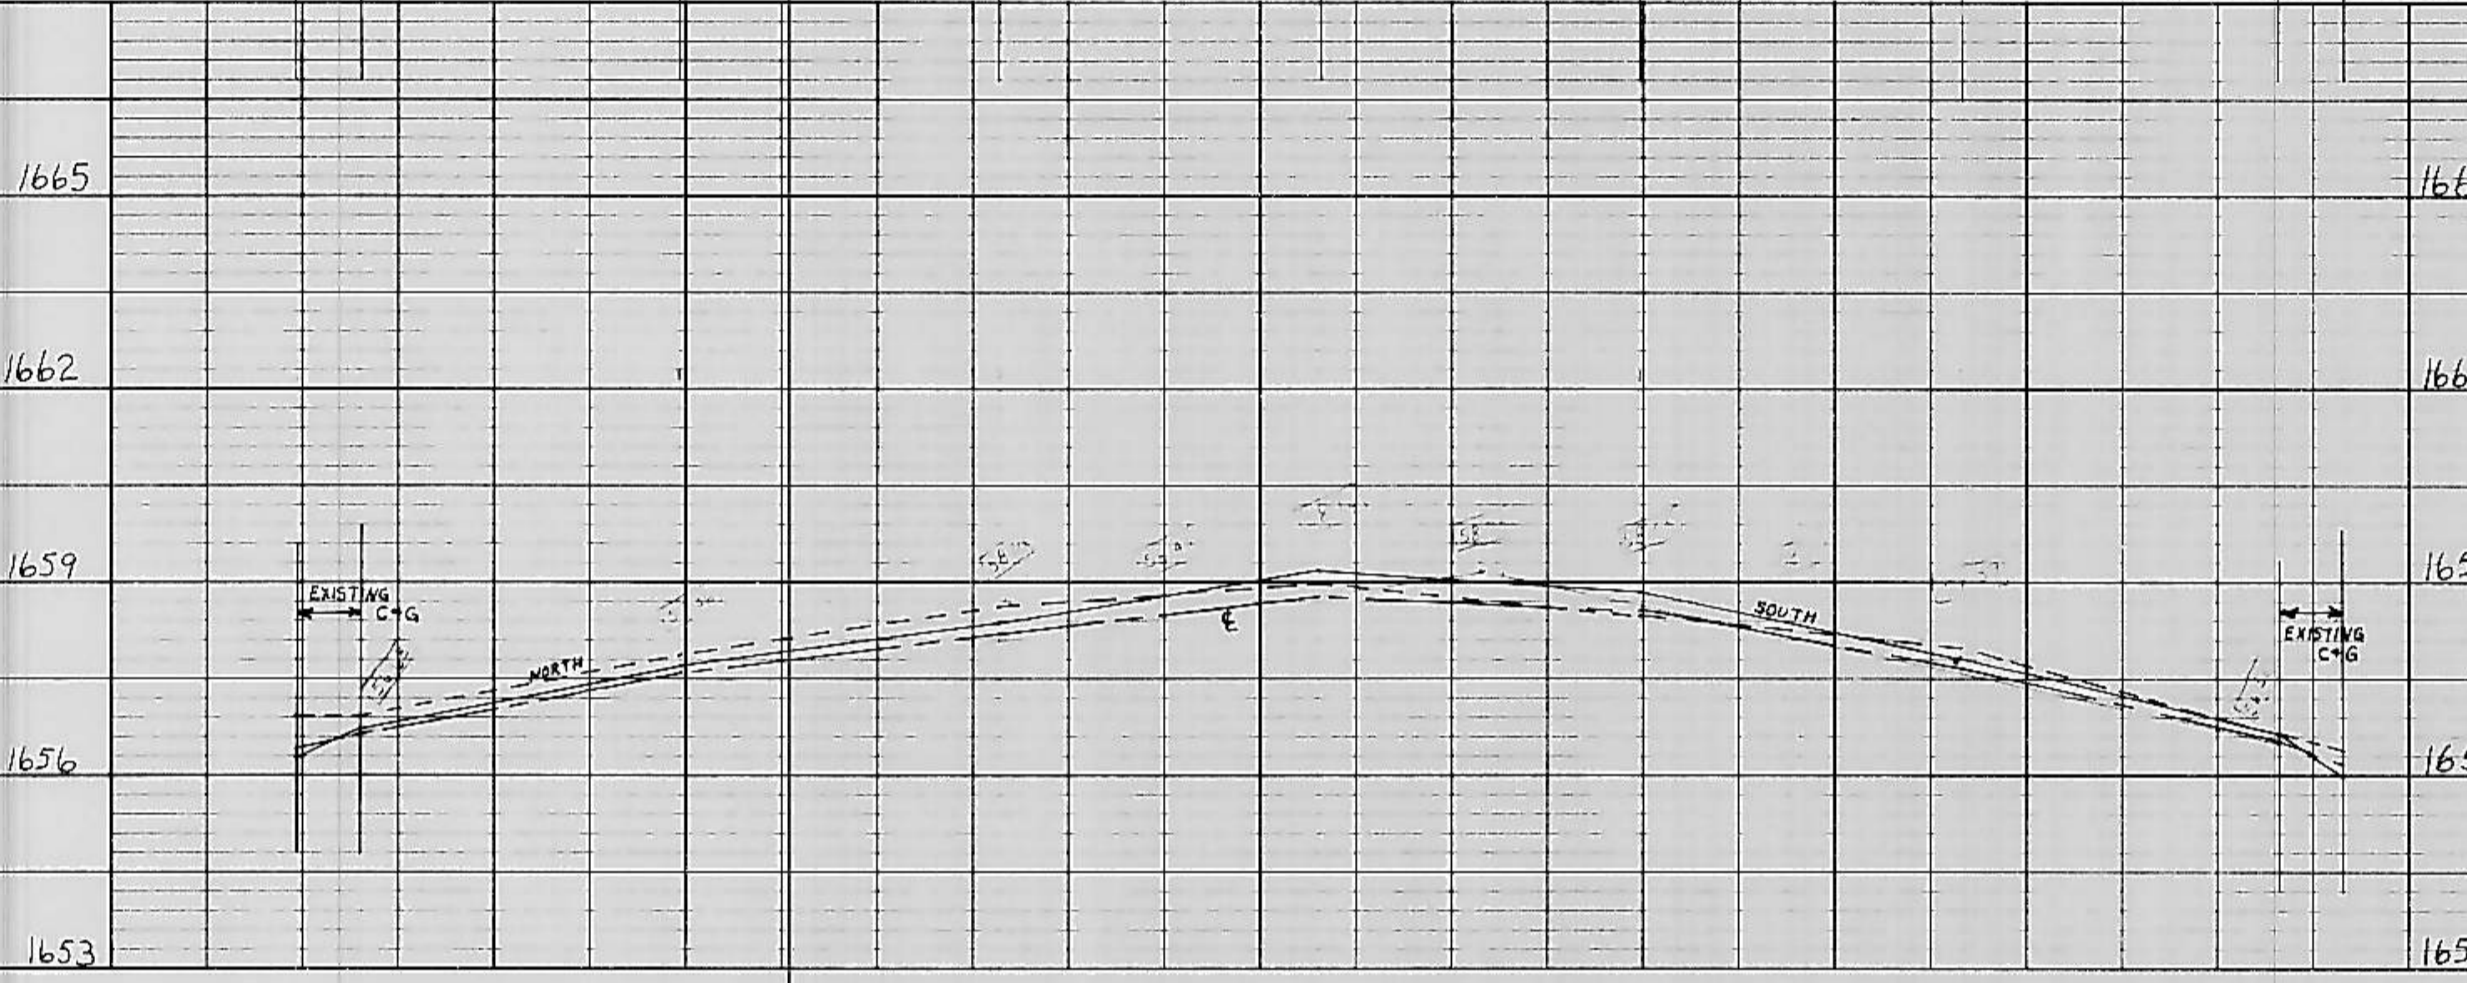
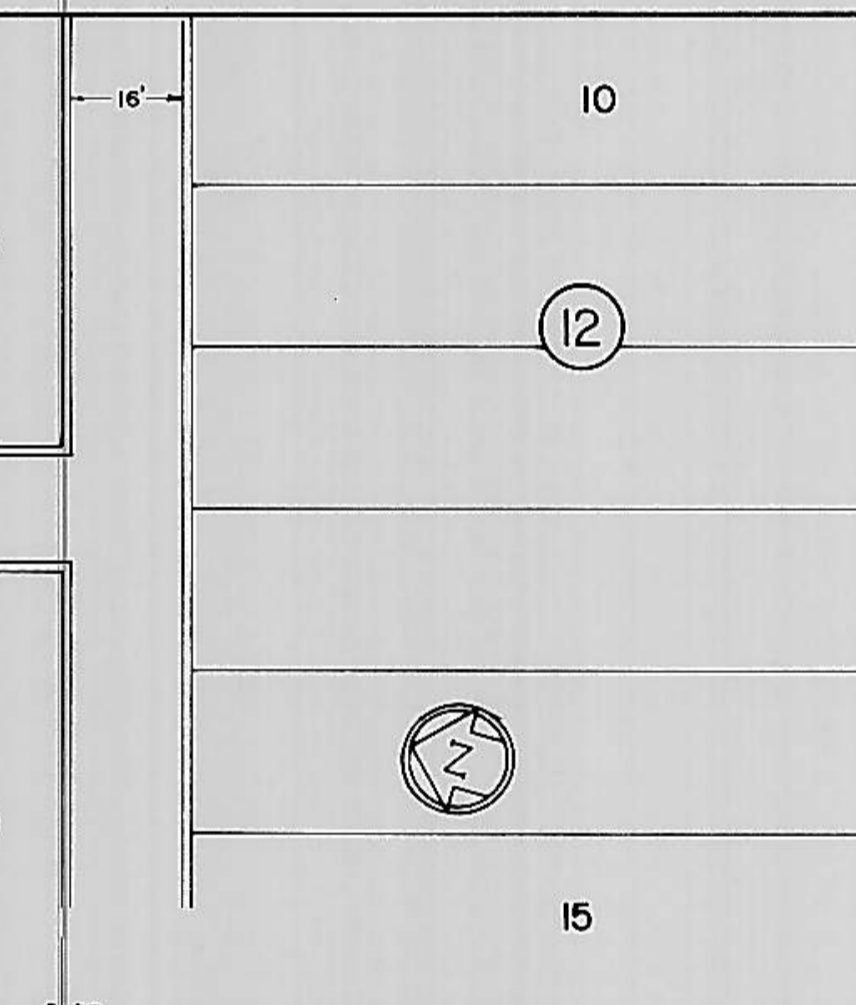


1659.61 TBM ON M, TOP RETAINING WALL
BY NORTH E OF ALLEY BY
HOUSE 207-10th AVE. N.E.

FIRST STREET NE.


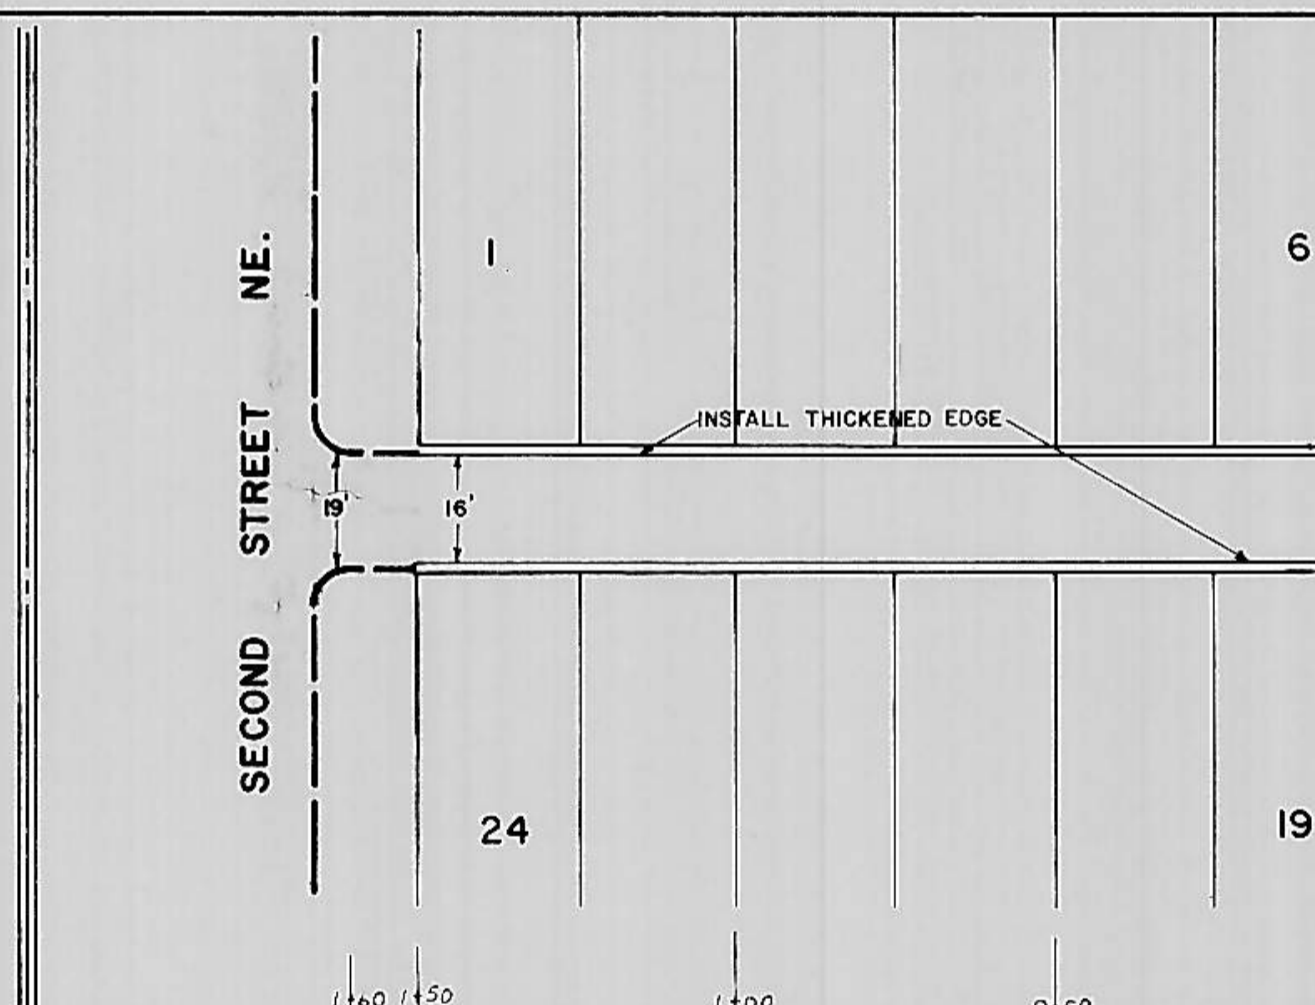


SCALE
HORZ 1"=30'
VERT 1"=1'

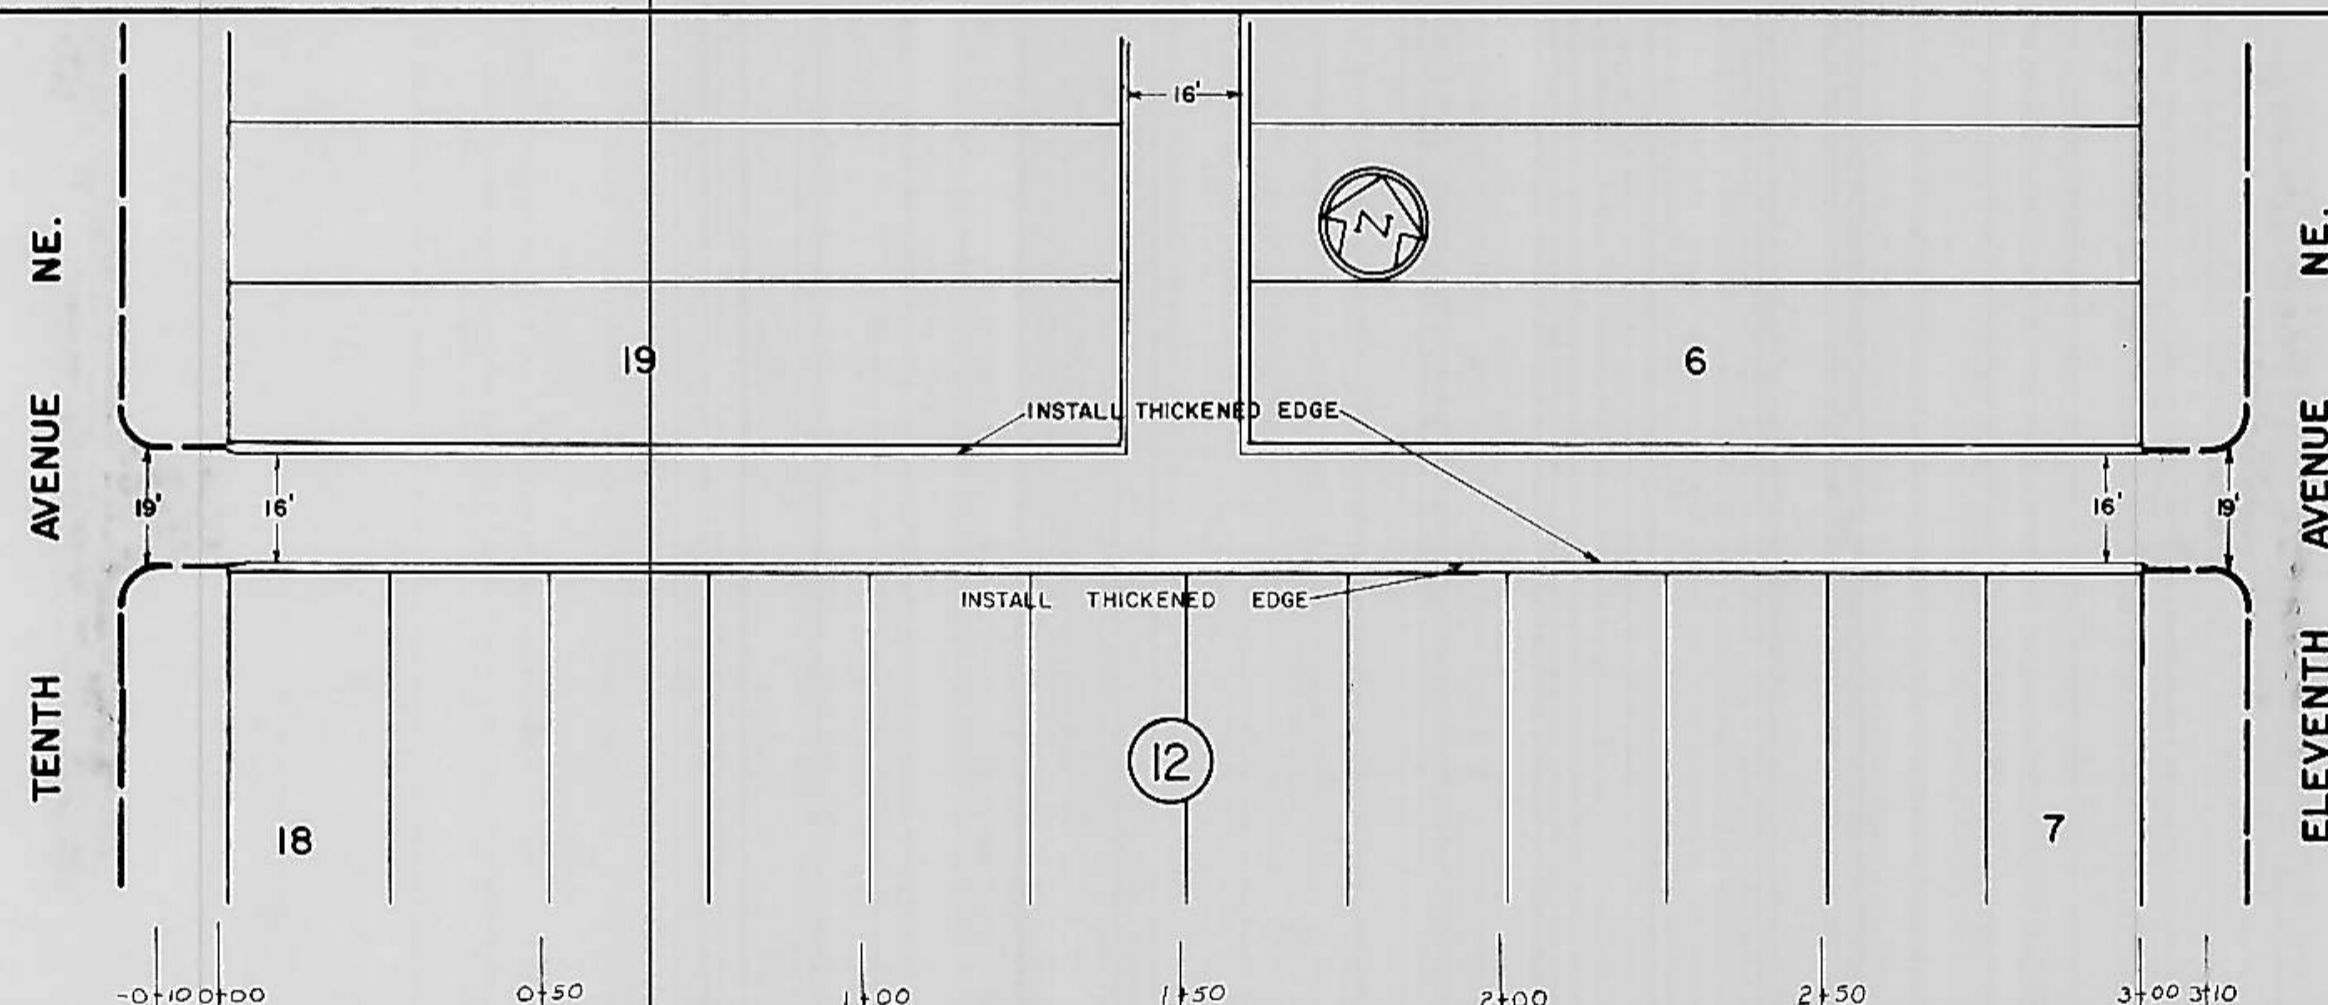

1657.64 TBM ON M, TOP RETAINING WALL
BY NORTH E OF ALLEY BY
HOUSE 204-10th AVE. N.E.

FIRST STREET NE.

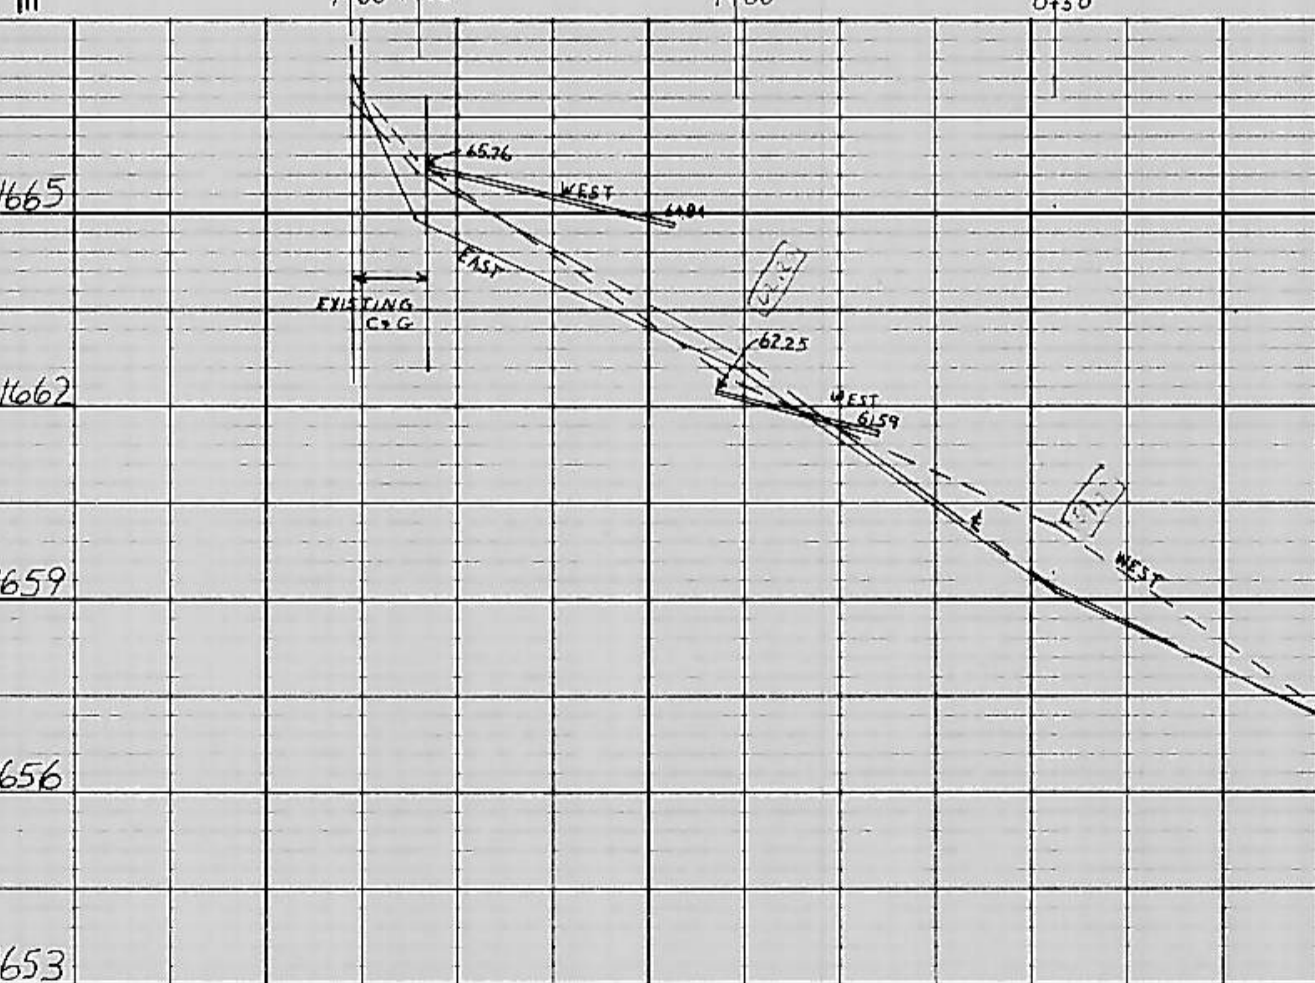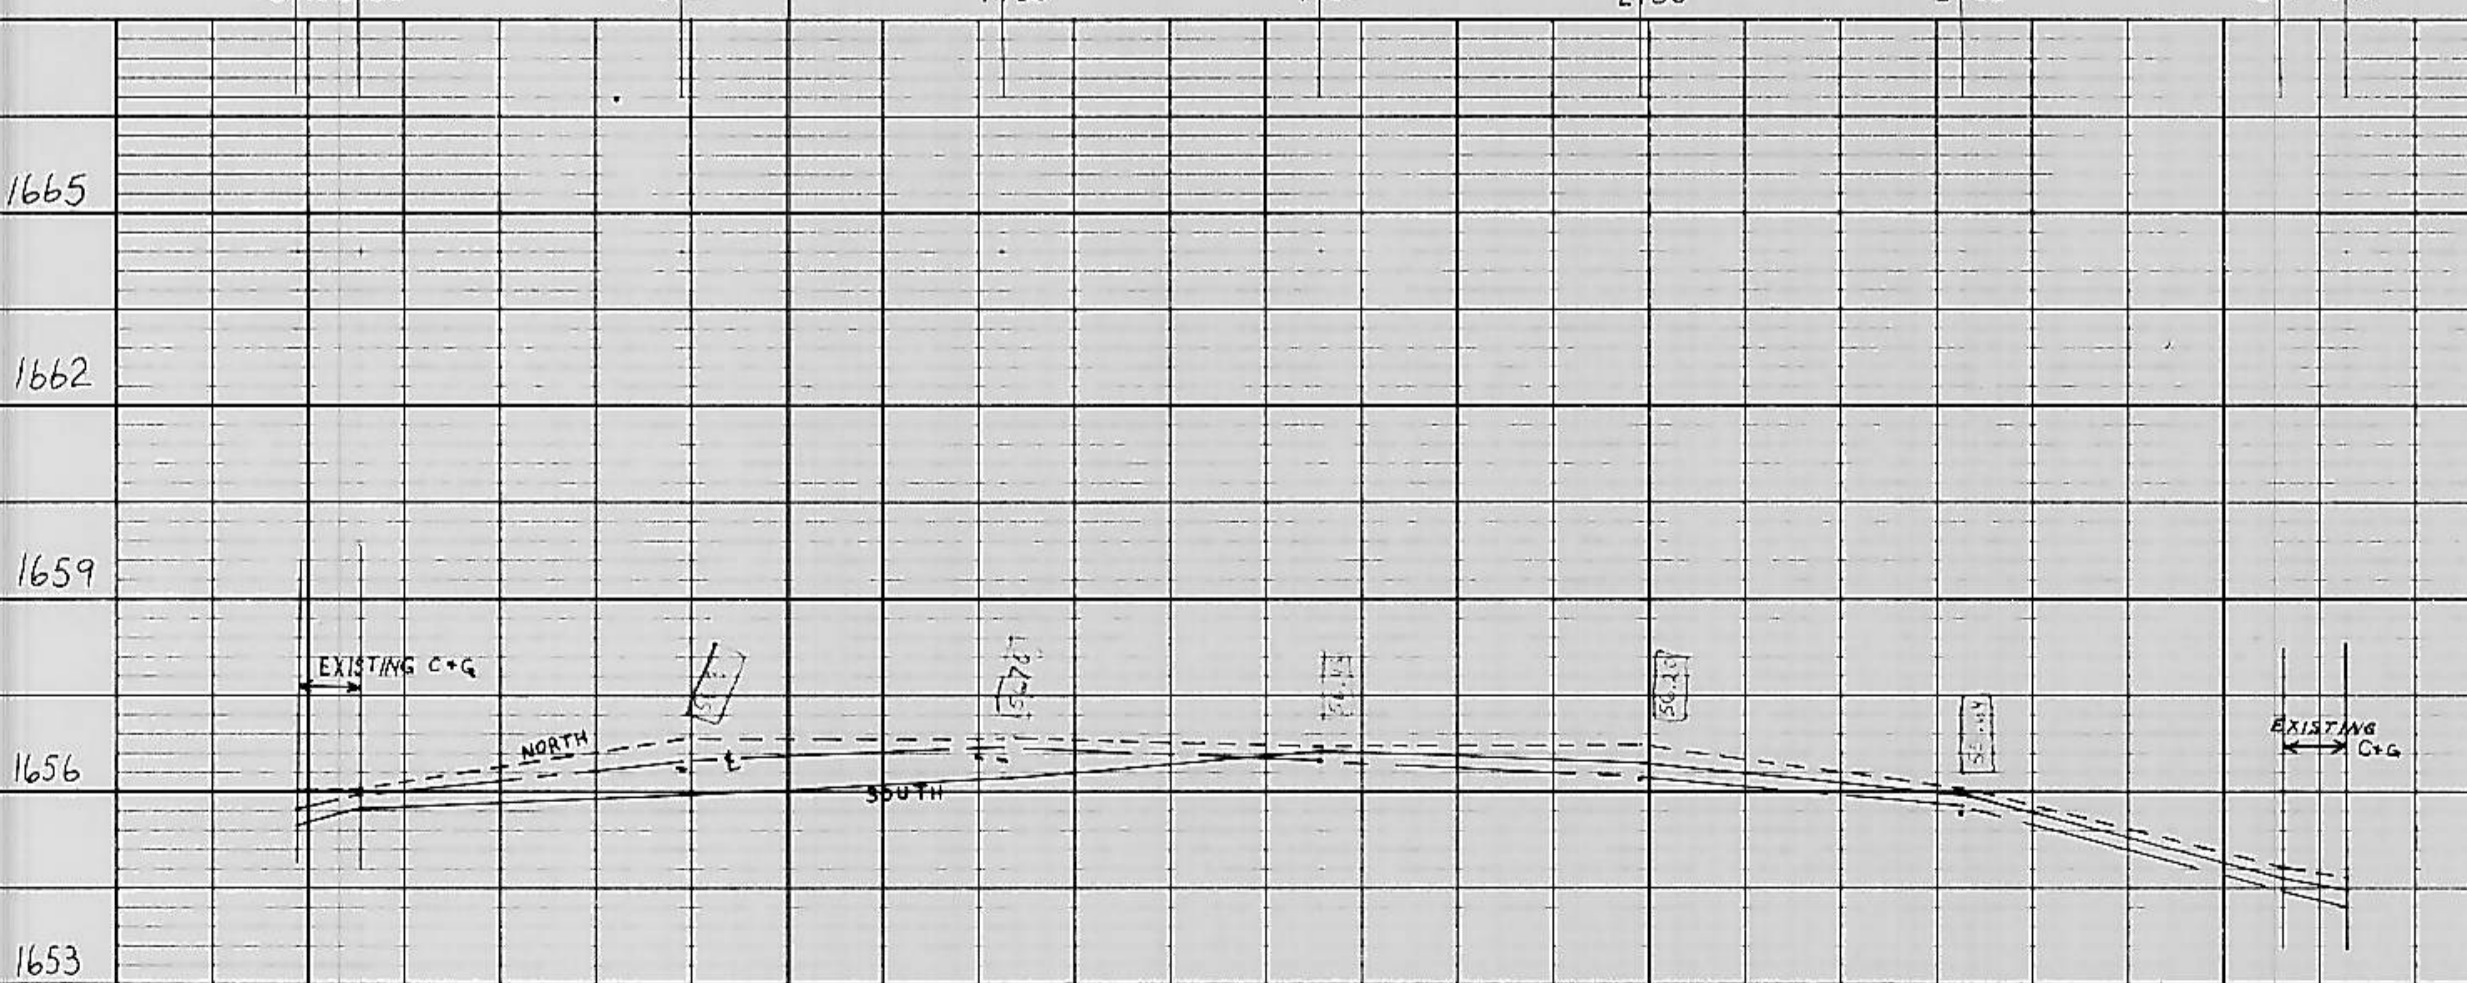

SCALE
HORZ 1"=30'
VERT 1"=1'

