


PLAN
 SURVIVAL
 PHOTO
 NOTE BOOK
 GRADES CHECKED
 ALIGNMENT CHECKED
 FIT OF WAY CHECKED
 No.


PROFILE
 SURVIVAL
 PHOTO
 NOTE BOOK
 GRADES CHECKED
 ALIGNMENT CHECKED
 FIT OF WAY CHECKED
 No.

LEXINGTON


Note: Street Width Shown is
 back to back of Curb

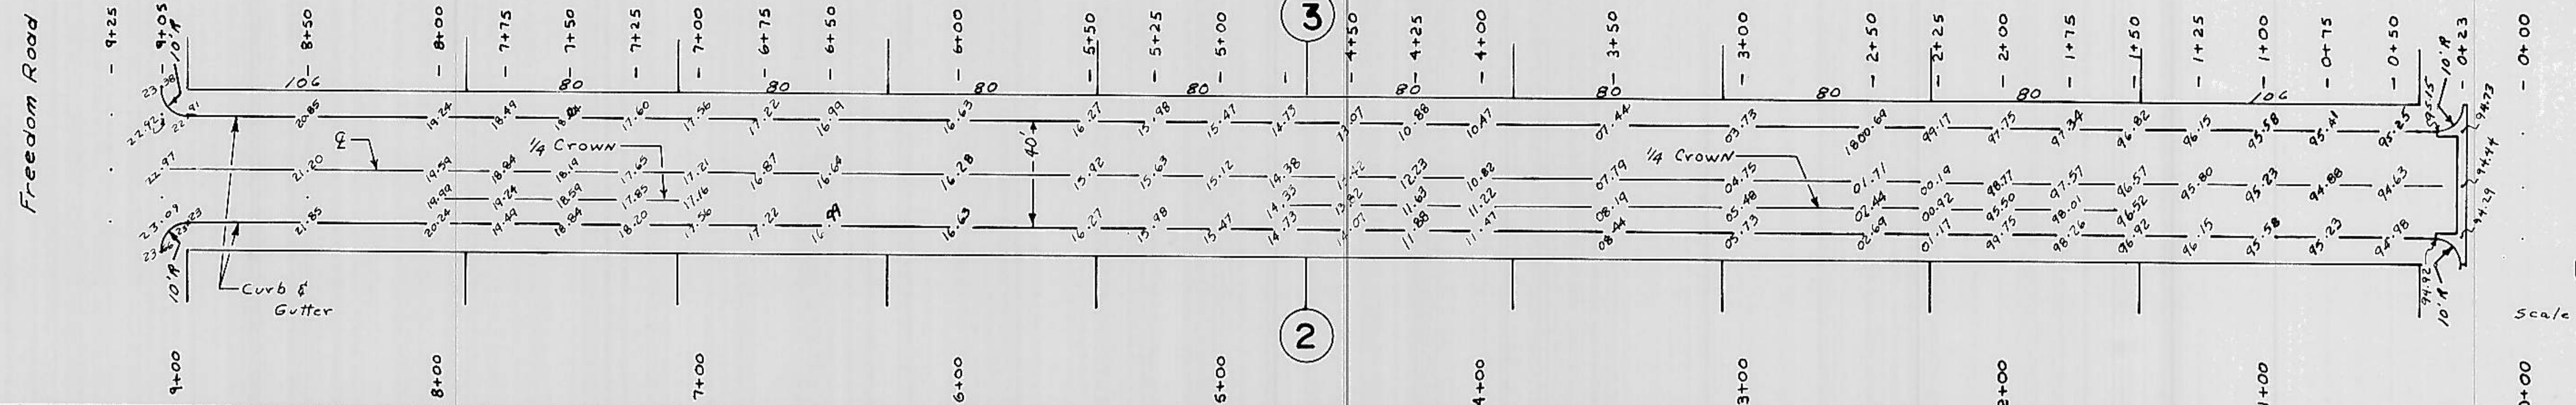

Scale 1" = 40'

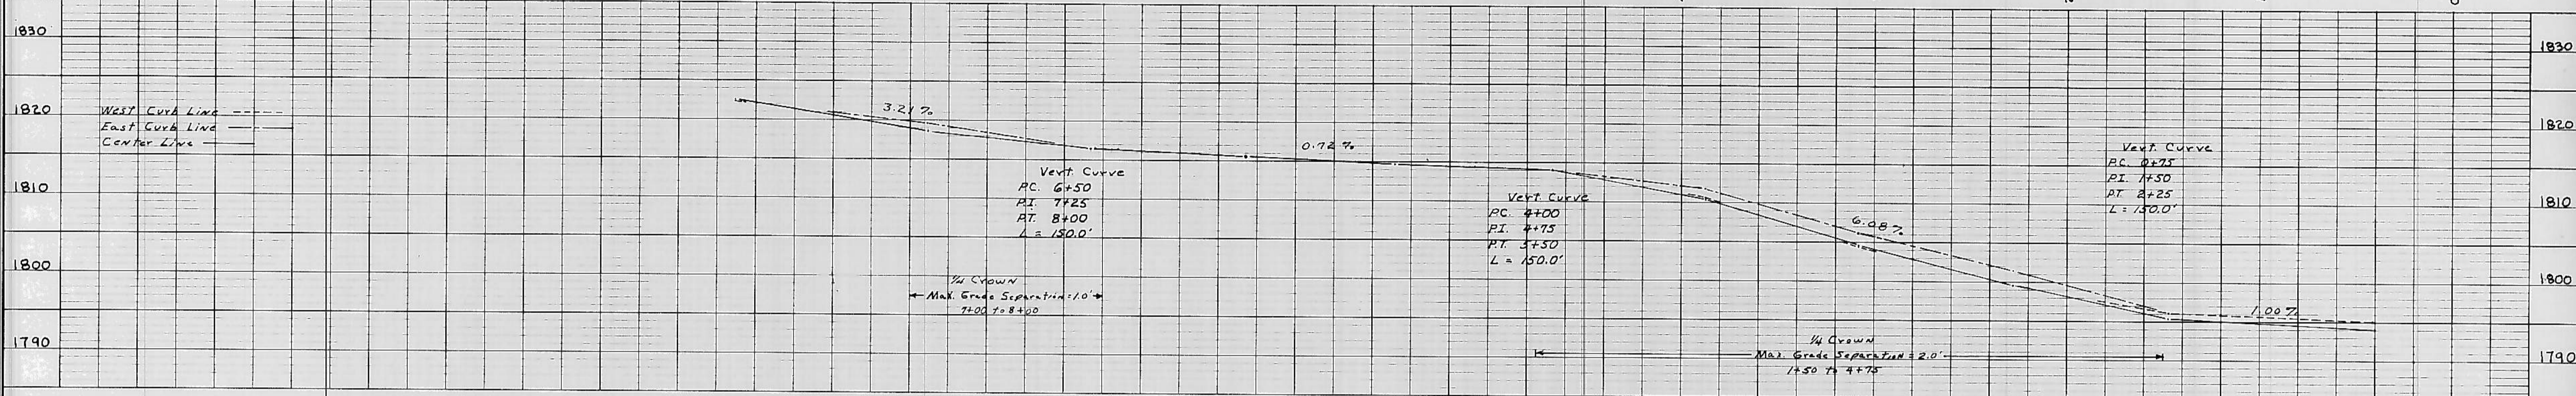

VALLEY FORGE

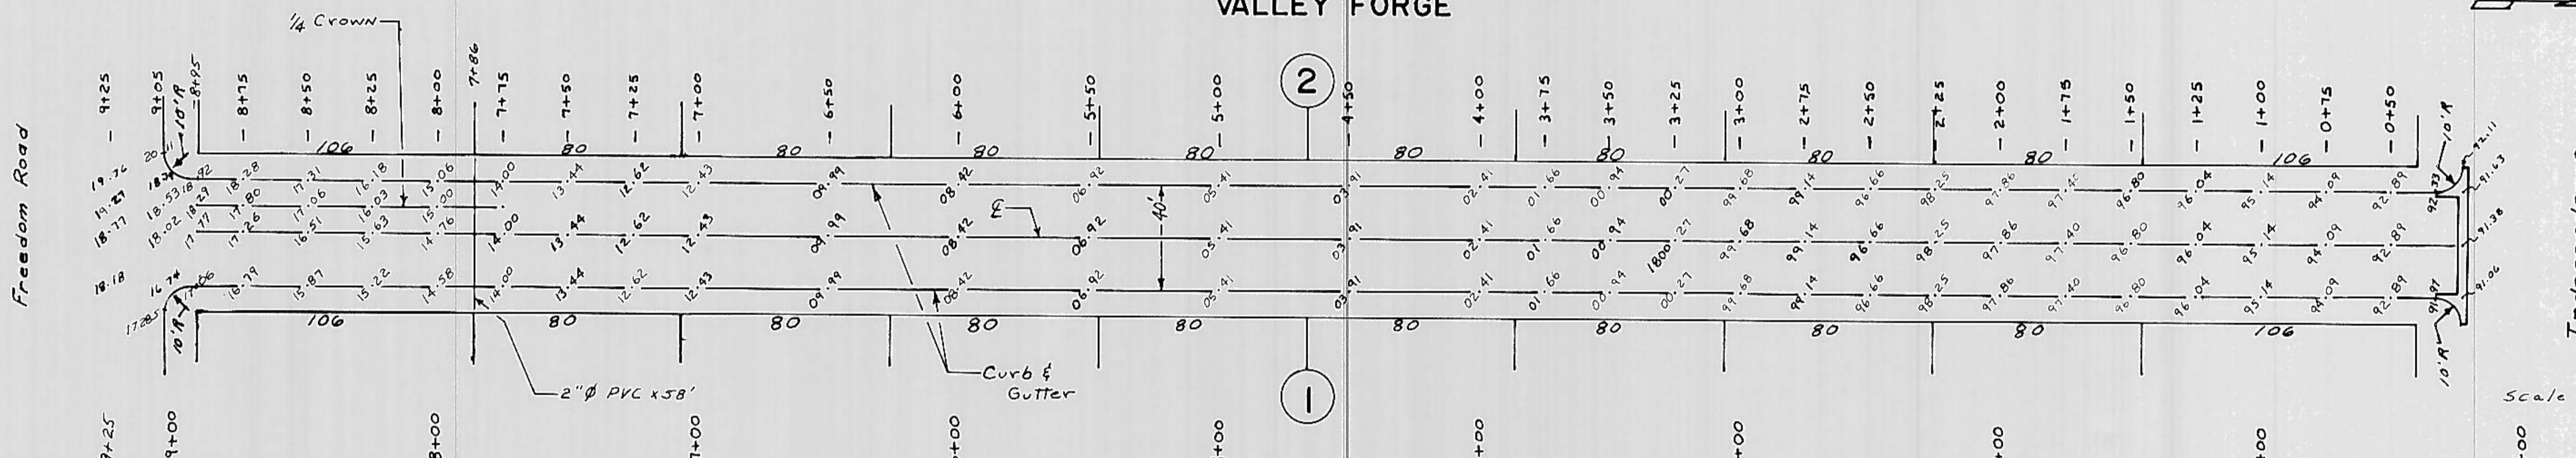

Scale 1" = 40'

