




TERRA VALLEE

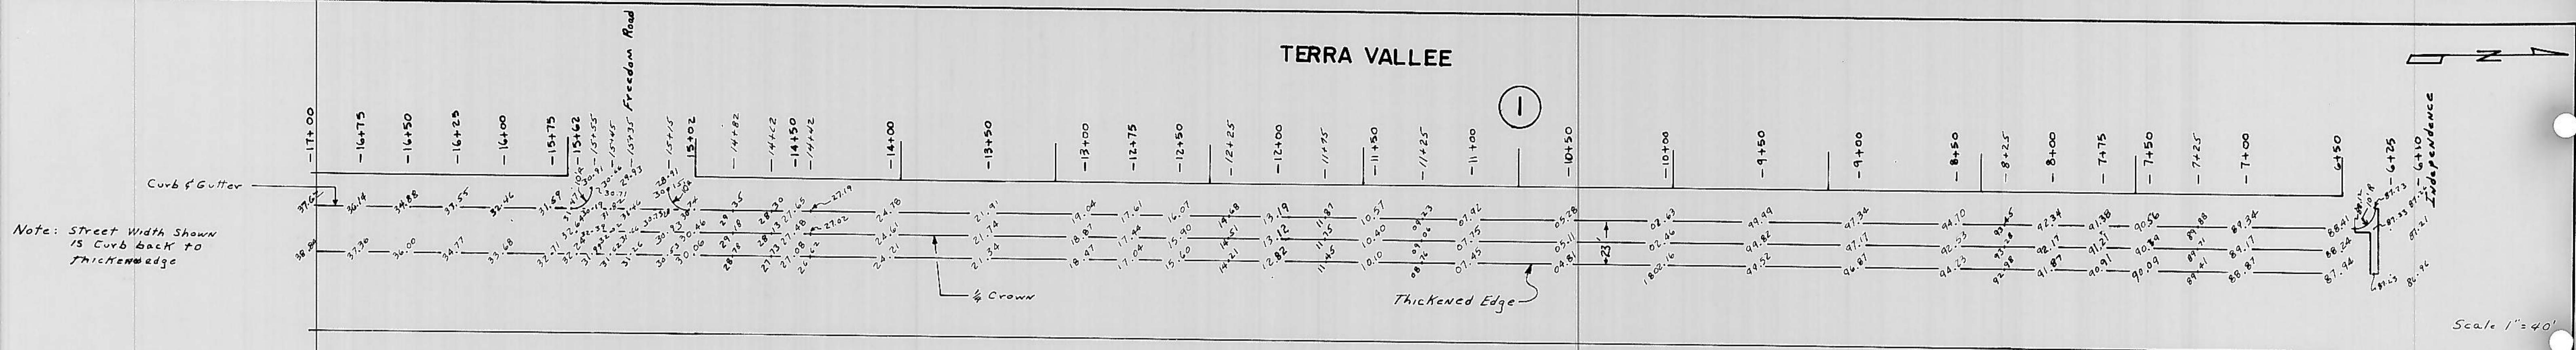

Scale 1" = 40'

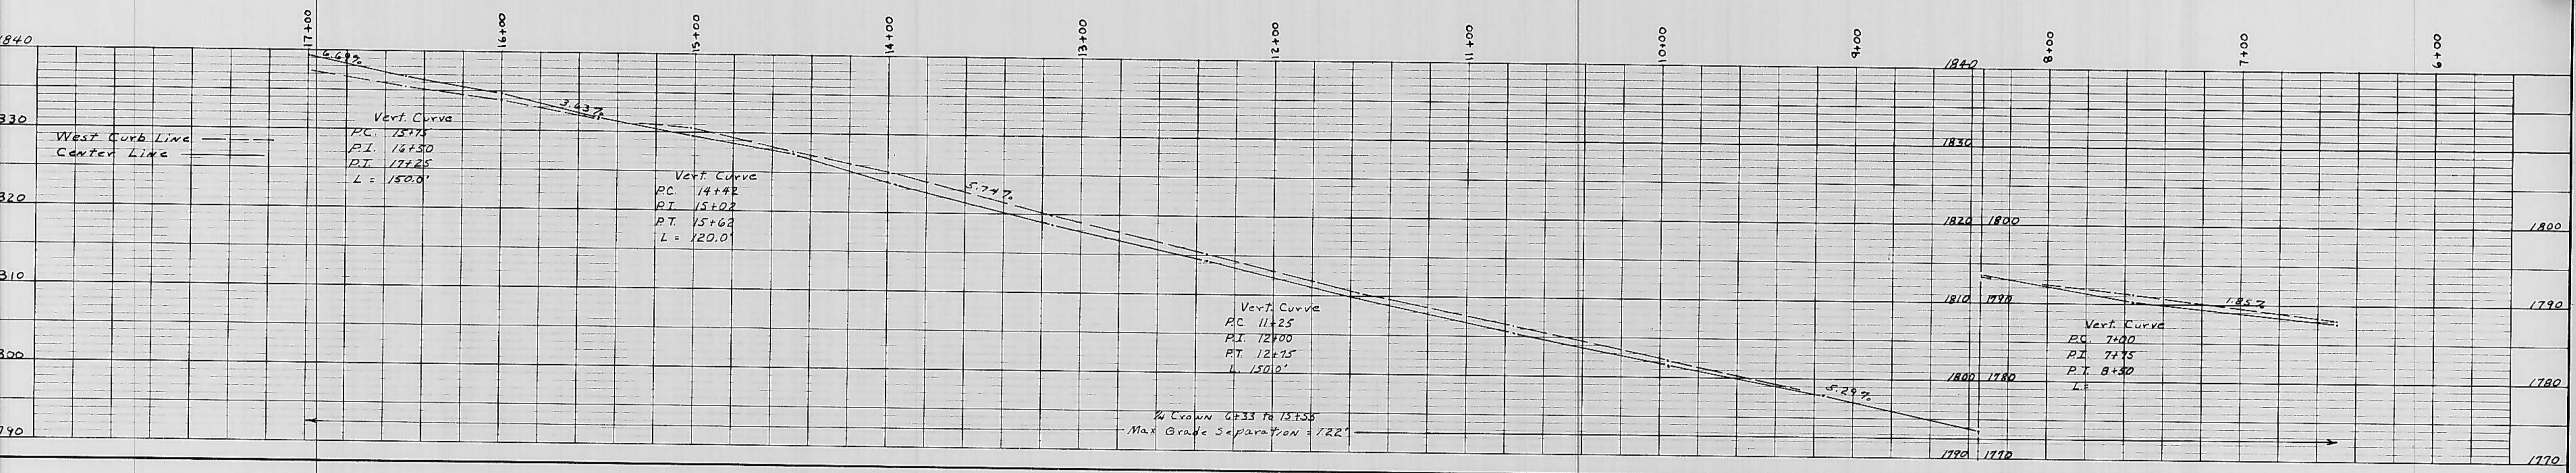

TERRA VALLEE

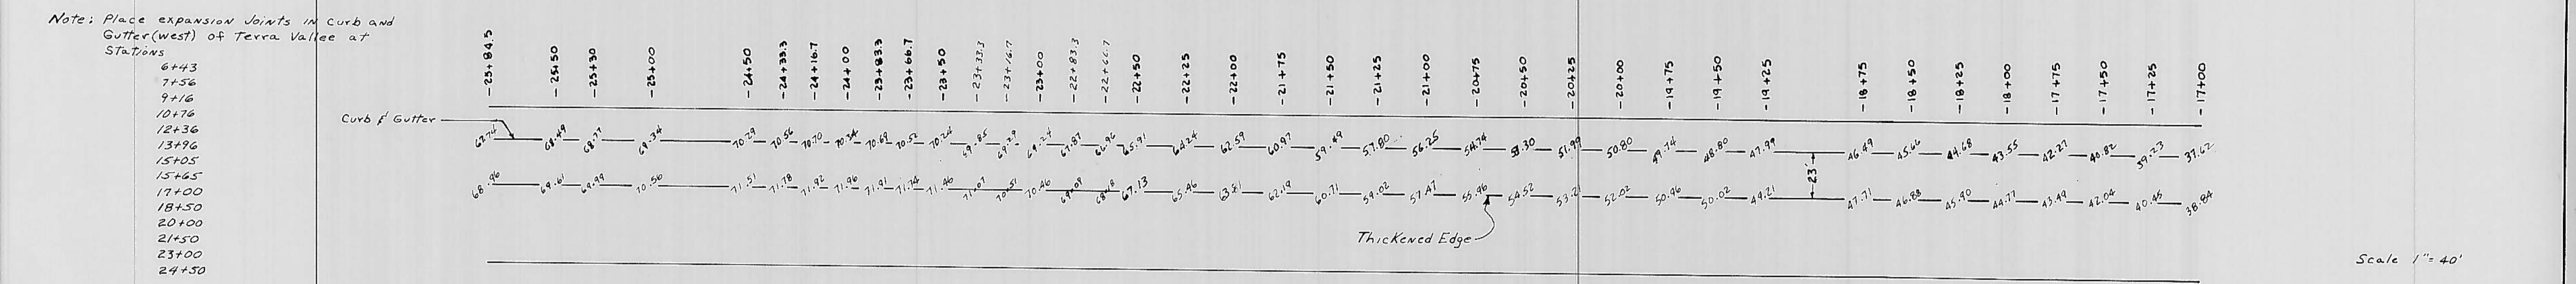

Scale 1" = 40'

