



- ⊕ EXISTING STREET LIGHTS
- ⊕ STREET LIGHTS TO BE INSTALLED
- C CONTROL CENTER

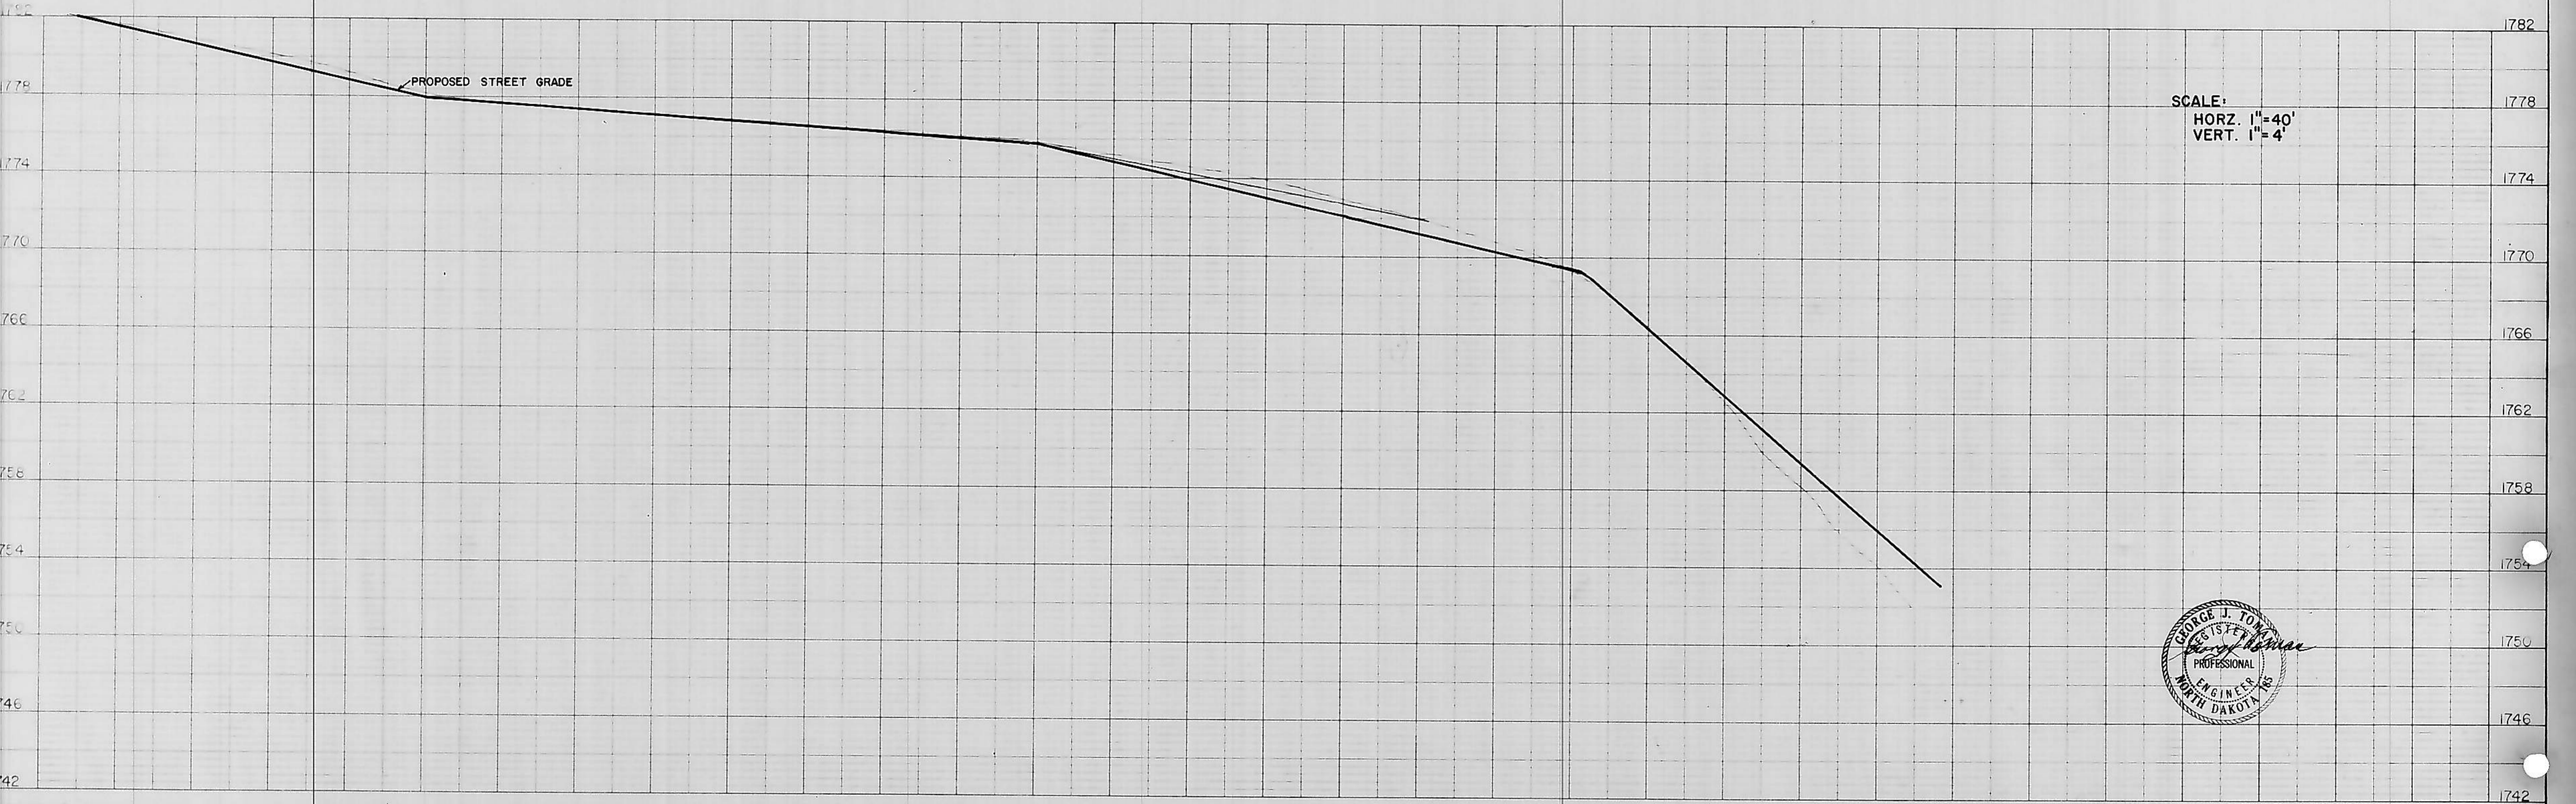

SCALE:
 HORZ. 1"=40'
 VERT. 1"=4'

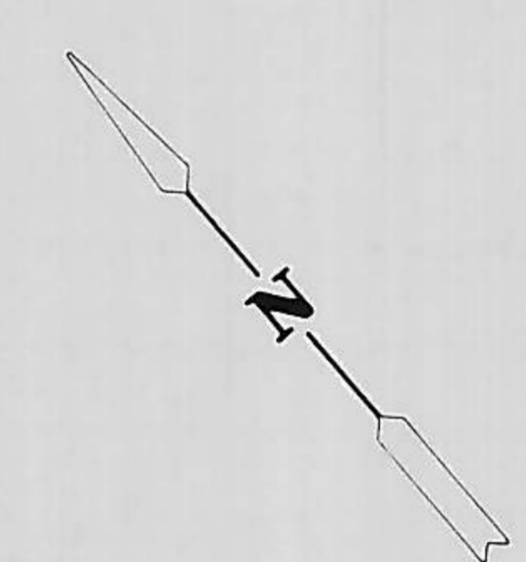