
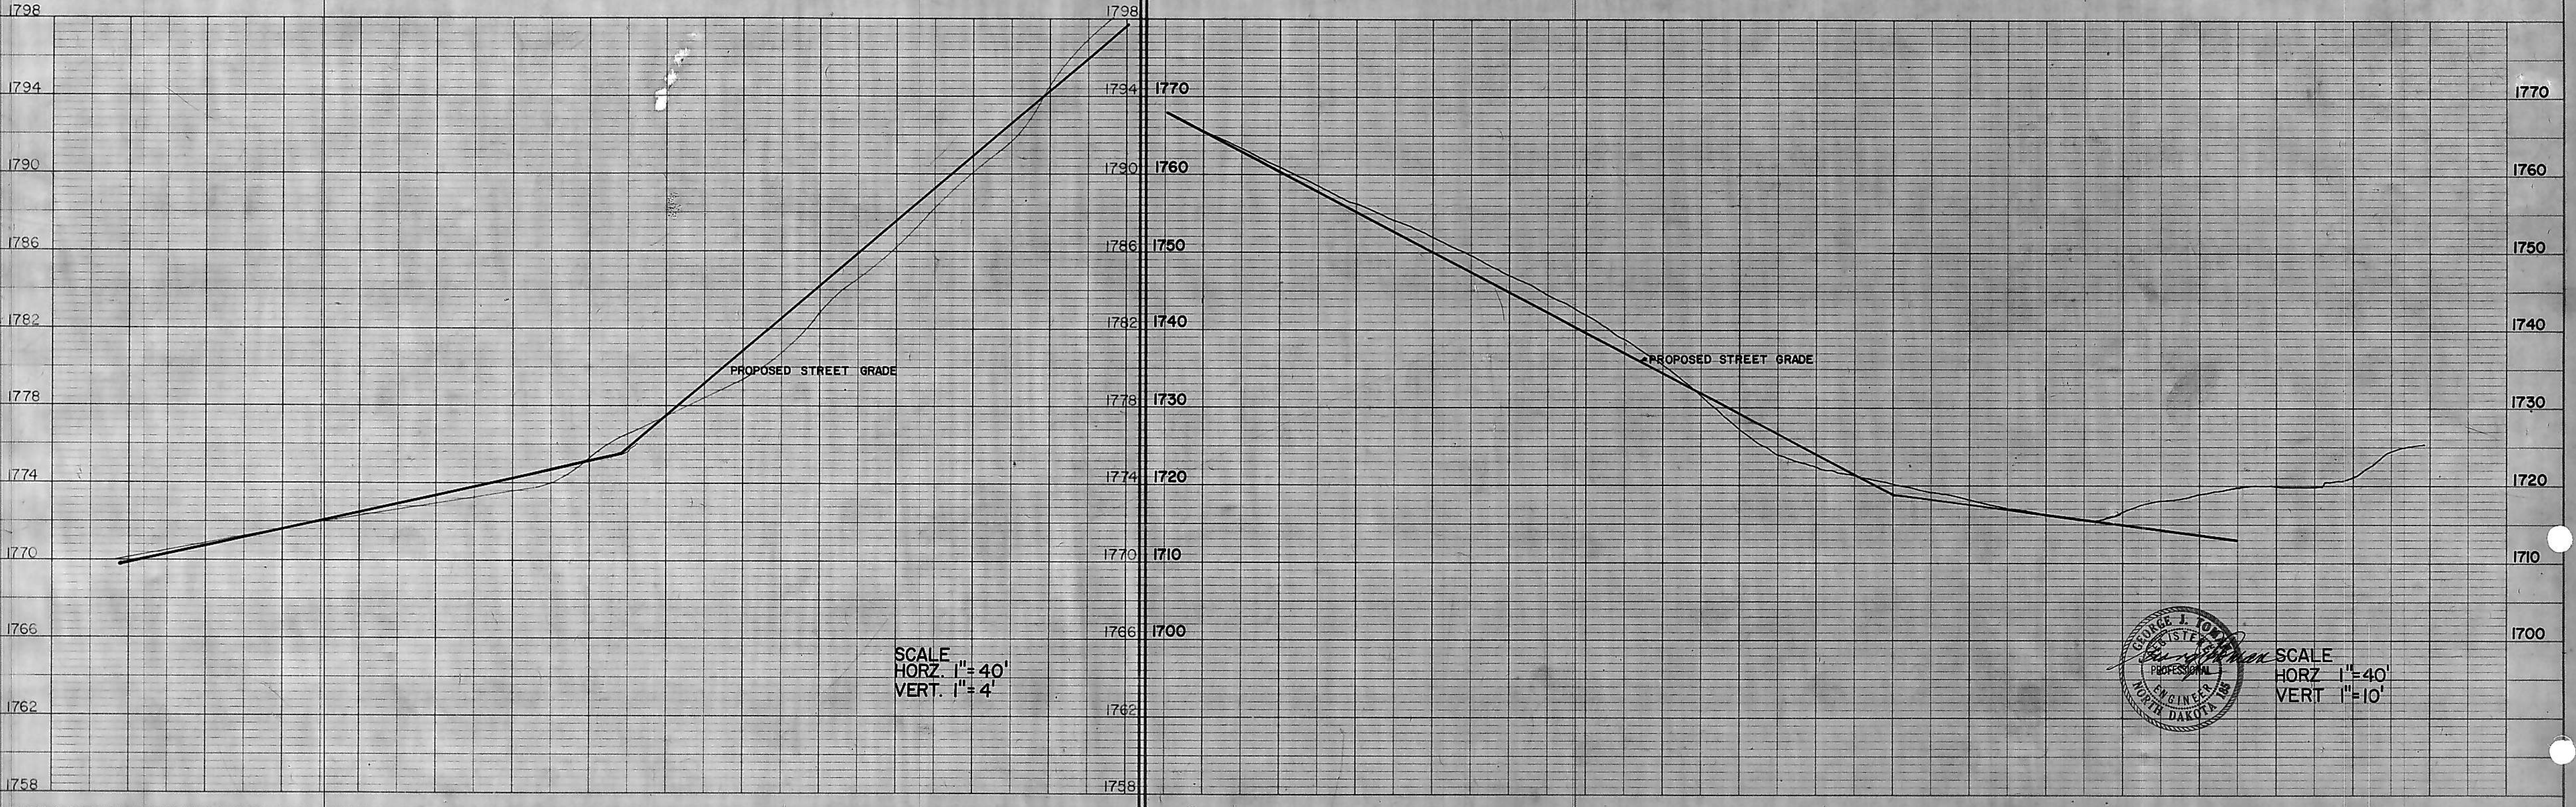
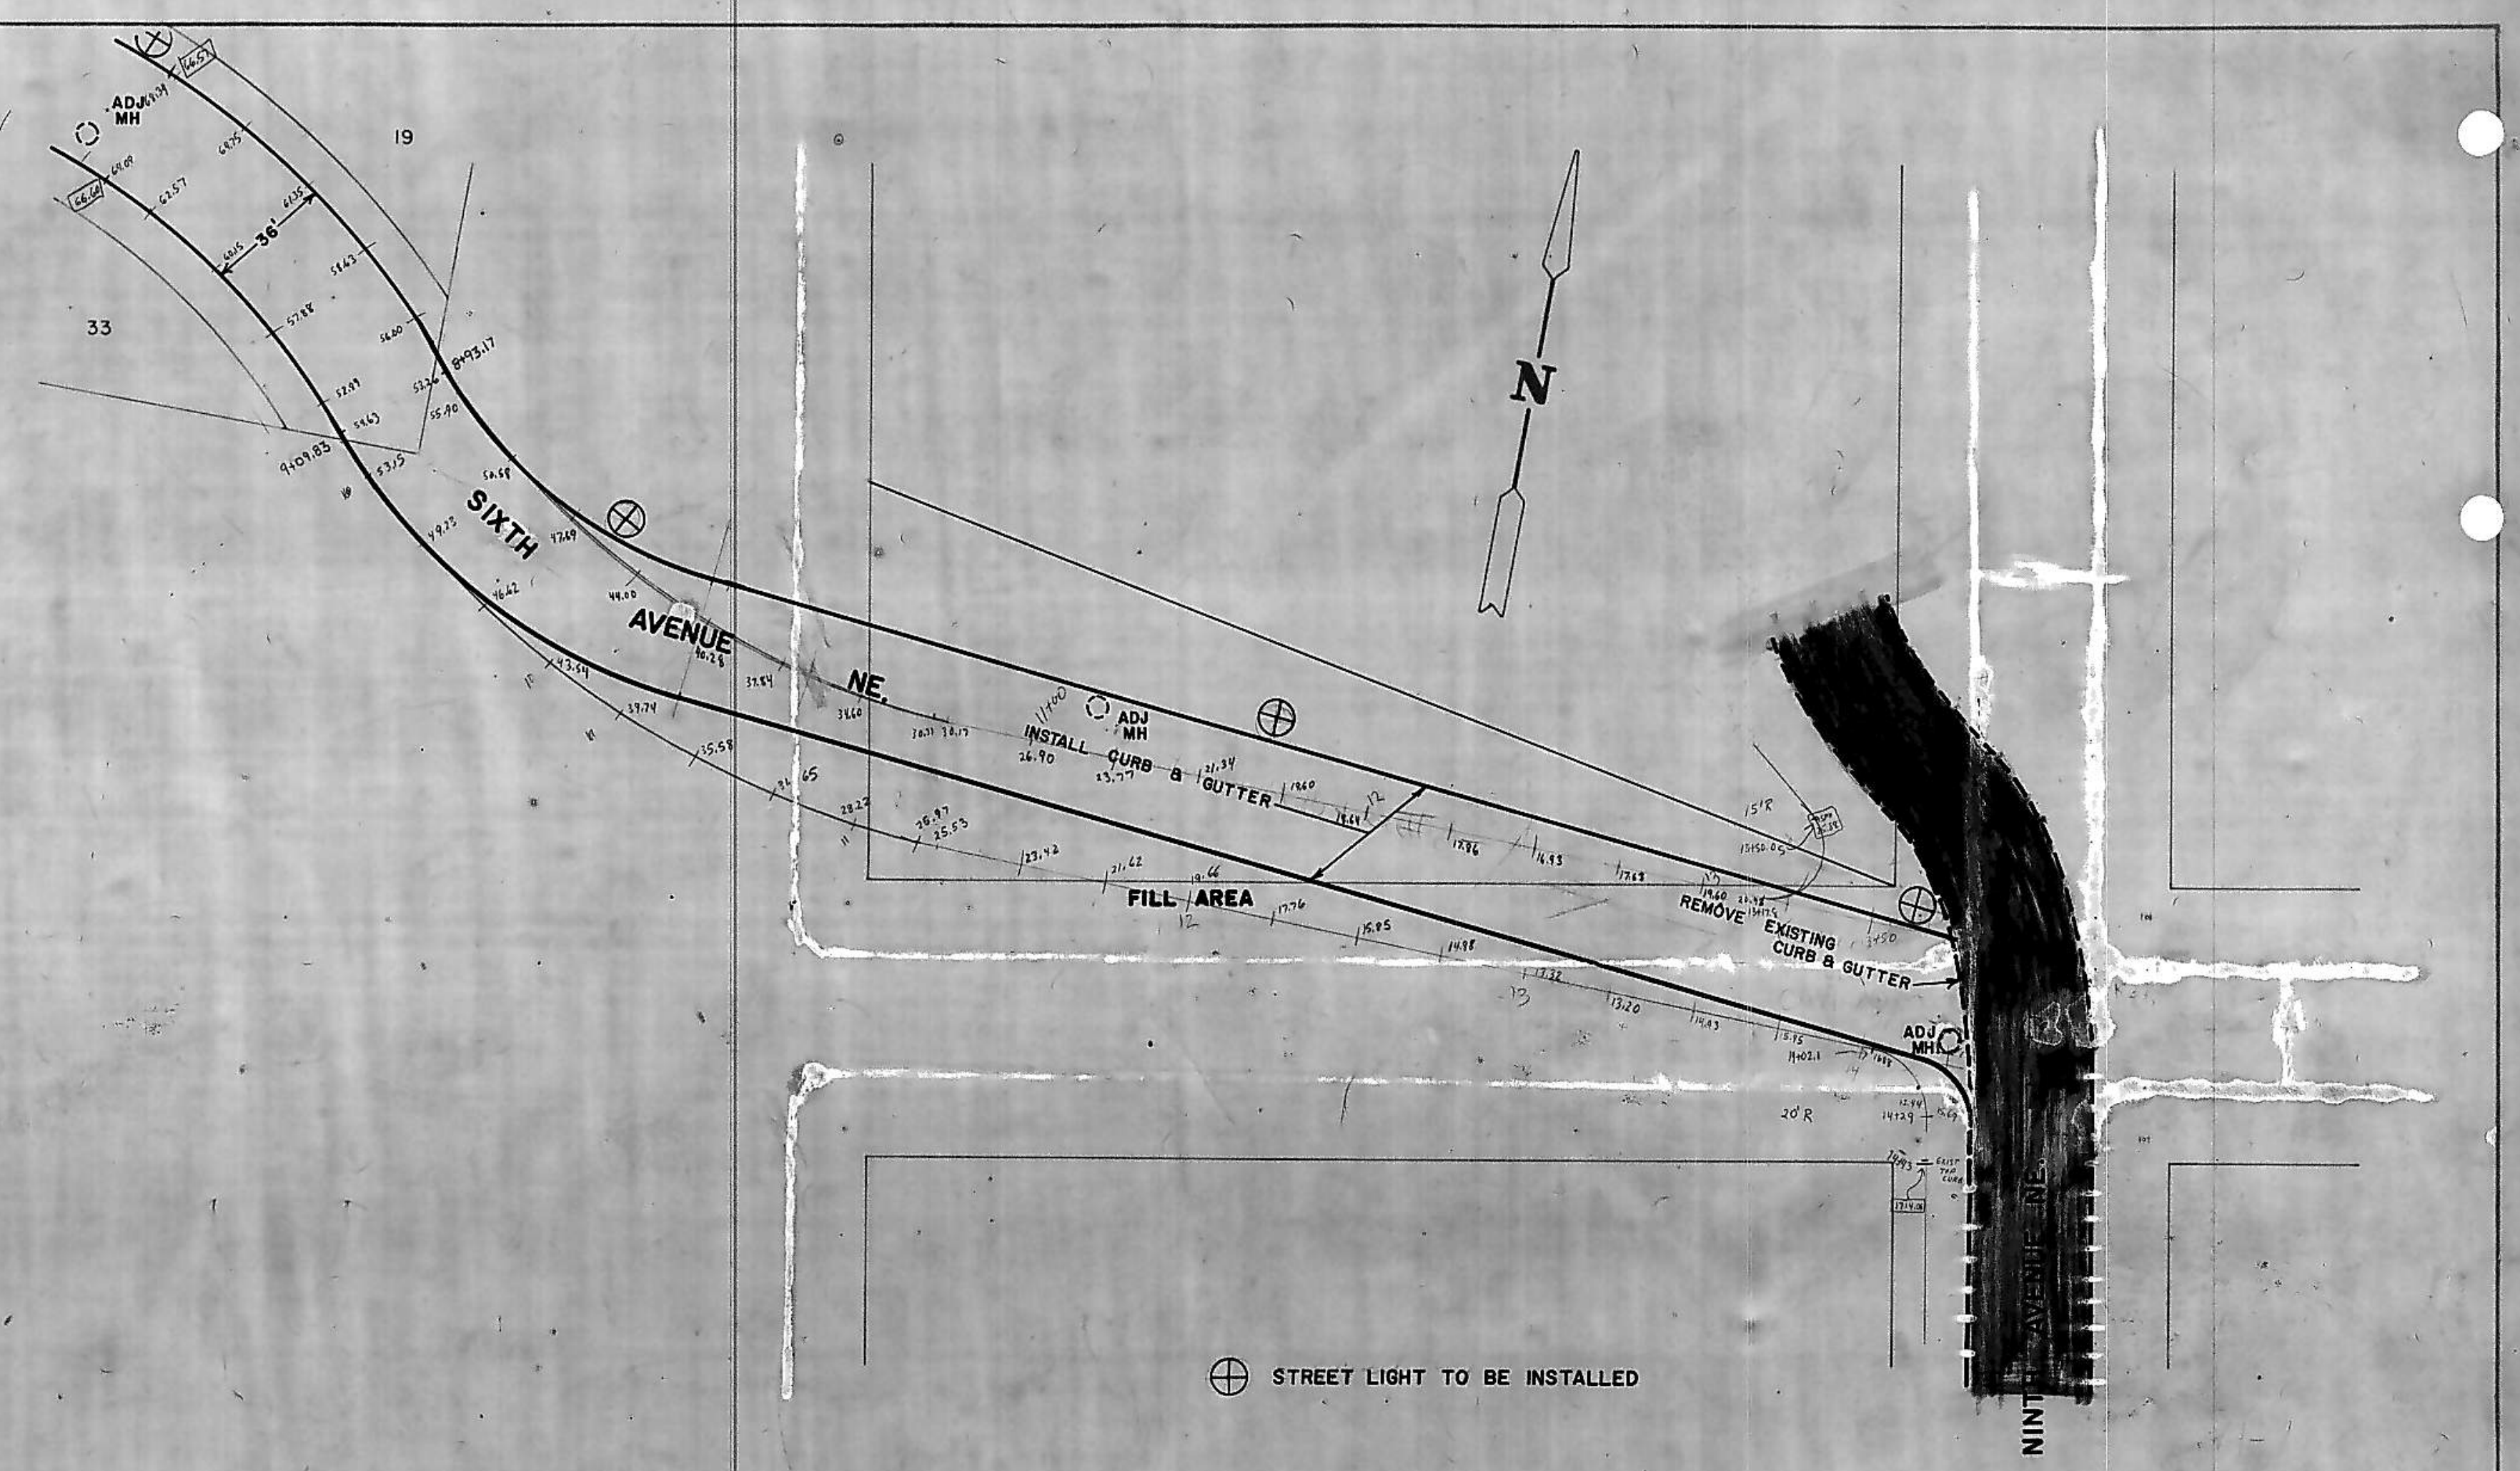


PLAN
 SURVEYED
 PLOTTED
 NOTE BOOK ALIGNMENT CHECKED
 NO. OF WATER CHECKED

PROFILE
 SURVEYED
 PLOTTED
 NOTE BOOK GRADES CHECKED
 NO. OF WATER CHECKED

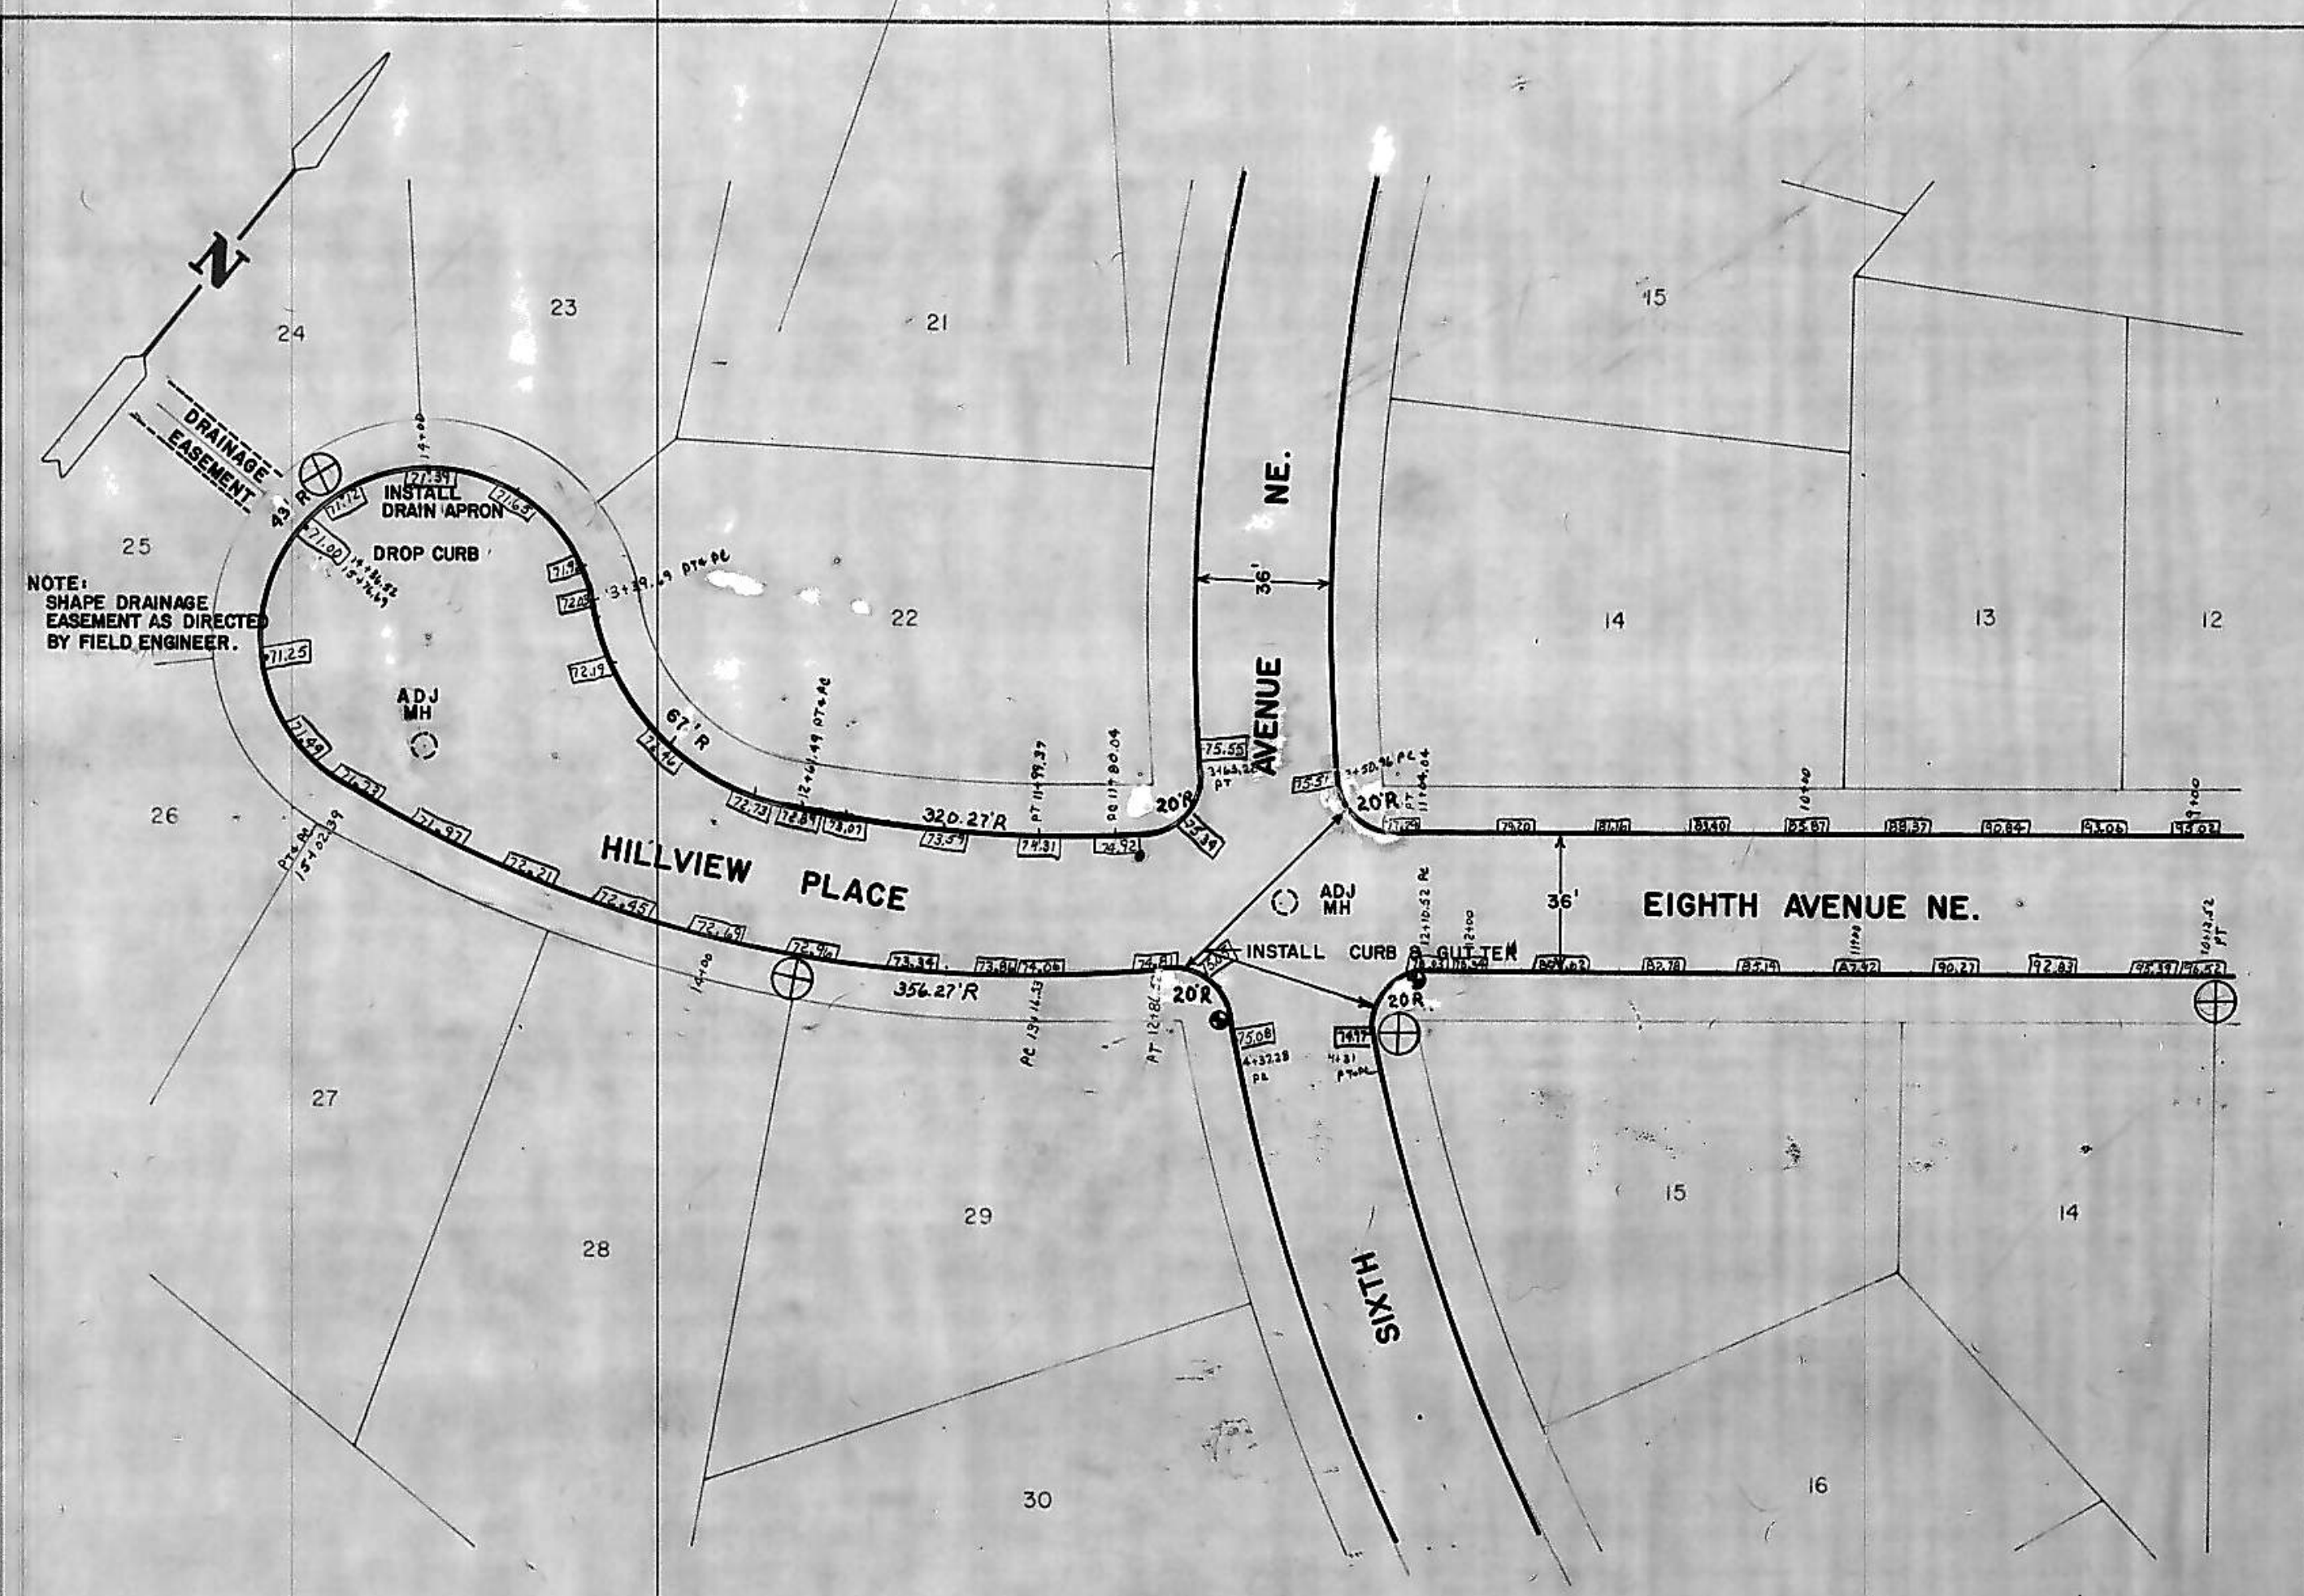

SCALE
 HORZ. 1" = 40'
 VERT. 1" = 4'

SCALE
 HORZ. 1" = 40'
 VERT. 1" = 10'

