
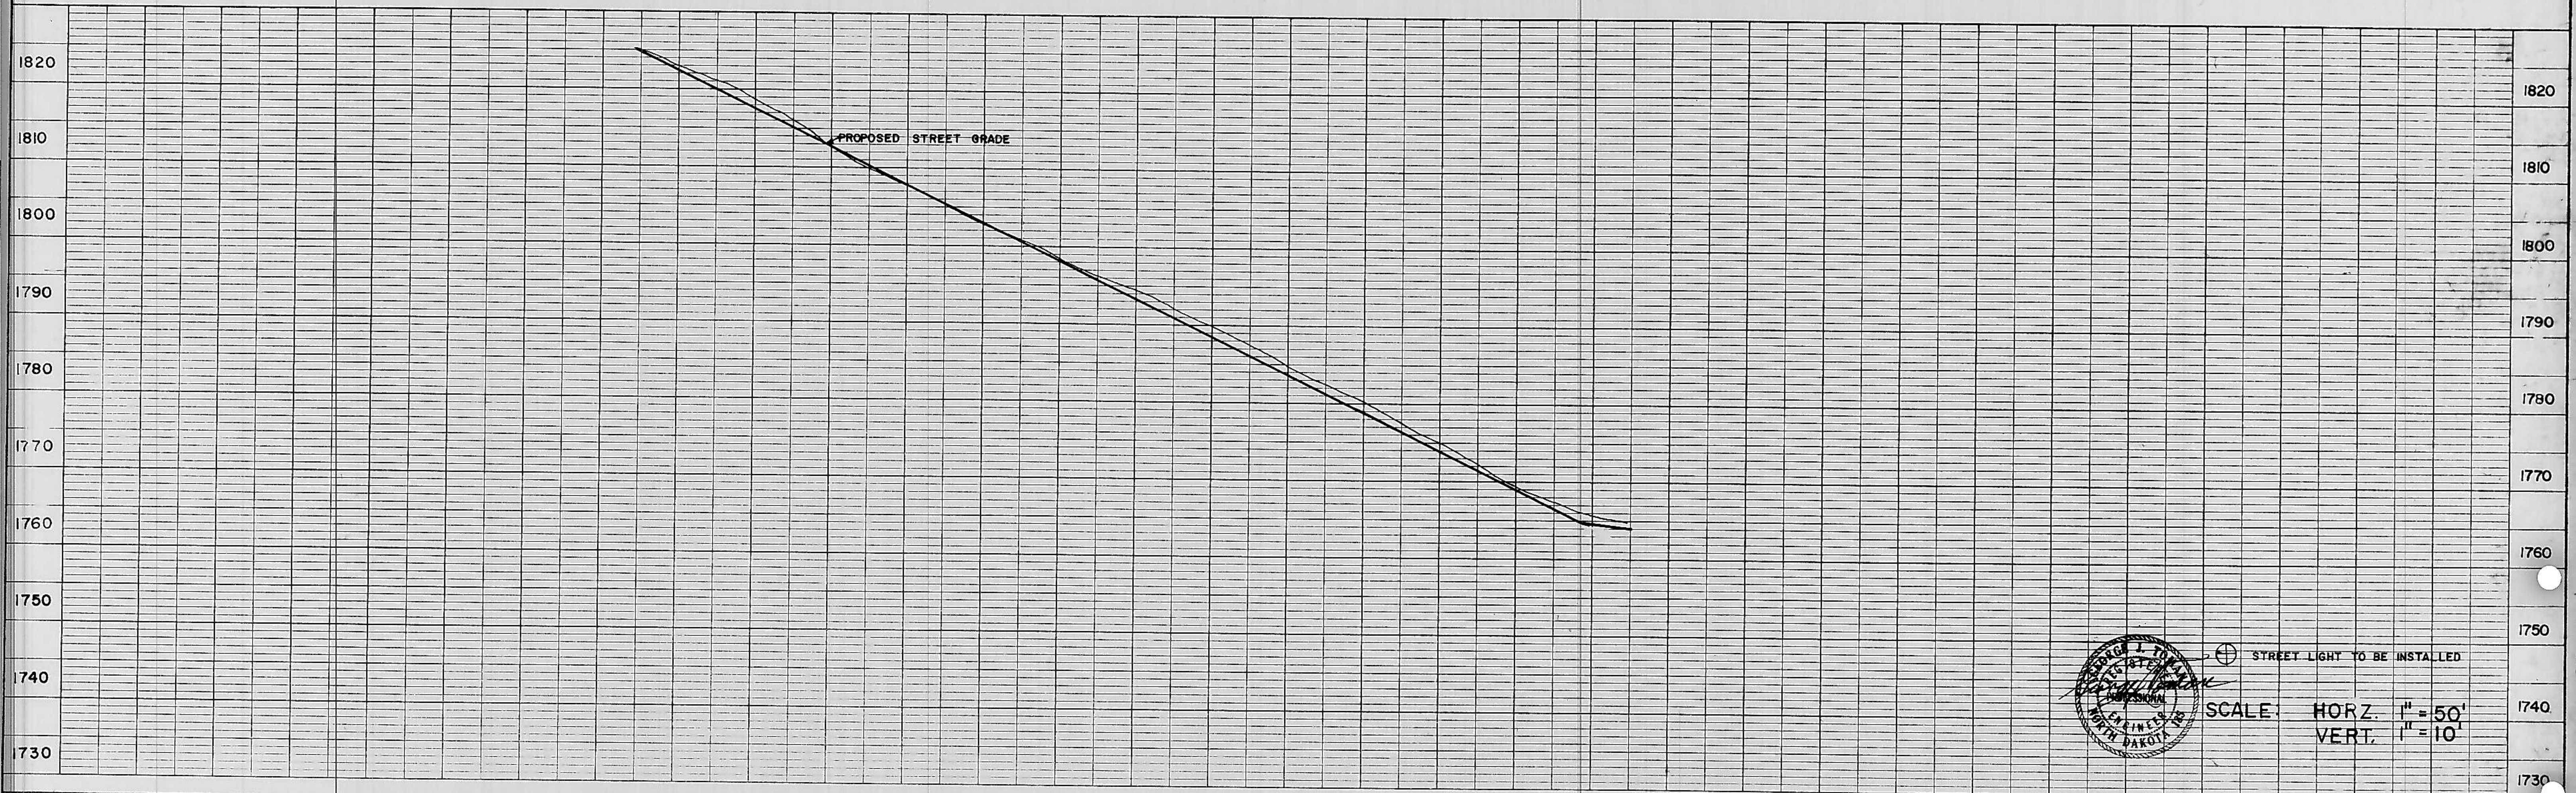


PLAN
 SURVEYED BY DATE
 PLOTTED BY
 NO. & BOOK OF DRAWINGS
 NO. OF WAYS CHECKED

PROFILE
 DRAWN BY DATE
 CHECKED BY
 NO. & BOOK OF DRAWINGS
 STRUCTURE NO. & INSCRIPTION

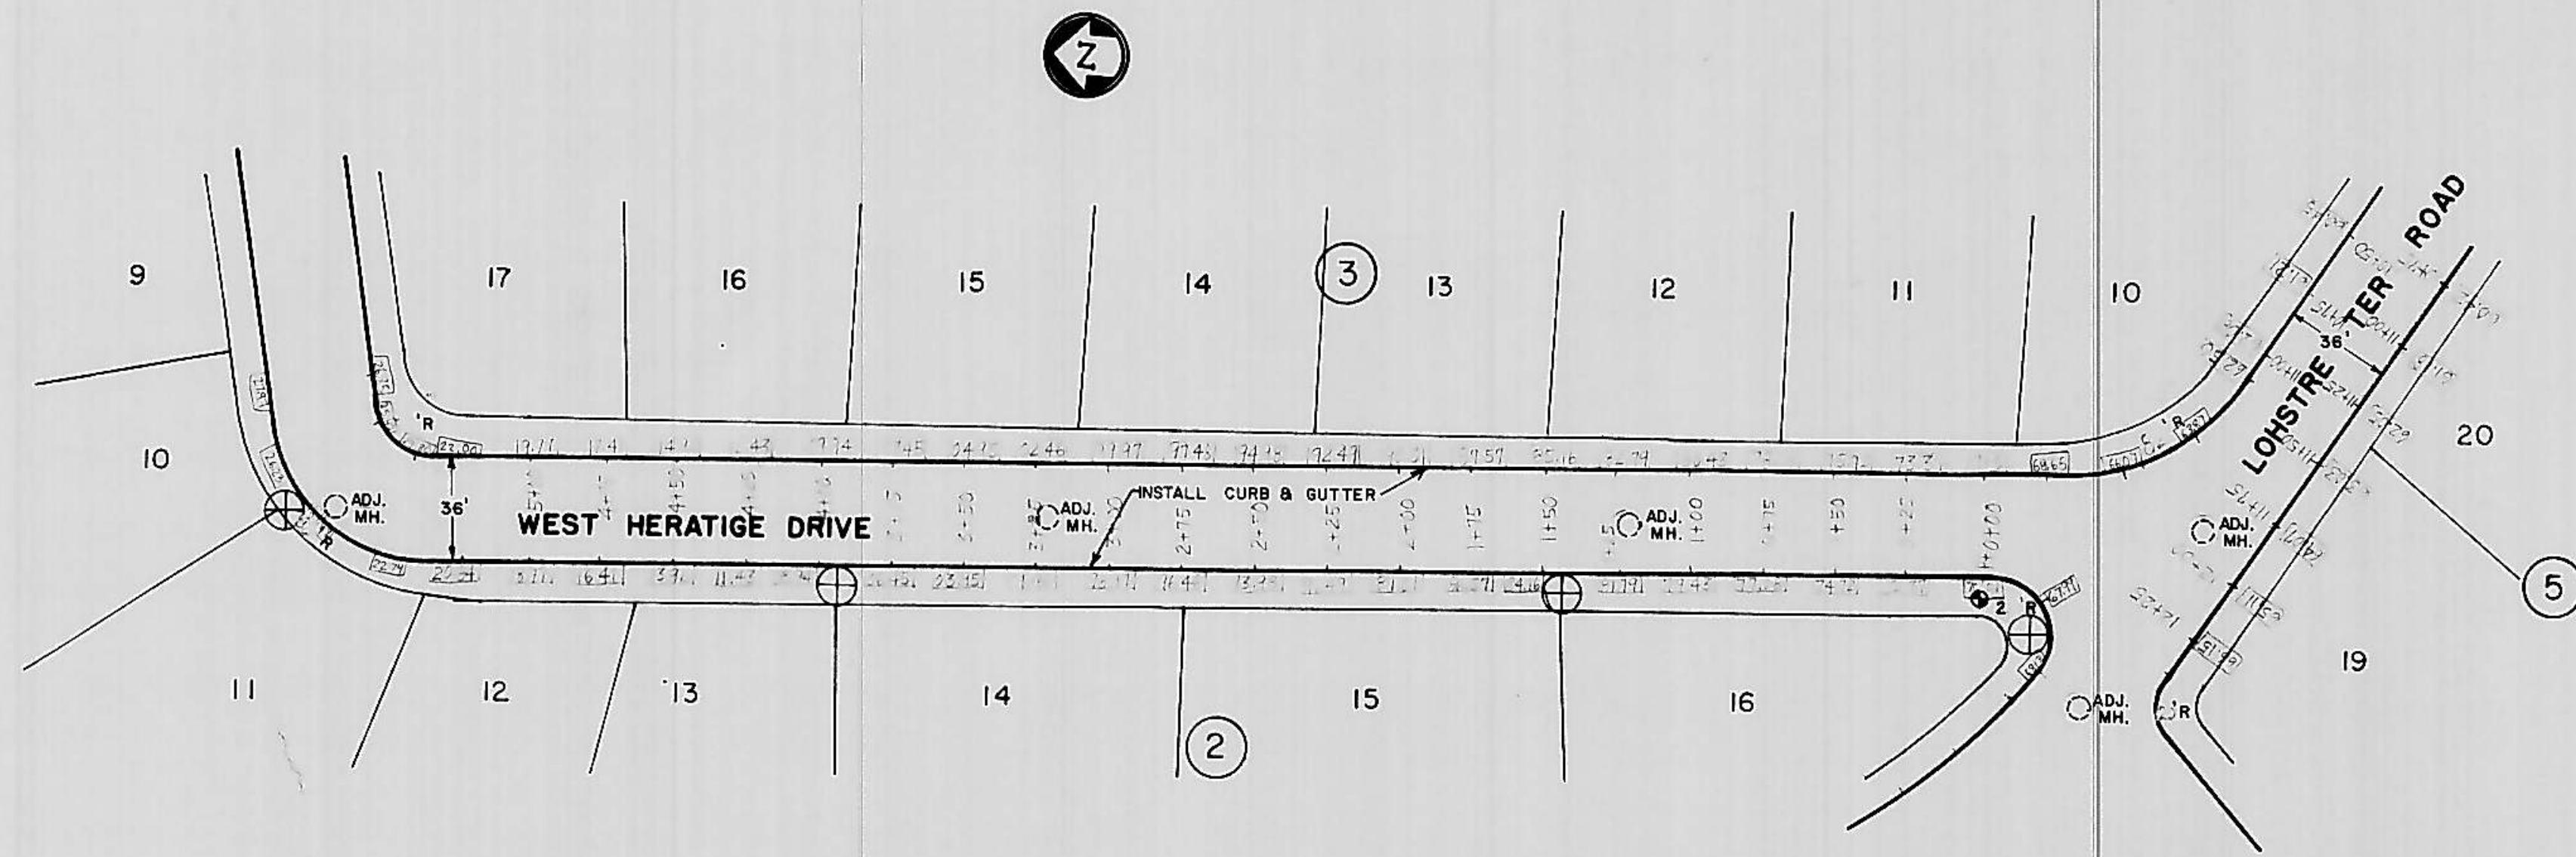

STREET LIGHT TO BE INSTALLED

SCALE: HORZ. 1" = 50'
 VERT. 1" = 10'