



UNIT 3

UNIT 4

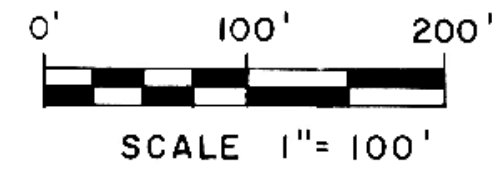

DIANE'S SECOND ADDITION

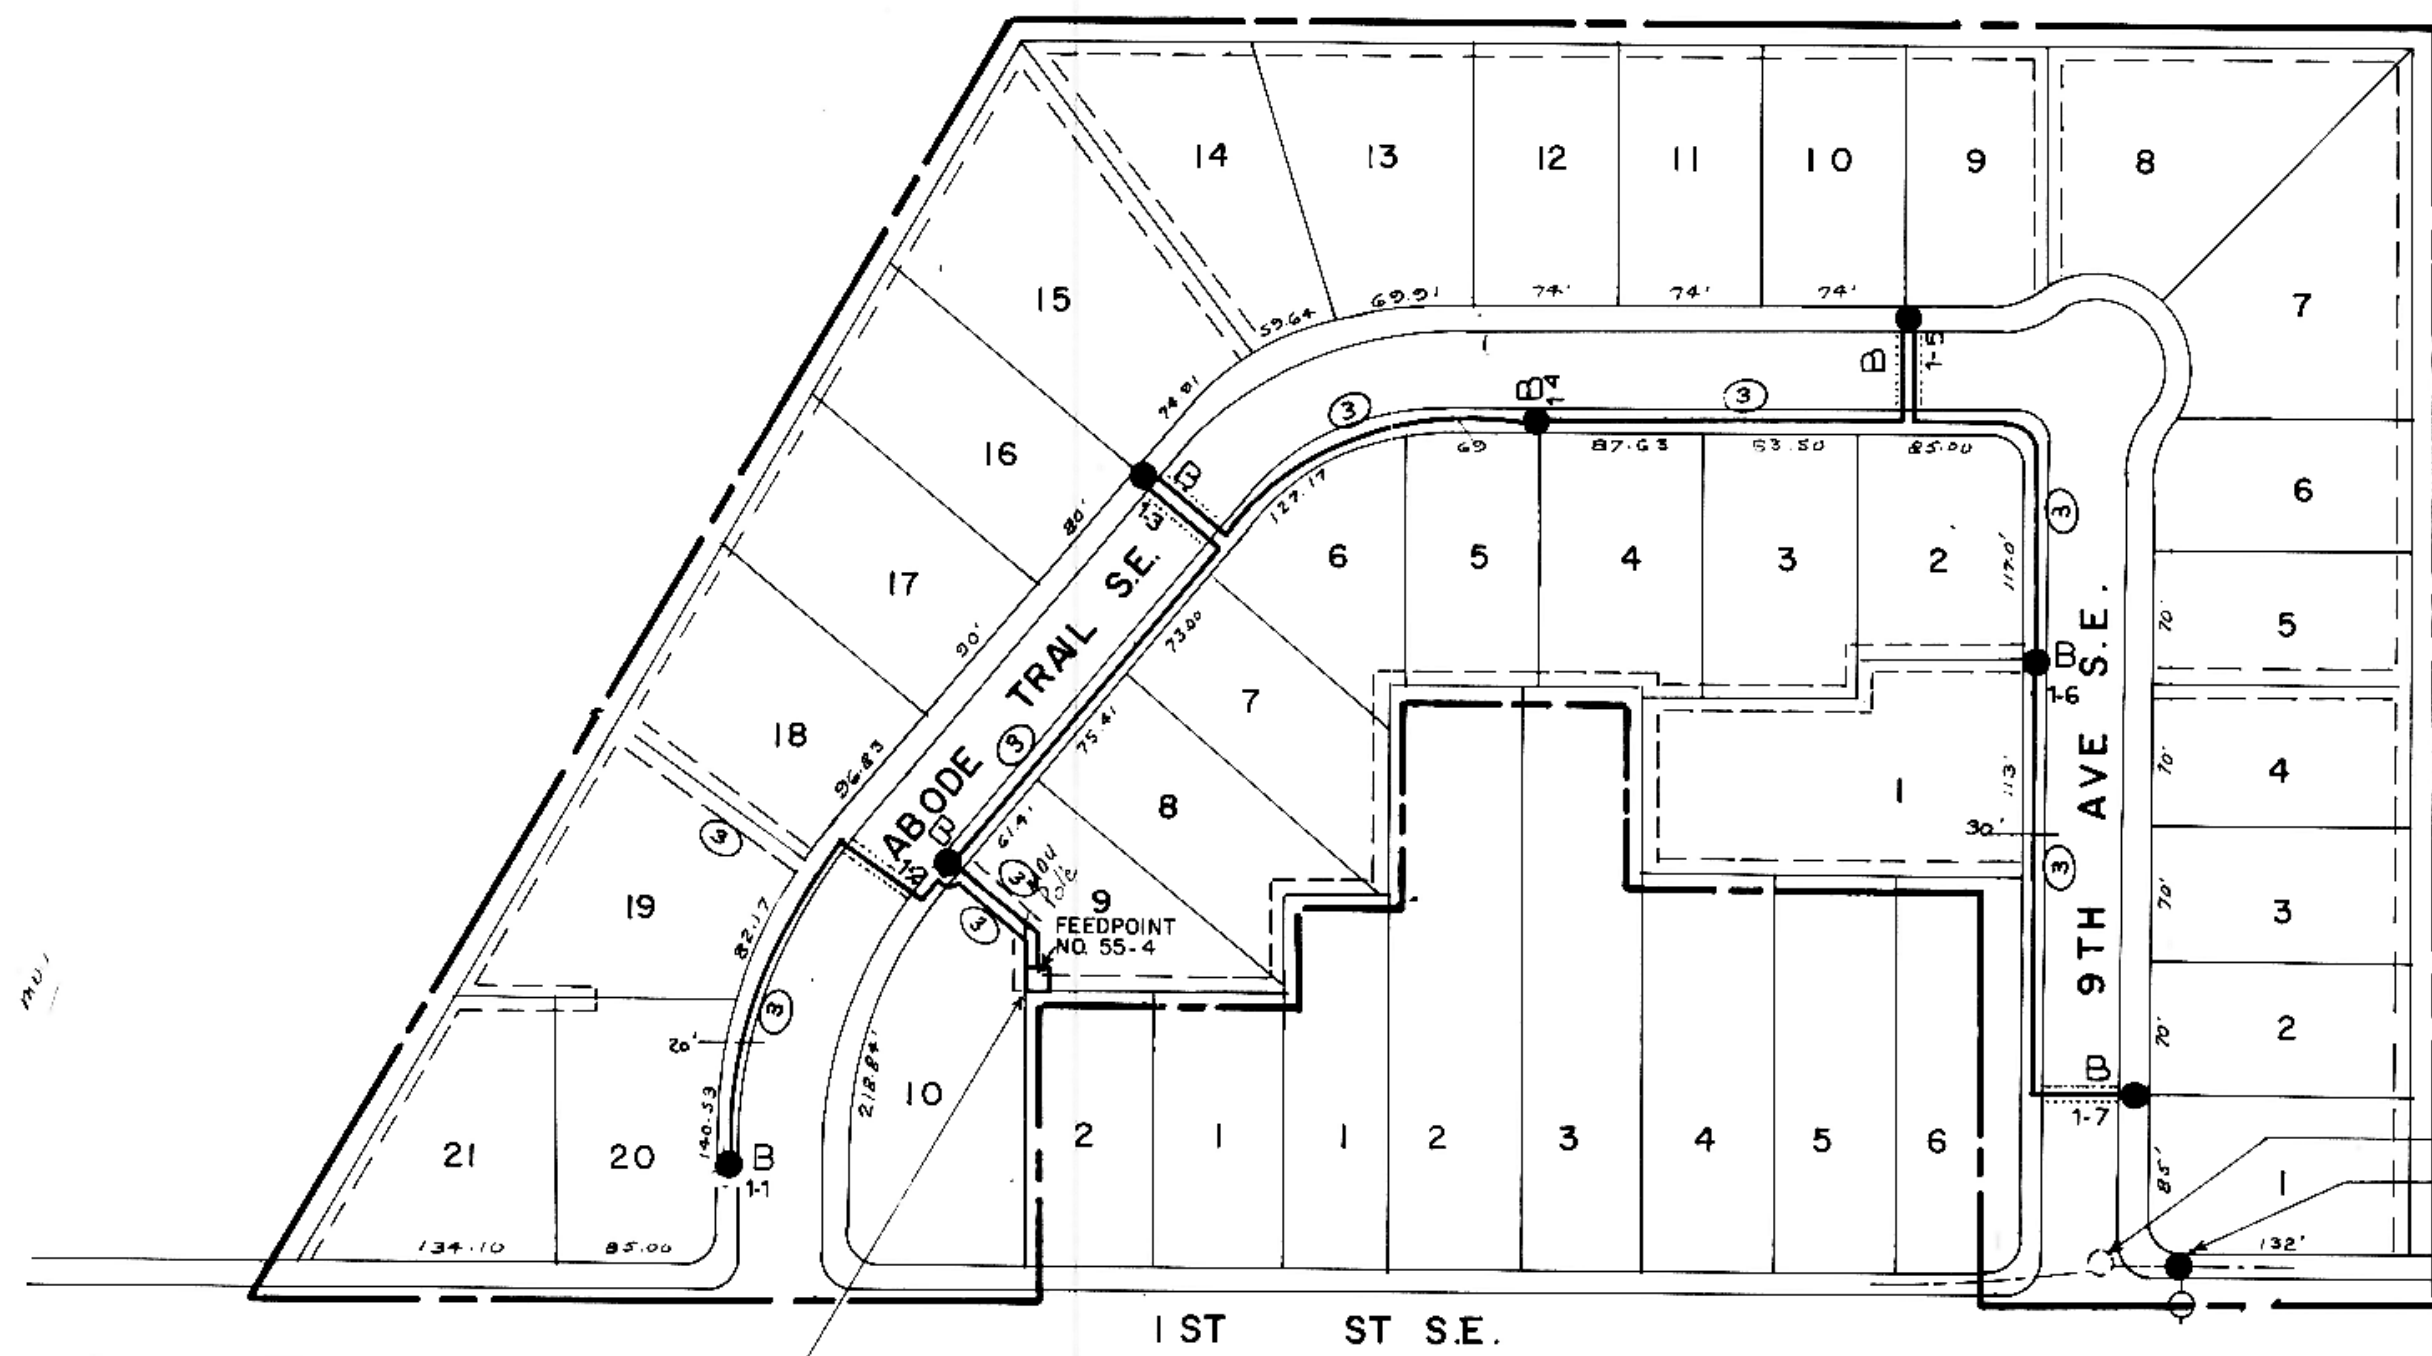

HOOVESTOL SUBDIVISION

EXISTING ST LIGHT
RELOCATE TO THIS POINT
CONNECT TO EXISTING CIRCUIT
MAKE UNDERGROUND SPLICES
WITH HOMAC "FLOODSEAL"

RELOCATE FEEDPOINT
NO. 55-4

SCHMIT, SMITH & RUSH
CONSULTING ENGINEERS
MINOT NORTH DAKOTA