

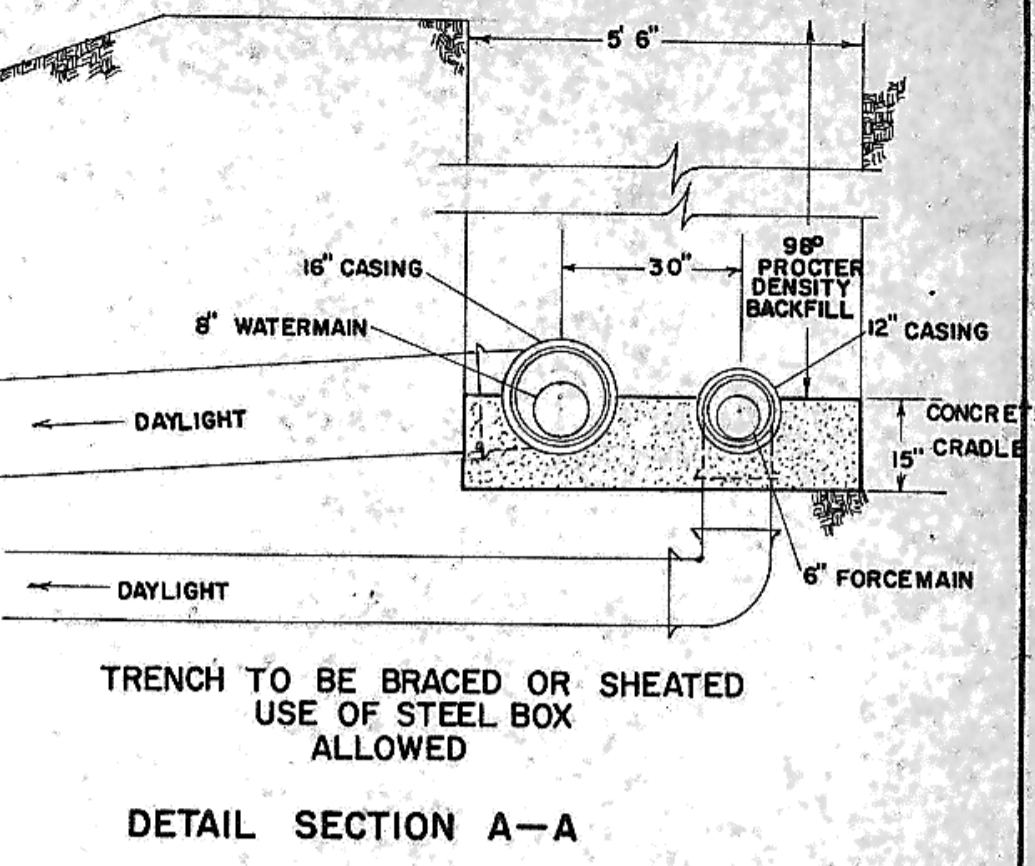
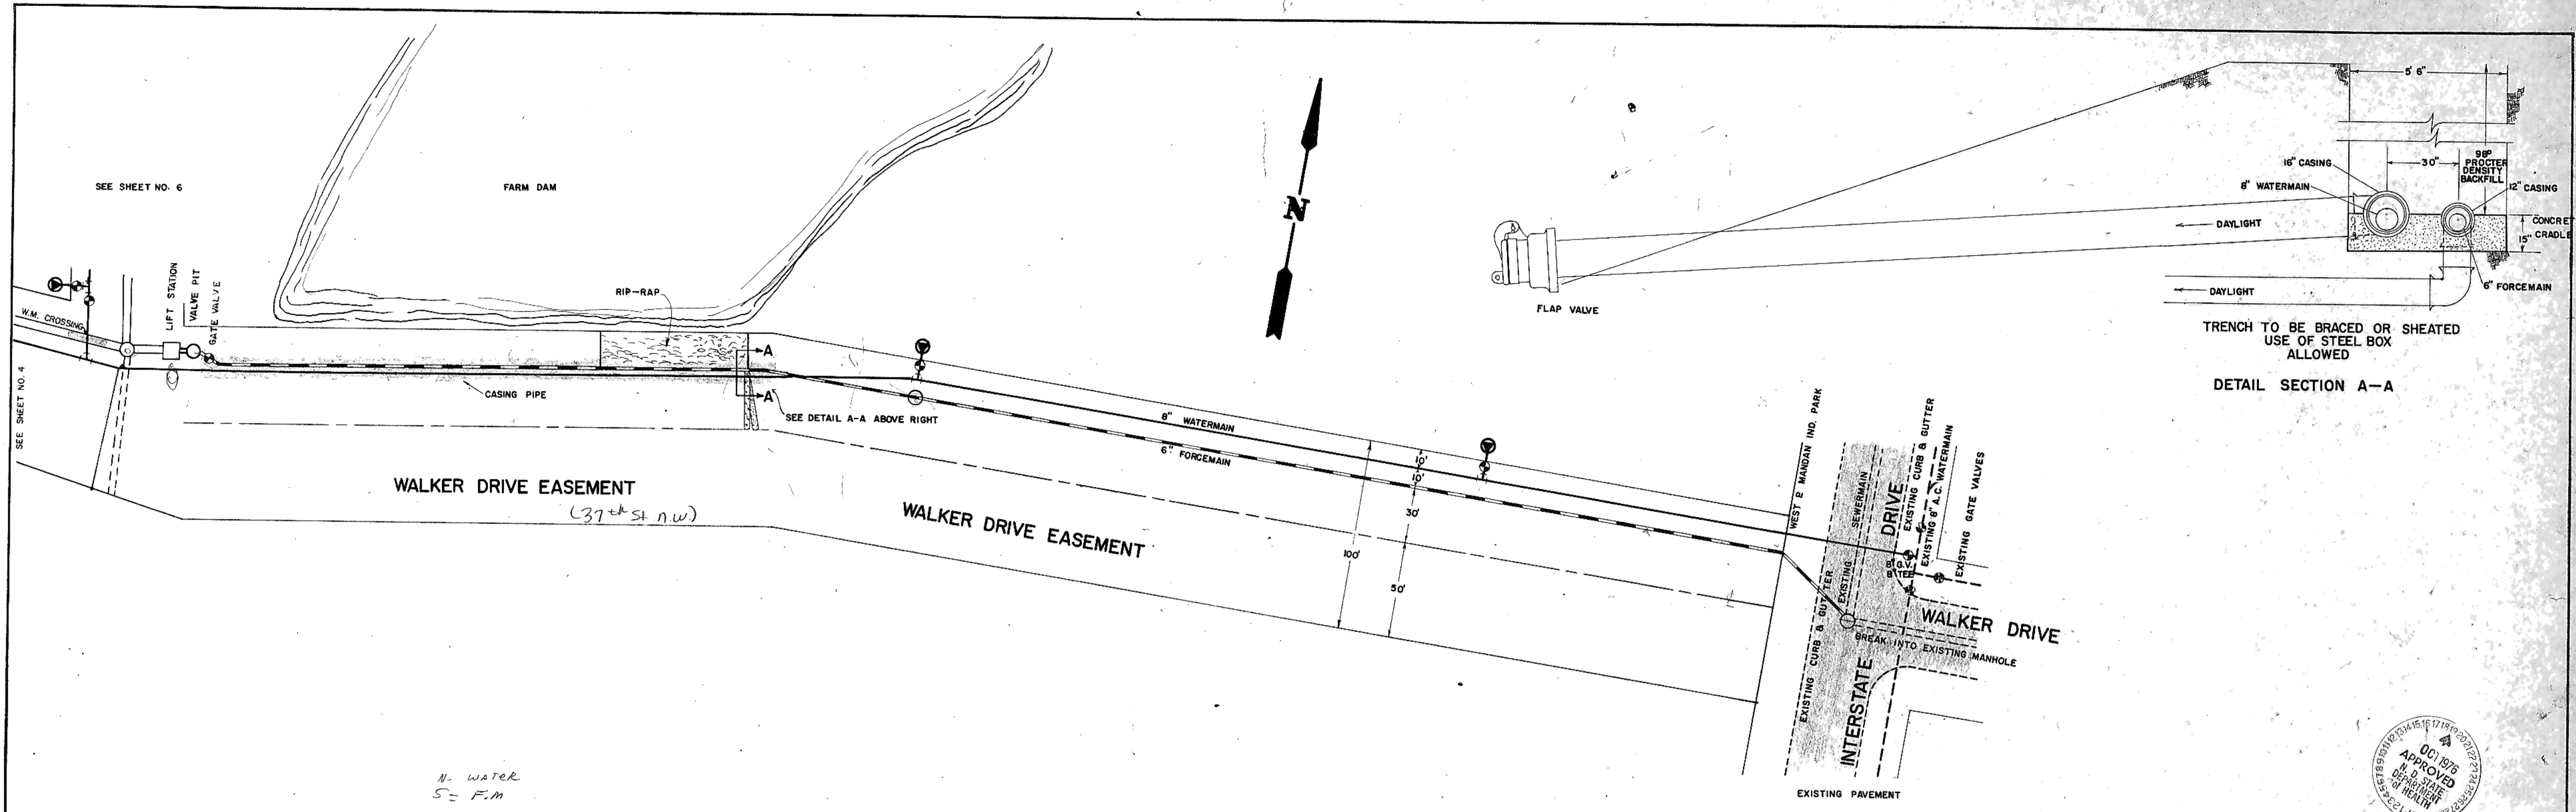


PLAN	SURVEYED	DATE
	PLOTTED	BY
	NOTE BOOK	NO.
	GRADES CHECKED	
	RT. OF WAY CHECKED	

PROFILE	SURVEYED	DATE
	GRADES CHECKED	BY
	NOTE BOOK	NO.
	STRUCTURE NOTATIONS CHECKED	

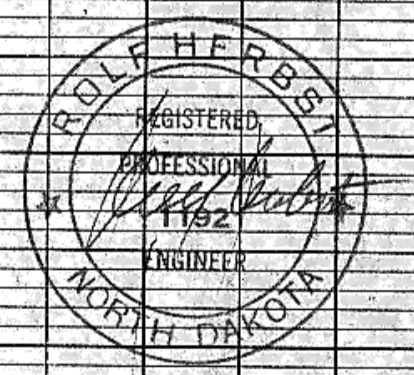

N = WATER  
S = F.M

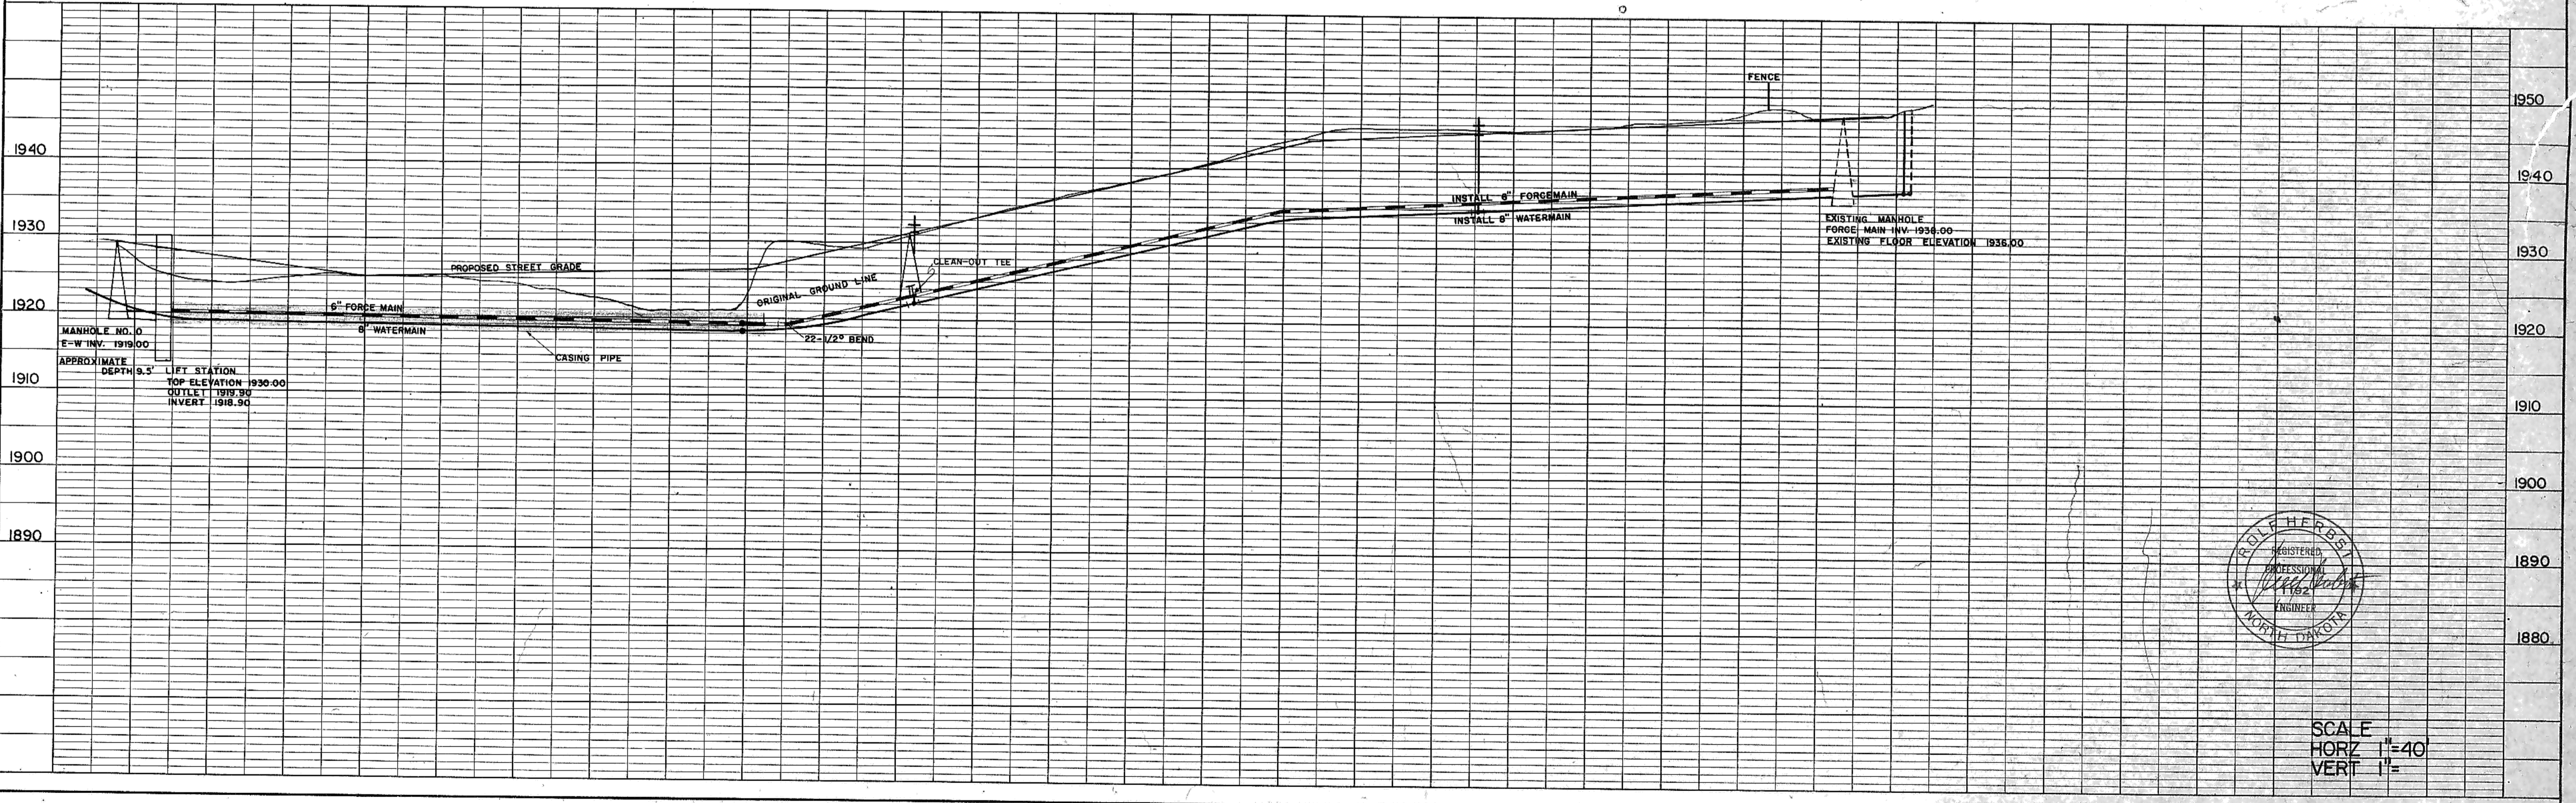

SCALE  
HORIZ 1"=40'  
VERT 1"=