



DATE
BY
SUPERVISOR
PLAN
NOTE BOOK
NO. OF WAY CHECKED
NO.

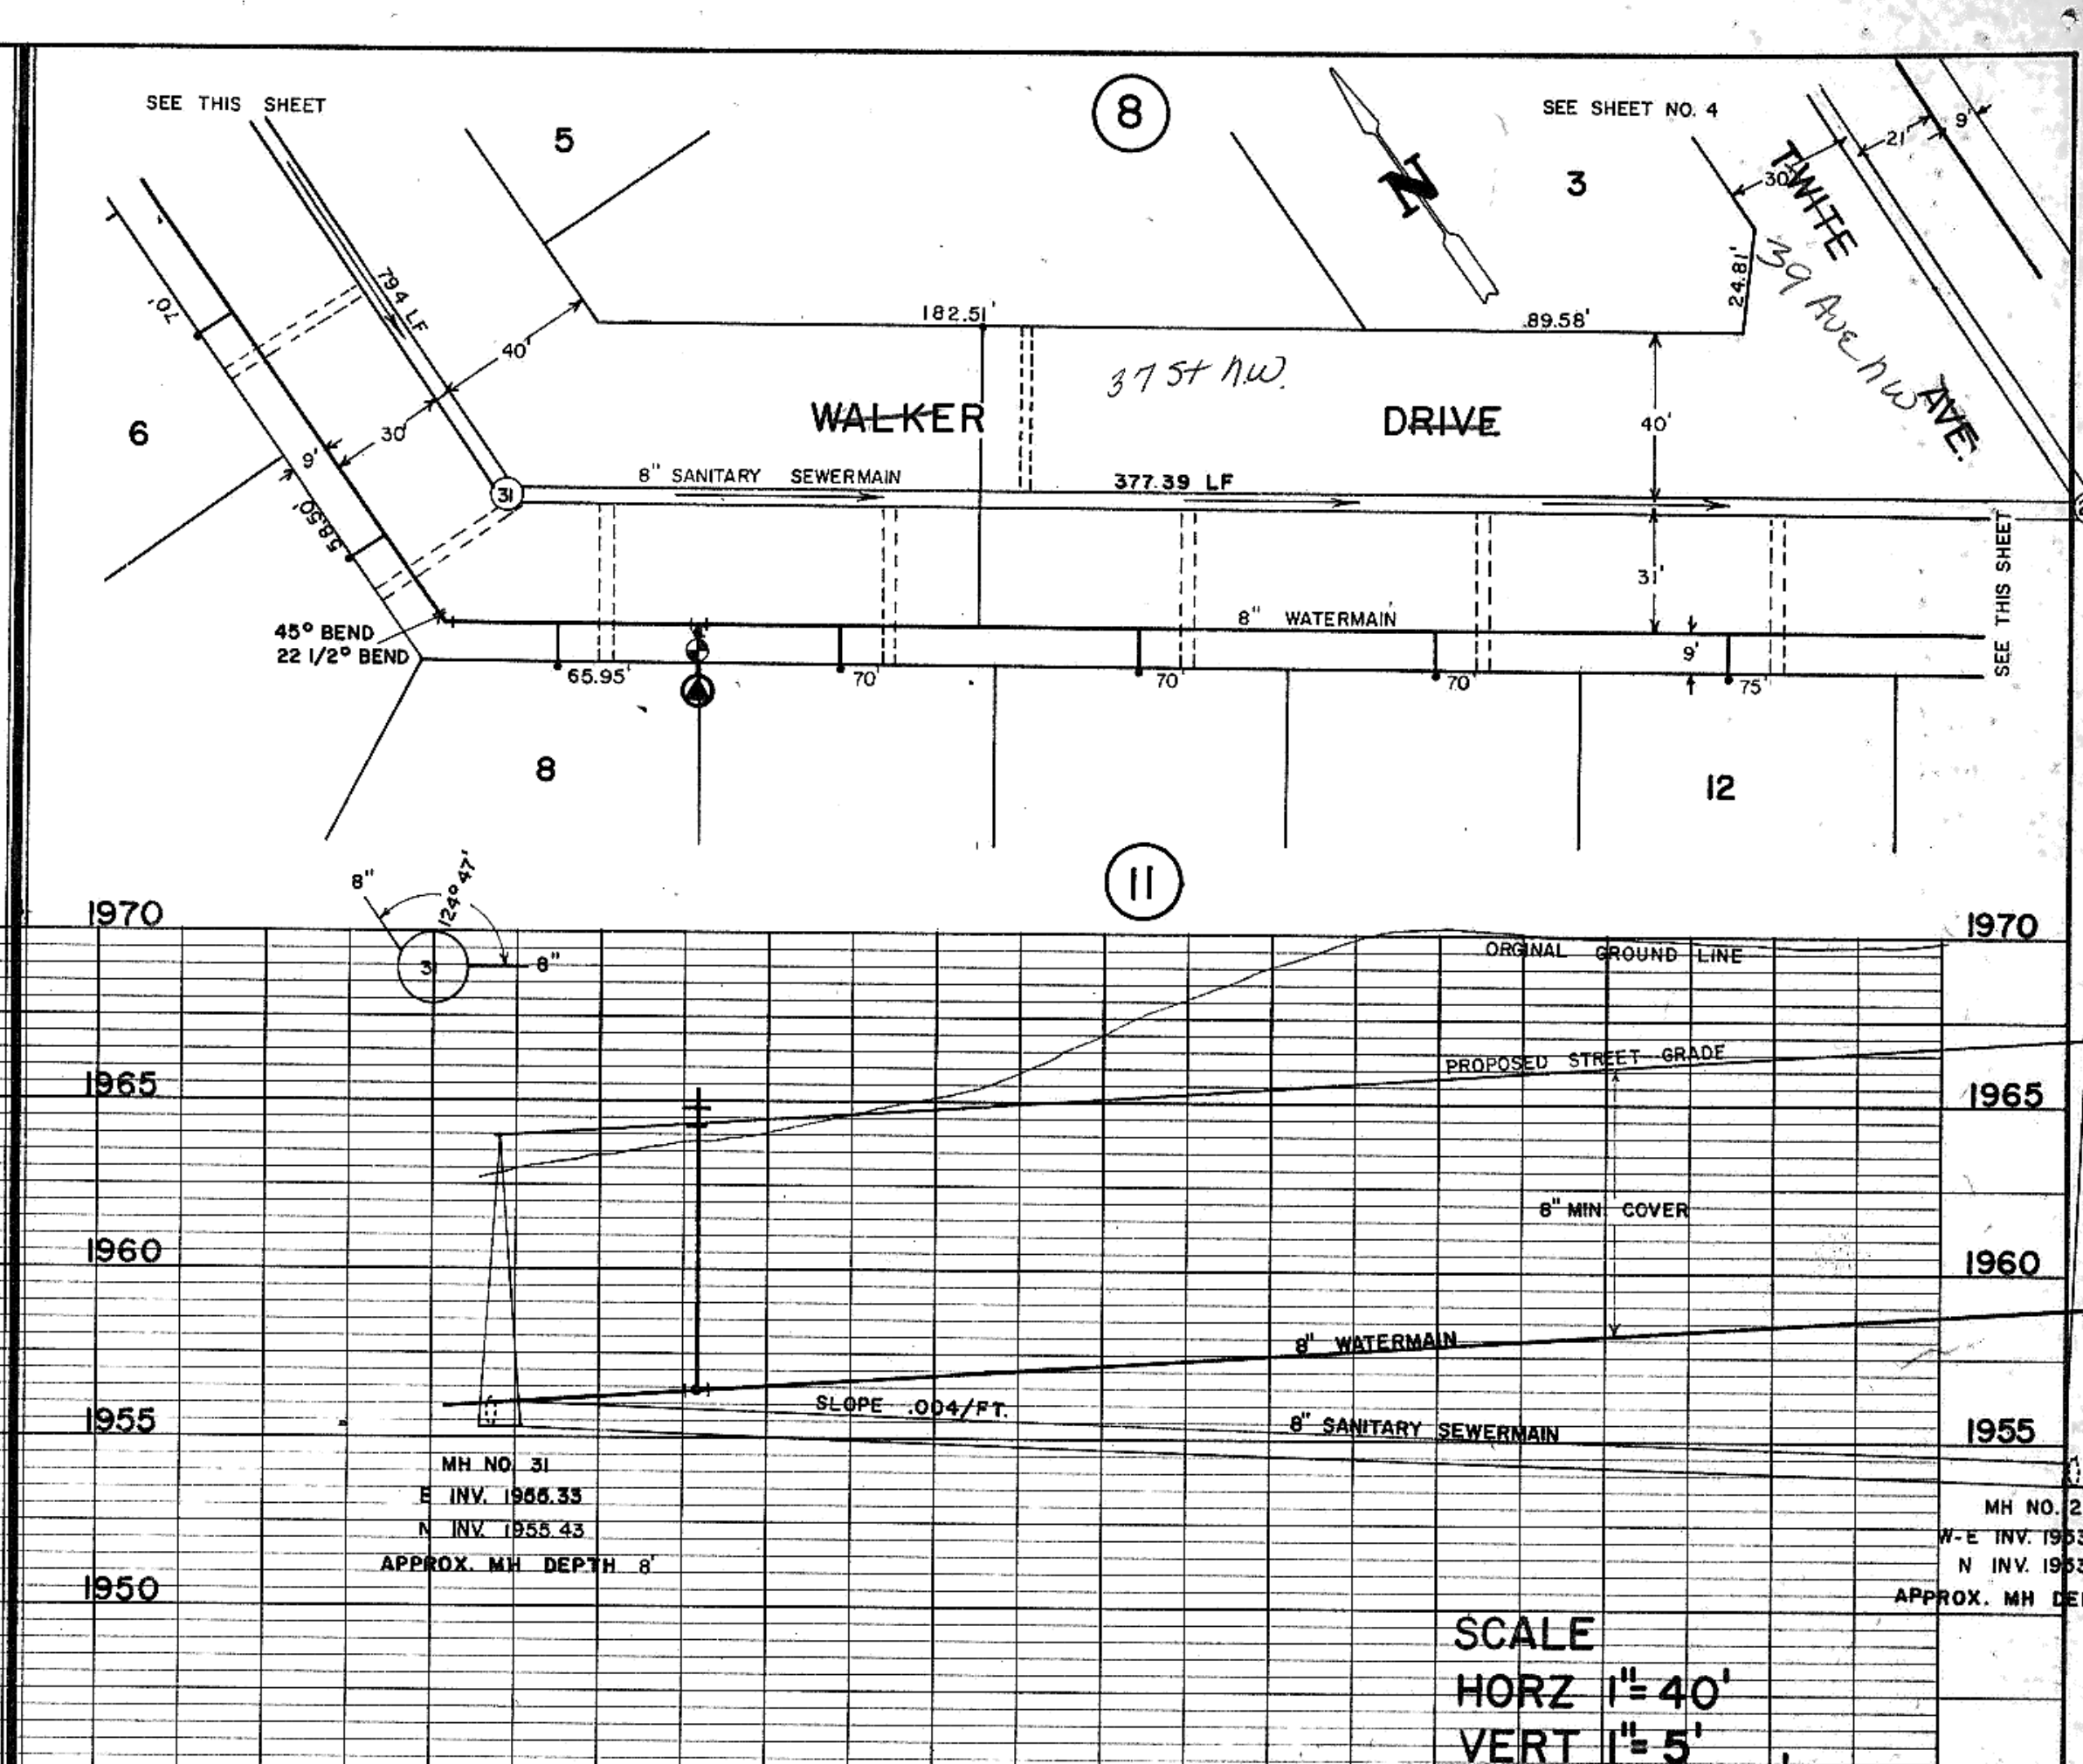

DATE
BY
SUPERVISOR
PROFILE
NOTE BOOK
NO. OF WAY CHECKED
NO.

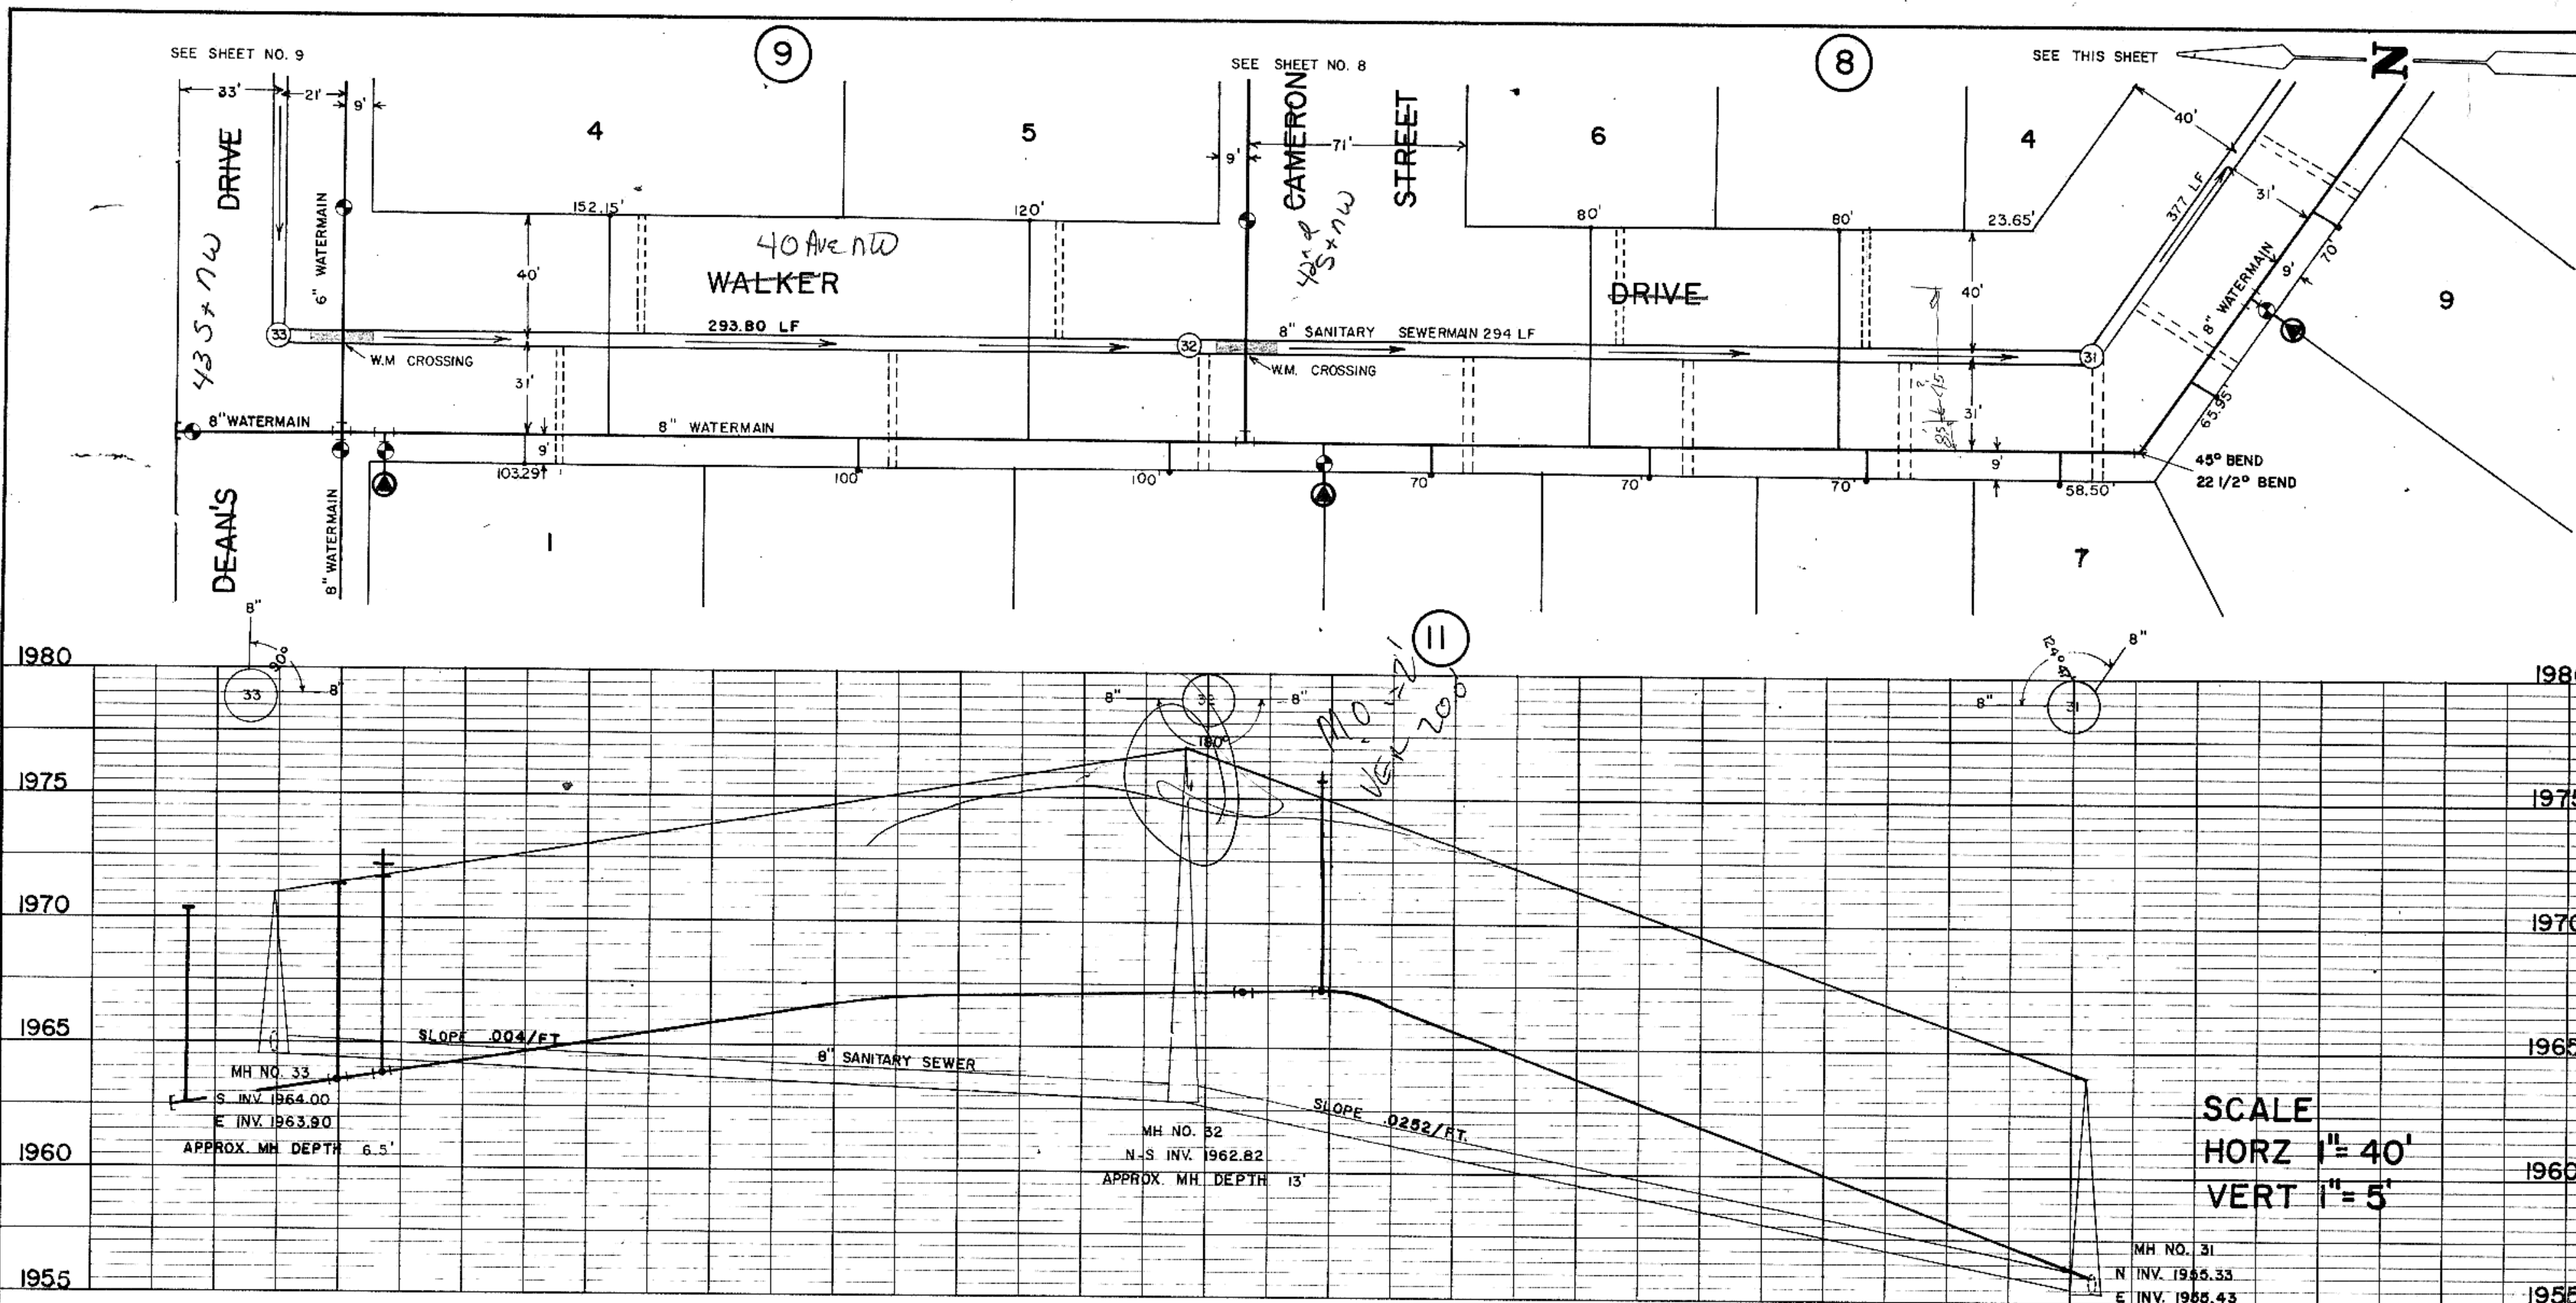