



PLAN
NOTE BOOK
No.

NOTE BOOK
No.

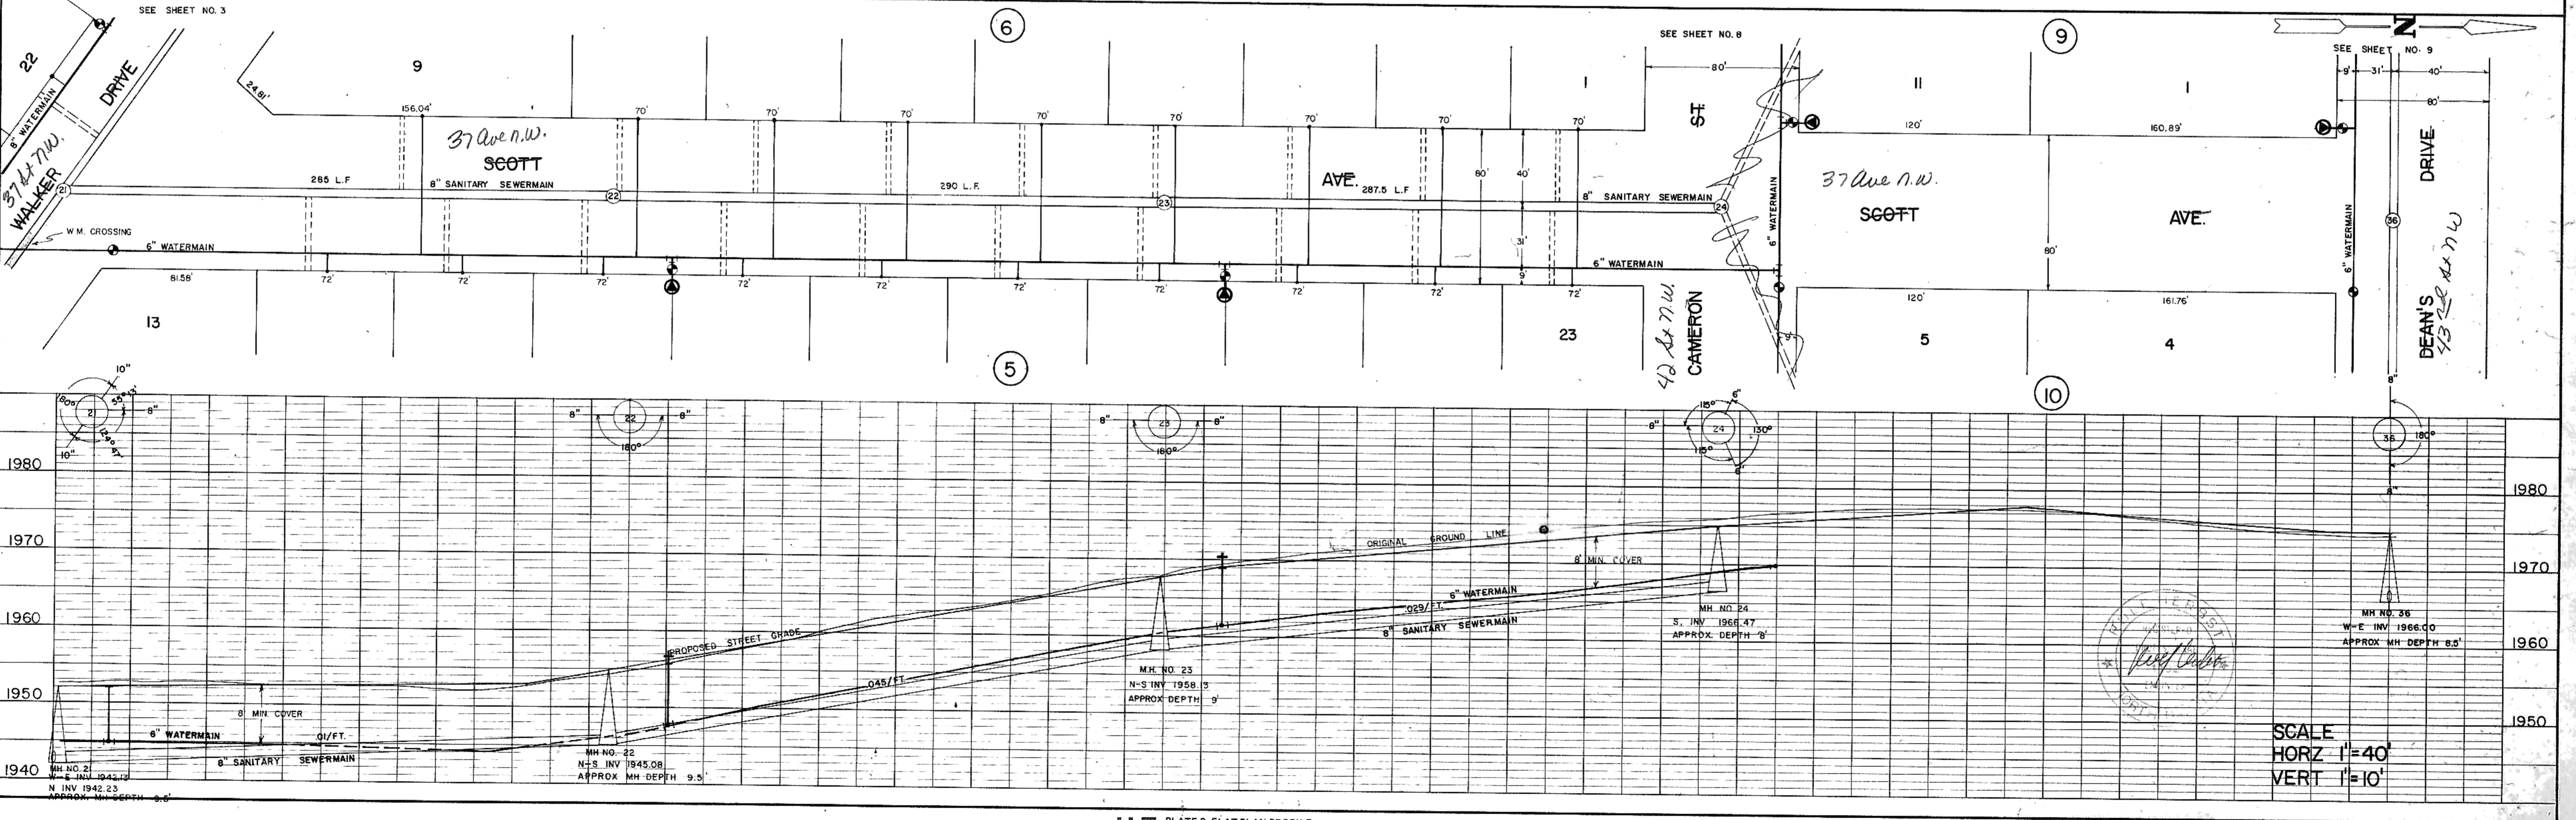

SCALE
HORIZ 1"=40'
VERT 1"=10'

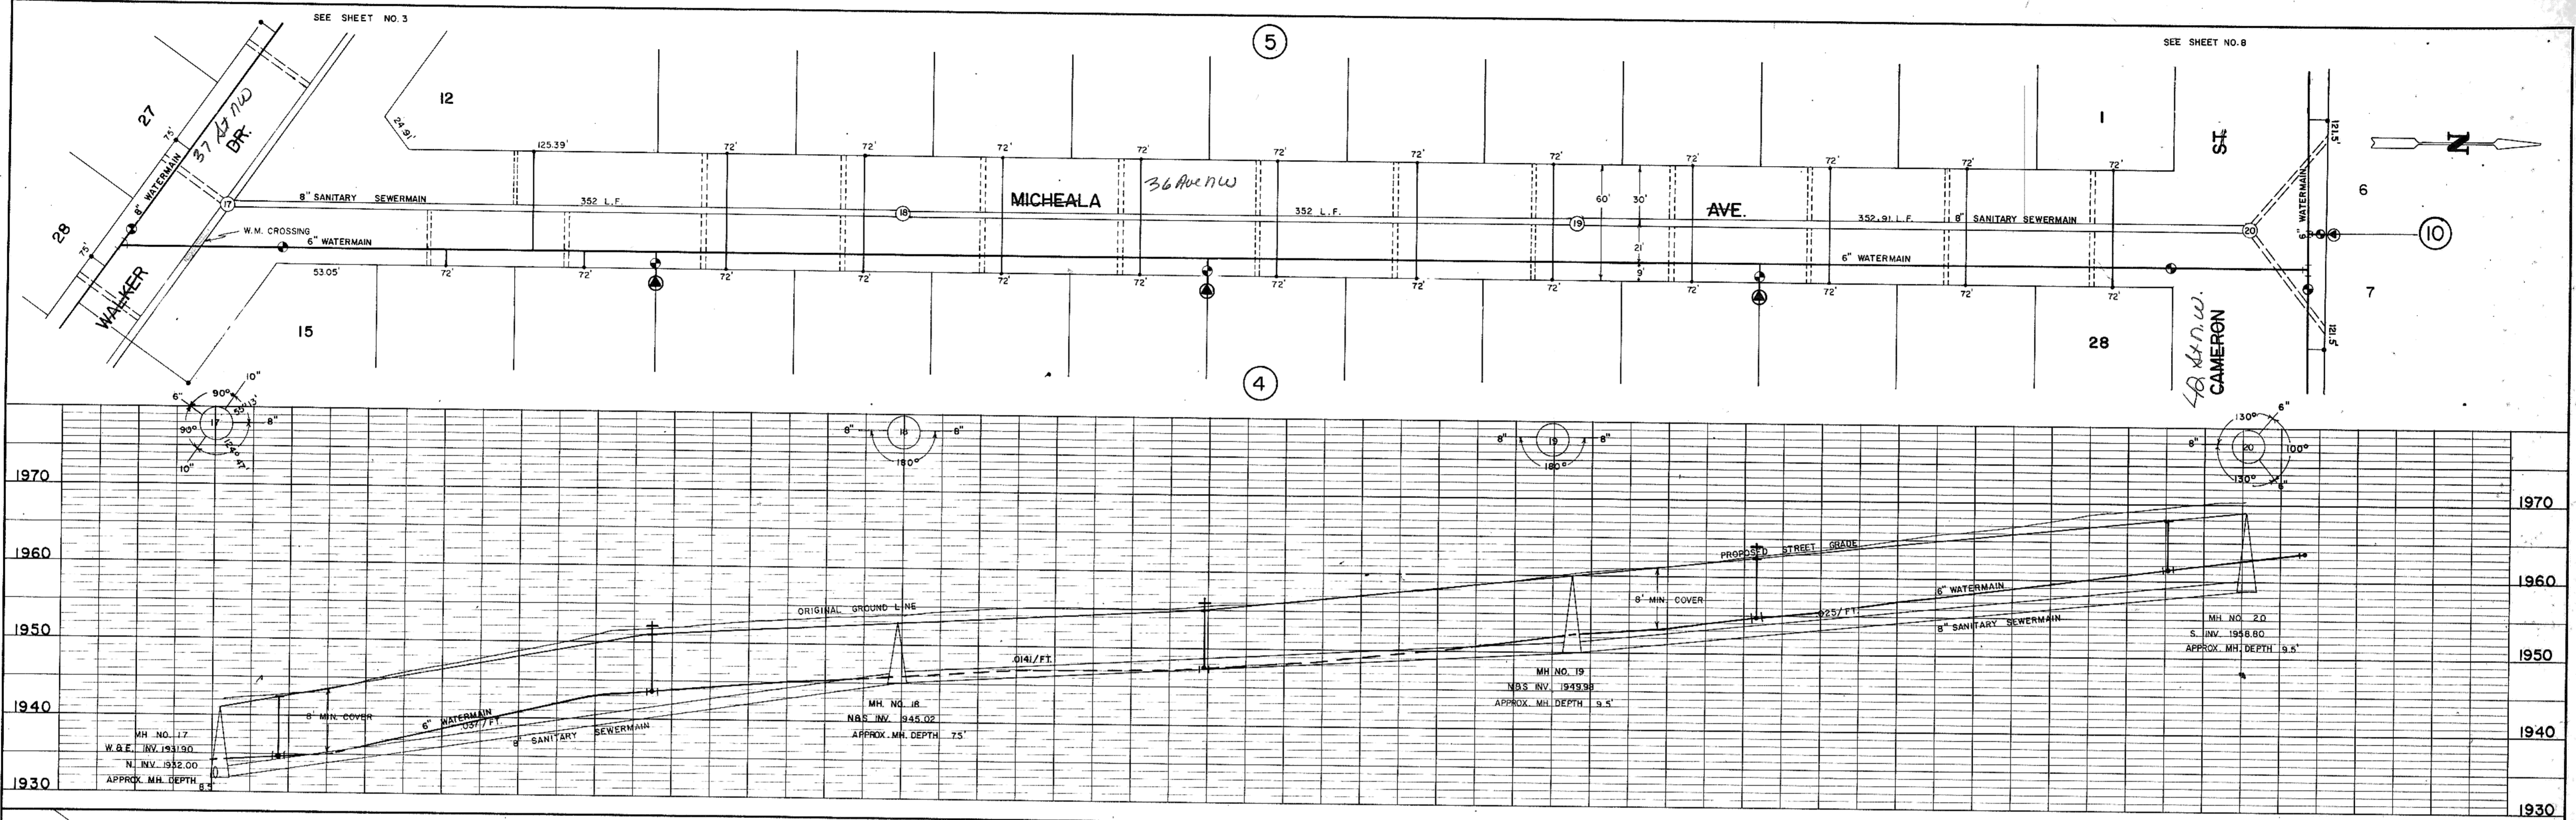