
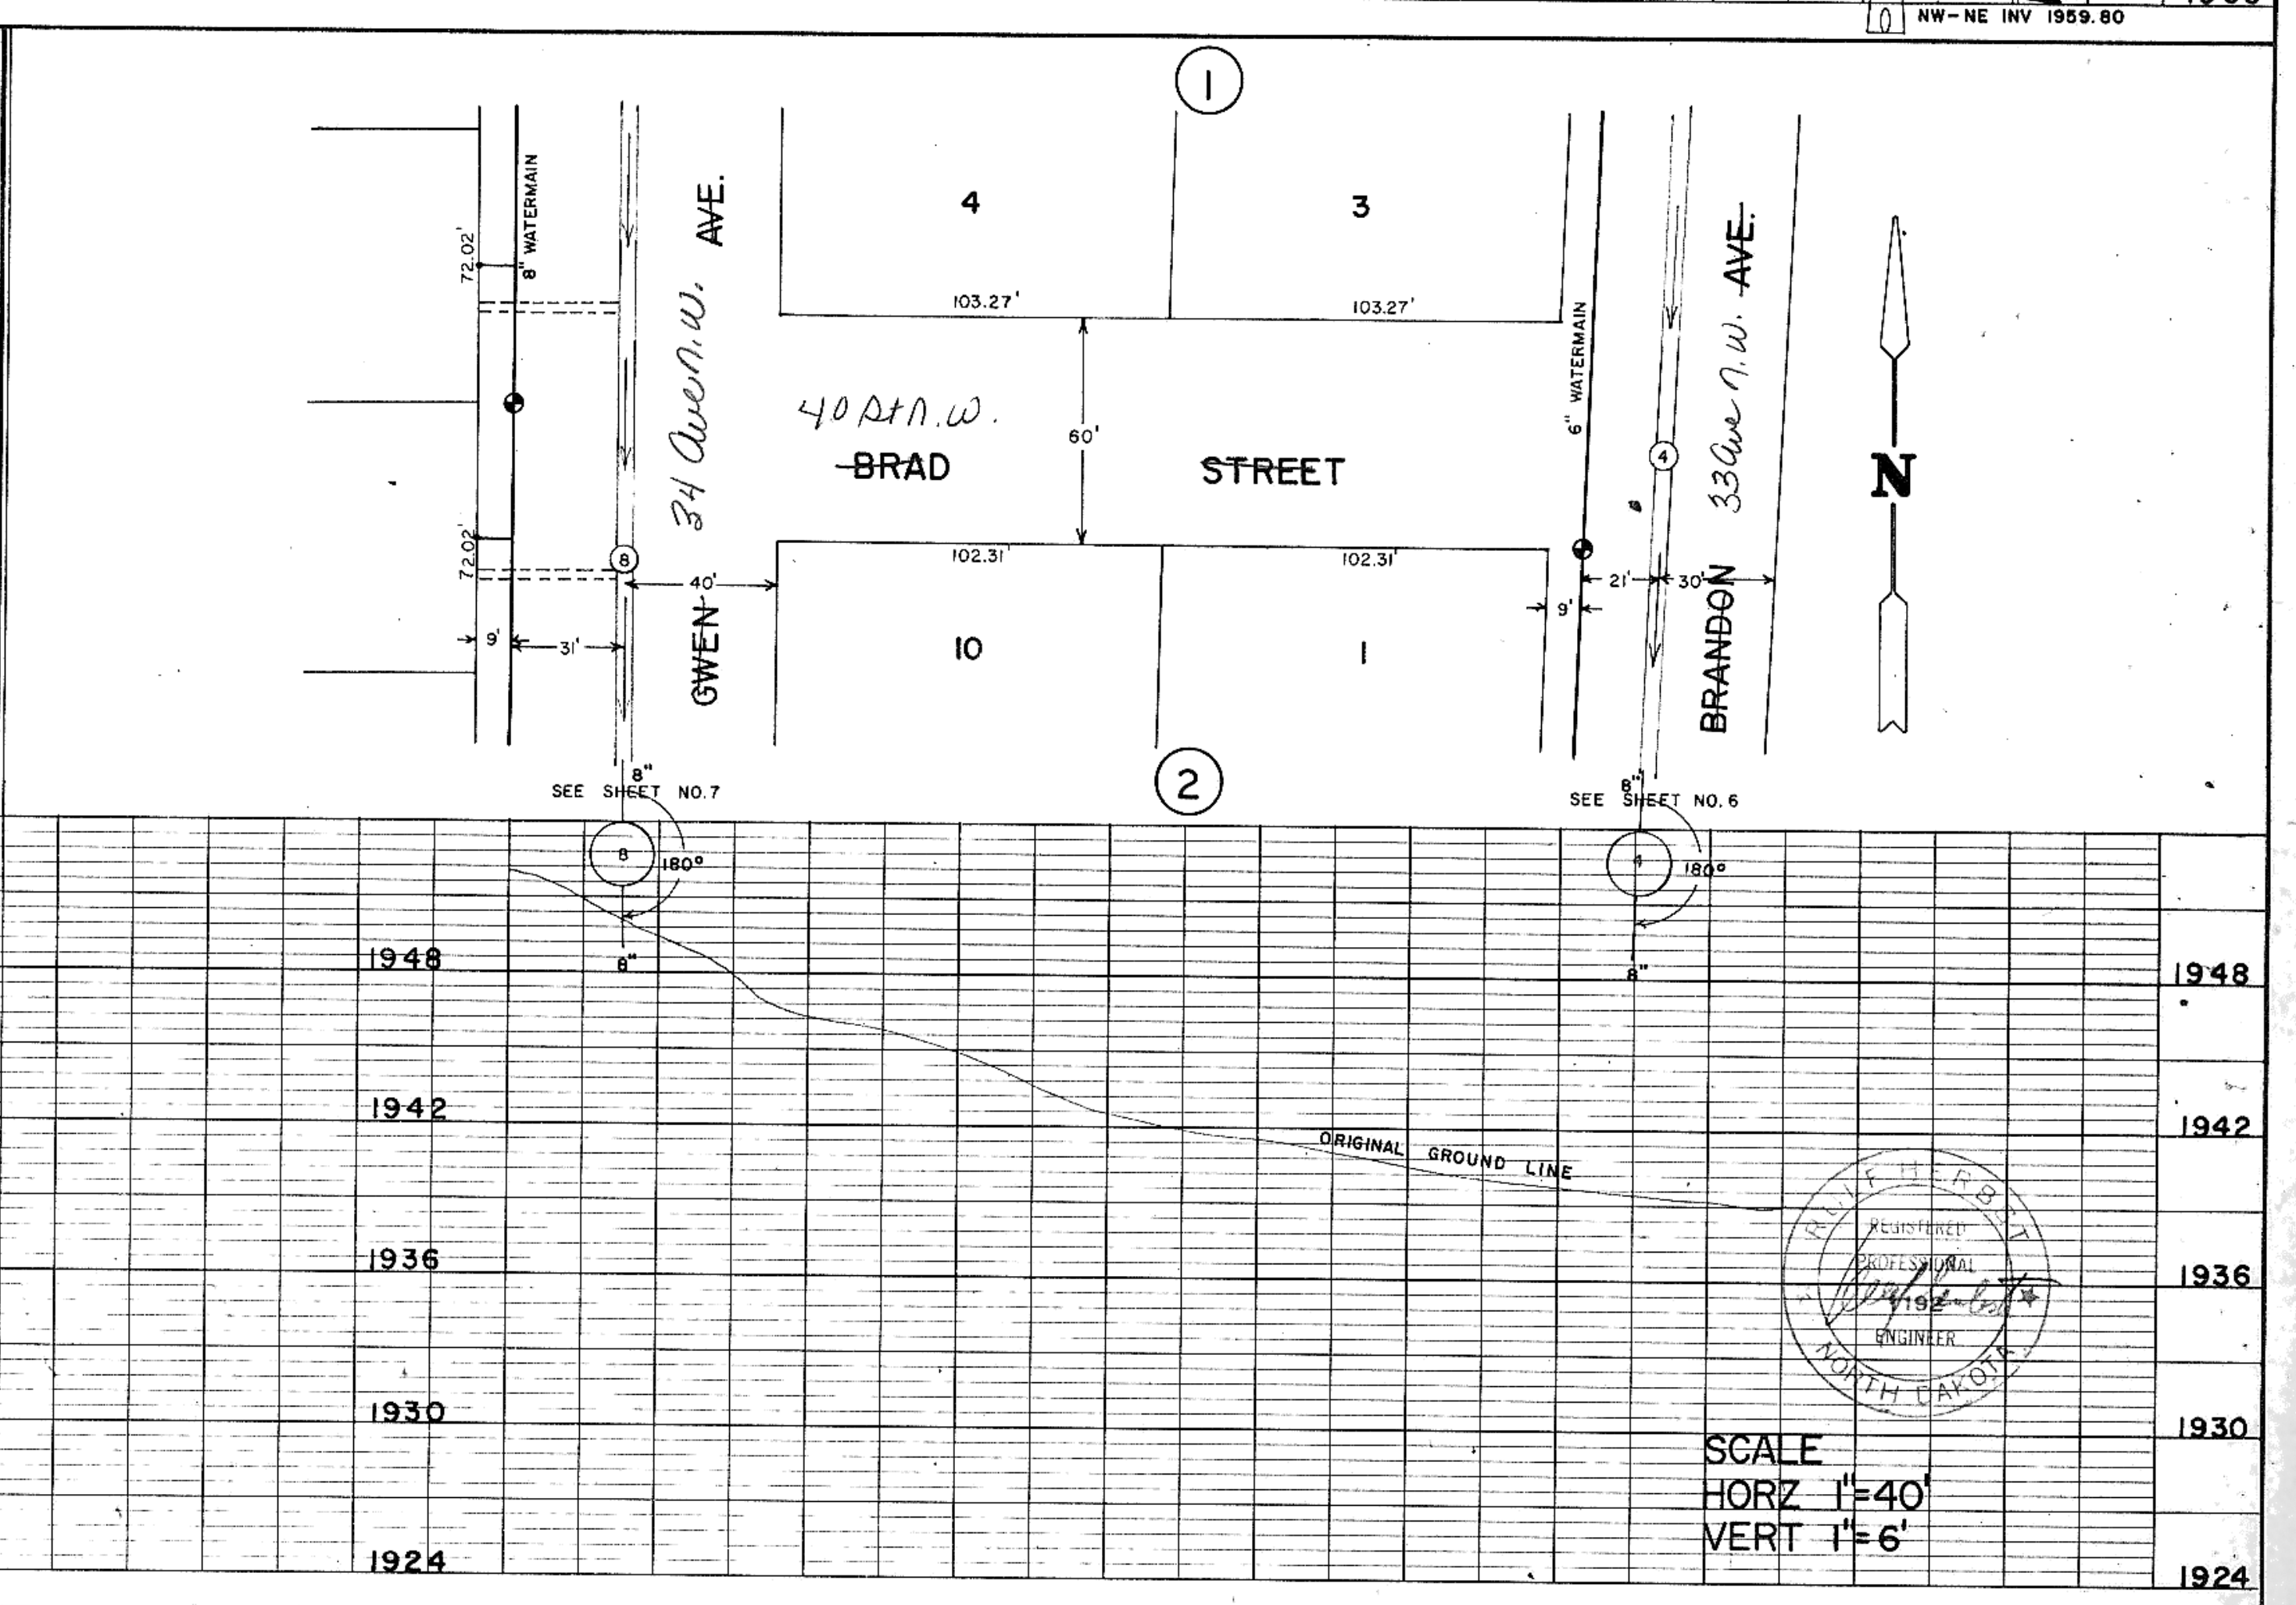
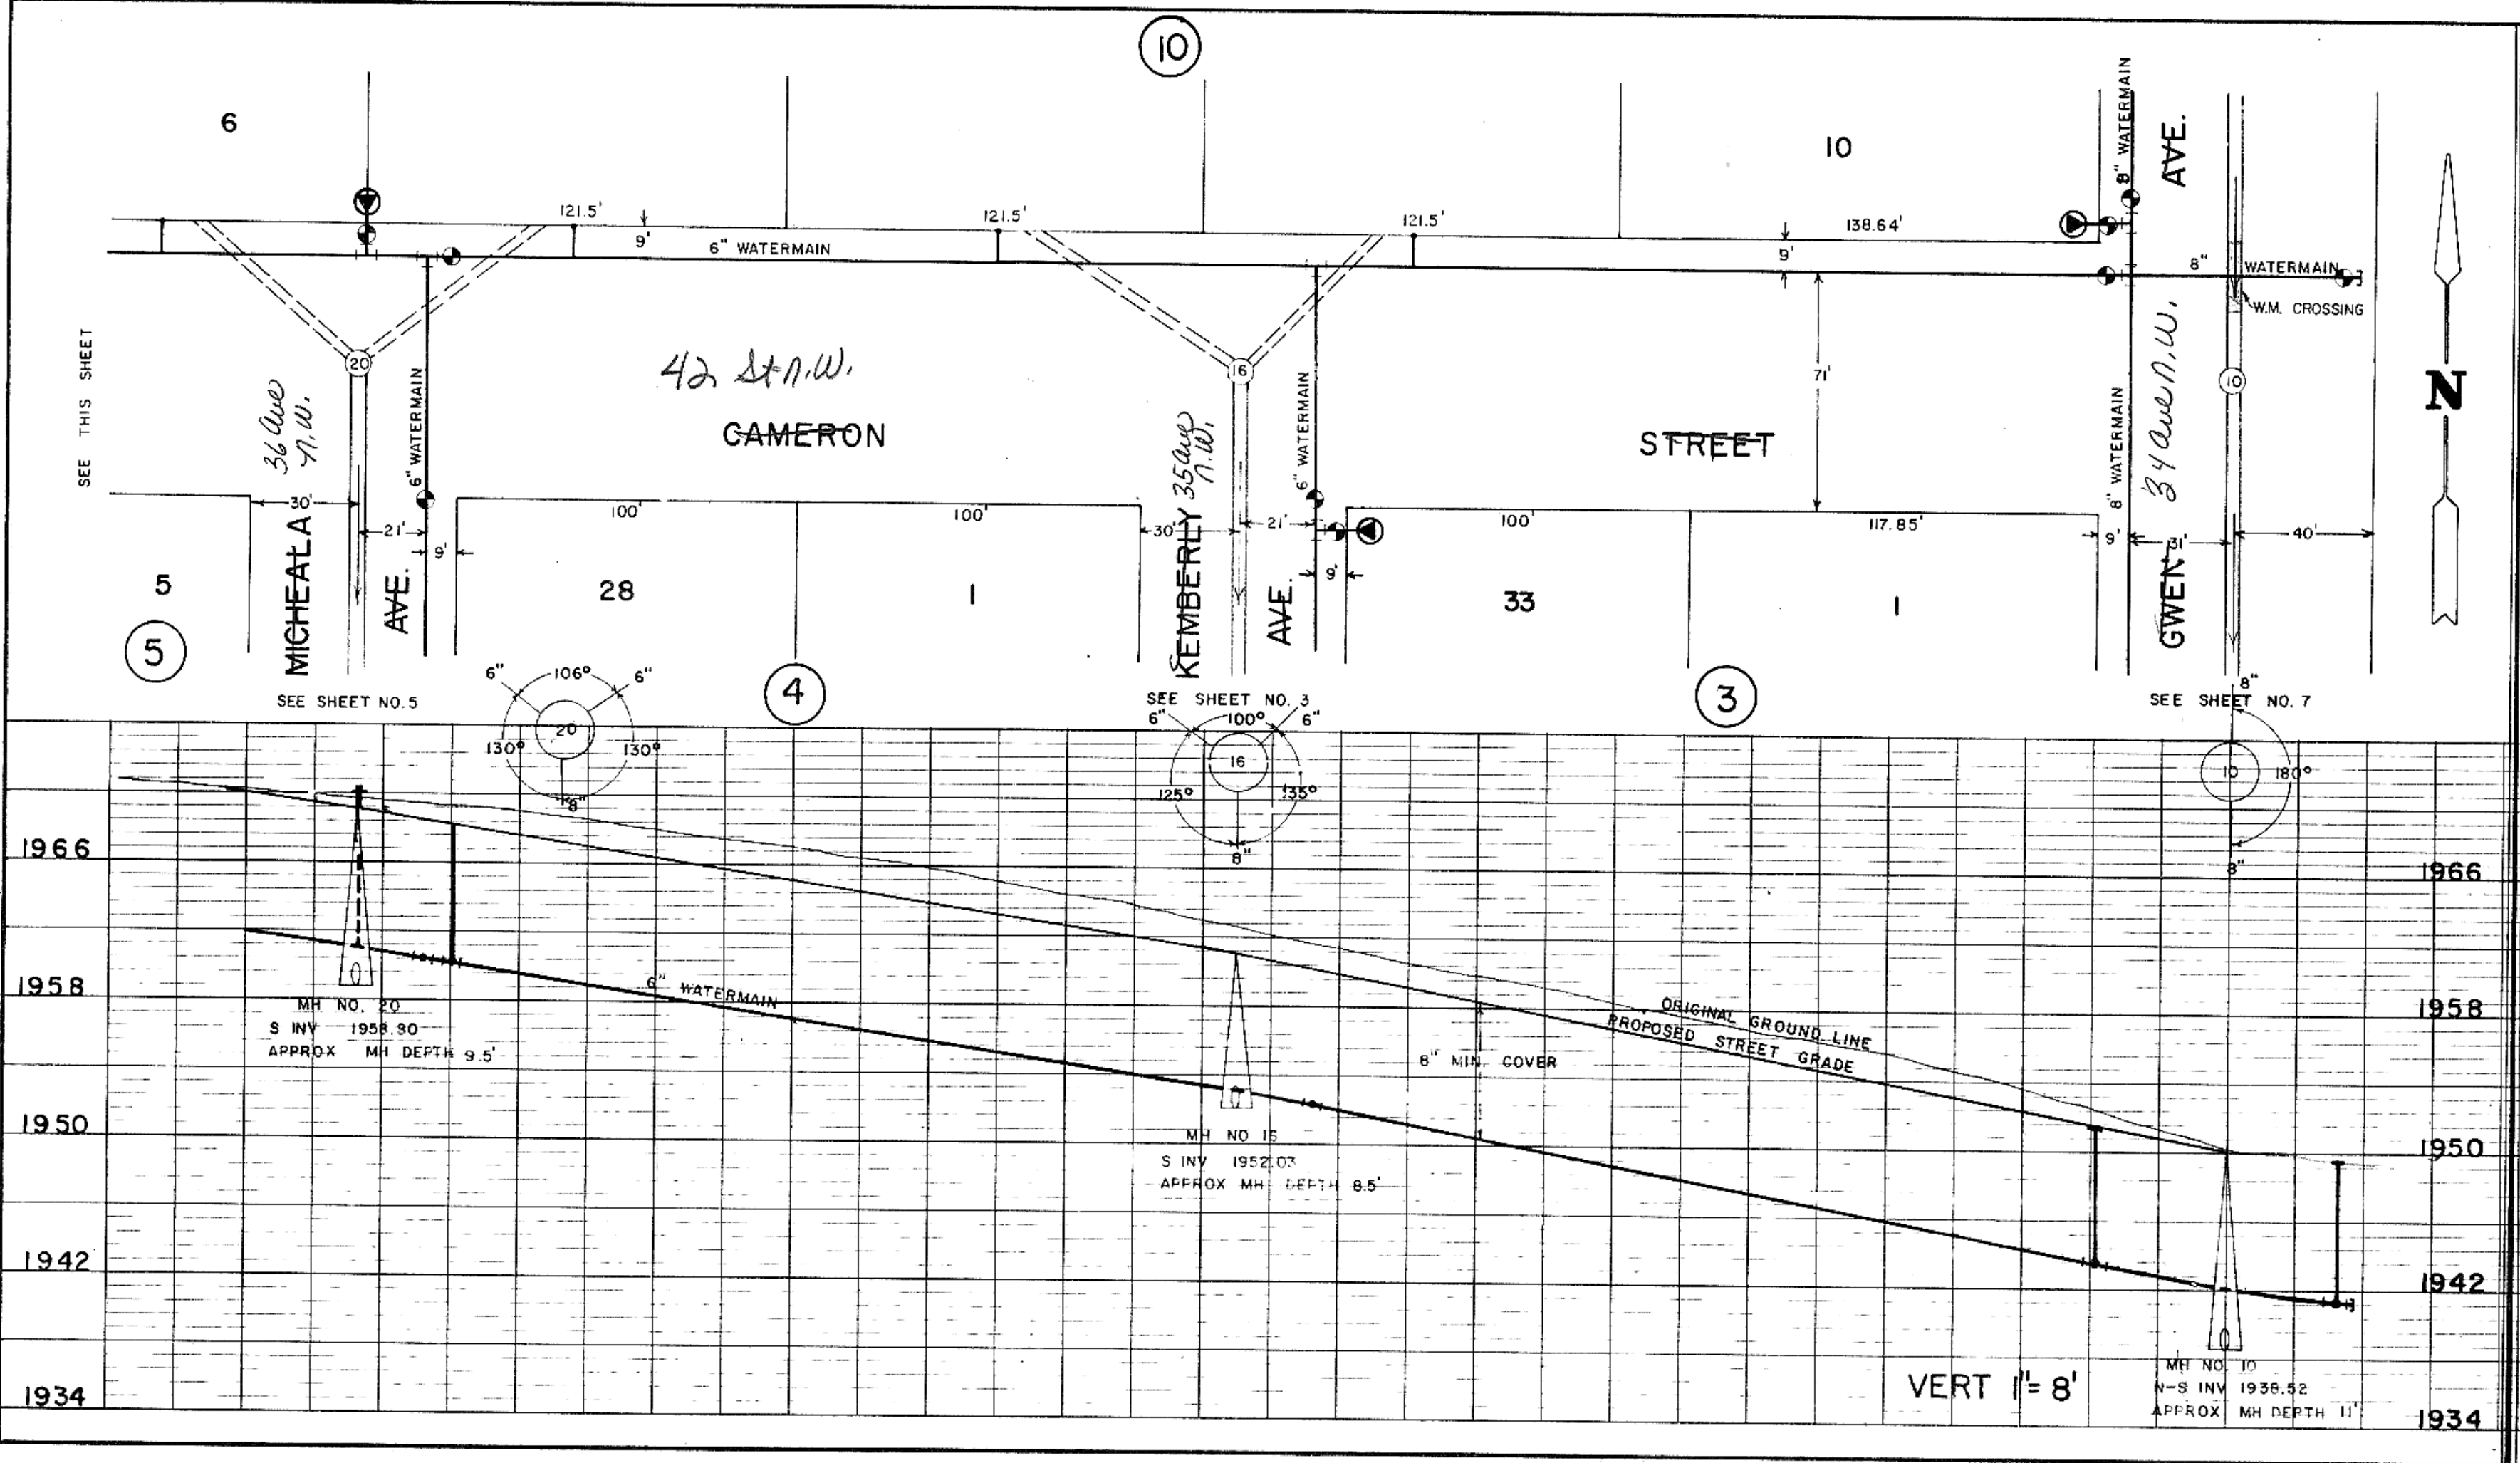


NOTE BOOK ALIGNMENT CHECKER
No. of W.M. CHECKED

NOTE BOOK STRUCTURE NOTATIONS CHECKED
No.

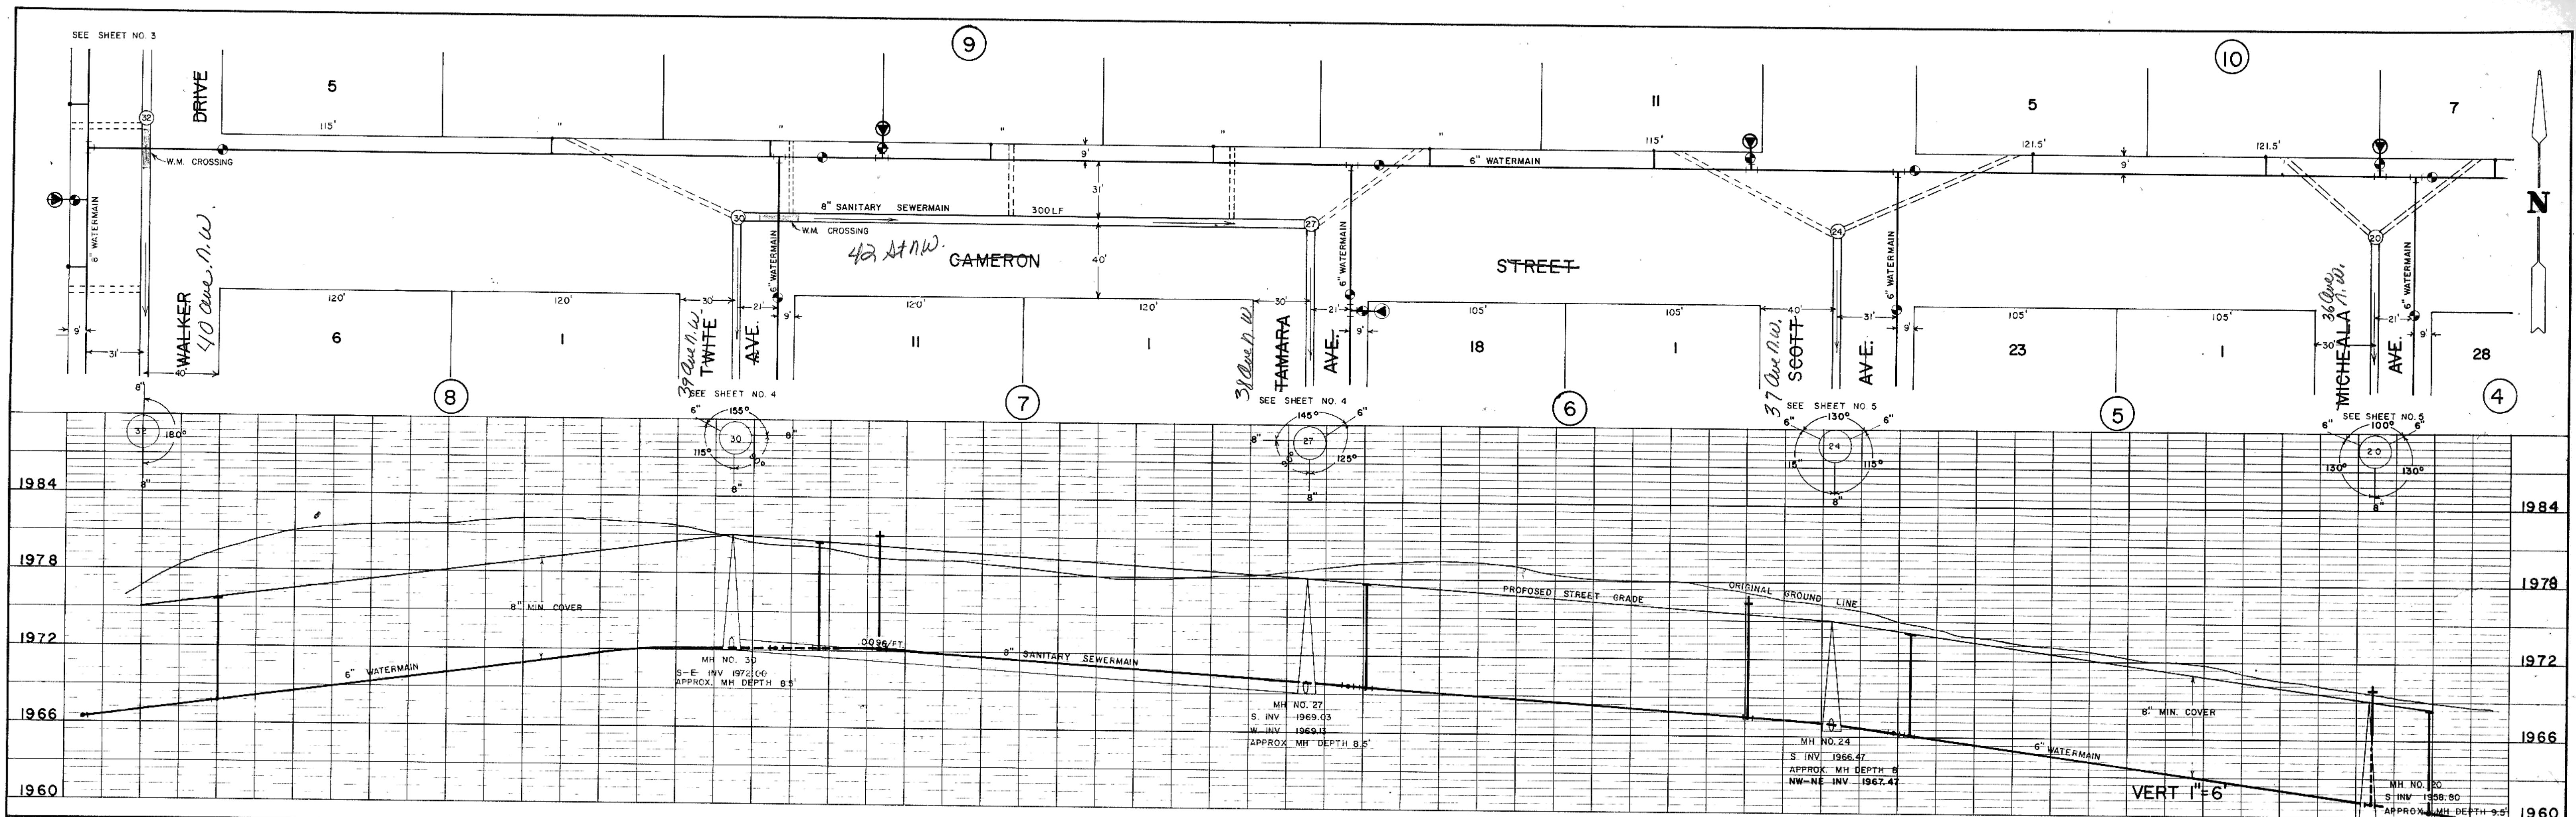

K&E PLATE 2, FLAT PLAN-PROFILE
KUFFEL & ESSER CO.
48 7032 MADE IN U.S.A.

Toman Engineering Company
Civil & Environmental Consultants
P. O. Box 708 P. O. Box 852
Mandan, ND Boisvein, Man RKO OEO
SHEET NO. 8 OF 12 SHEETS

