



DATE: \_\_\_\_\_ BY: \_\_\_\_\_  
 SURVEYED: \_\_\_\_\_  
 PLOTTED: \_\_\_\_\_  
 PLAN NOTE BOOK No. \_\_\_\_\_  
 ALIGNMENT CHECKED: \_\_\_\_\_  
 ALL DIMENSIONS CHECKED: \_\_\_\_\_

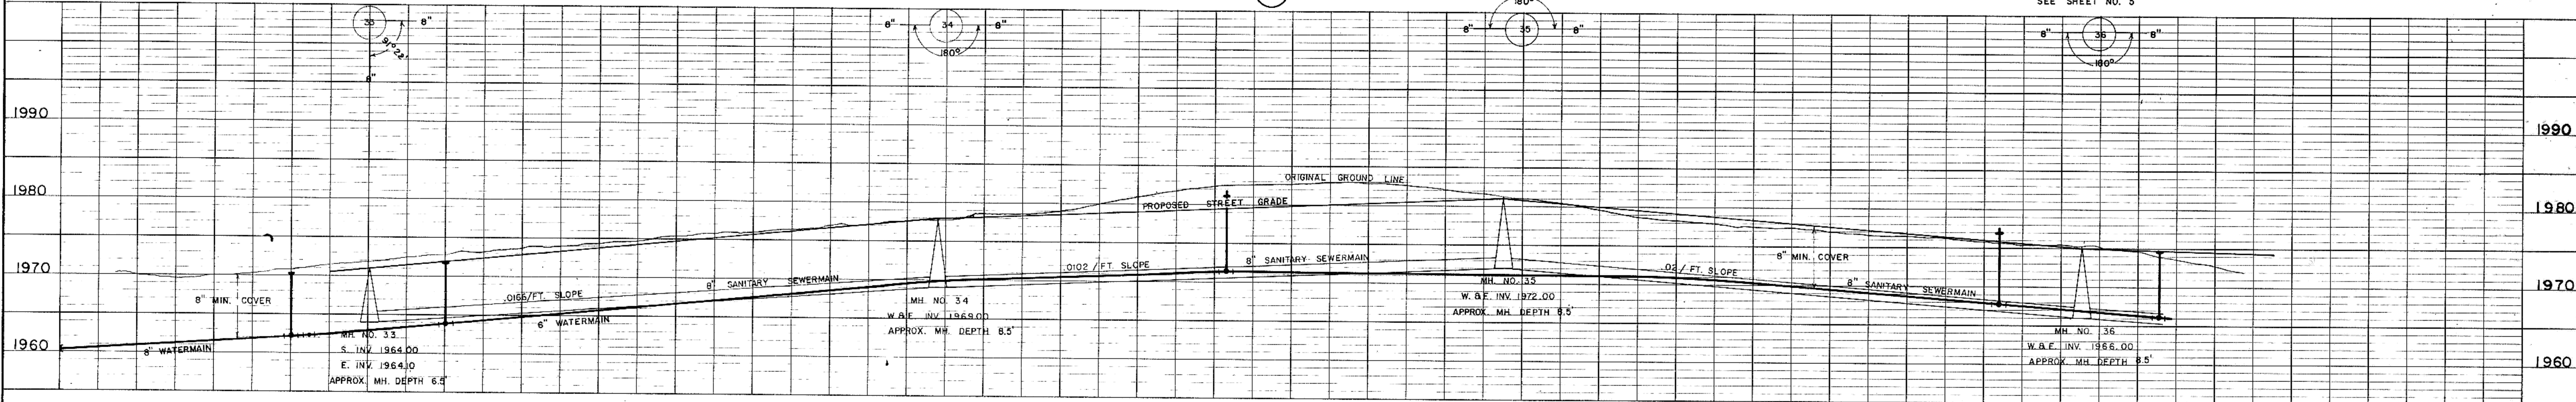

DATE: \_\_\_\_\_ BY: \_\_\_\_\_  
 SURVEYED: \_\_\_\_\_  
 PLOTTED: \_\_\_\_\_  
 PROFILE NOTE BOOK No. \_\_\_\_\_  
 ALIGNMENT CHECKED: \_\_\_\_\_  
 ALL DIMENSIONS CHECKED: \_\_\_\_\_

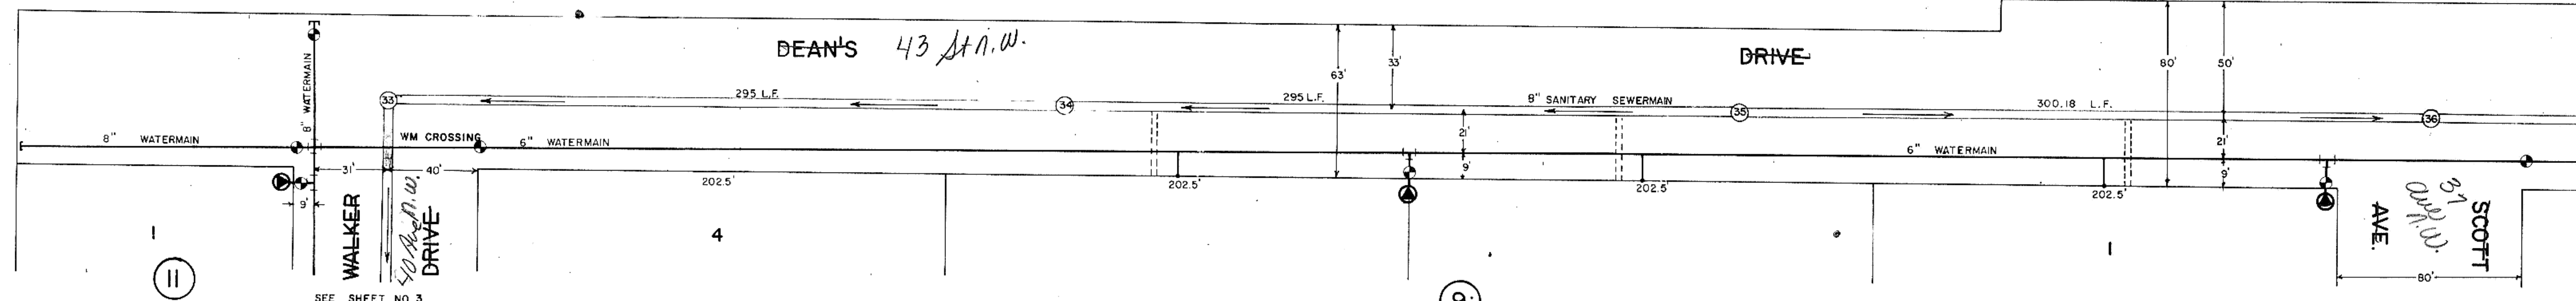