
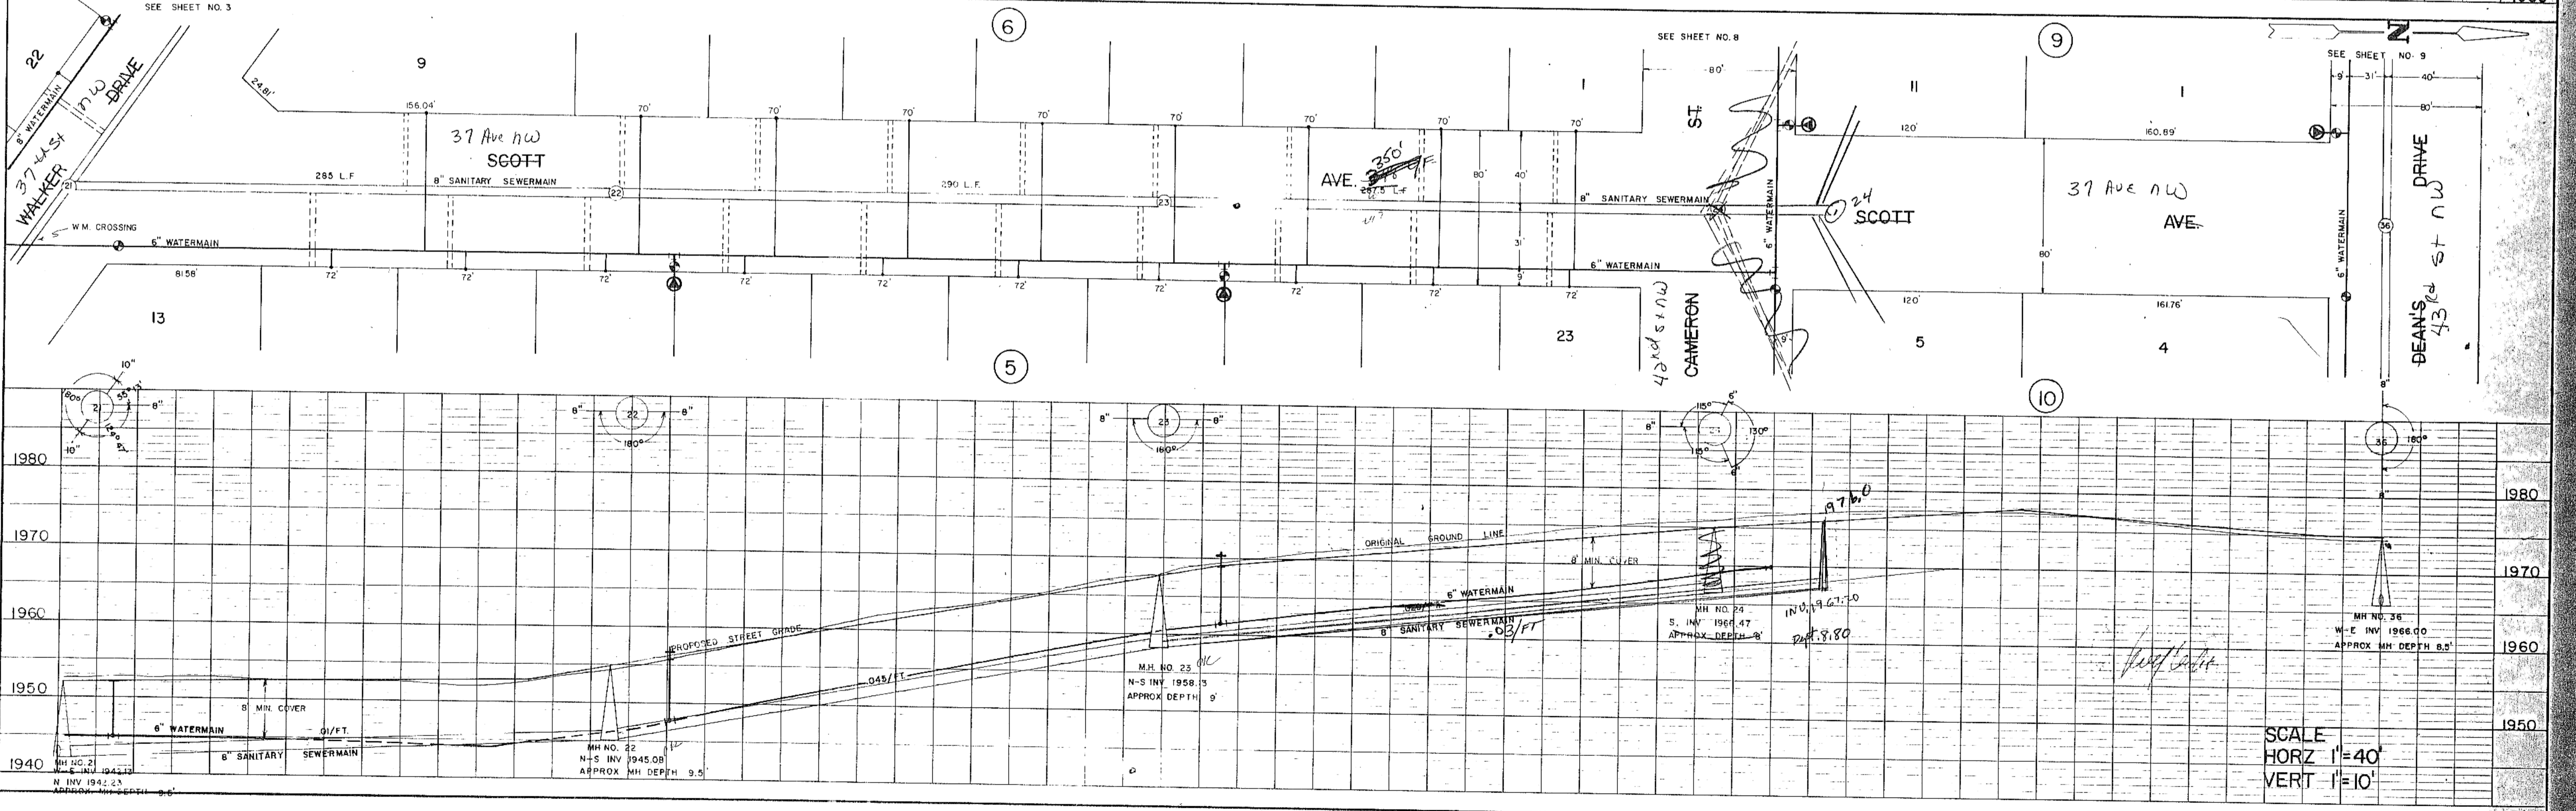


PLAN
 DRAWN BY: _____
 CHECKED BY: _____
 DATE: _____
 NOTE BOOK NO. _____
 ADJUSTMENT CHECKED BY: _____
 40' OF WAY CHECKED BY: _____

PROFILE
 DRAWN BY: _____
 CHECKED BY: _____
 DATE: _____
 NOTE BOOK NO. _____
 ADJUSTMENT CHECKED BY: _____
 40' OF WAY CHECKED BY: _____

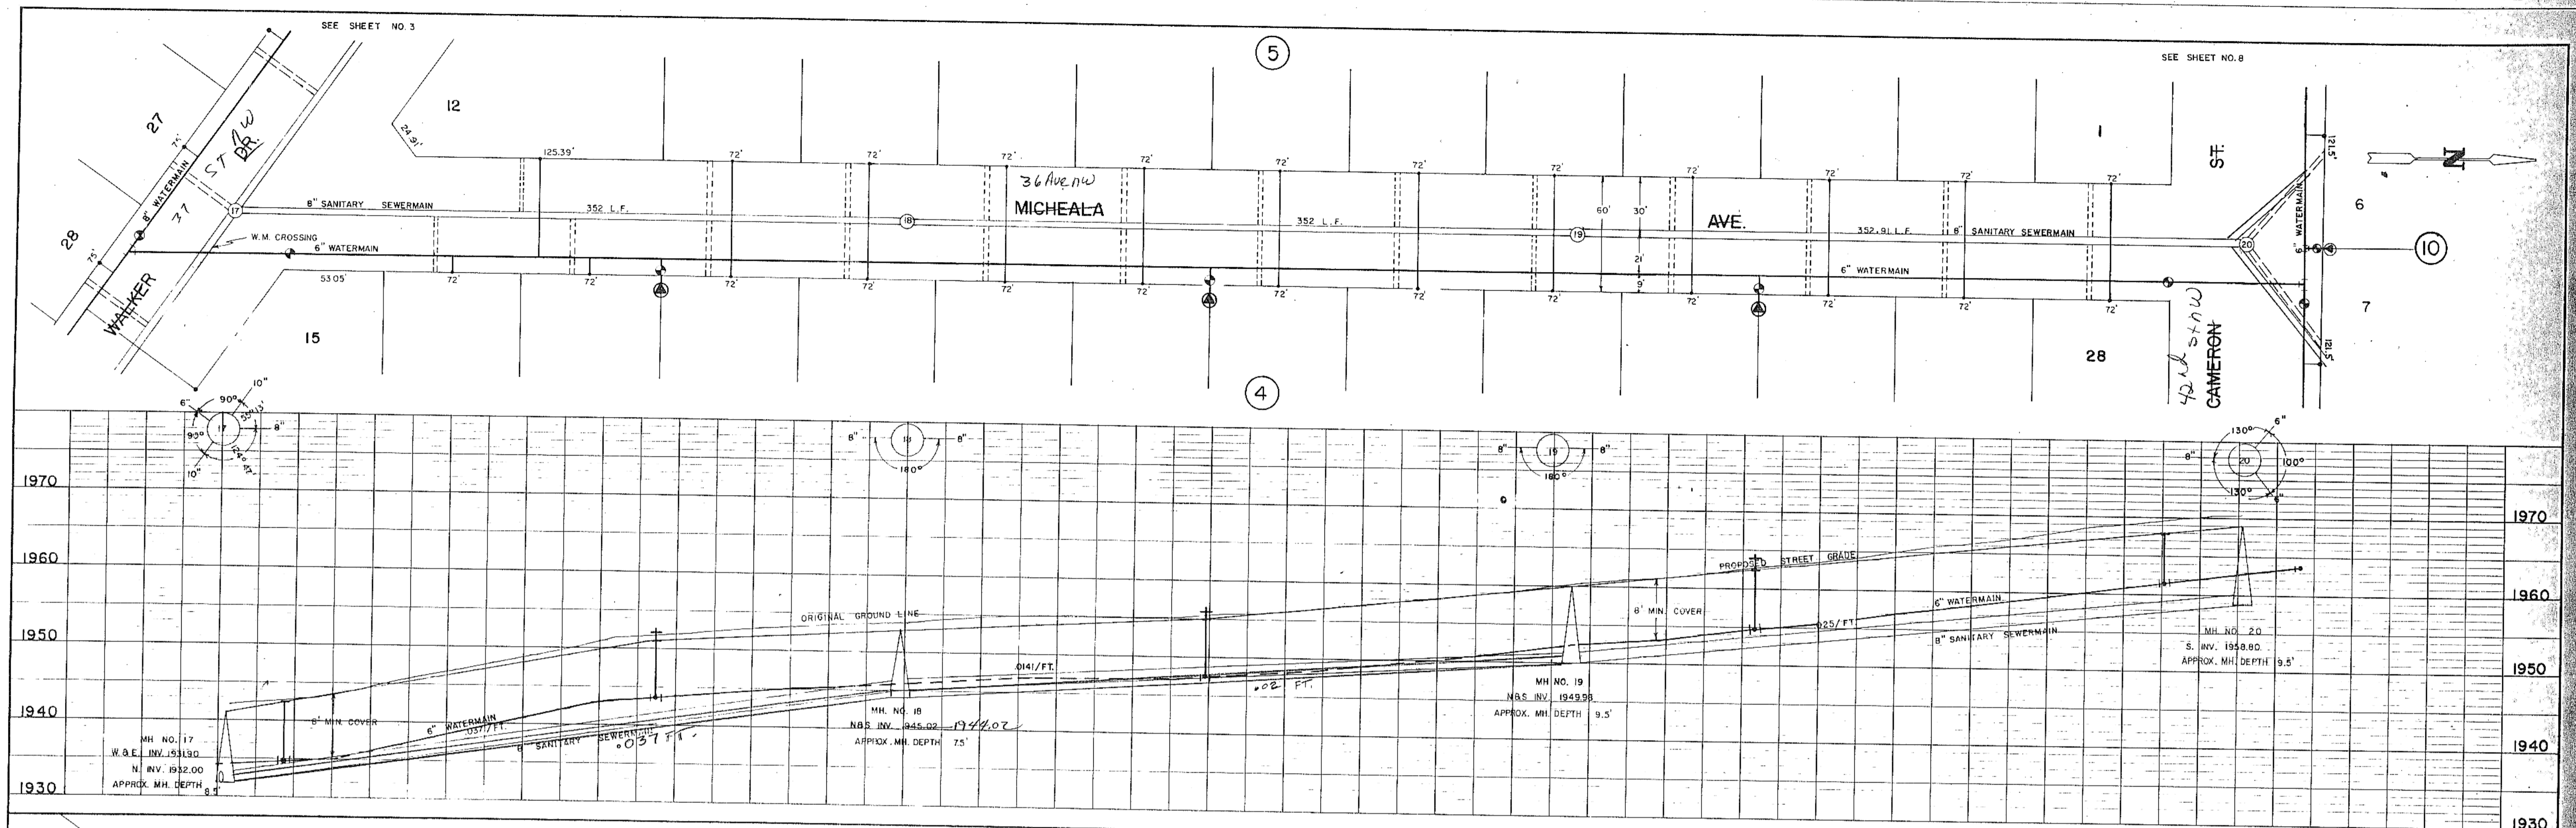

K&E PLATE 2, FLAT PLAN PROFILE
 KEUFEL & ESSER CO.
 48 7032 MADE IN U.S.A.

Toman Engineering Company
 Civil & Environmental Consultants
 P. O. Box 703 Mandan, ND 58040
 SHEET NO. 5 OF 12 SHEETS

SCALE
 HORIZ 1"=40'
 VERT 1"=10'