


DATE	
BY	
REVISIONS	
NOTED	
ALIGNMENT CHECKED	
NOTE BOOK	
NO.	
DATE	
BY	
REVISIONS	
NOTED	
ALIGNMENT CHECKED	
NOTE BOOK	
NO.	

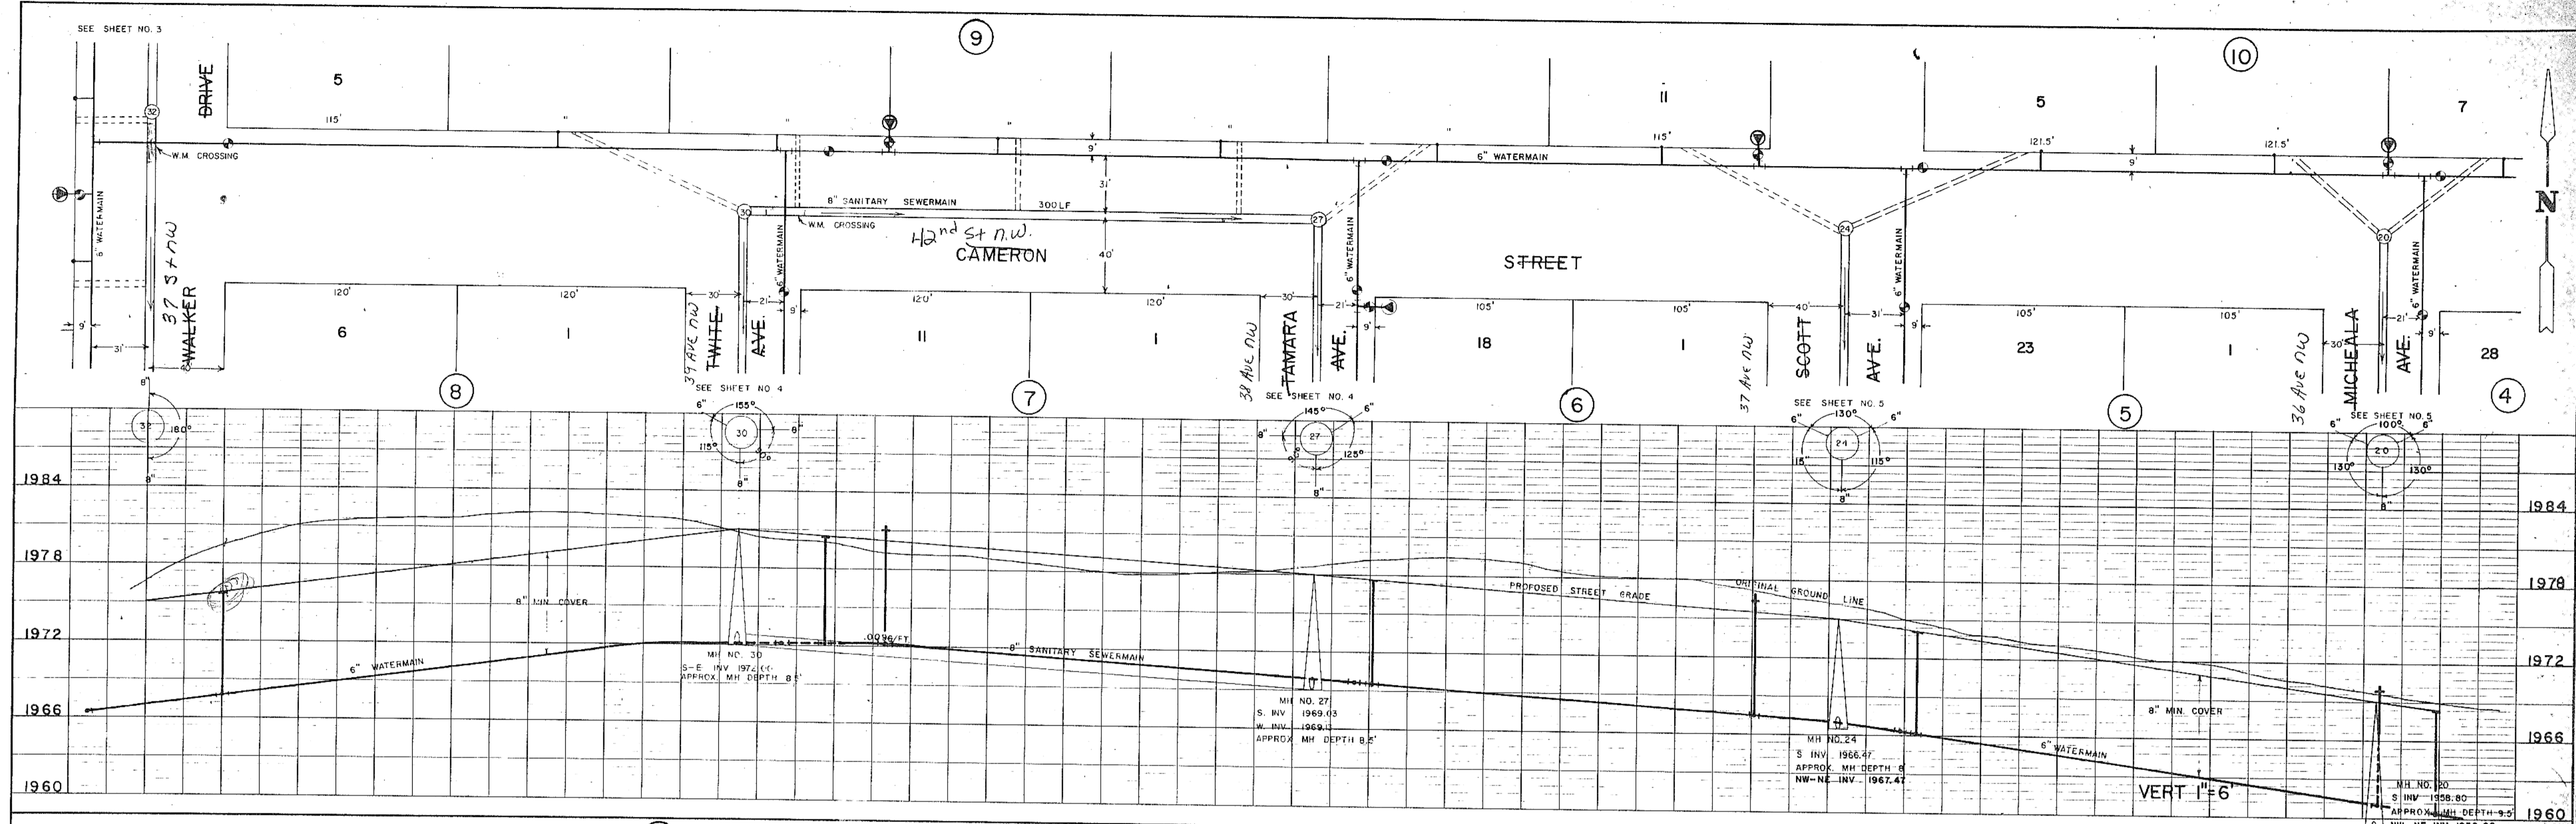

DATE	
BY	
REVISIONS	
NOTED	
ALIGNMENT CHECKED	
NOTE BOOK	
NO.	
DATE	
BY	
REVISIONS	
NOTED	
ALIGNMENT CHECKED	
NOTE BOOK	
NO.	

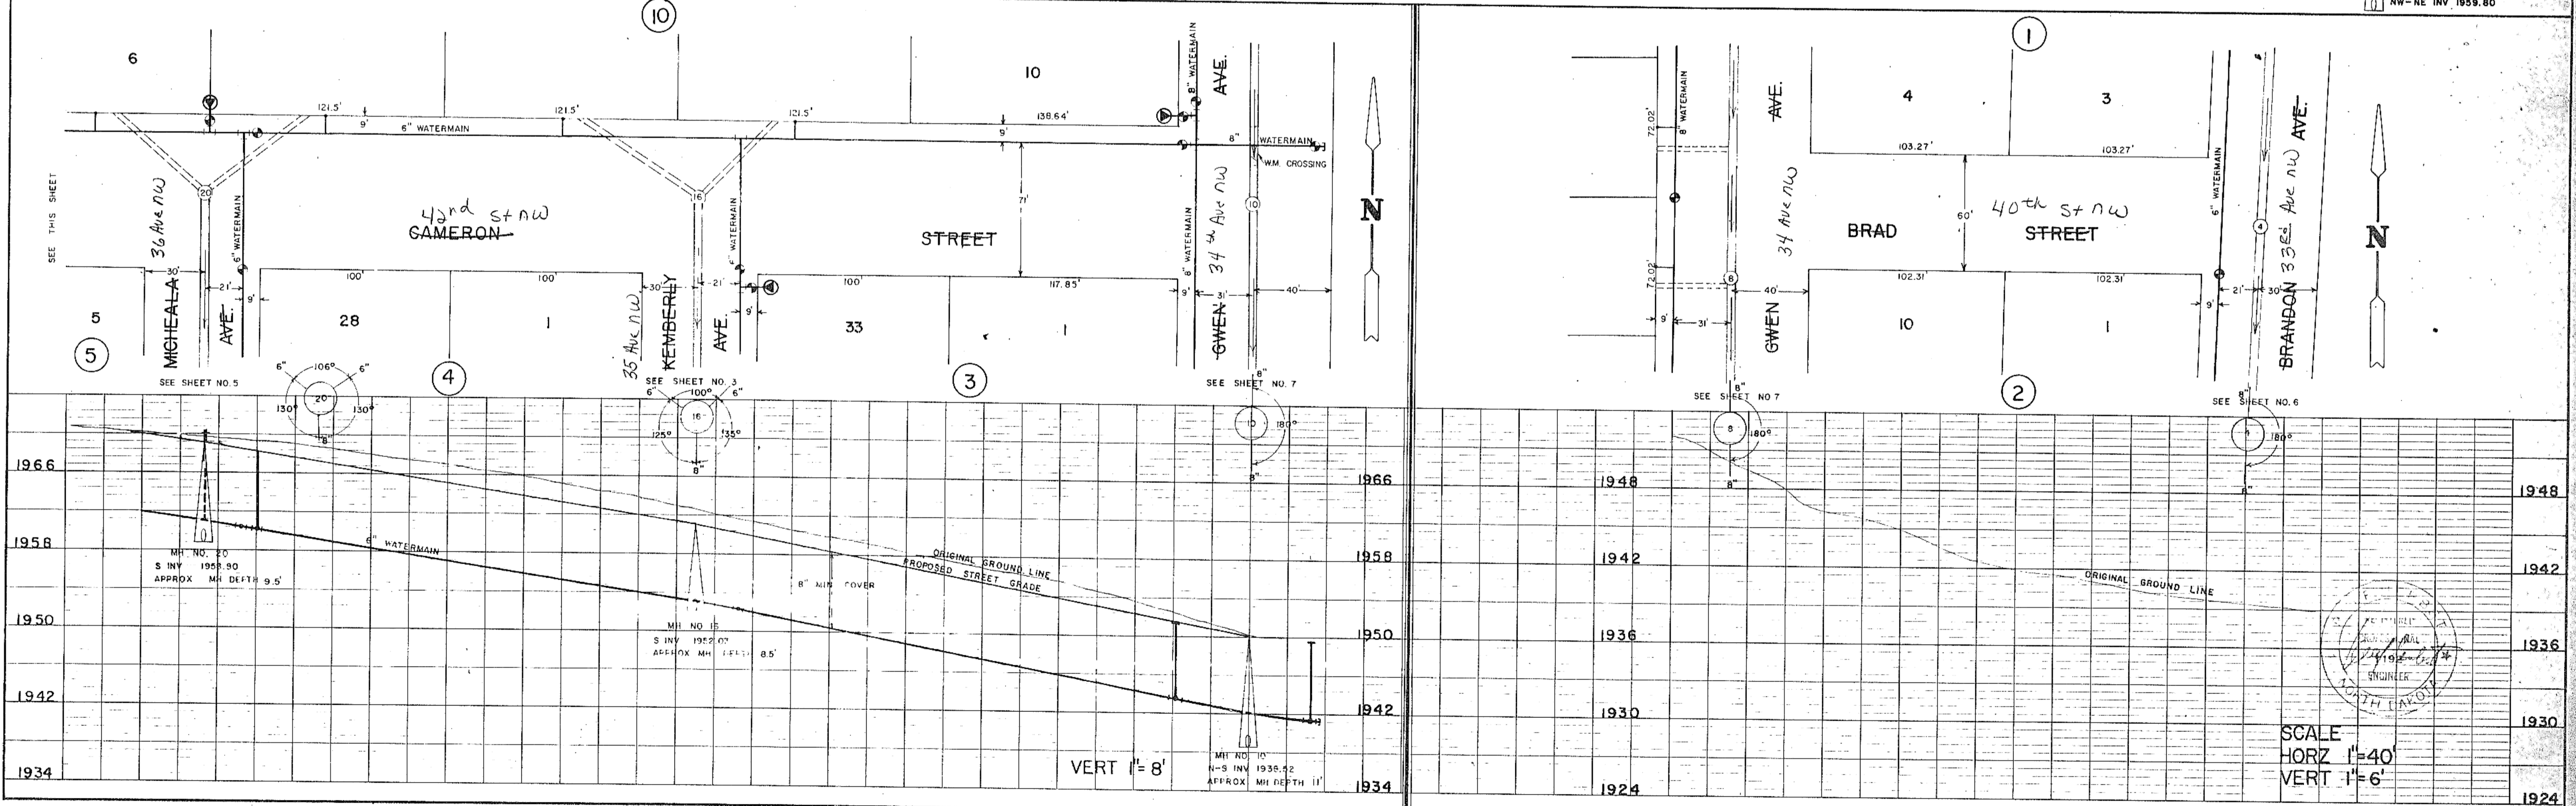


PLATE 2, FLAT PLAN-PROFILE
KEUFFEL & ESSER CO.
48 7032 MADE IN U.S.A.

Toman Engineering Company
Civil & Environmental Consultants
P. O. Box 708 P. O. Box 552
Mandan, ND Boissevain, Man RKO OEO
SHEET NO. 8 OF 12 SHEETS