

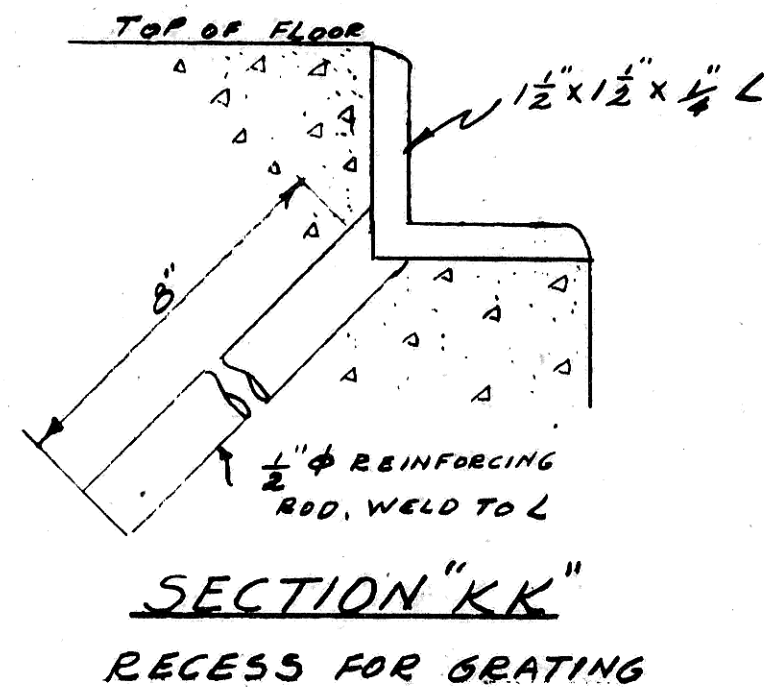


PLAN VIEW OF WELL- FLOOR SLAB OMITTED  
SCALE: 1/4" = 1'-0"

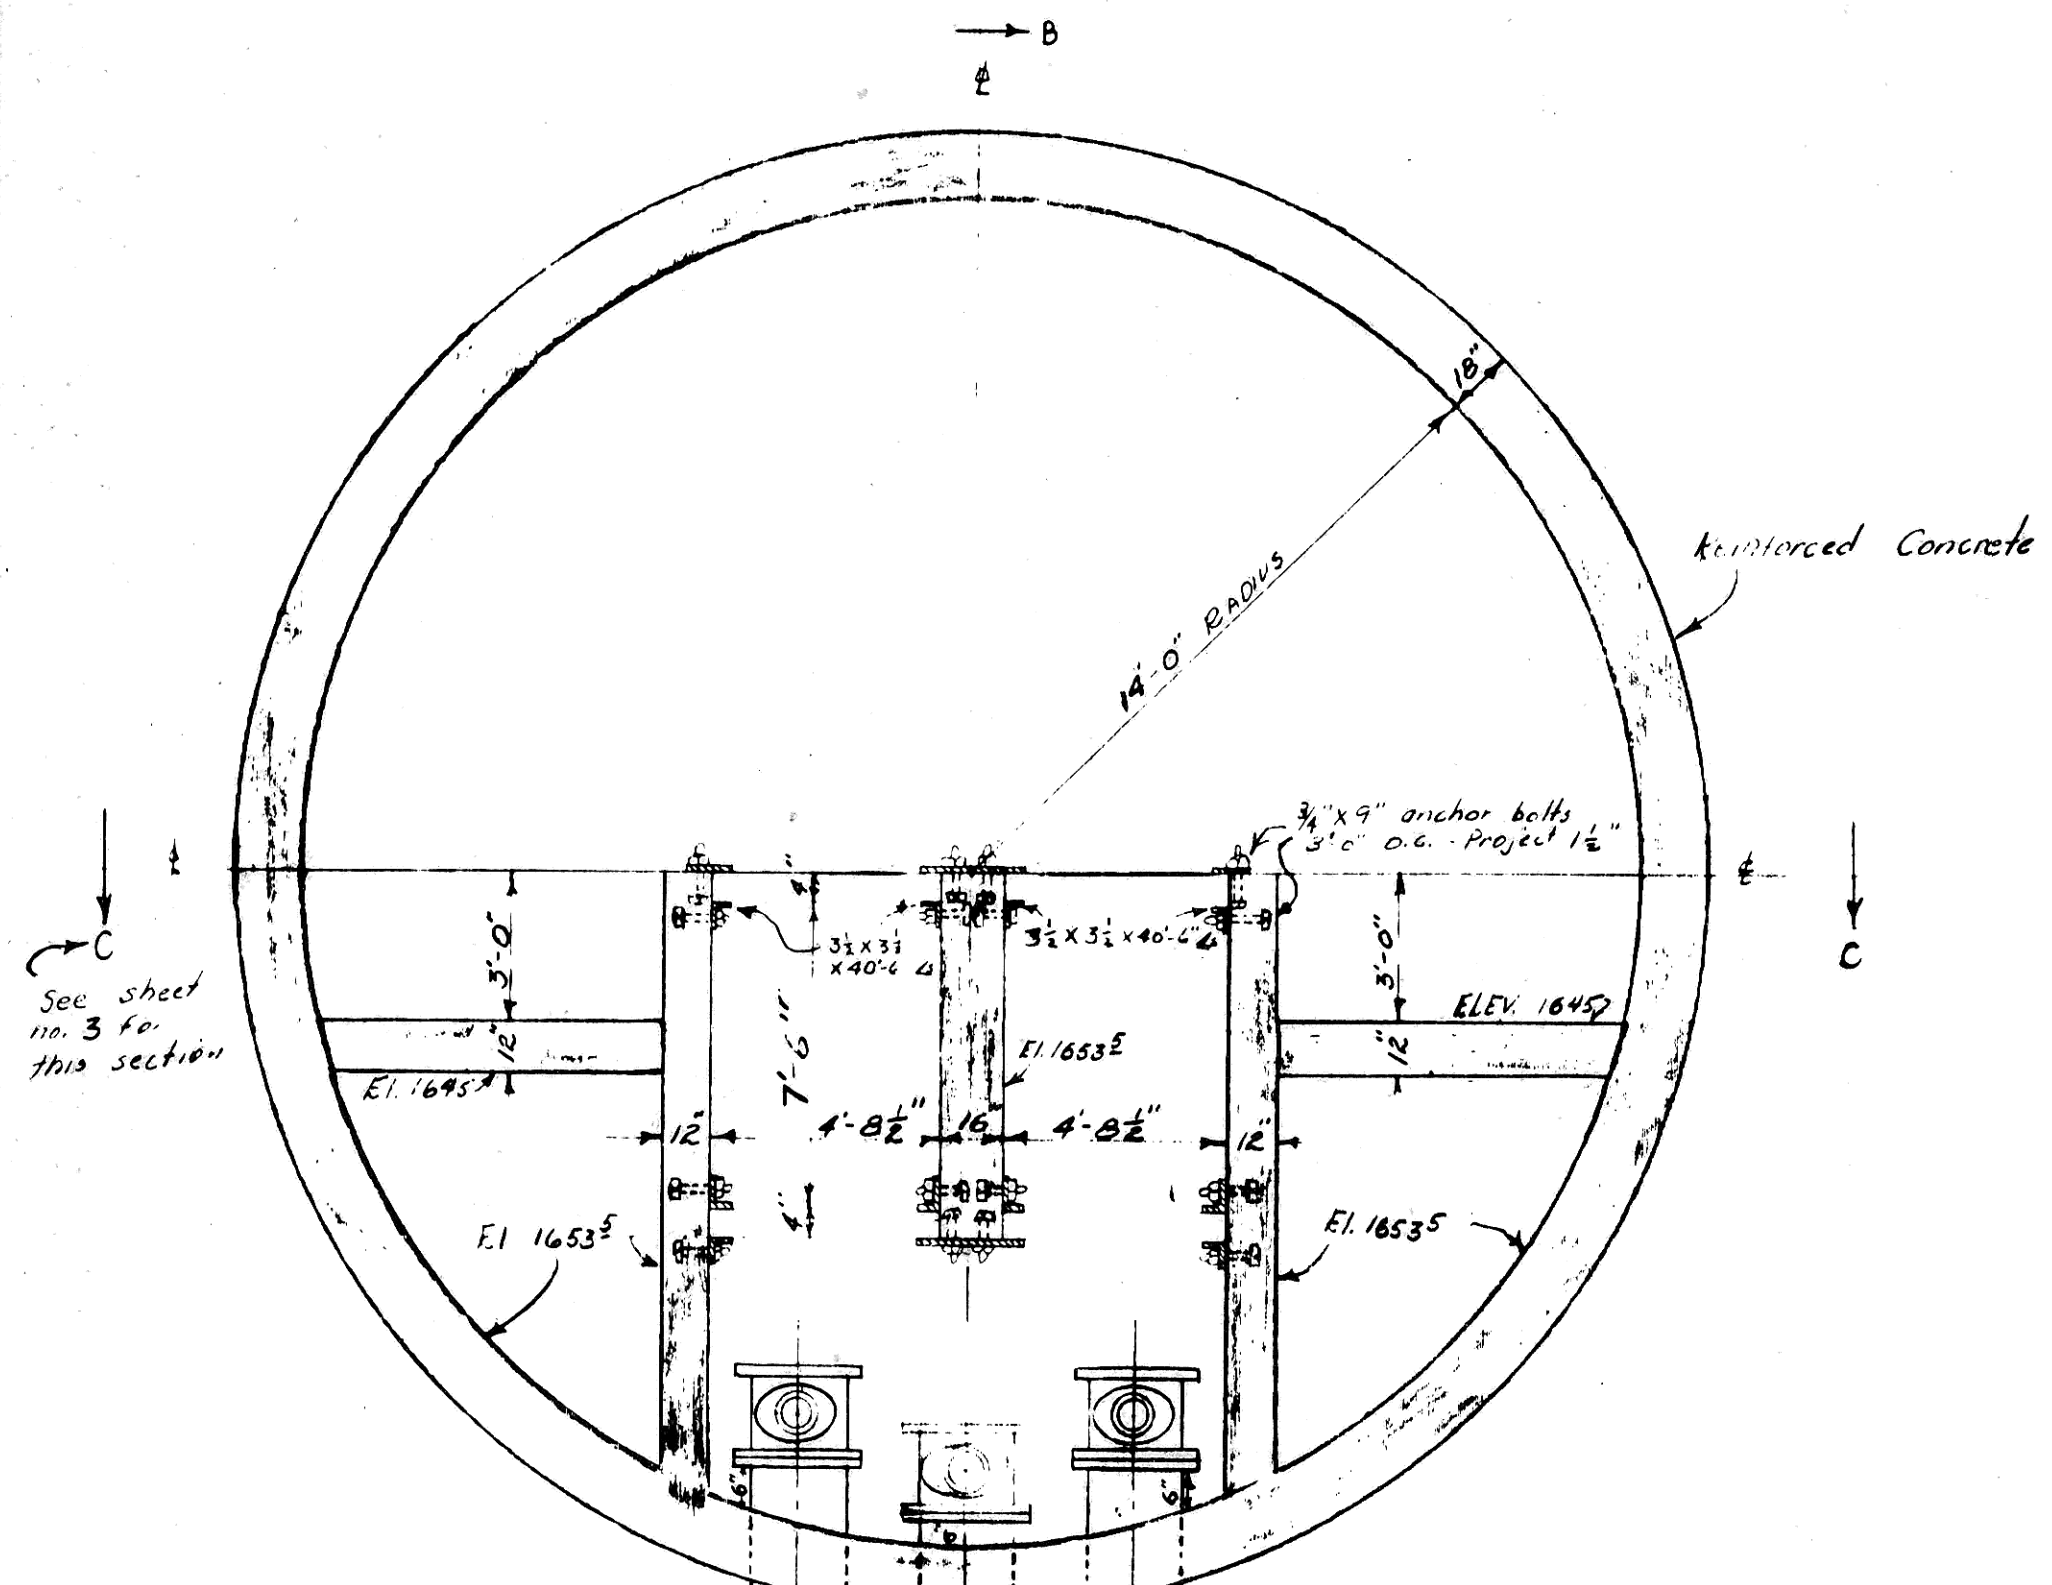


See sheet no. 4 for details of floor slab steel.

See sheet no. 4 for details of steel for wall of barrel

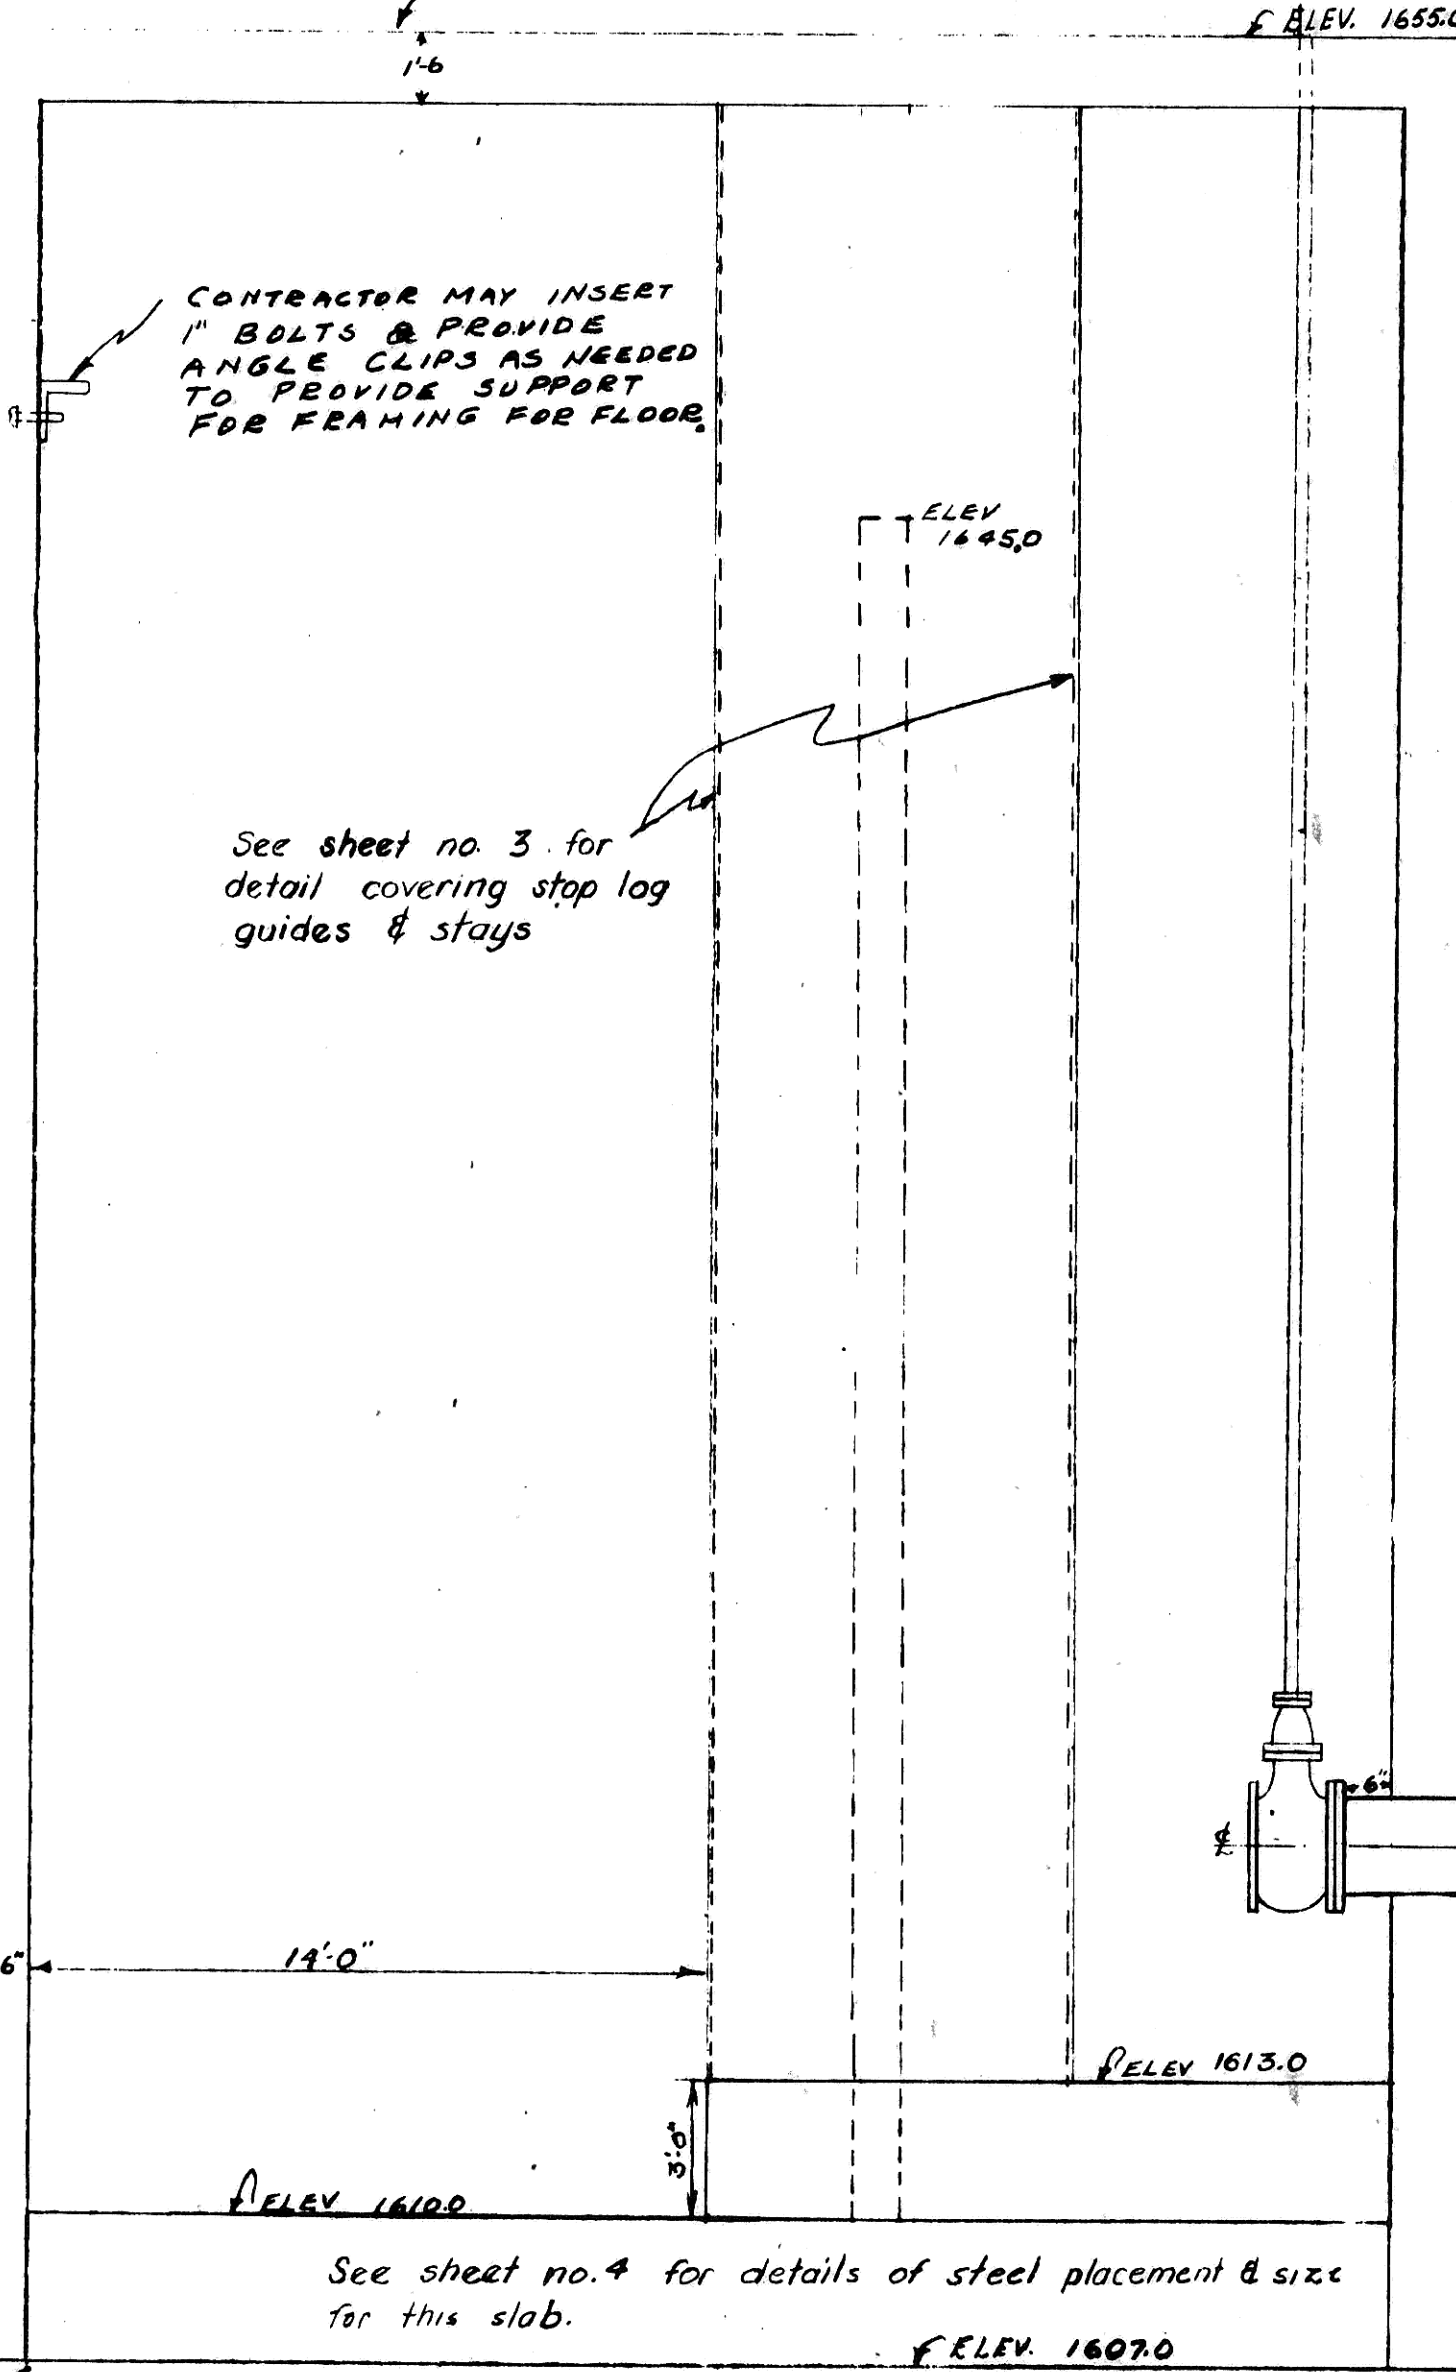


See sheet no. 3 for detail covering stop lag guides & stays


SUPER-STRUCTURE NOT SHOWN  
SECTION B-B -  
SCALE: 1/4" = 1'-0"

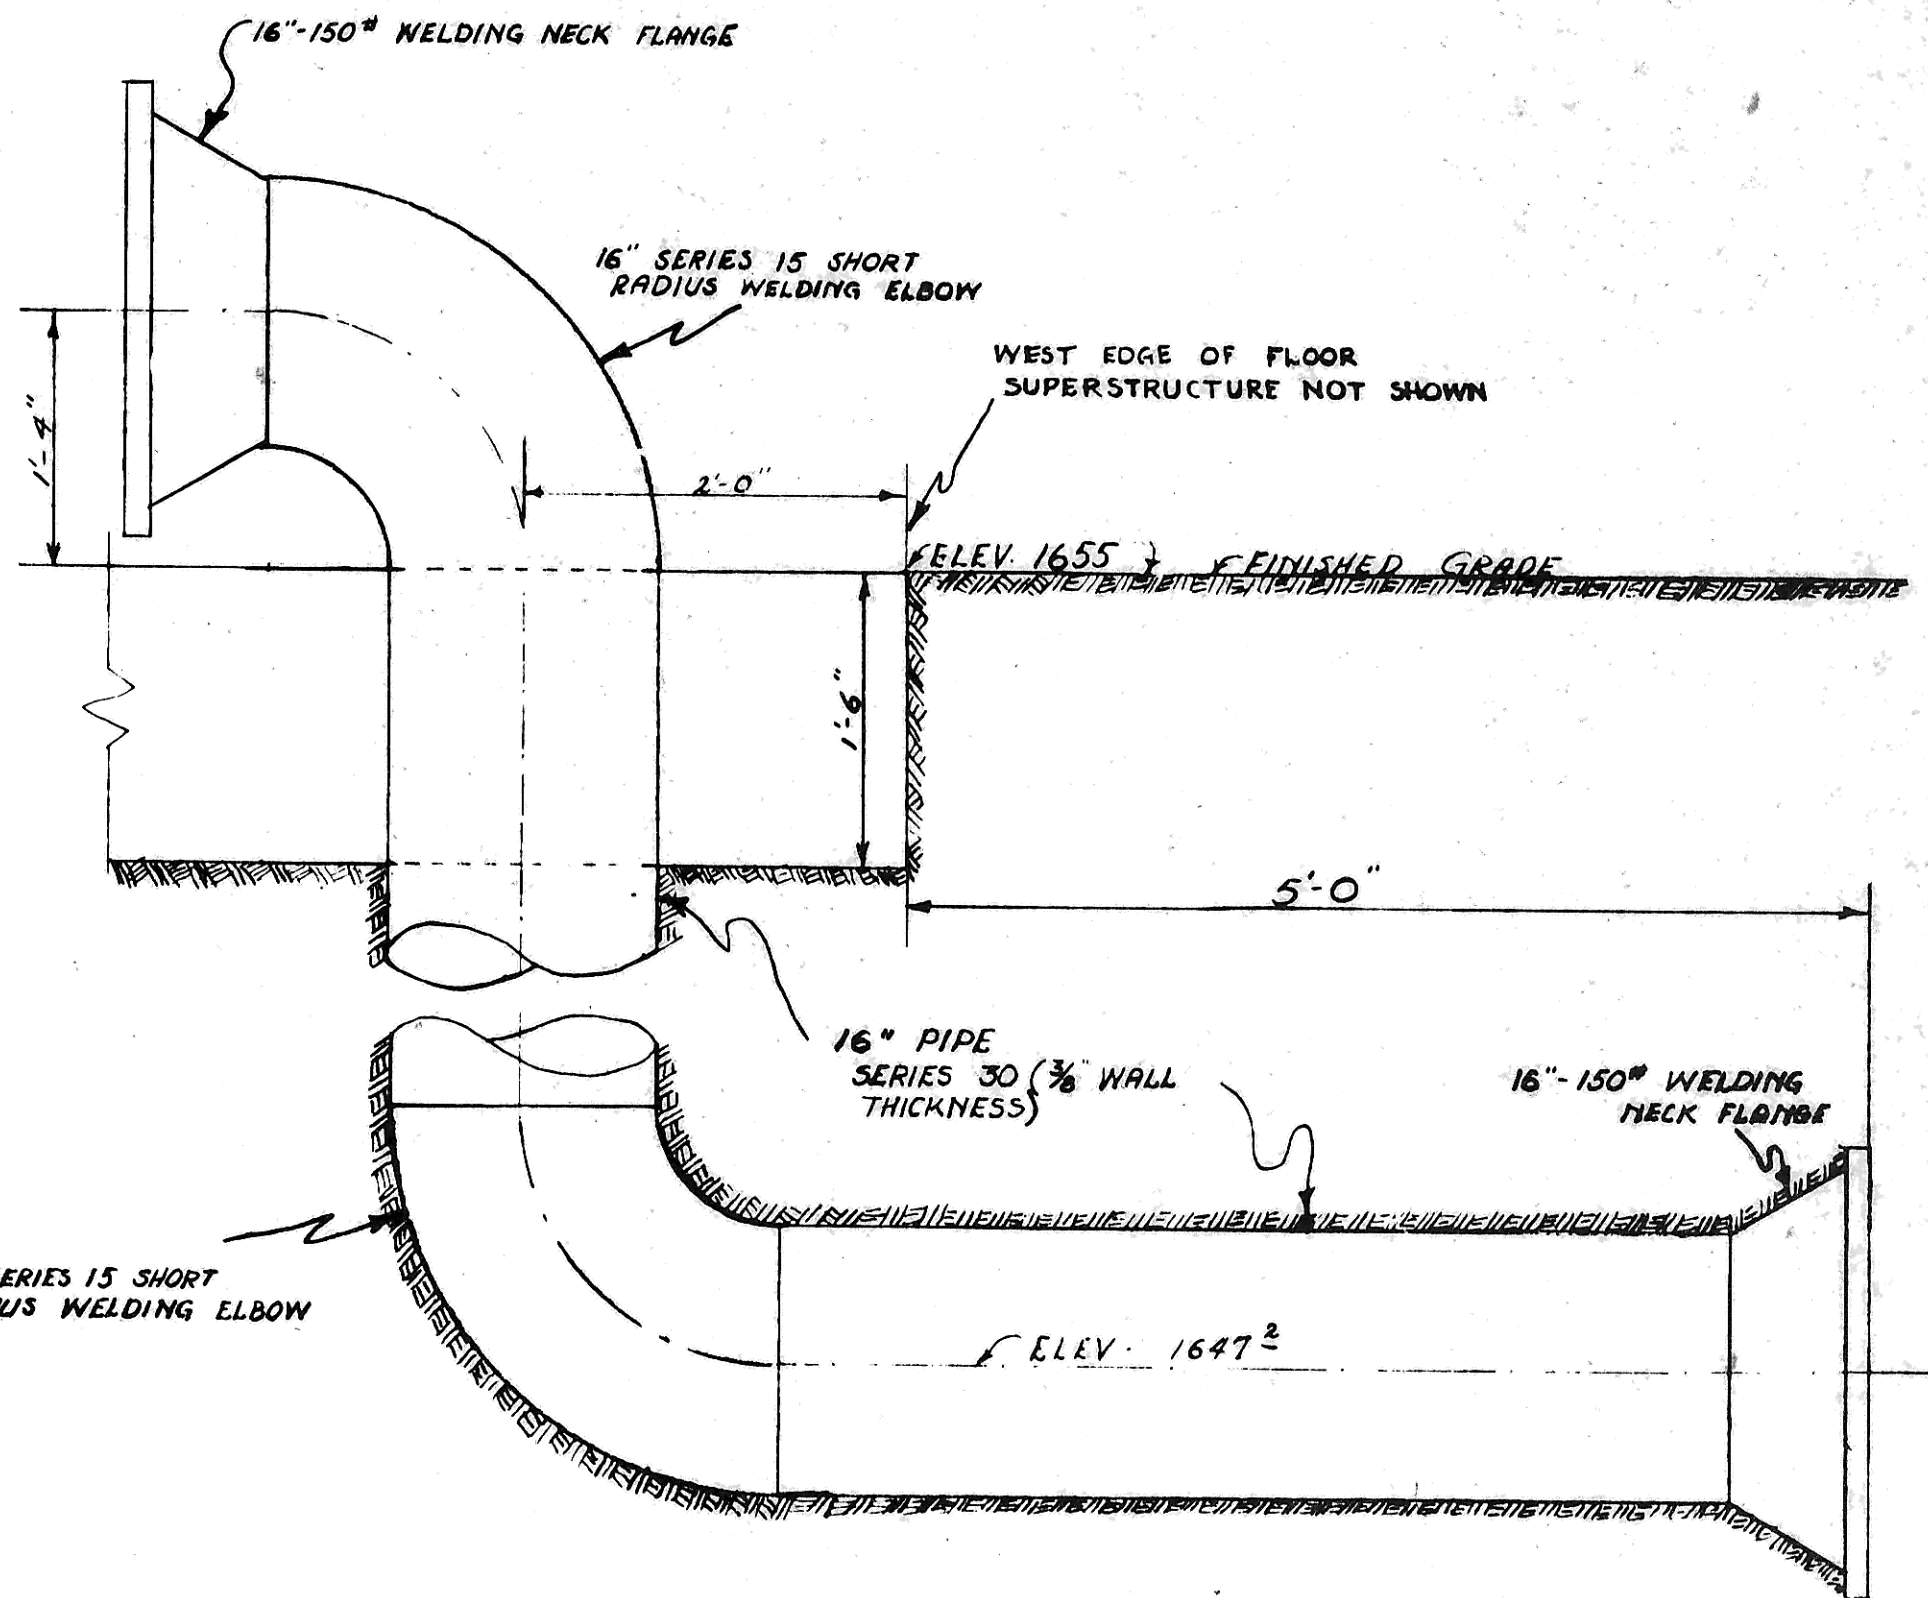


SECTION A-A  
SCALE: 1" = 1'-0"

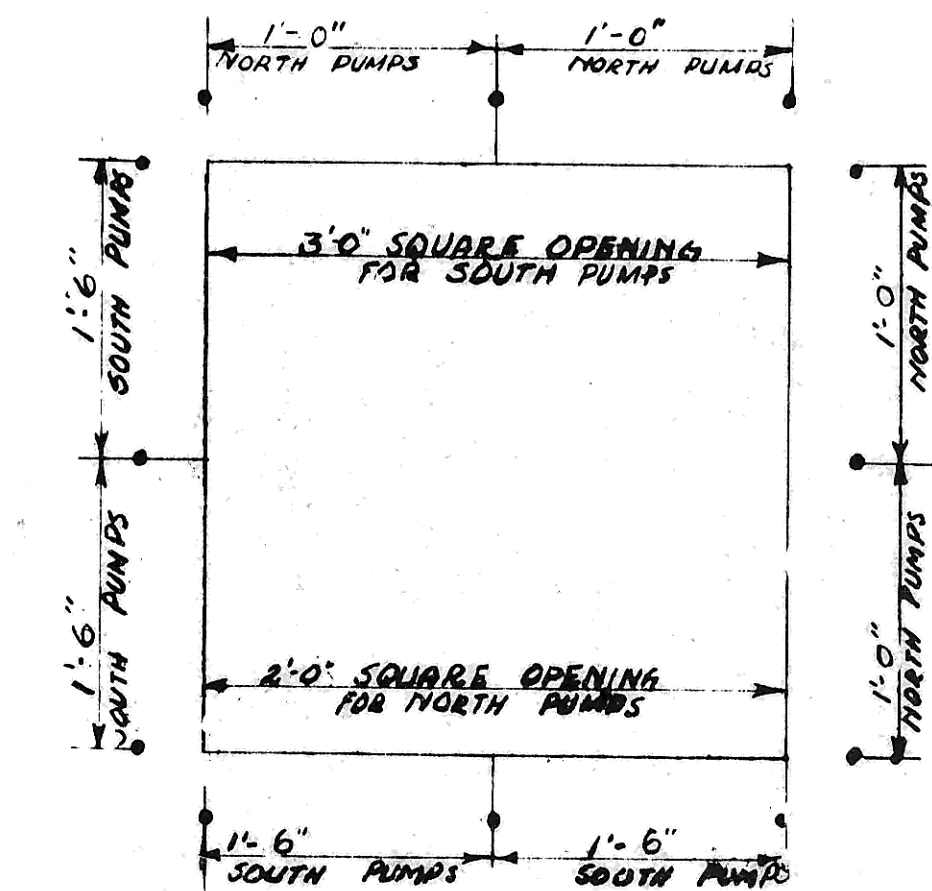

PLAN SHOWING FLOOR OPENINGS FOR PUMPS  
NO SCALE

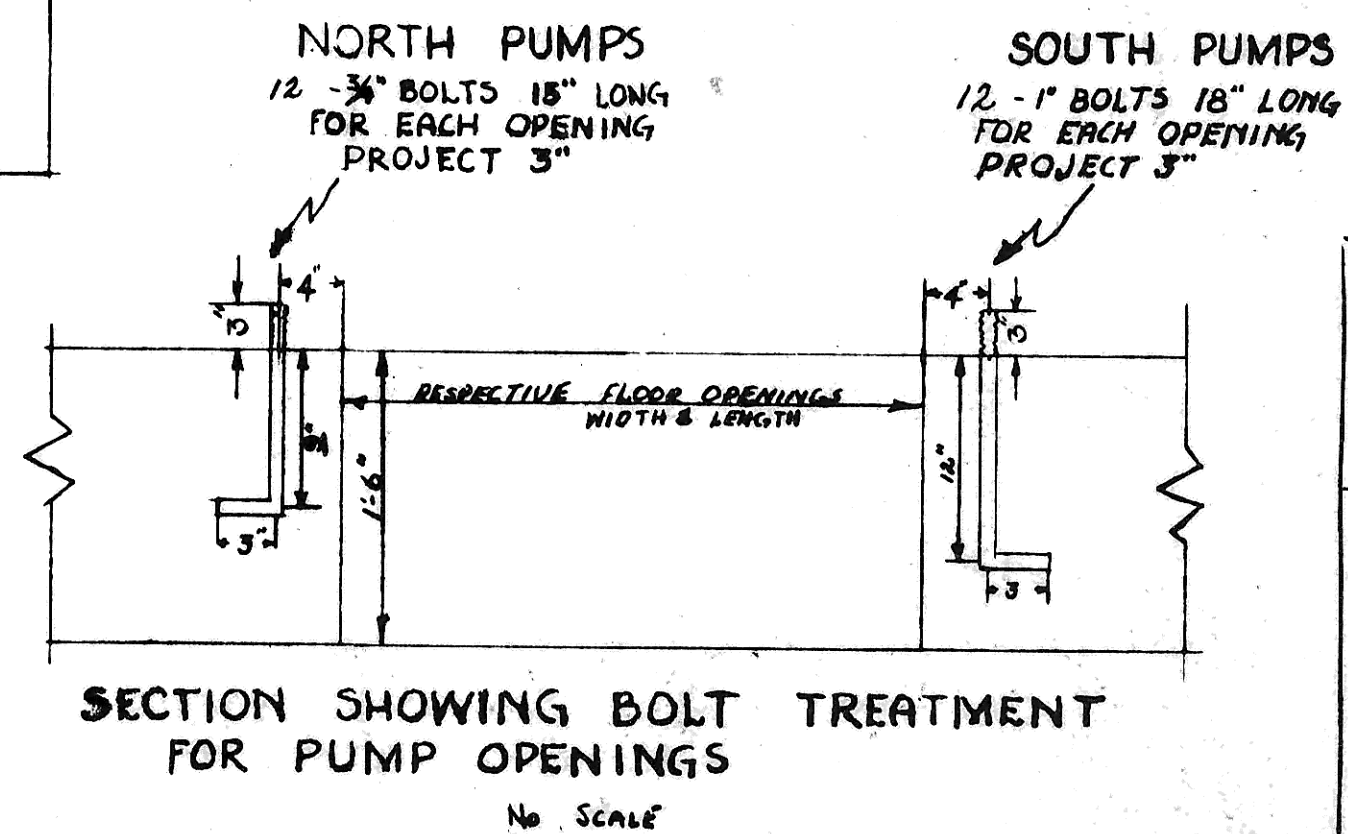

SECTION SHOWING BOLT TREATMENT FOR PUMP OPENINGS  
NO SCALE

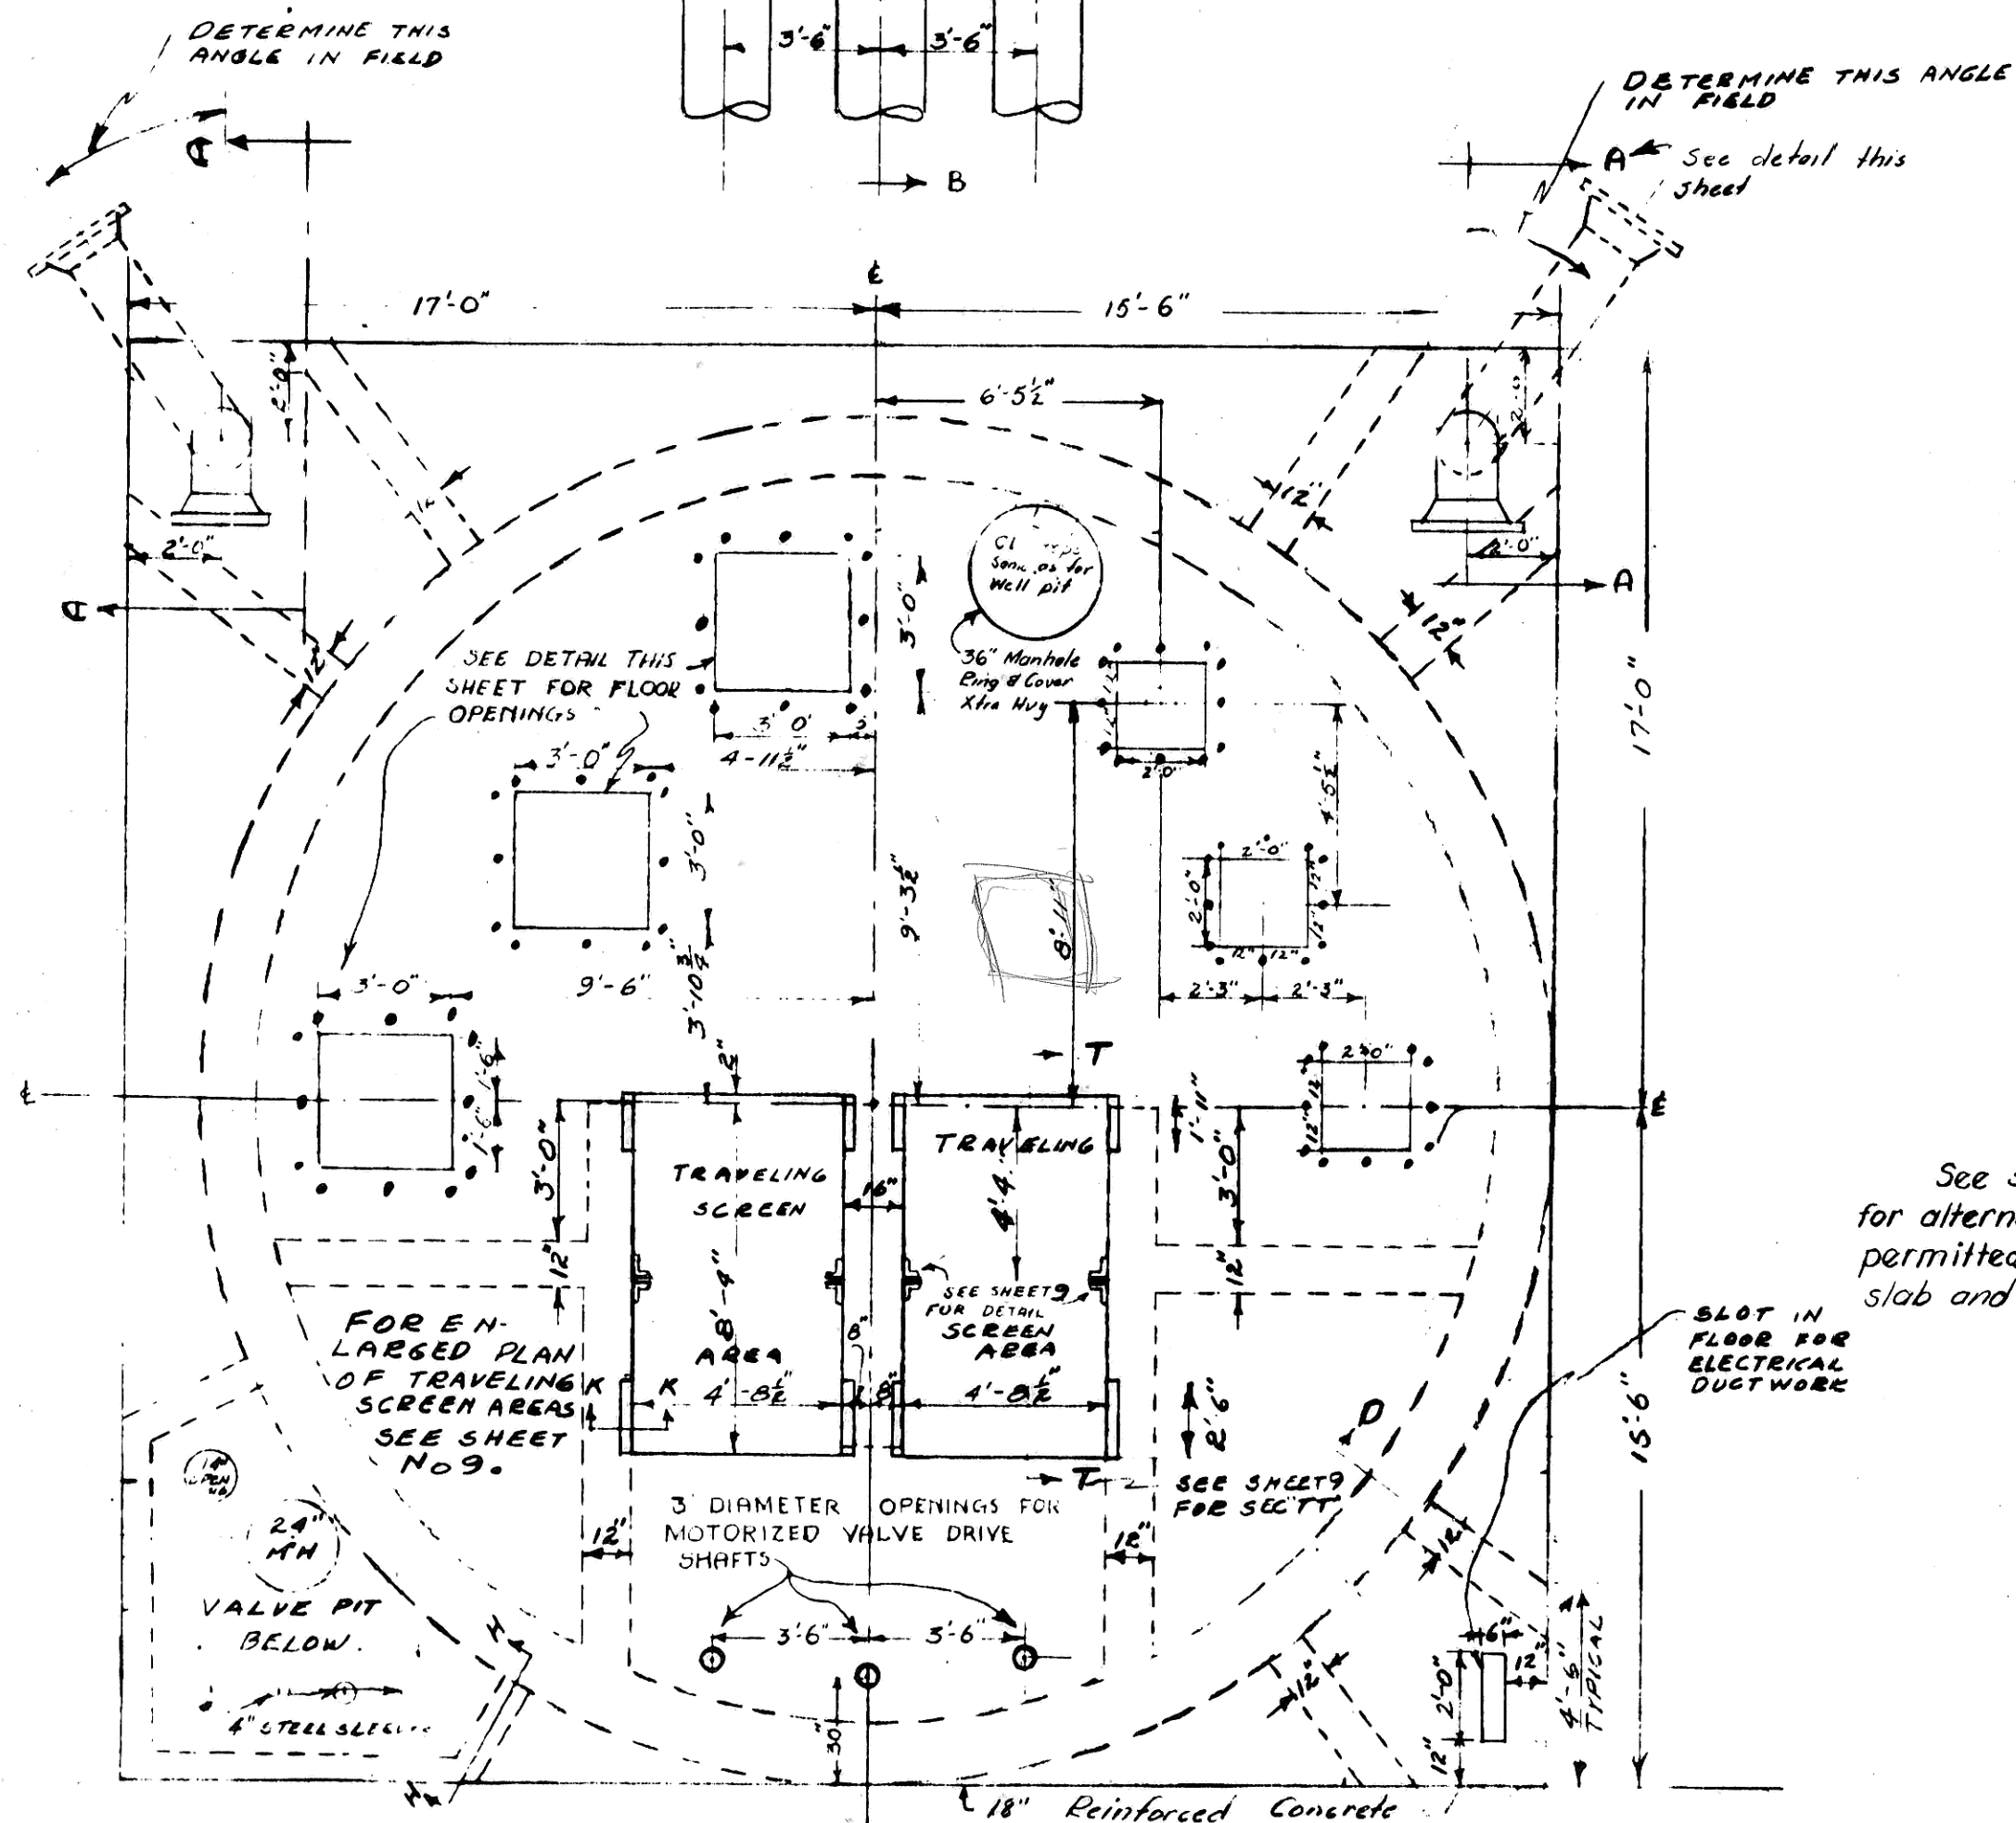

PLAN VIEW SHOWING FLOOR SLAB TREATMENT  
SCALE: 1/4" = 1'-0"

Job: WATER WORKS IMPROVEMENT, 1953  
PHASE II.

File No. \_\_\_\_\_ Date: \_\_\_\_\_  
Revised: \_\_\_\_\_

2 OF 9 SHEETS  
AS SHOWN.

DRAWN BY: \_\_\_\_\_ CHECKED BY: \_\_\_\_\_  
PLAN VIEW OF WELL & FLOOR SLAB CONCRETE  
WORK - SECTIONS A-A & B-B - FLOOR OPENINGS

George J. Toman  
P. E. No. 105

Consulting Engineer