

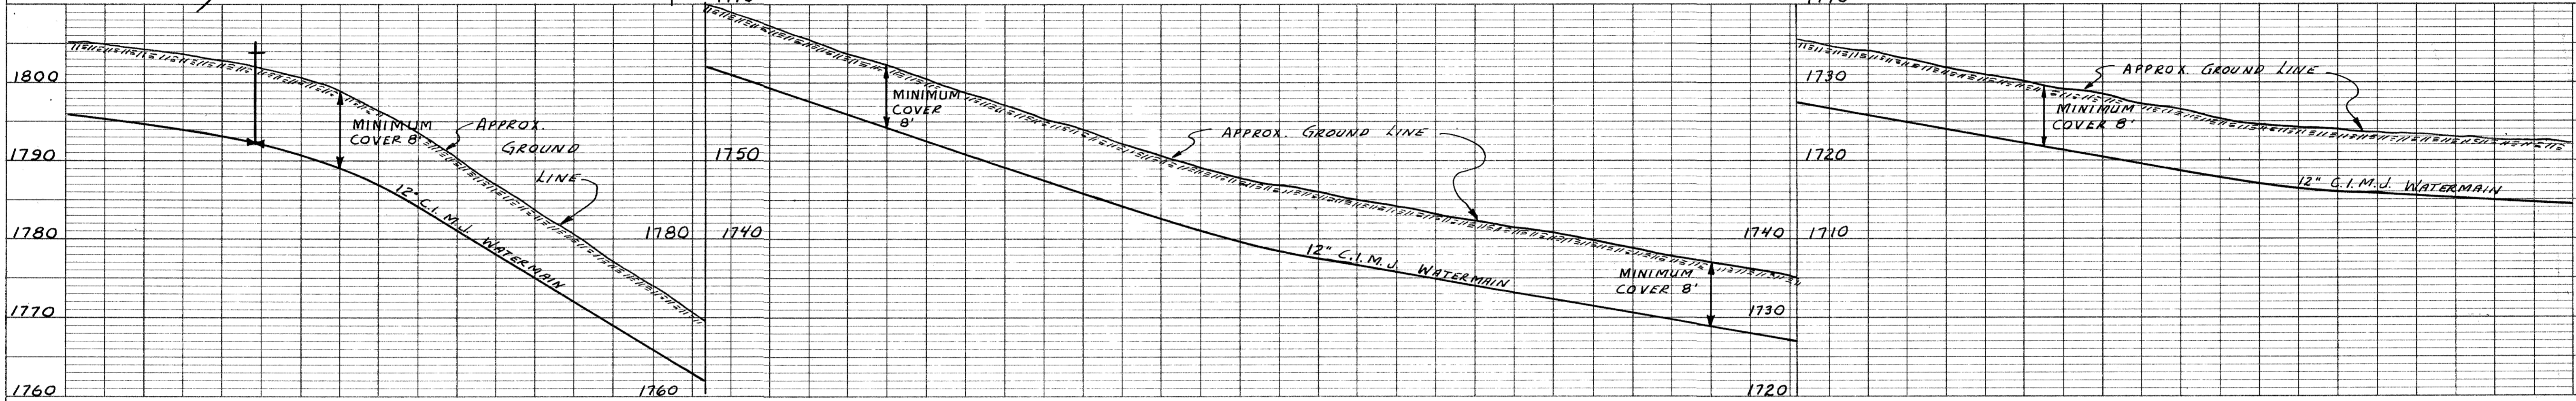
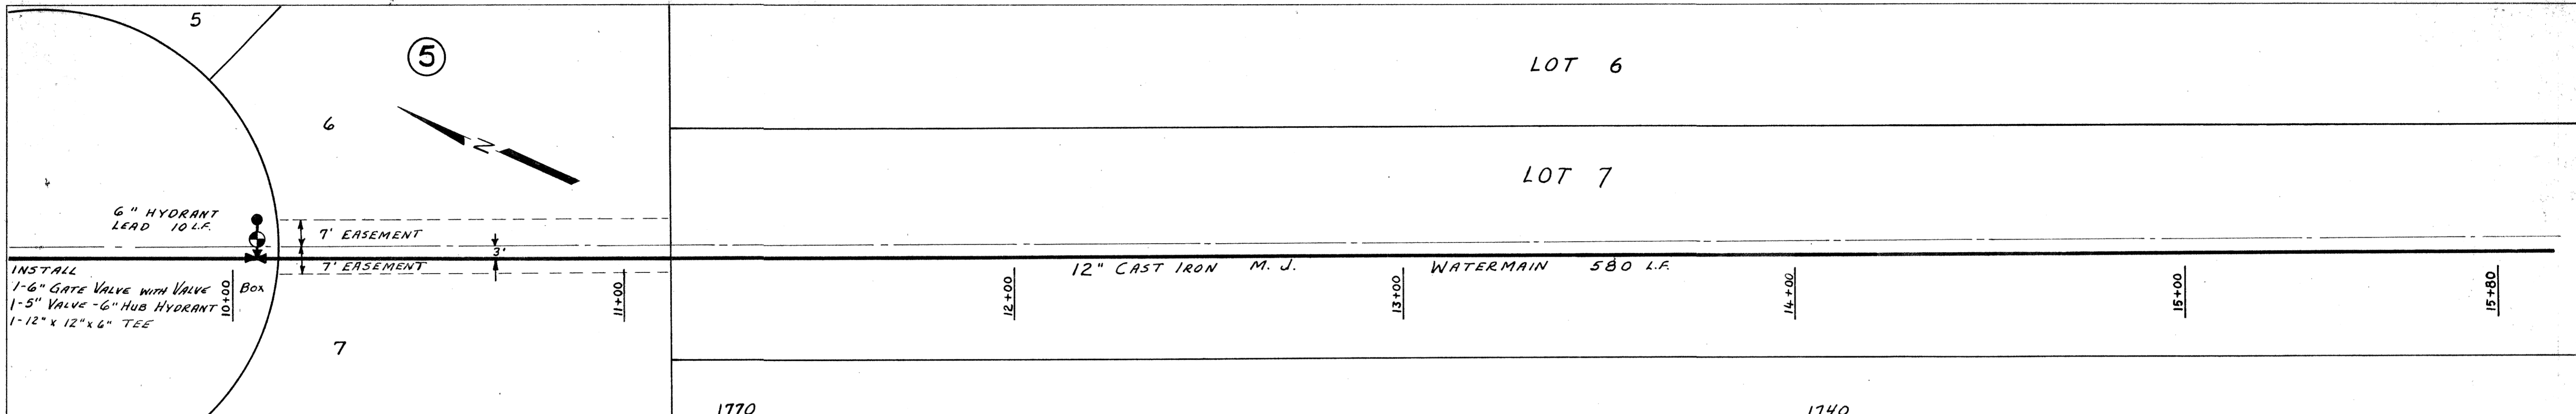
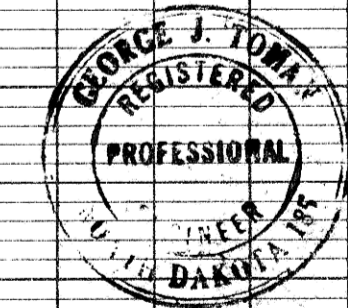


DATE: _____ BY: _____
 SURVEYED: _____
 PLAN NOTE BOOK: _____
 ALIGNMENT CHECKED: _____
 RT. OF WAY CHECKED: _____
 No. _____

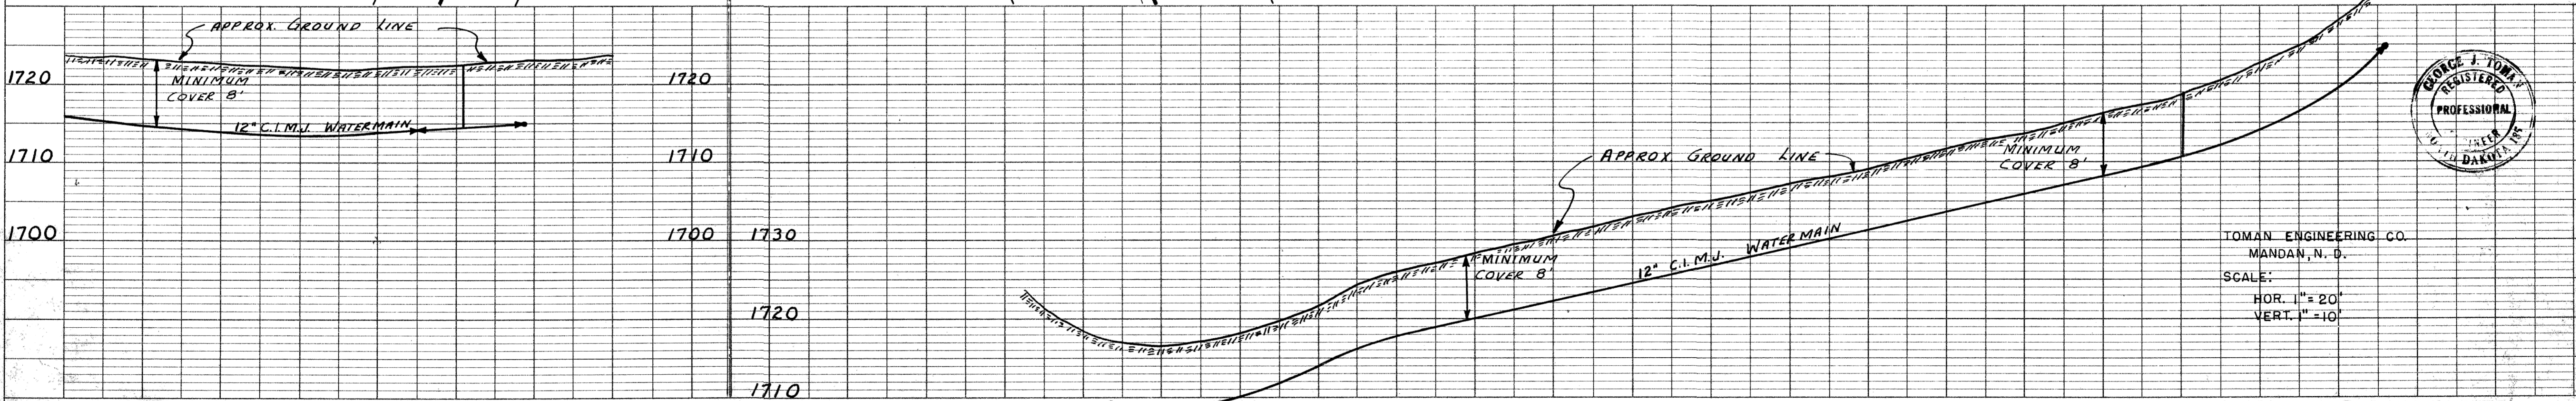

DATE: _____ BY: _____
 SURVEYED: _____
 PROFILE NOTE BOOK: _____
 GRADES CHECKED: _____
 B. M.'S. NOTED: _____
 STRUCTURE NOTATIONS CHECKED: _____
 No. _____

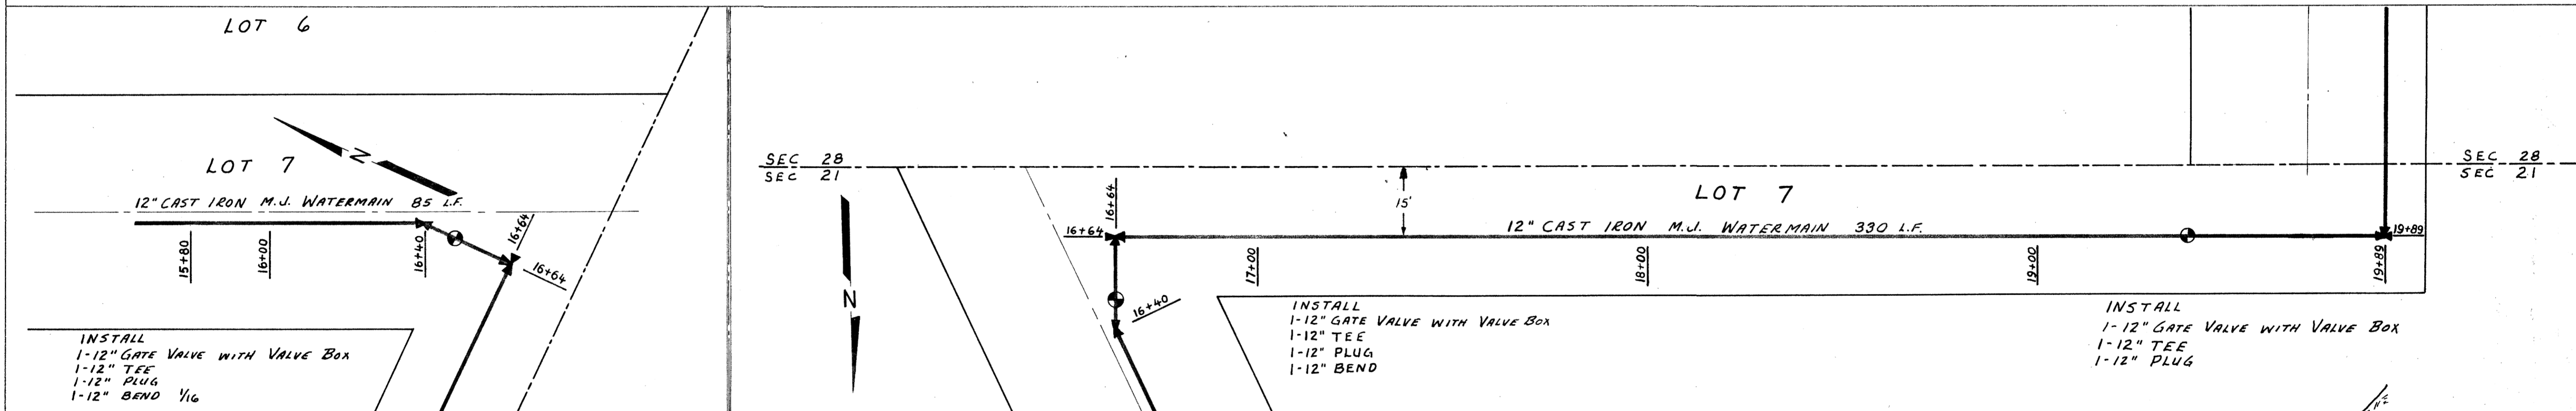

TOMAN ENGINEERING CO.
 MANDAN, N. D.
 SCALE:
 HOR. 1" = 20'
 VERT. 1" = 10'