


DATE: _____ BY: _____
 SURVEYED: _____ PLOTTED: _____
 NOTE BOOK: _____ ALIGNMENT CHECKED: _____
 No. _____


DATE: _____ BY: _____
 SURVEYED: _____ PLOTTED: _____
 NOTE BOOK: _____ B.M.'S NOTED: _____
 No. _____ STRUCTURE NOTATIONS CHECKED: _____

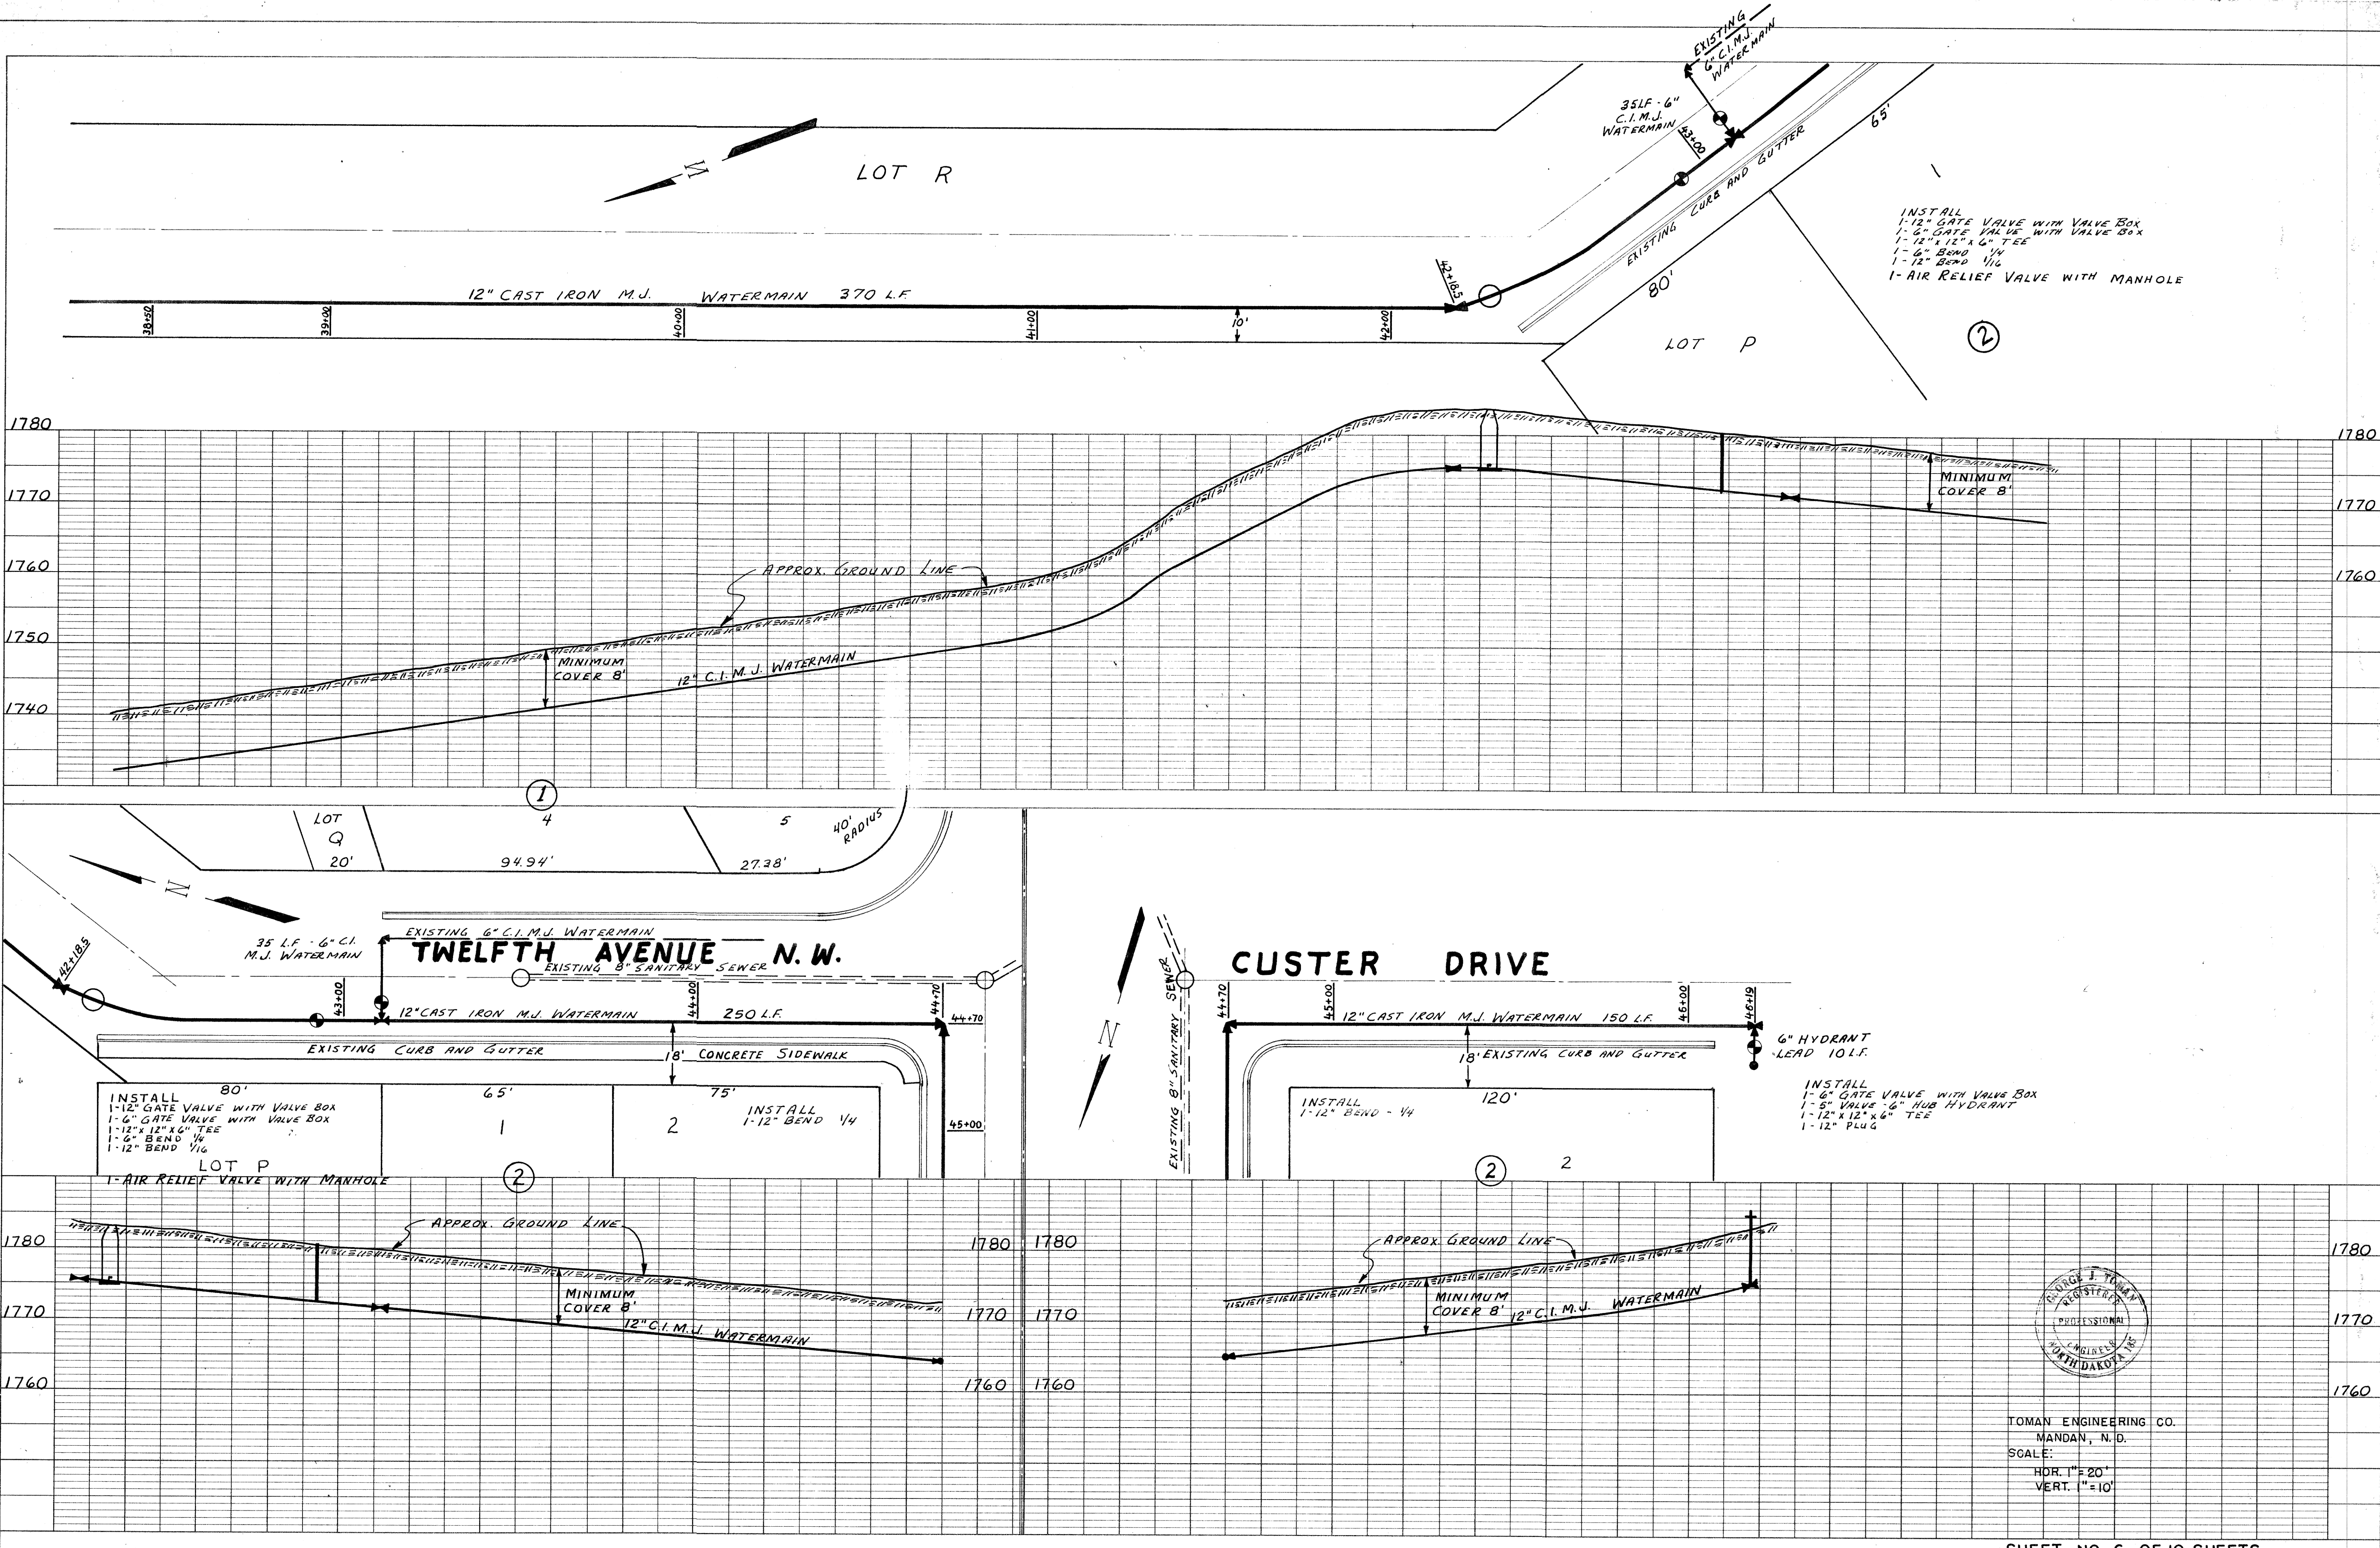

INSTALL
 1-12" GATE VALVE WITH VALVE BOX
 1-6" GATE VALVE WITH VALVE BOX
 1-12" x 12" x 6" TEE
 1-6" BEND 1/4
 1-12" BEND 1/16
 1-AIR RELIEF VALVE WITH MANHOLE

INSTALL
 1-12" GATE VALVE WITH VALVE BOX
 1-6" GATE VALVE WITH VALVE BOX
 1-12" x 12" x 6" TEE
 1-6" BEND 1/4
 1-12" BEND 1/16
 1-AIR RELIEF VALVE WITH MANHOLE

INSTALL
 1-6" GATE VALVE WITH VALVE BOX
 1-6" VALVE - 6" HUB HYDRANT
 1-12" x 12" x 6" TEE
 1-12" PLUG

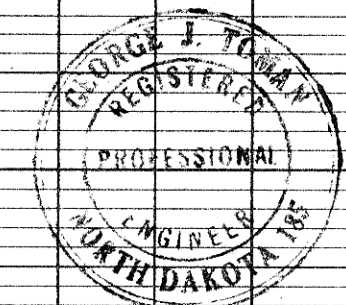

TOMAN ENGINEERING CO.
 MANDAN, N. D.
 SCALE:
 HOR. 1" = 20'
 VERT. 1" = 10'