

SEVENTH STREET N.W.

8" CAST IRON M.J. WATER MAIN 590 L.F.

EXISTING CURB AND GUTTER

INSTALL
1-8" BEND 1/8
1-8" BEND 1/16
1-AIR RELIEF VALVE WITH MANHOLE

393.90'

70'


82'

91.20'

5

4

3

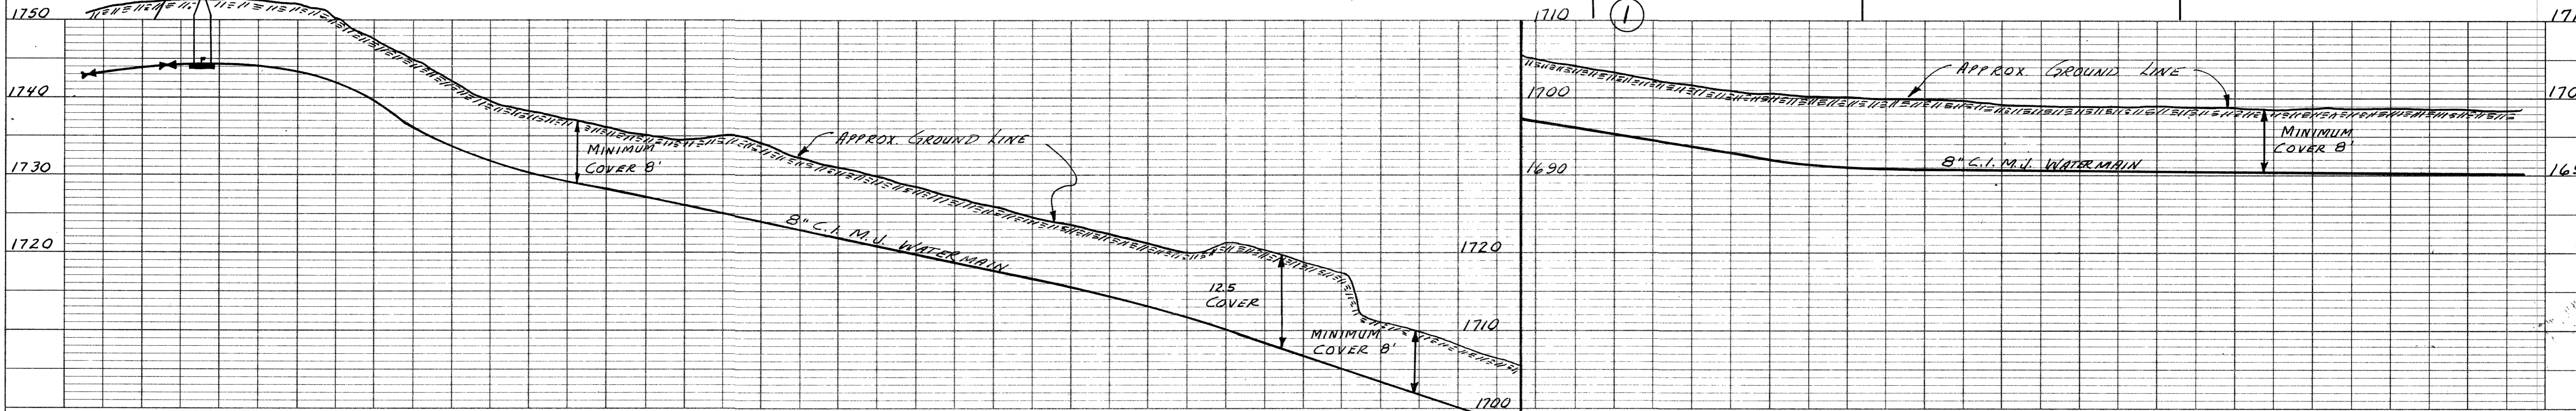

INSTALL
1-8" GATE VALVE WITH VALVE BOX
1-6" GATE VALVE WITH VALVE BOX
1-8" x 8" x 6" TEE
1-8" BEND 1/4
1-8" BEND 1/32
1-5" VALVE - 6" HUB HYDRANT

INSTALL
1-8" GATE VALVE WITH VALVE BOX
1-6" GATE VALVE WITH VALVE BOX
1-8" x 8" x 6" TEE
1-8" BEND 1/4
1-8" BEND 1/32
1-5" VALVE - 6" HUB HYDRANT

SEVENTH STREET N.W.

NINTH AVENUE N.W.

EXISTING 8" SANITARY SEWER

EXISTING CURB AND GUTTER

8" CAST IRON M.J. WATER MAIN 360 L.F.

EXISTING CURB AND GUTTER

8" CAST IRON M.J. WATER MAIN 90 L.F.

91.20'

123.52'

70'

69.90'

60'

60'

4

3


3

2

1

9

10

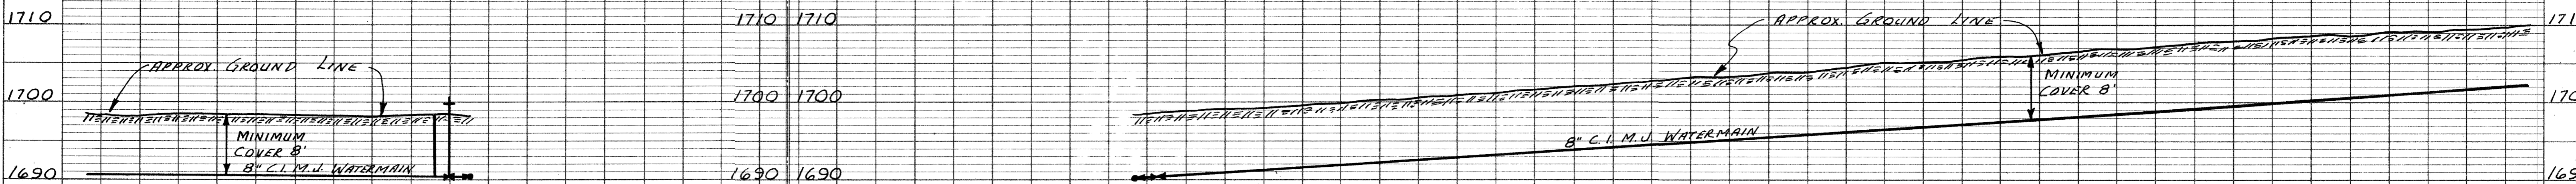

TOMAN ENGINEERING CO.
MANDAN, N. D.
SCALE:
HOR. 1" = 20'
VERT. 1" = 10'

PLAN
SURVEYED
PLOTTED
NOTE BOOK
ALIGNMENT CHECKED
RT. OF WAY CHECKED
No.

PROFILE
SURVEYED
PLOTTED
NOTE BOOK
GRADES CHECKED
STRUCTURE NOTATIONS CHECKED
No.