




DATE: _____
 BY: _____
 PLAN
 SURVEYED _____
 NOTED _____
 ALIGNMENT CHECKED _____
 BT. OF WAY CHECKED _____
 No. _____

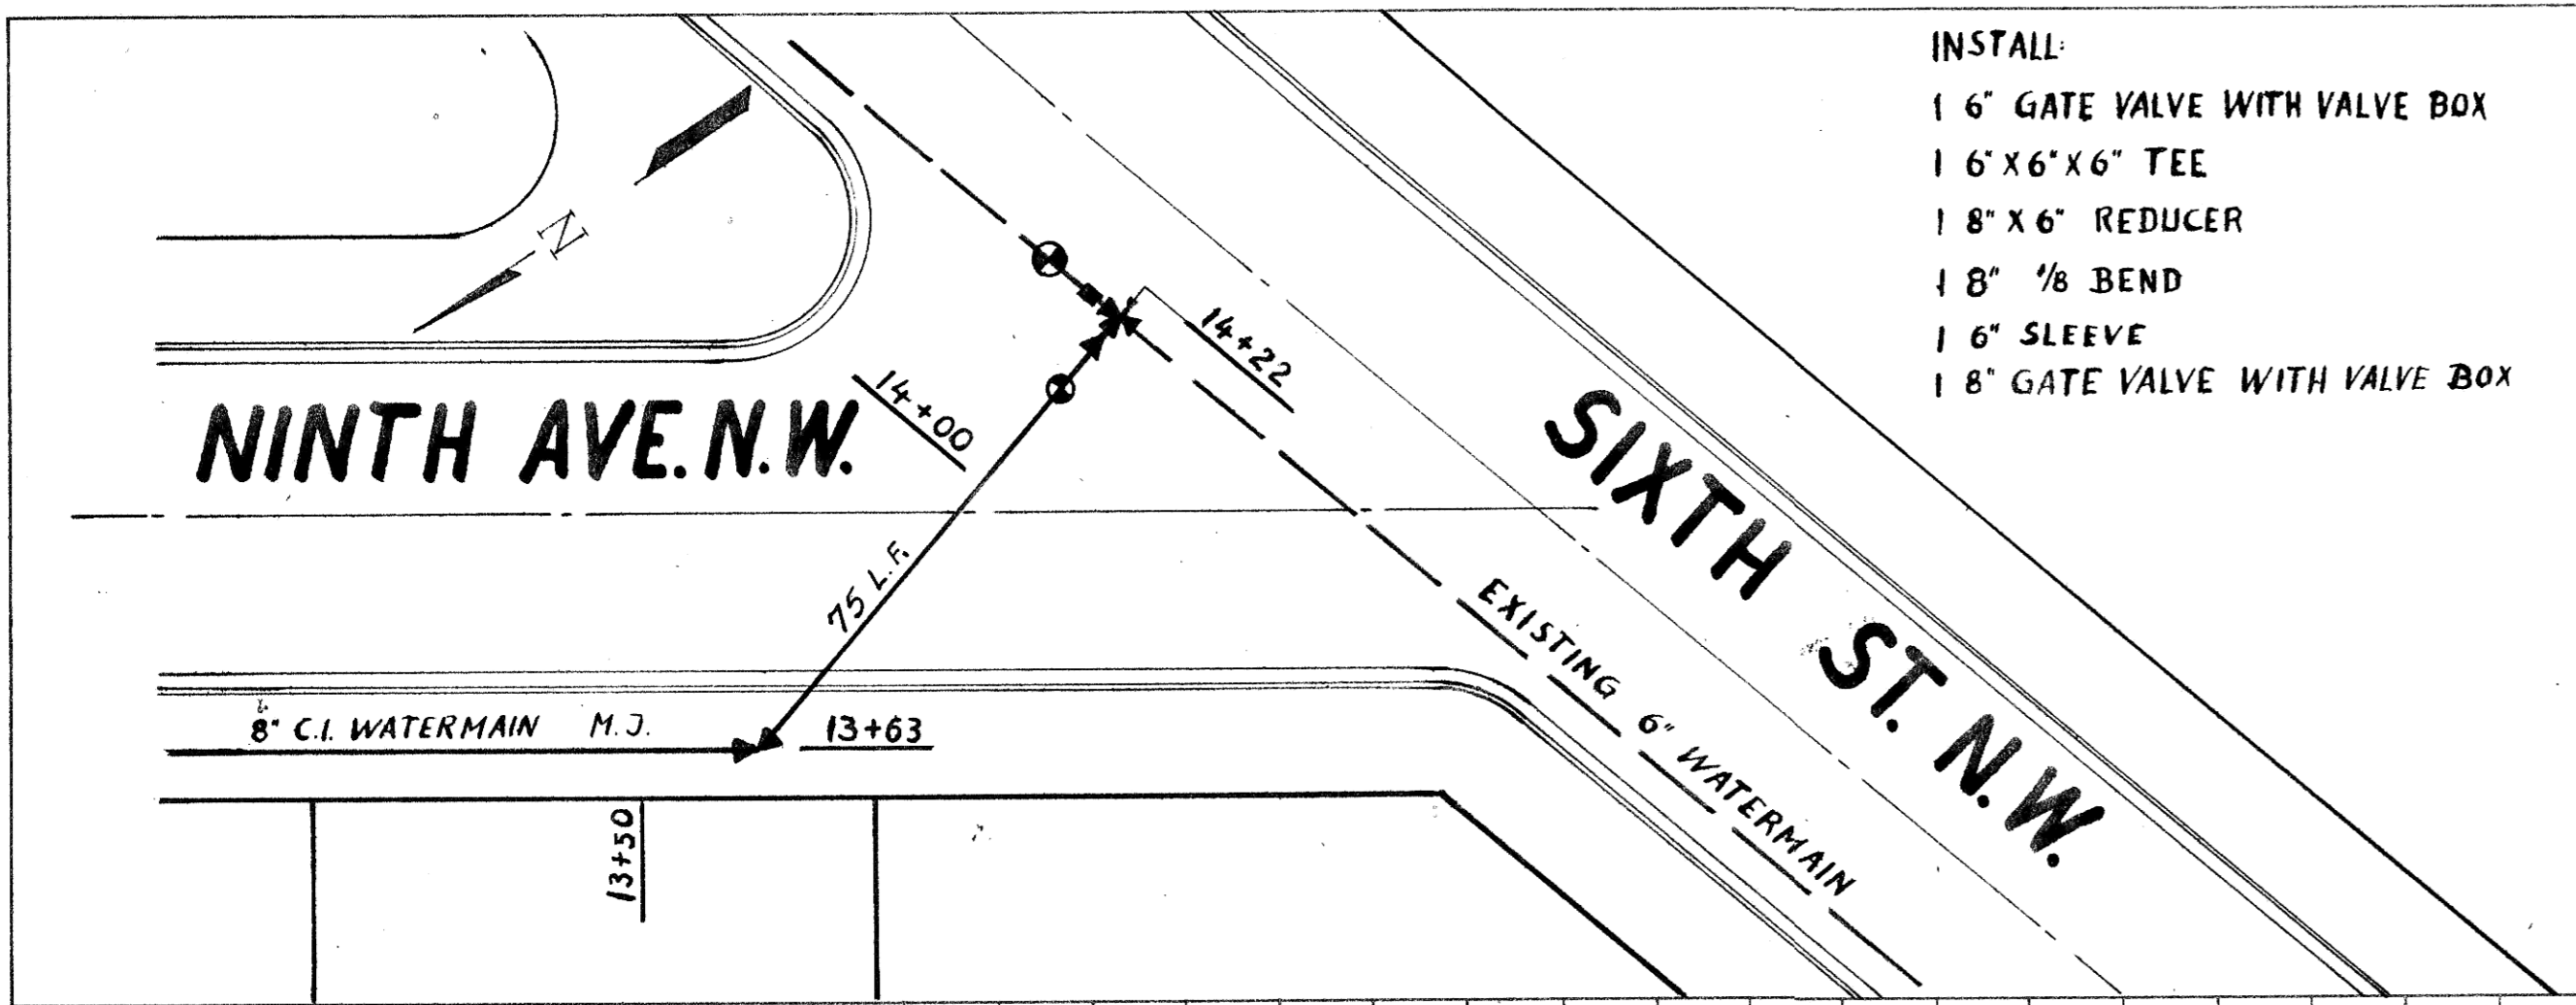

- INSTALL:
 1 6" GATE VALVE WITH VALVE BOX
 1 6" X 6" X 6" TEE
 1 8" X 6" REDUCER
 1 8" 1/8 BEND
 1 6" SLEEVE
 1 8" GATE VALVE WITH VALVE BOX


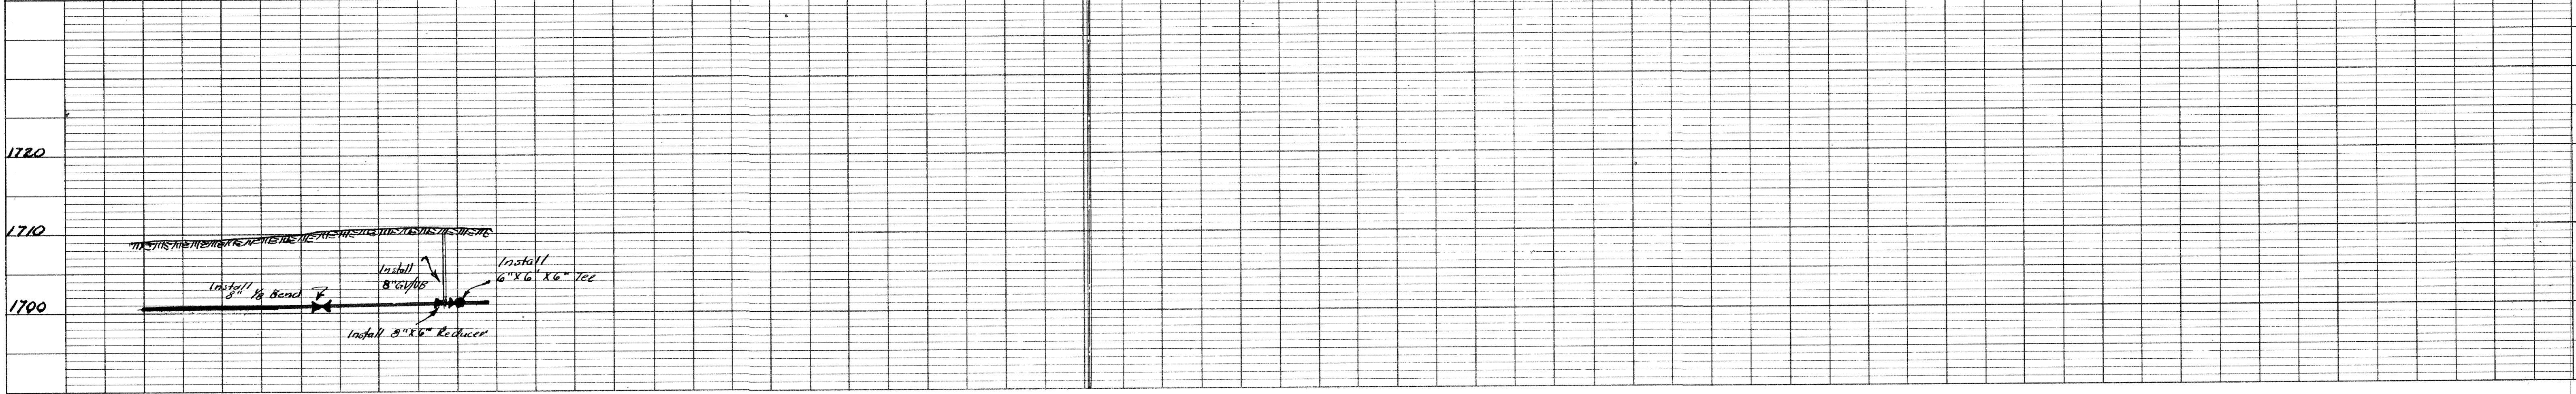


DATE: _____
 BY: _____
 PROFILE
 SURVEYED _____
 NOTED _____
 GRADE CHECKED _____
 S. M.'S. NOTED _____
 STRUCTURE NOTATIONS CHECKED _____
 No. _____

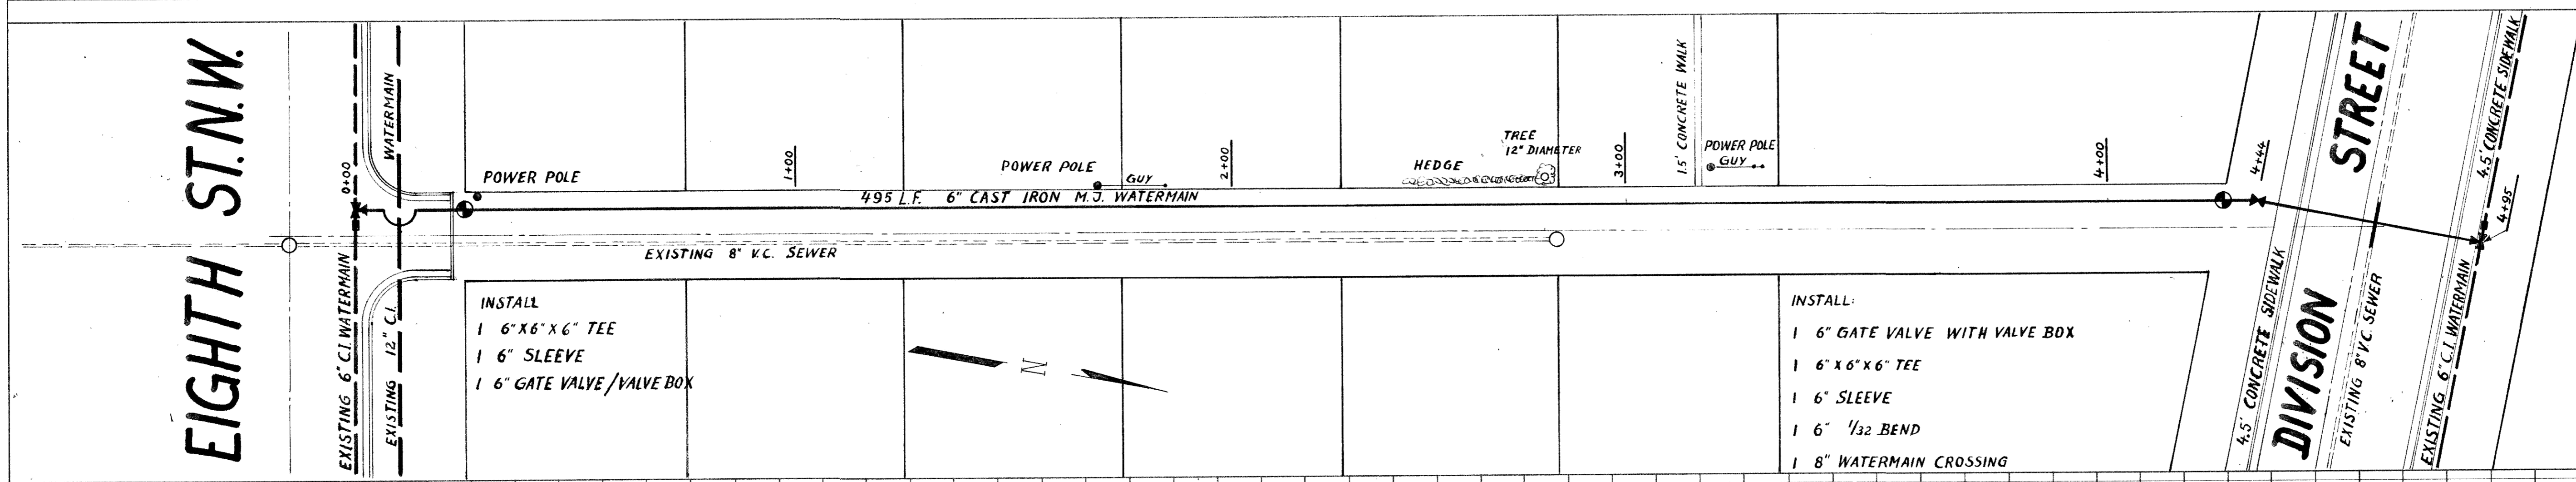

- INSTALL:
 1 6" X 6" X 6" TEE
 1 6" SLEEVE
 1 6" GATE VALVE / VALVE BOX

- INSTALL:
 1 6" GATE VALVE WITH VALVE BOX
 1 6" X 6" X 6" TEE
 1 6" SLEEVE
 1 6" 1/32 BEND
 1 8" WATERMAIN CROSSING

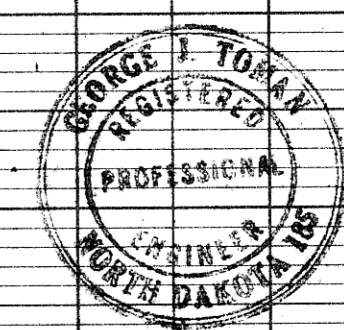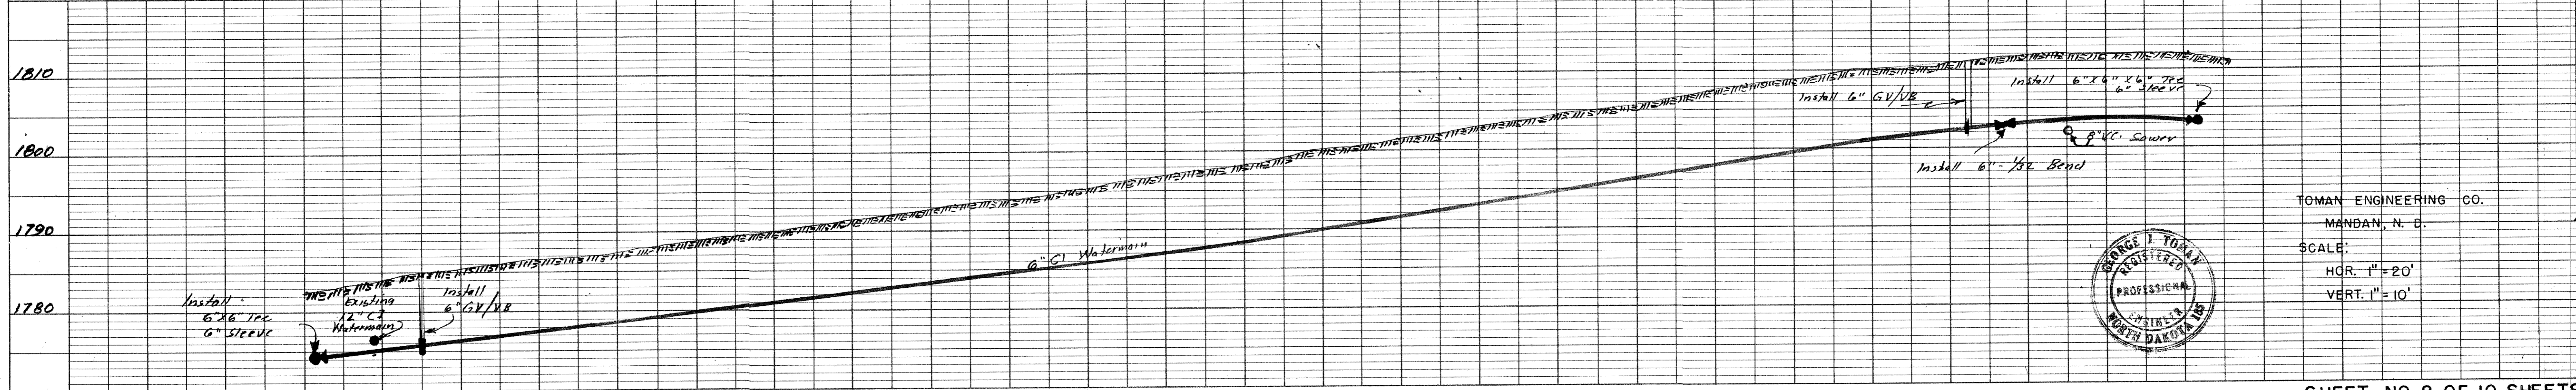

TOMAN ENGINEERING CO.
 MANDAN, N. D.
 SCALE:
 HOR. 1" = 20'
 VERT. 1" = 10'