



PLAN	SURVEYED	DATE
NOTE BOOK	PLOTTED	BY
ALIGNMENT CHECKED	BY	
BY		
PT. OF WAY CHECKED		
No.		

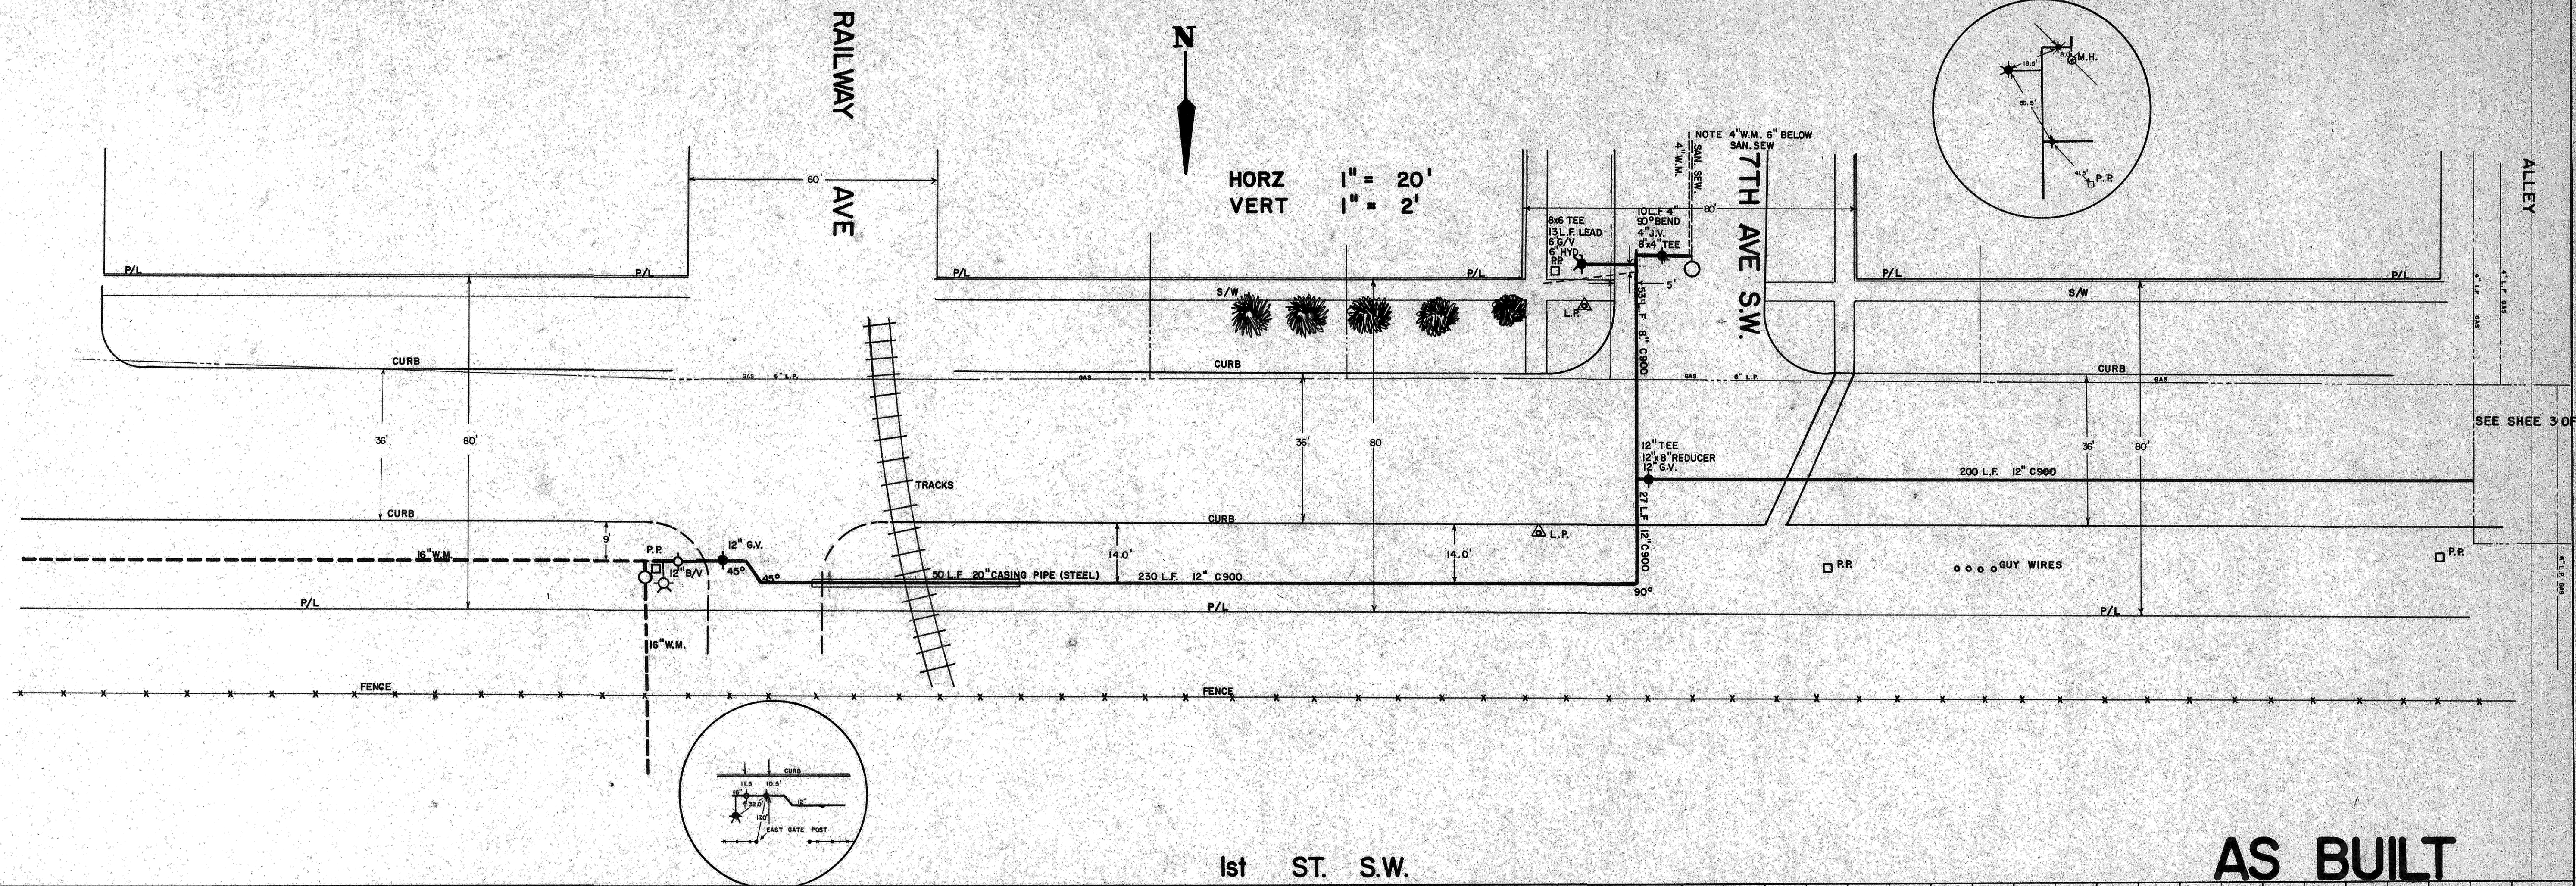

PROFILE	SURVEYED	DATE
NOTE BOOK	PLOTTED	BY
STRUCTURE NOTATIONS CHECKED	BY	
No.		

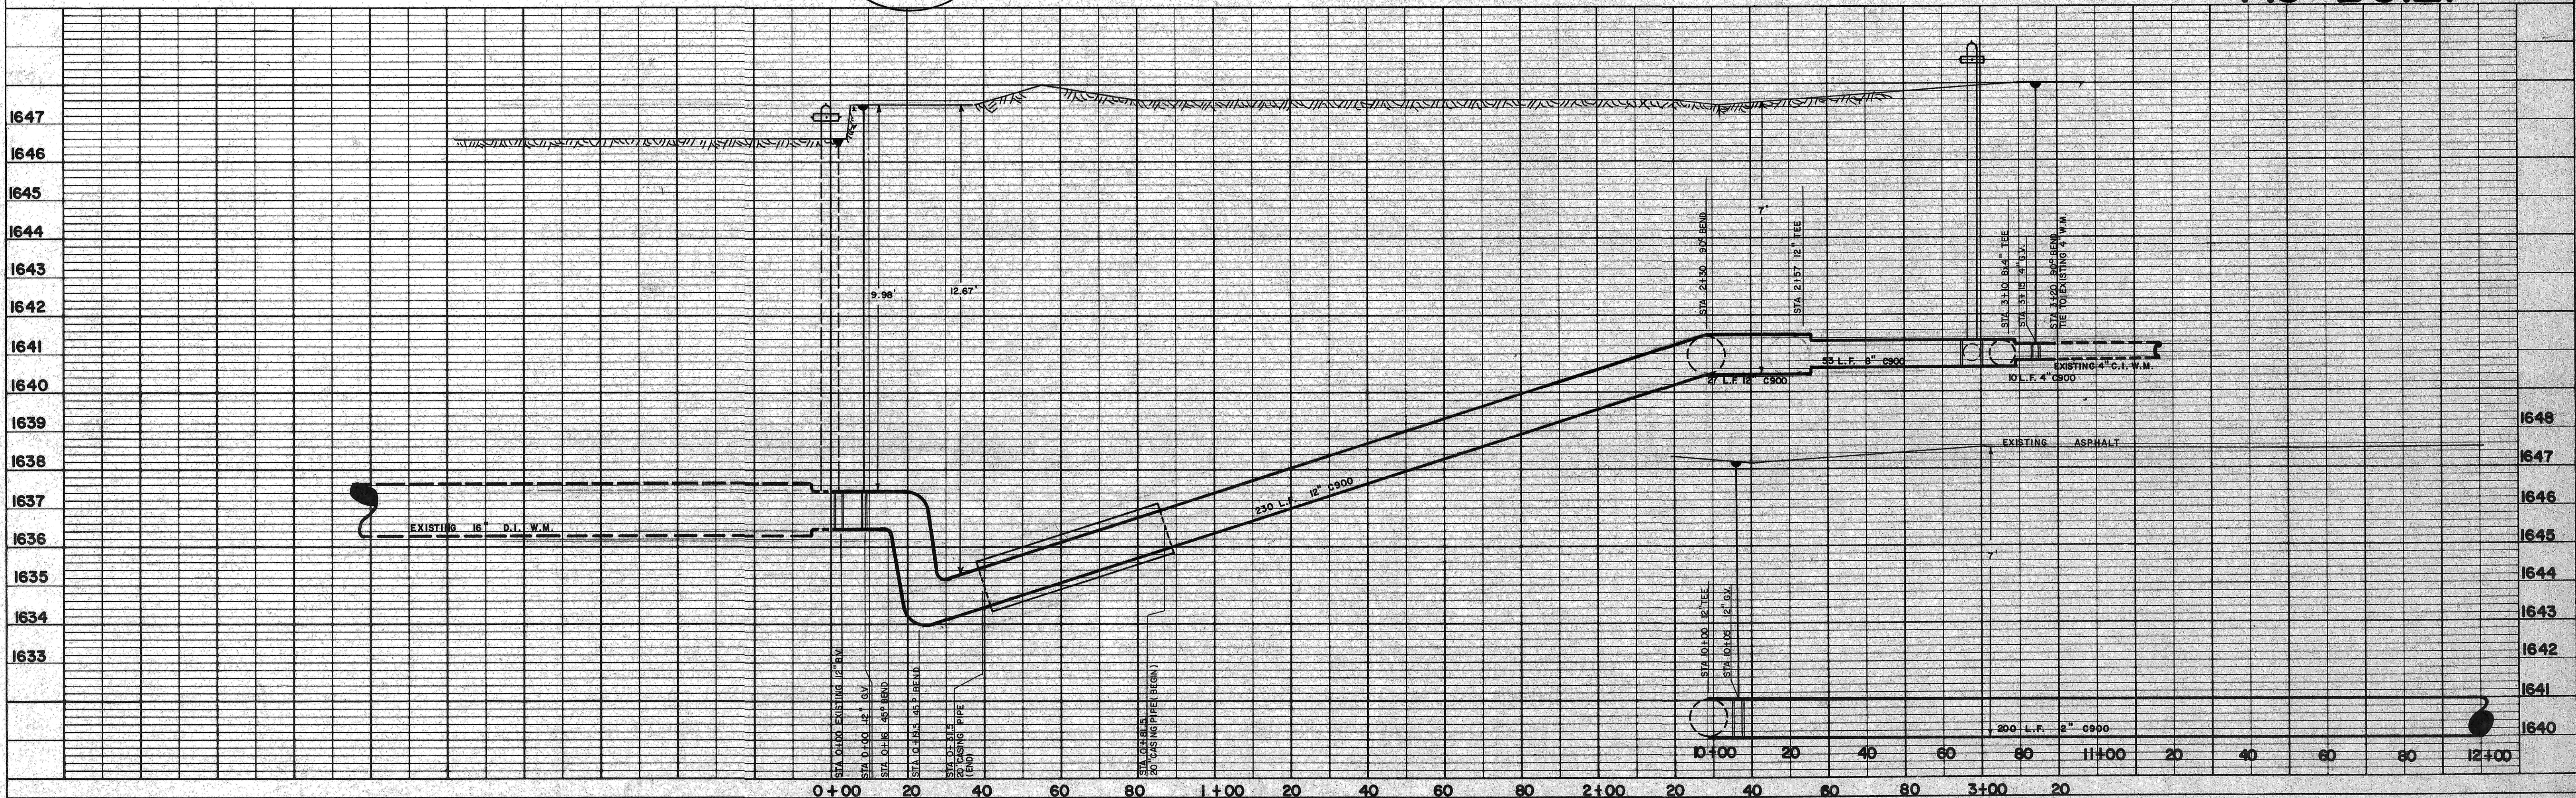

AS BUILT