


APRIL 1993
 0 20 40 60 80
 SCALE: 1"=20' HOR
 1"=5' VER

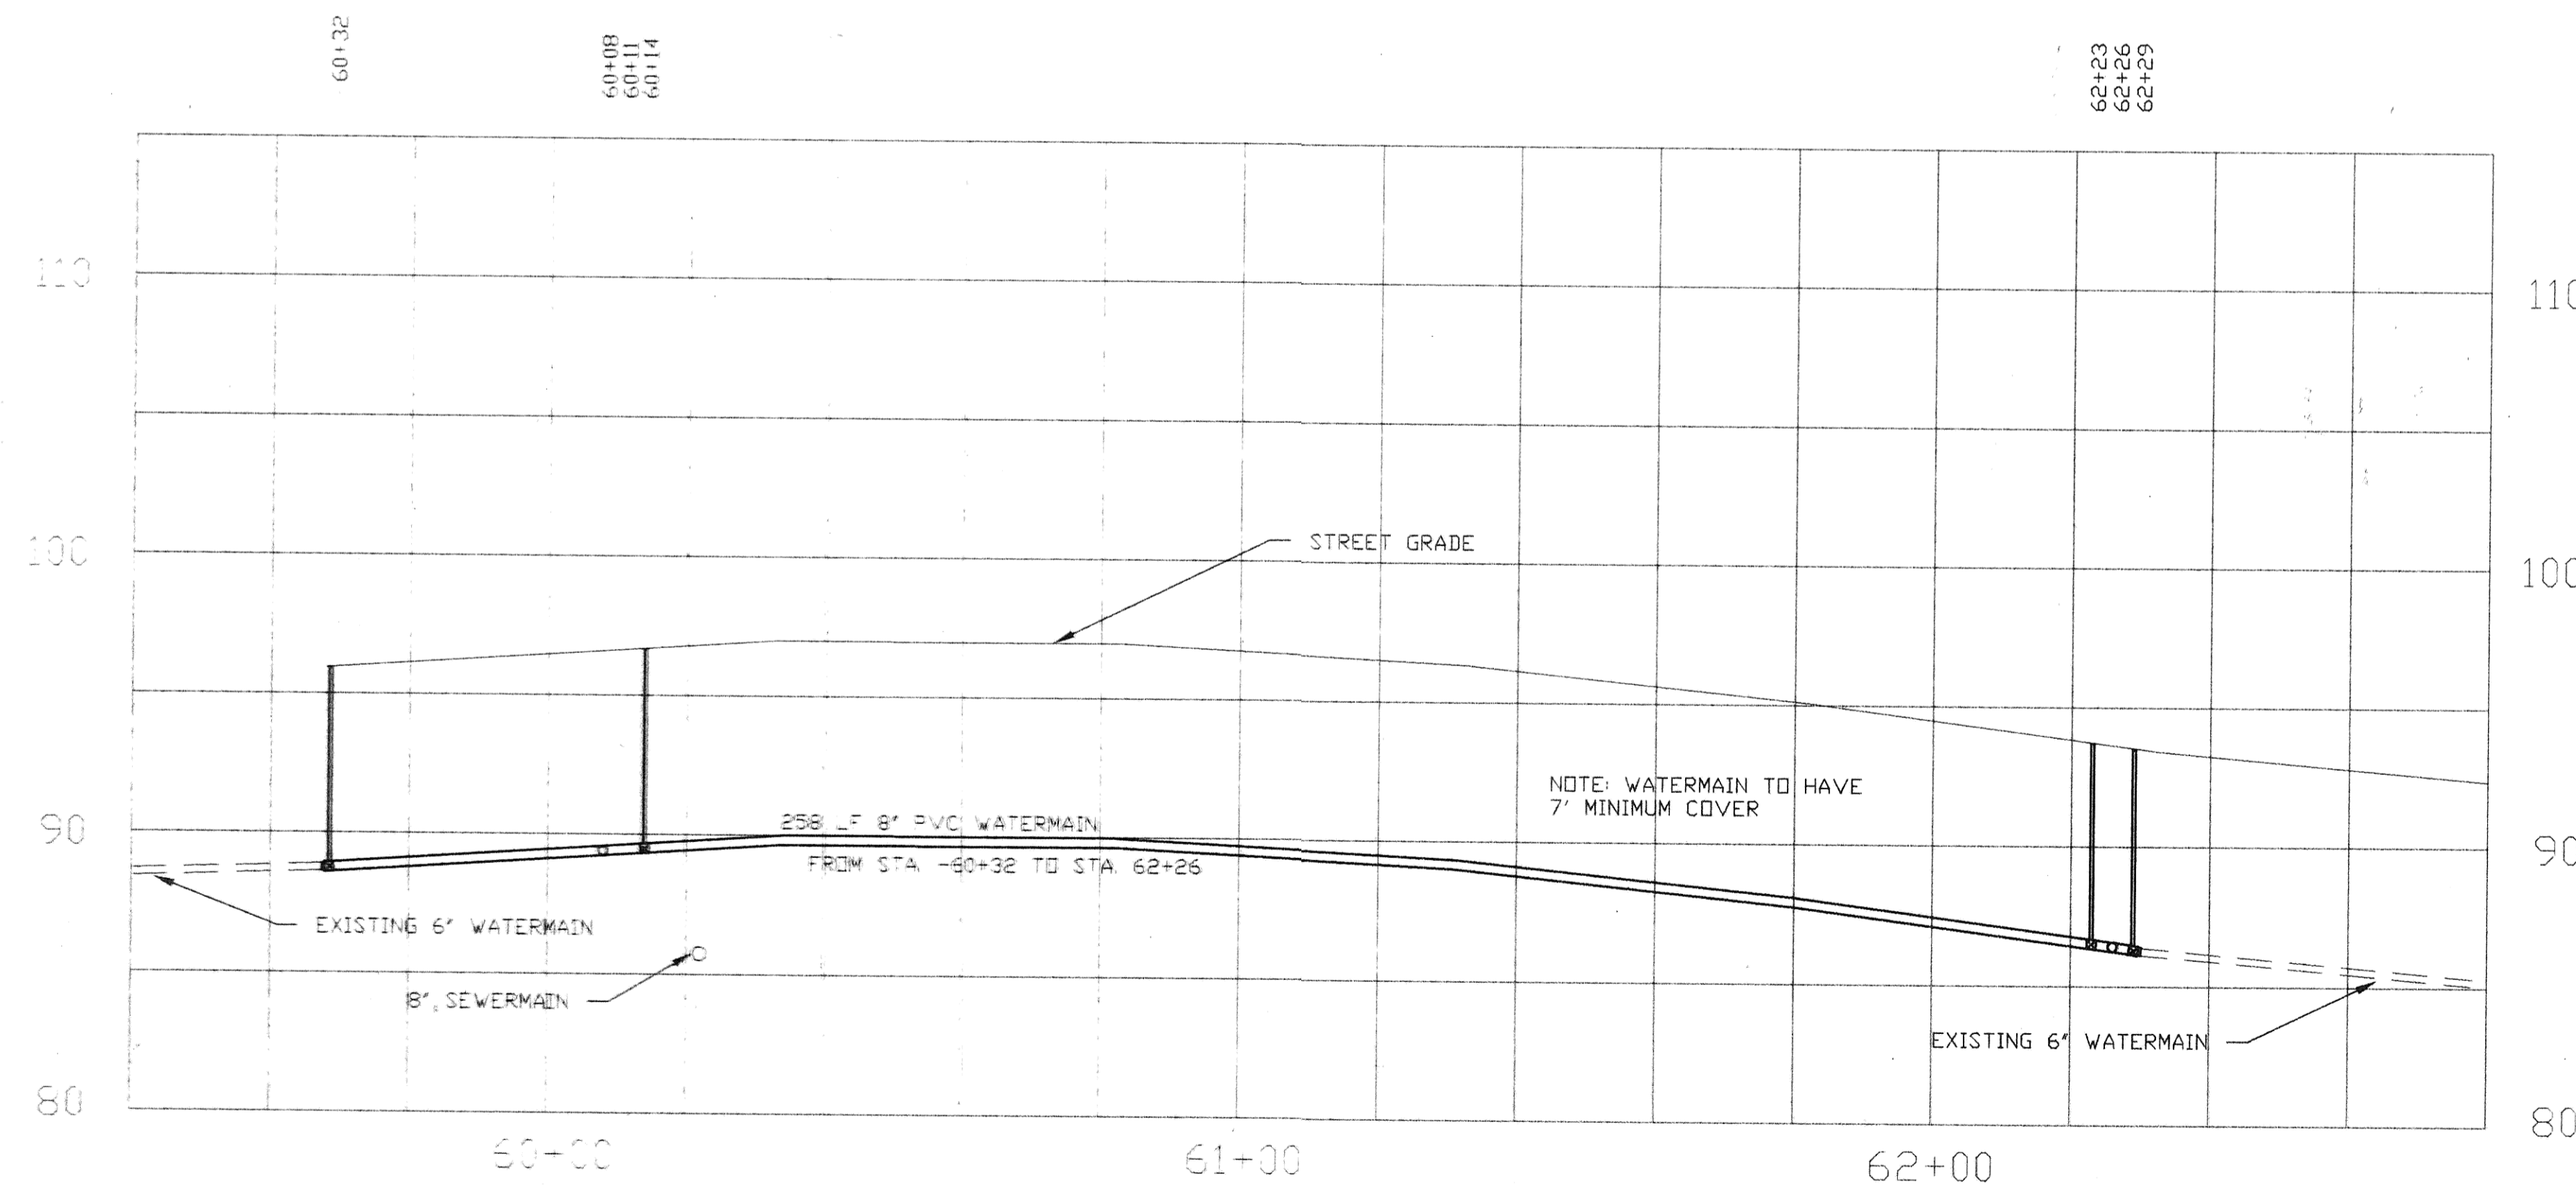

- STA. -60+32
TIE INTO EXISTING 6' W.M.
8' G.V.
8x6 REDUCER
- STA. 60+08
TIE INTO 8x8 TEE
- STA. 60+11
225° BEND
- STA. 60+14
8' G.V.
- STA. 62+23
8' G.V.
- STA. 62+26
8x8 CROSS
8' PLUG
7 LF 8' PVC
8x6 TEE
8' PLUG
- STA. 62+29
TIE INTO EXISTING 6' W.M.
6' G.V.
8' PLUG

FEB. 1995	JW	TL	AS BUILT
DATE	REV. BY	APPR. BY	DESCRIPTION
CITY OF MANDAN, NORTH DAKOTA ENGINEERING DEPARTMENT			
WATER IMPROVEMENT PROJECT 93-4 2ND AVE NW			
CITY ENG.	T. LITTLE	DRAWN BY	J. WRIGHT
APPR. BY		CHECKED BY	
PROJECT NO.	93-4	DISTRICT NO.	N/A
		SCALE	AS SHOWN
		DATE	
		SHEET	7 OF 9