


APRIL 1993  
 0 20 40 60 80  
 SCALE: 1"=20' HOR  
 1"=5' VER

3RD AVE NW

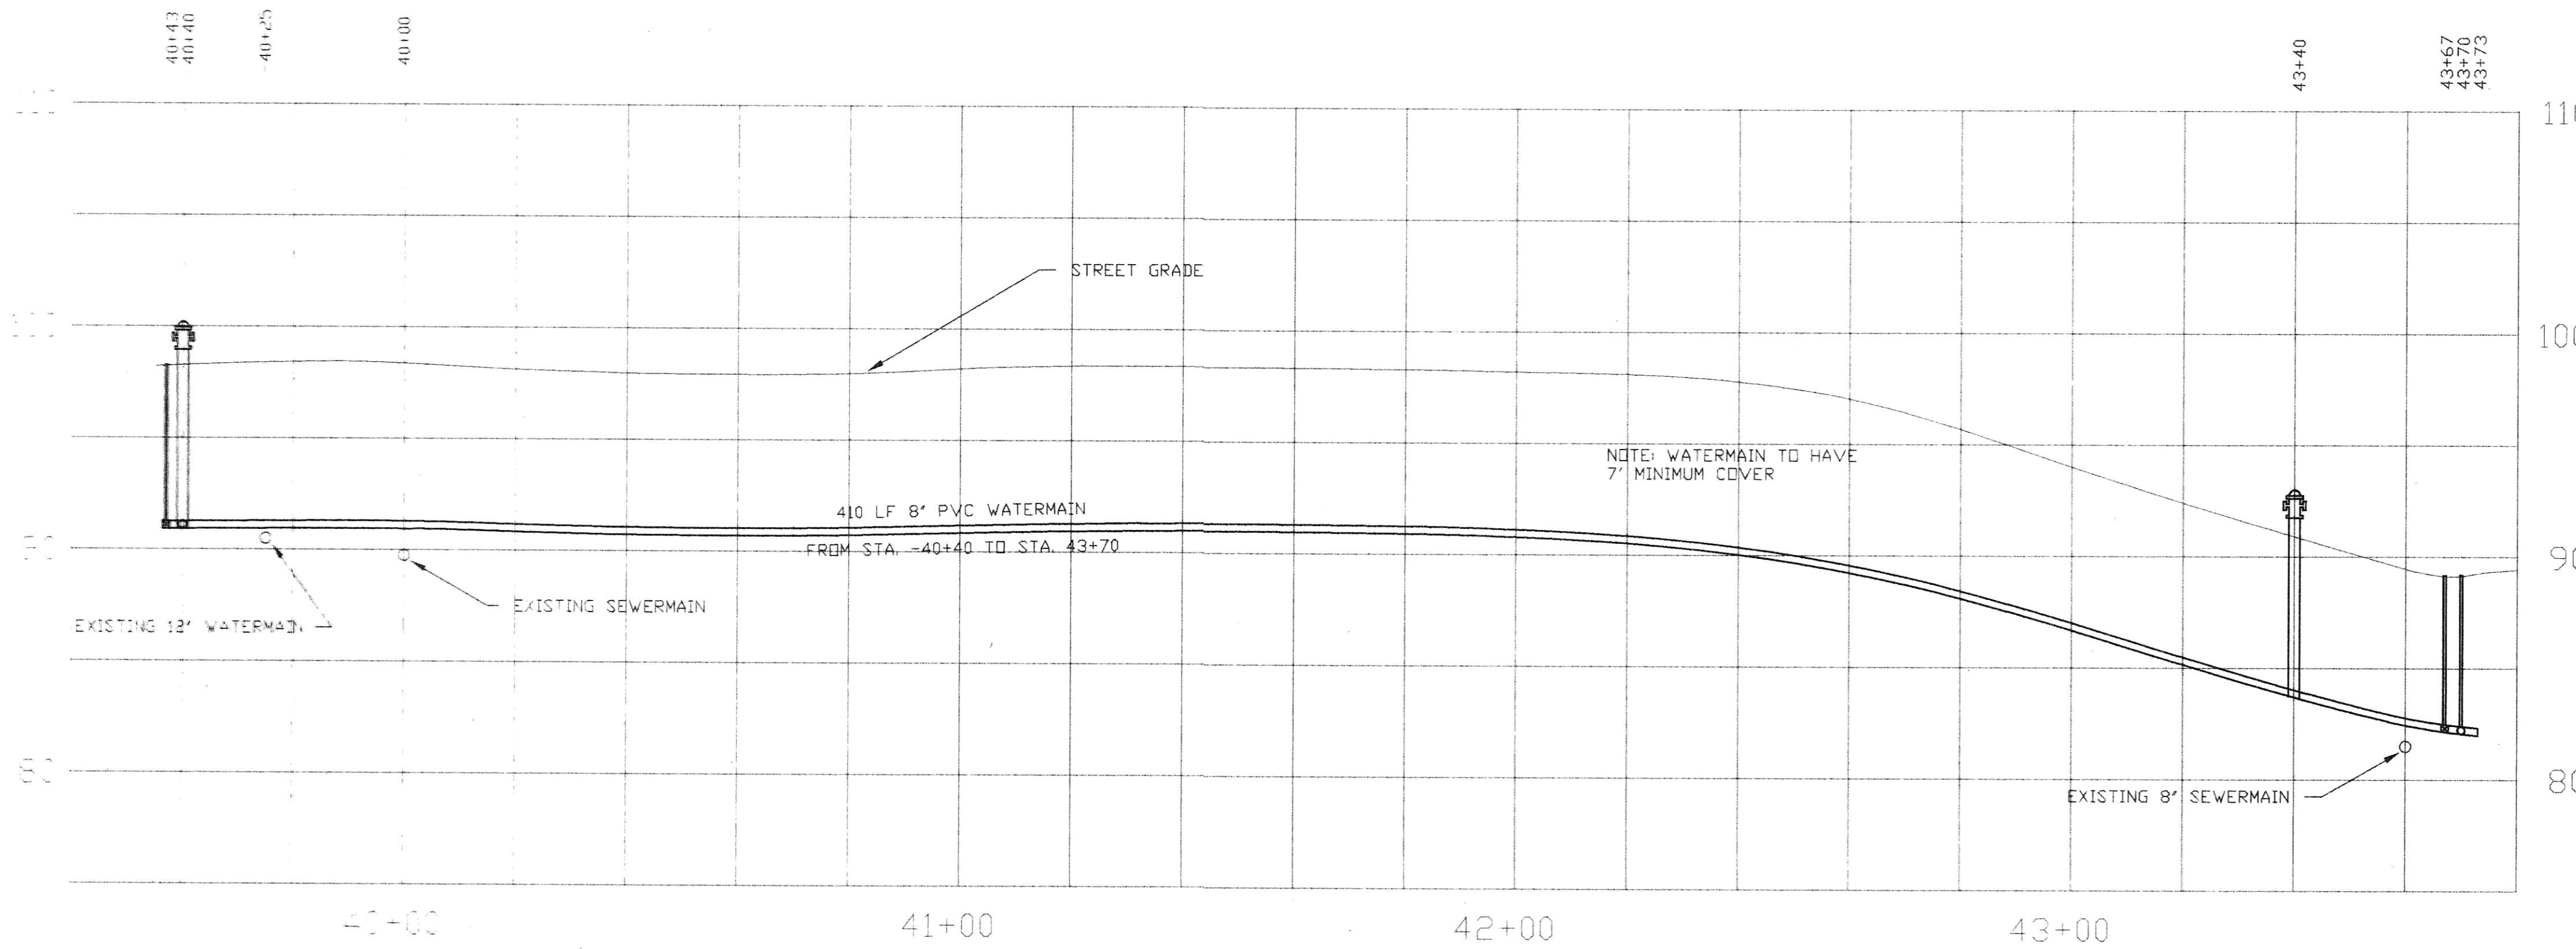

- STA. -40+43  
TIE INTO EXISTING 6' W.M.  
6' G.V.  
8' PLUG
- STA. -40+40  
REMOVE AND SALVAGE HYDRANT  
6' HYDRANT  
10 LF 6' HYDRANT LEAD  
6' G.V.  
6 LF 6' HYDRANT LEAD  
6x8 TEE  
7 LF 6' HYDRANT LEAD  
6' G.V.  
3 LF 6' HYDRANT LEAD  
6x8 TEE
- STA. 43+40  
6' HYDRANT  
14 LF 6' HYDRANT LEAD  
6' G.V.  
3 LF 6' HYDRANT LEAD  
6x8 TEE
- STA. 43+67  
8' G.V.
- STA. 43+70  
TIE INTO EXISTING 6' W.M.  
2- 6x8 REDUCER  
2- 8' G.V.  
3 LF 8' PVC  
8x8 CROSS  
3 LF 8' PVC
- STA. 43+73  
8' PLUG

FEB. 1995	JW	TL	AS BUILT
DATE	REV. BY	APPR. BY	DESCRIPTION
CITY OF MANDAN, NORTH DAKOTA ENGINEERING DEPARTMENT			
WATER IMPROVEMENT PROJECT 93-4 3RD AVE NW			
CITY ENG. BY	T. LITTLE	DRAWN BY	J. WRIGHT
APPR. BY		CHECKED BY	
PROJECT NO.	93-4	DISTRICT NO.	N/A
SCALE:	AS SHOWN	DATE:	
SHEET	8	OF	9