

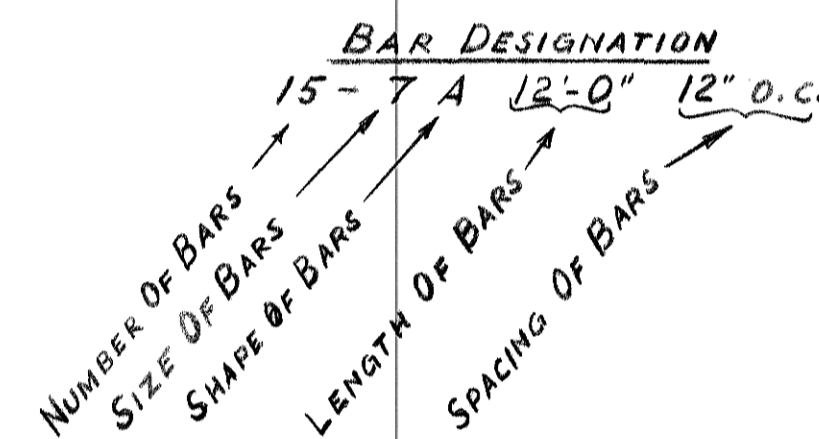
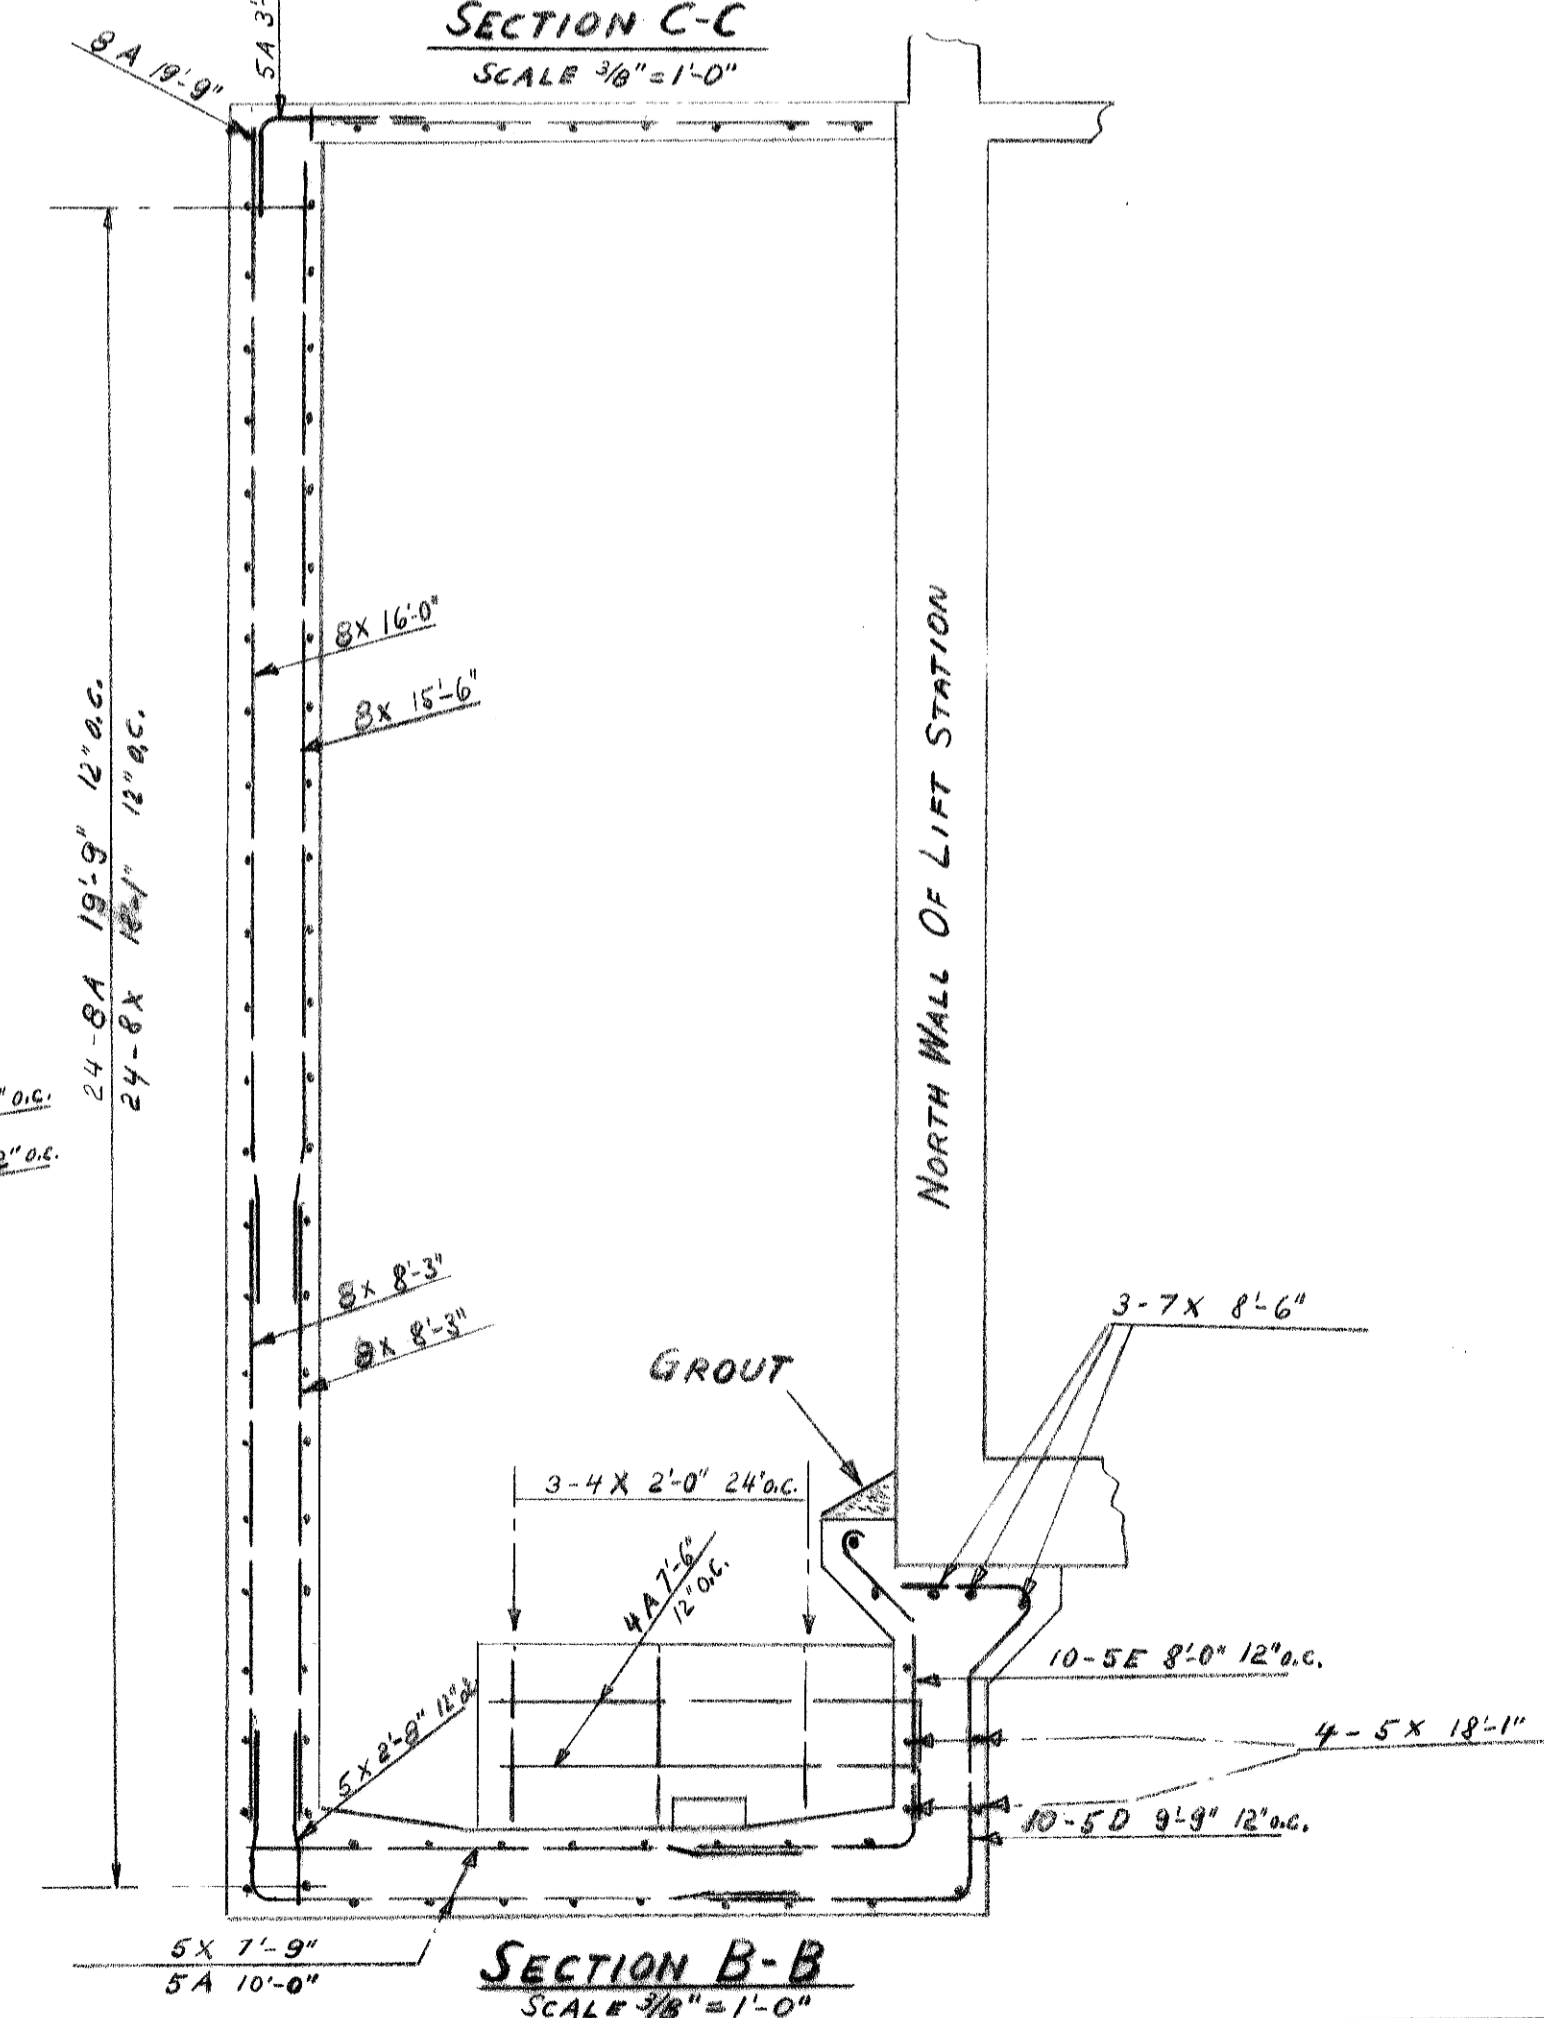


NOTE: ALL REINFORCEMENT STEEL LAPPED A DISTANCE OF 30 BAR DIAMETERS. ALL REINFORCEMENT HAS A MINIMUM CLEAR DISTANCE OF 2 1/2" TO FACE CONCRETE UNLESS OTHERWISE SHOWN.

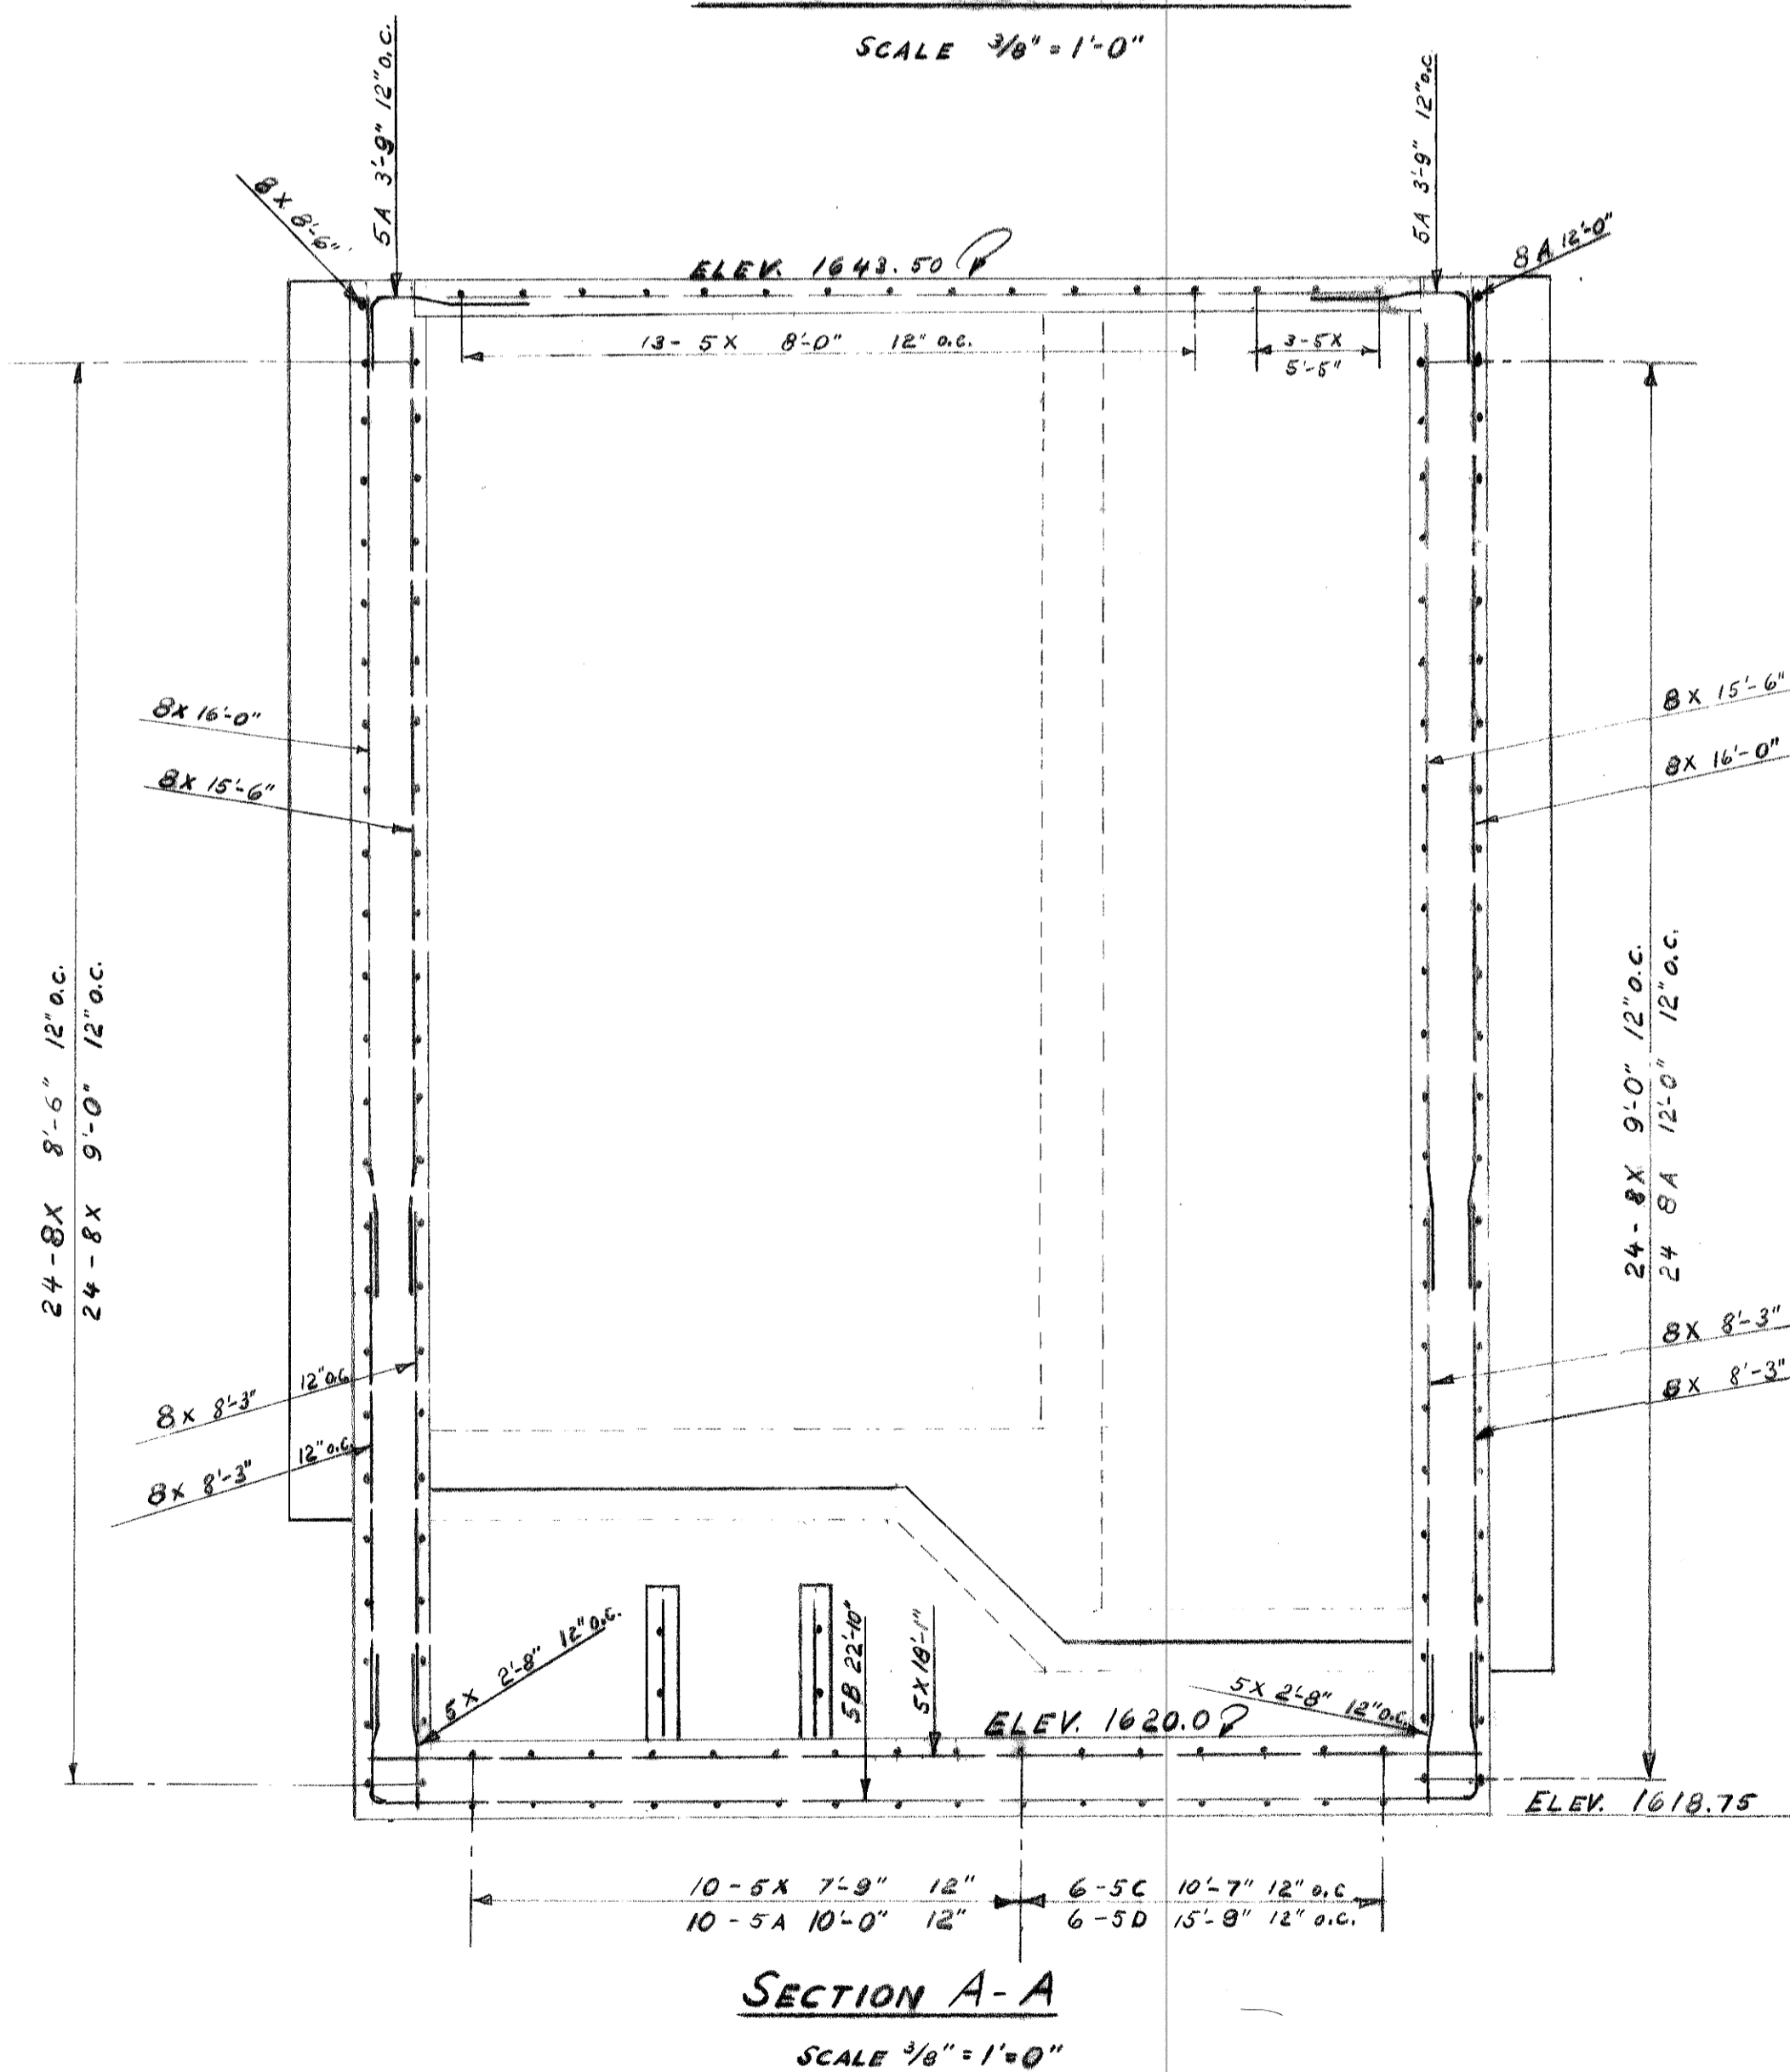

BAR TYPE	DIMENSIONS IN FEET & INCHES					
	A	B	C	D	E	F
8A 19'-9"	2'-9"	17'-0"				
8A 12'-0"	3'-0"	9'-0"				
5A 10'-0"	2'-3"	7'-9"				
5A 3'-9"	1'-6"	2'-3"				
4A 7'-6"	1'-6"	6'-0"				
5B 22'-10"	2'-3"	18'-4"	2'-3"			
8B 4'-3"	1'-6"	1'-3"	1'-6"			
5C 10'-7"	1'-6"	8'-6"	0'-7"			
5D 15'-9"	0'-6"	10'-0"	1'-0"	2'-0"	1'-0"	2'-3"
5D 9'-9"	3'-0"	3'-9"	1'-0"	2'-0"	1'-0"	0

DETAILED BAR DIMENSIONS

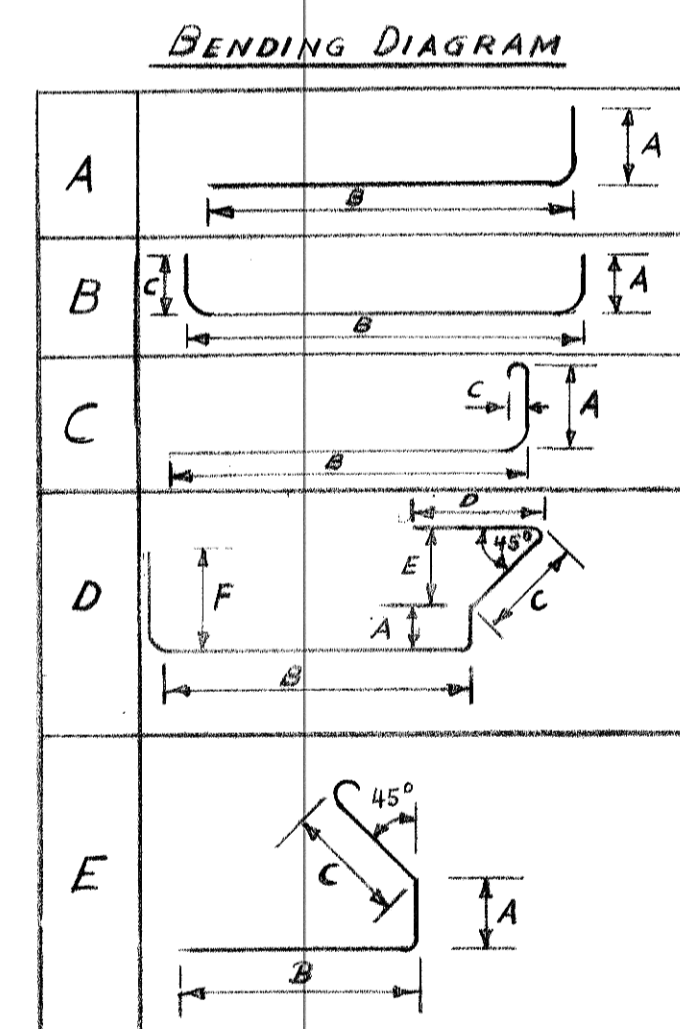

REVISED
Date: 10-28-66
DESTROY
PREVIOUS PRINTS
George J. Toman
Consulting Engineer



Job: SANITARY SEWER IMPROVEMENT DISTRICT No. 14
MANDAN, NORTH DAKOTA

Date: AUGUST 1966

File No. _____ Revised: _____

SHEET NO. 6 OF 27 SHEETS
Scale: AS SHOWN

DRAWN BY: R.H. CHECKED BY: [Signature]

WET WELL
REINFORCING DETAIL

George J. Toman
R.P.E. No. 185

Consulting Engineer
Mandan, North Dakota