

NOTE BOOK ALIGNMENT CHECKED.
 RT. OF WAY CHECKED.
 NO.

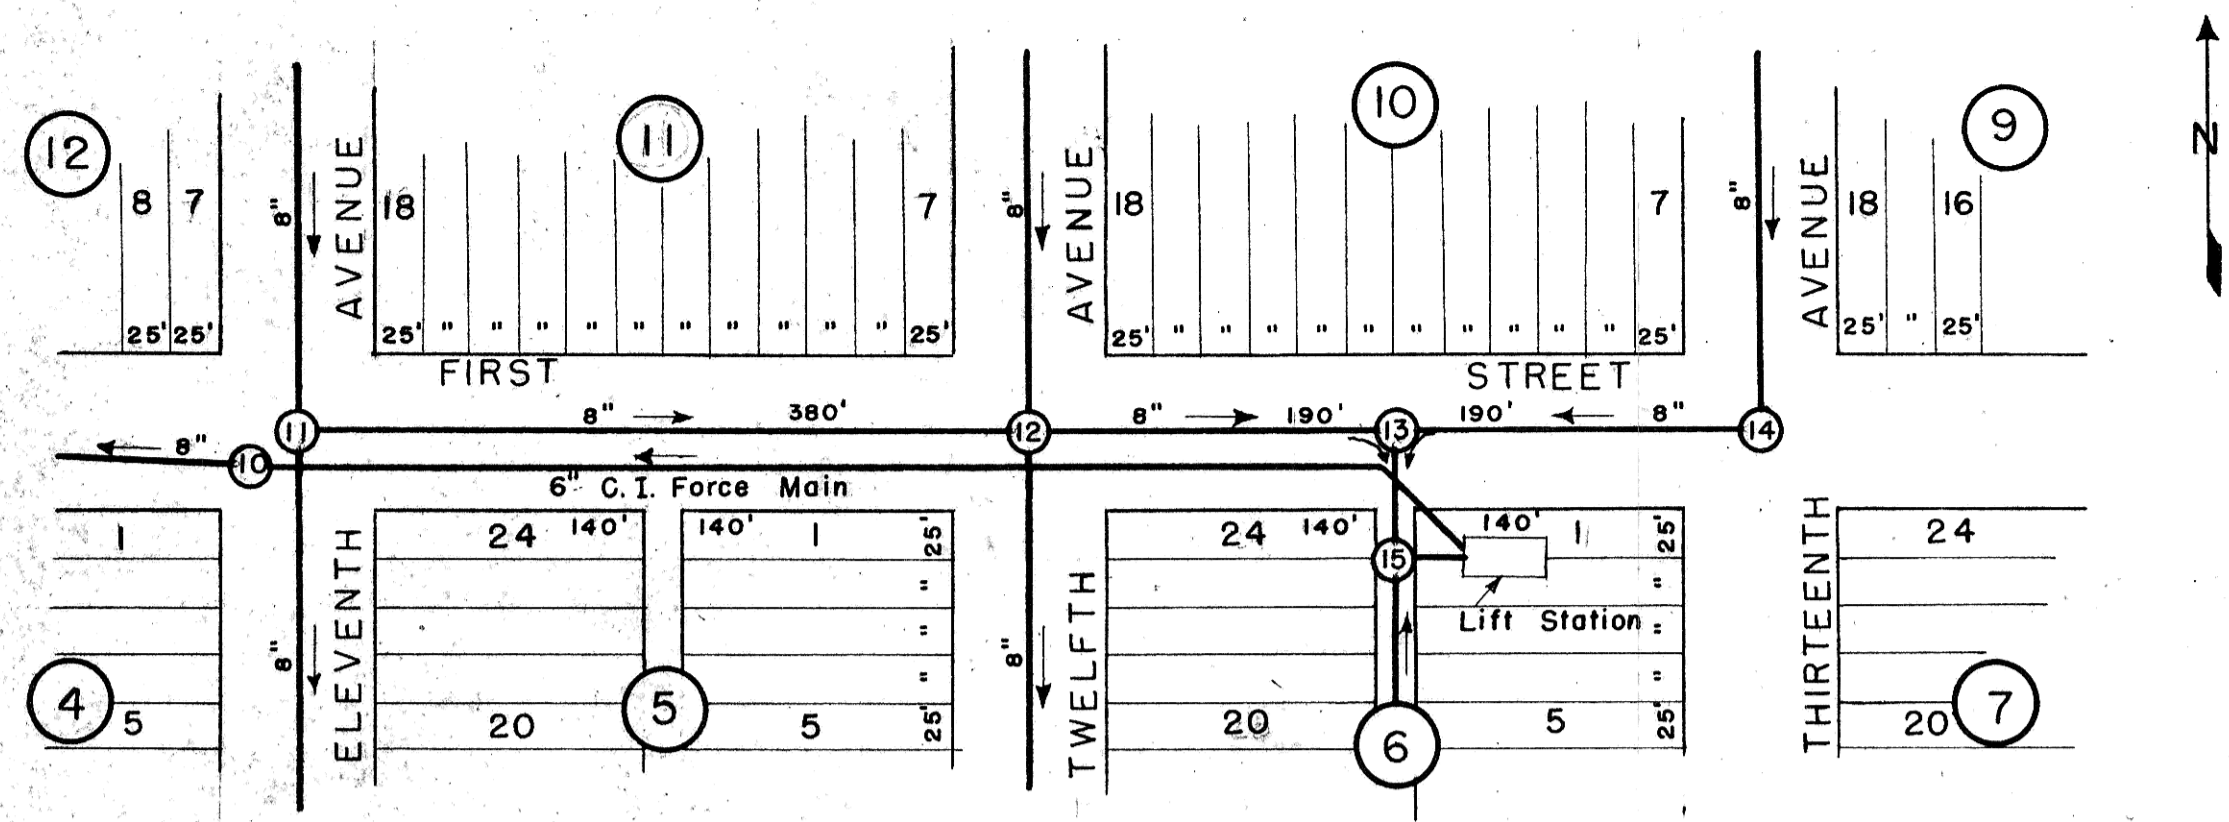


PLATE 6

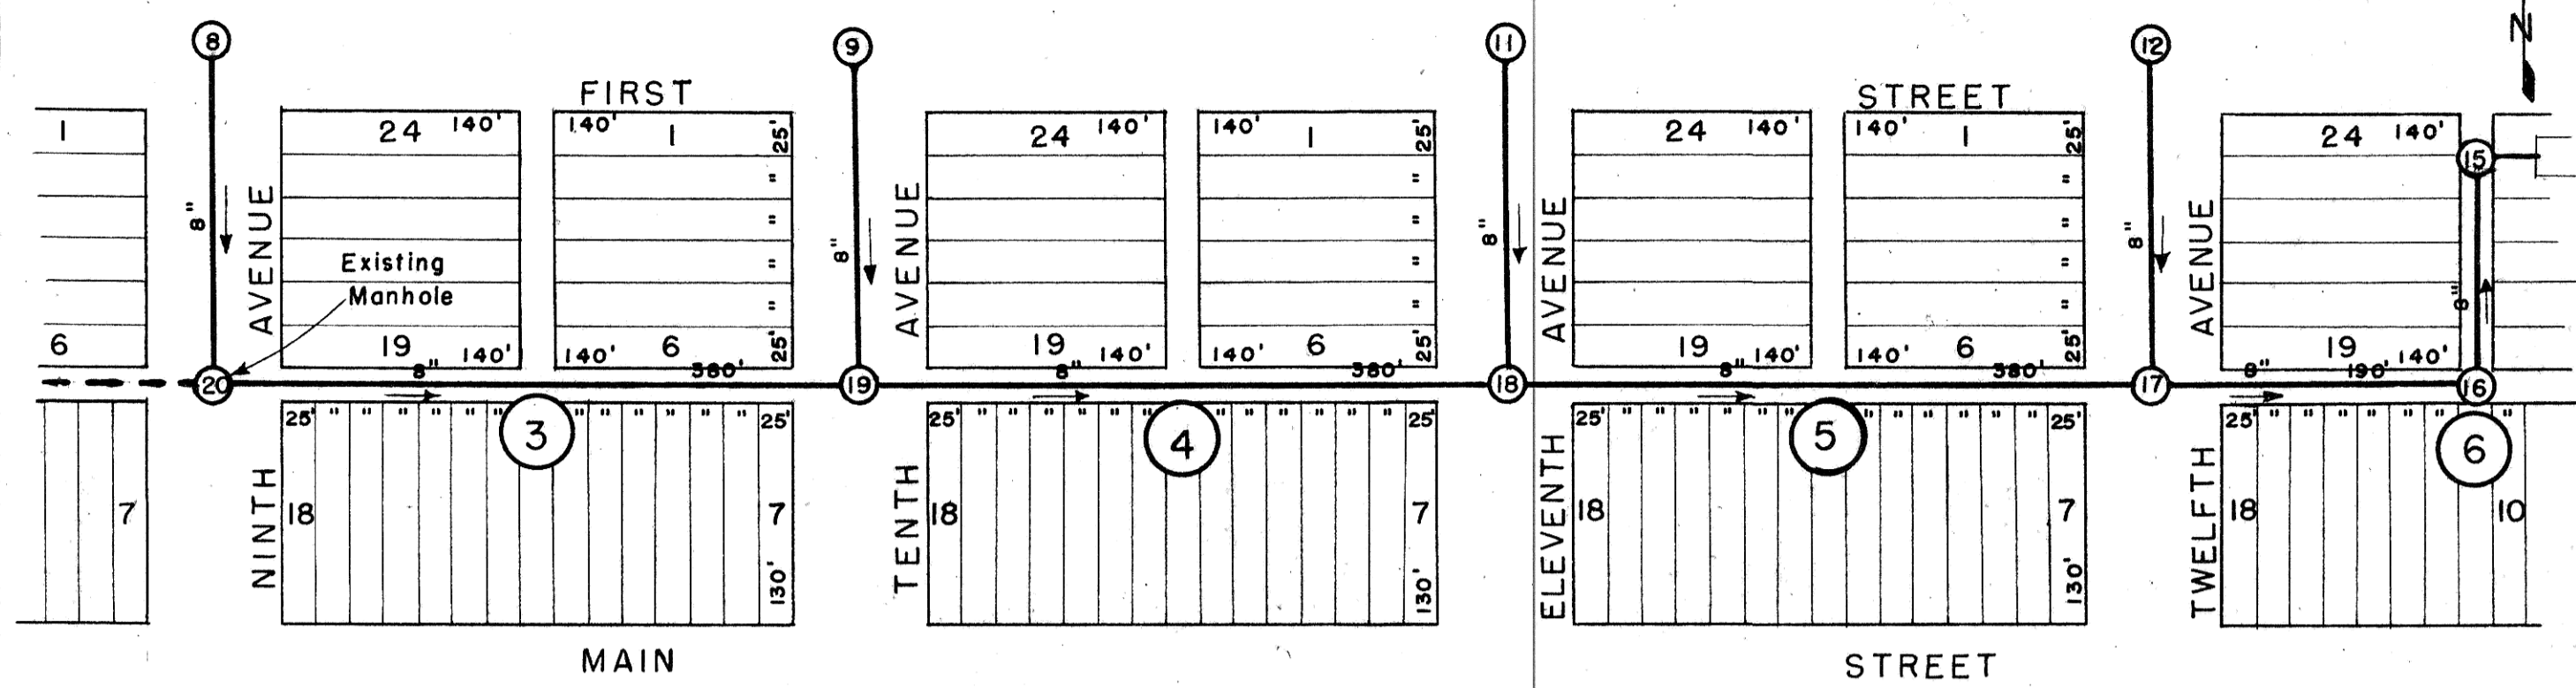
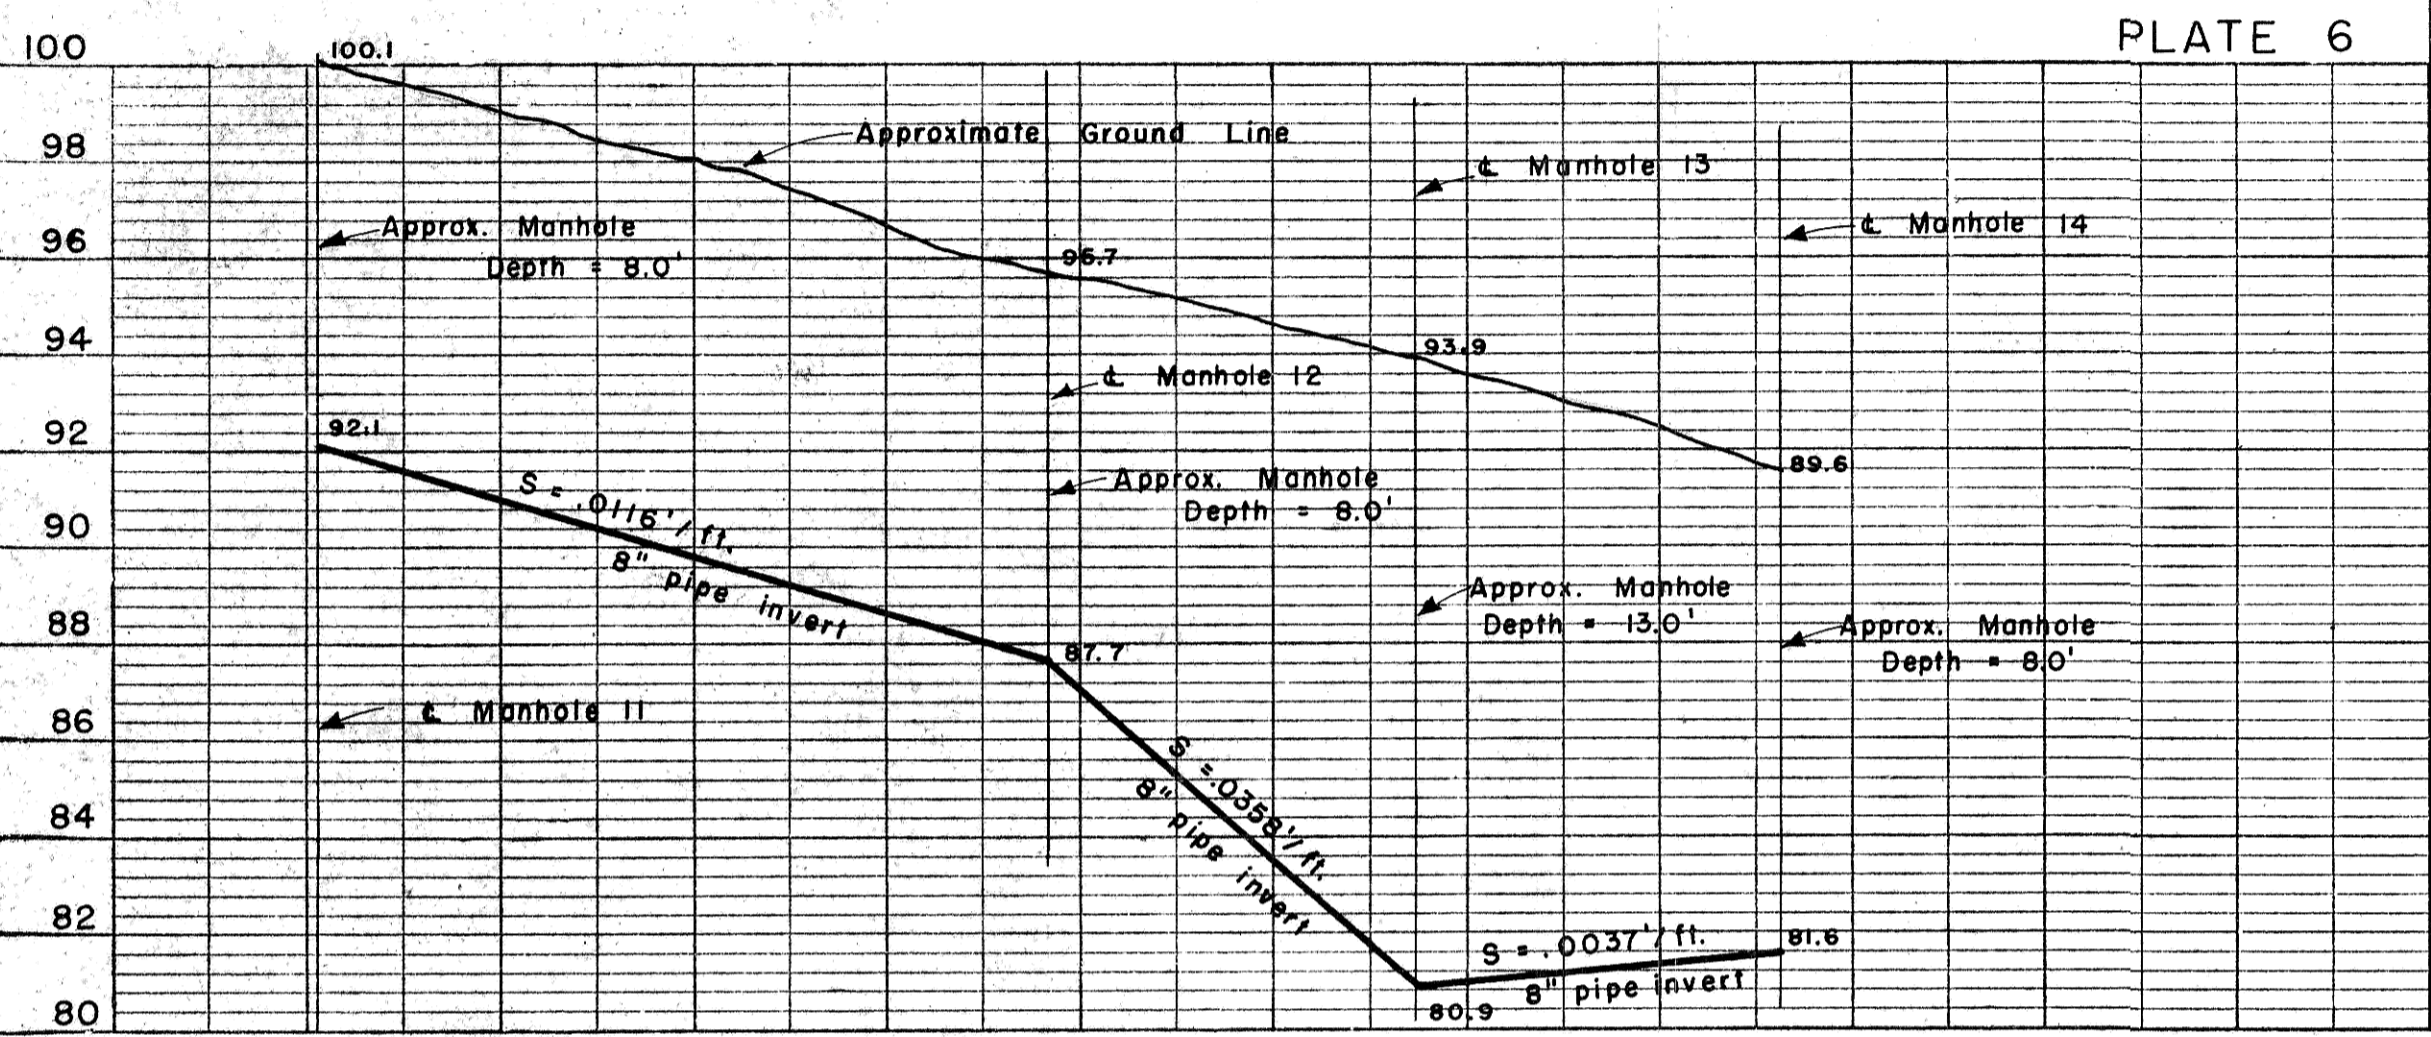


PLATE 7

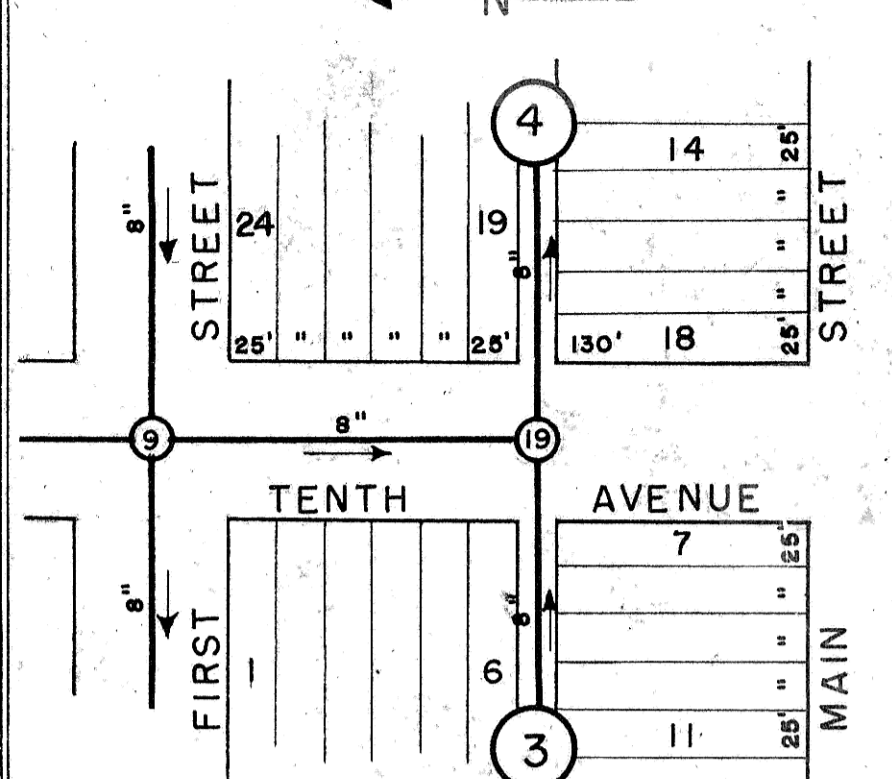
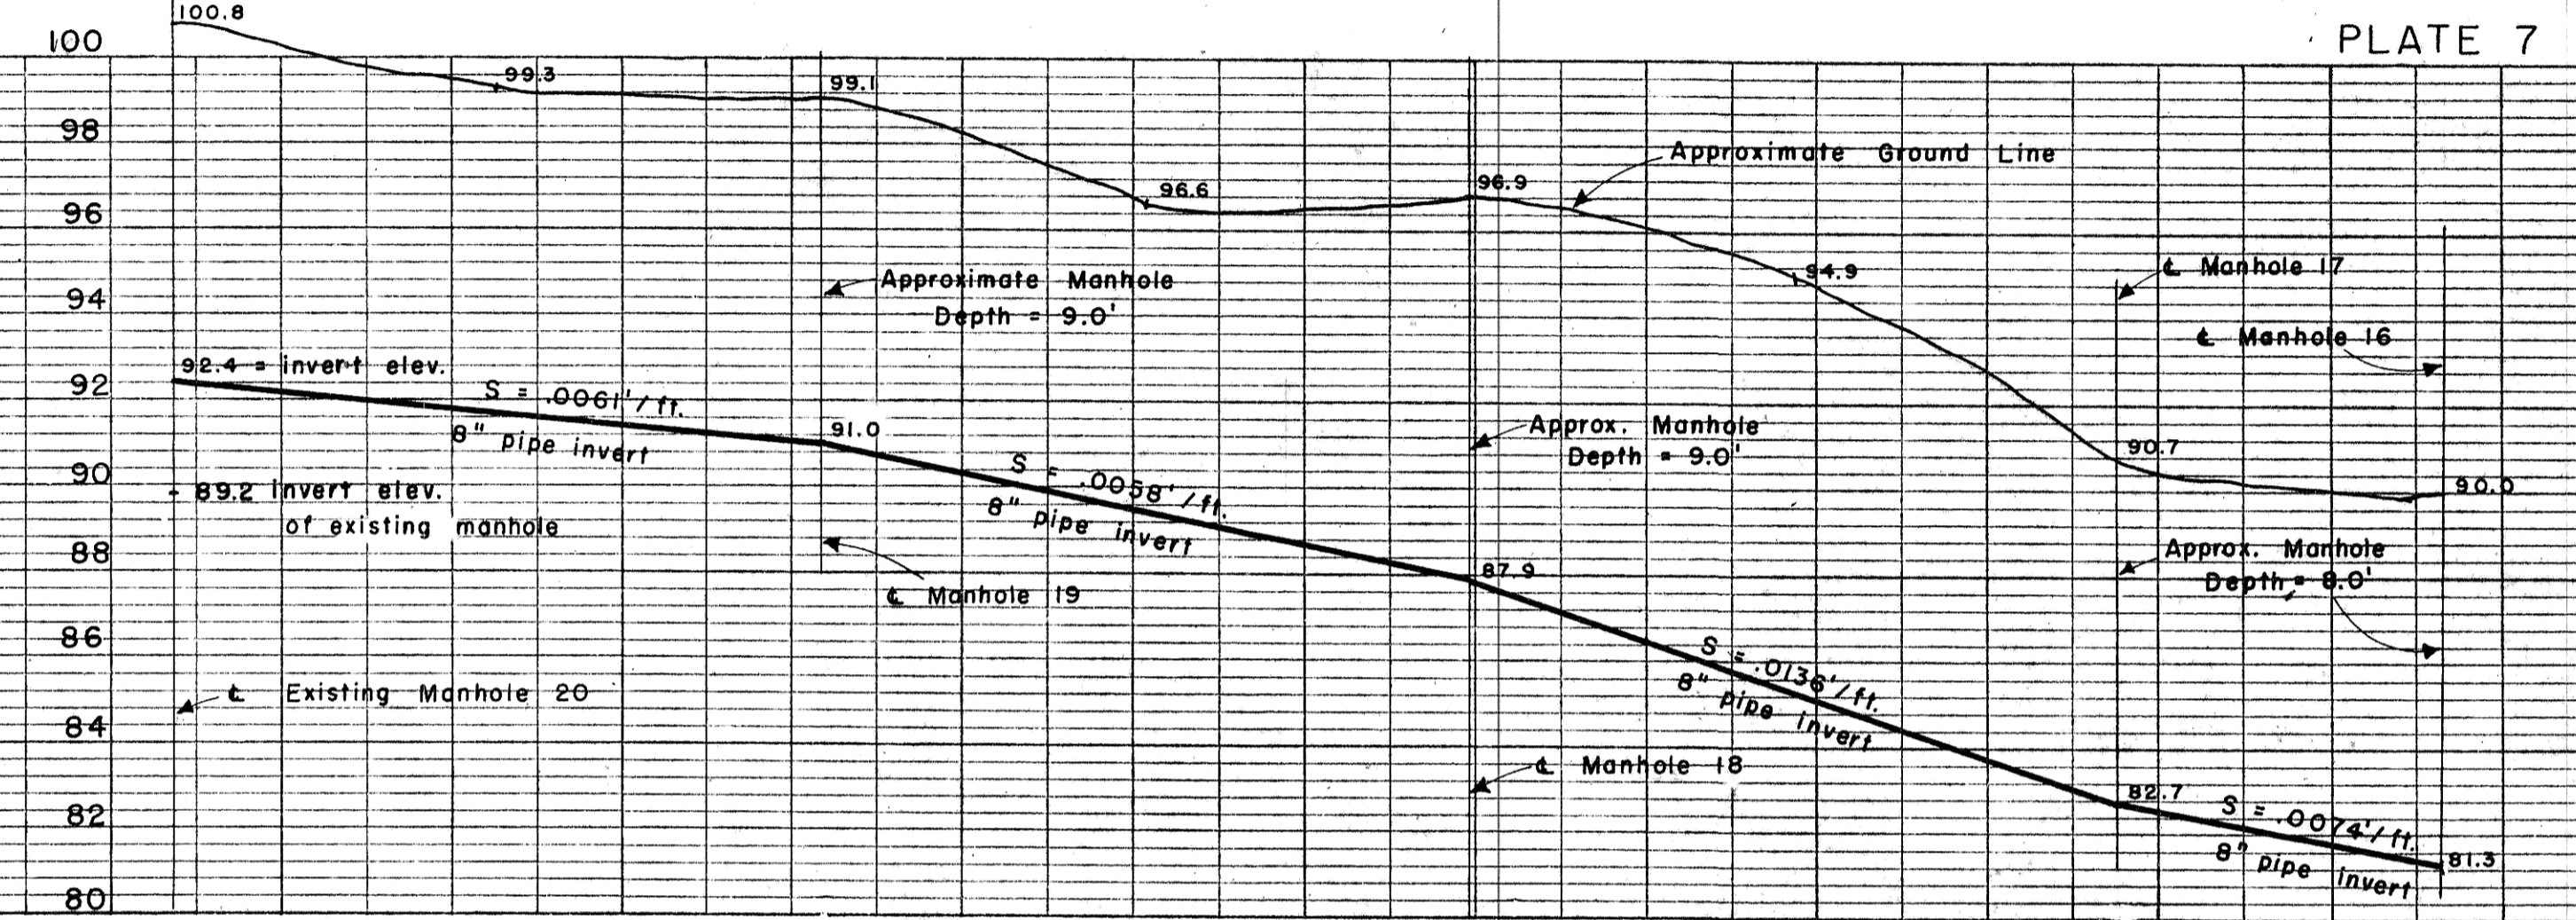


PLATE 8

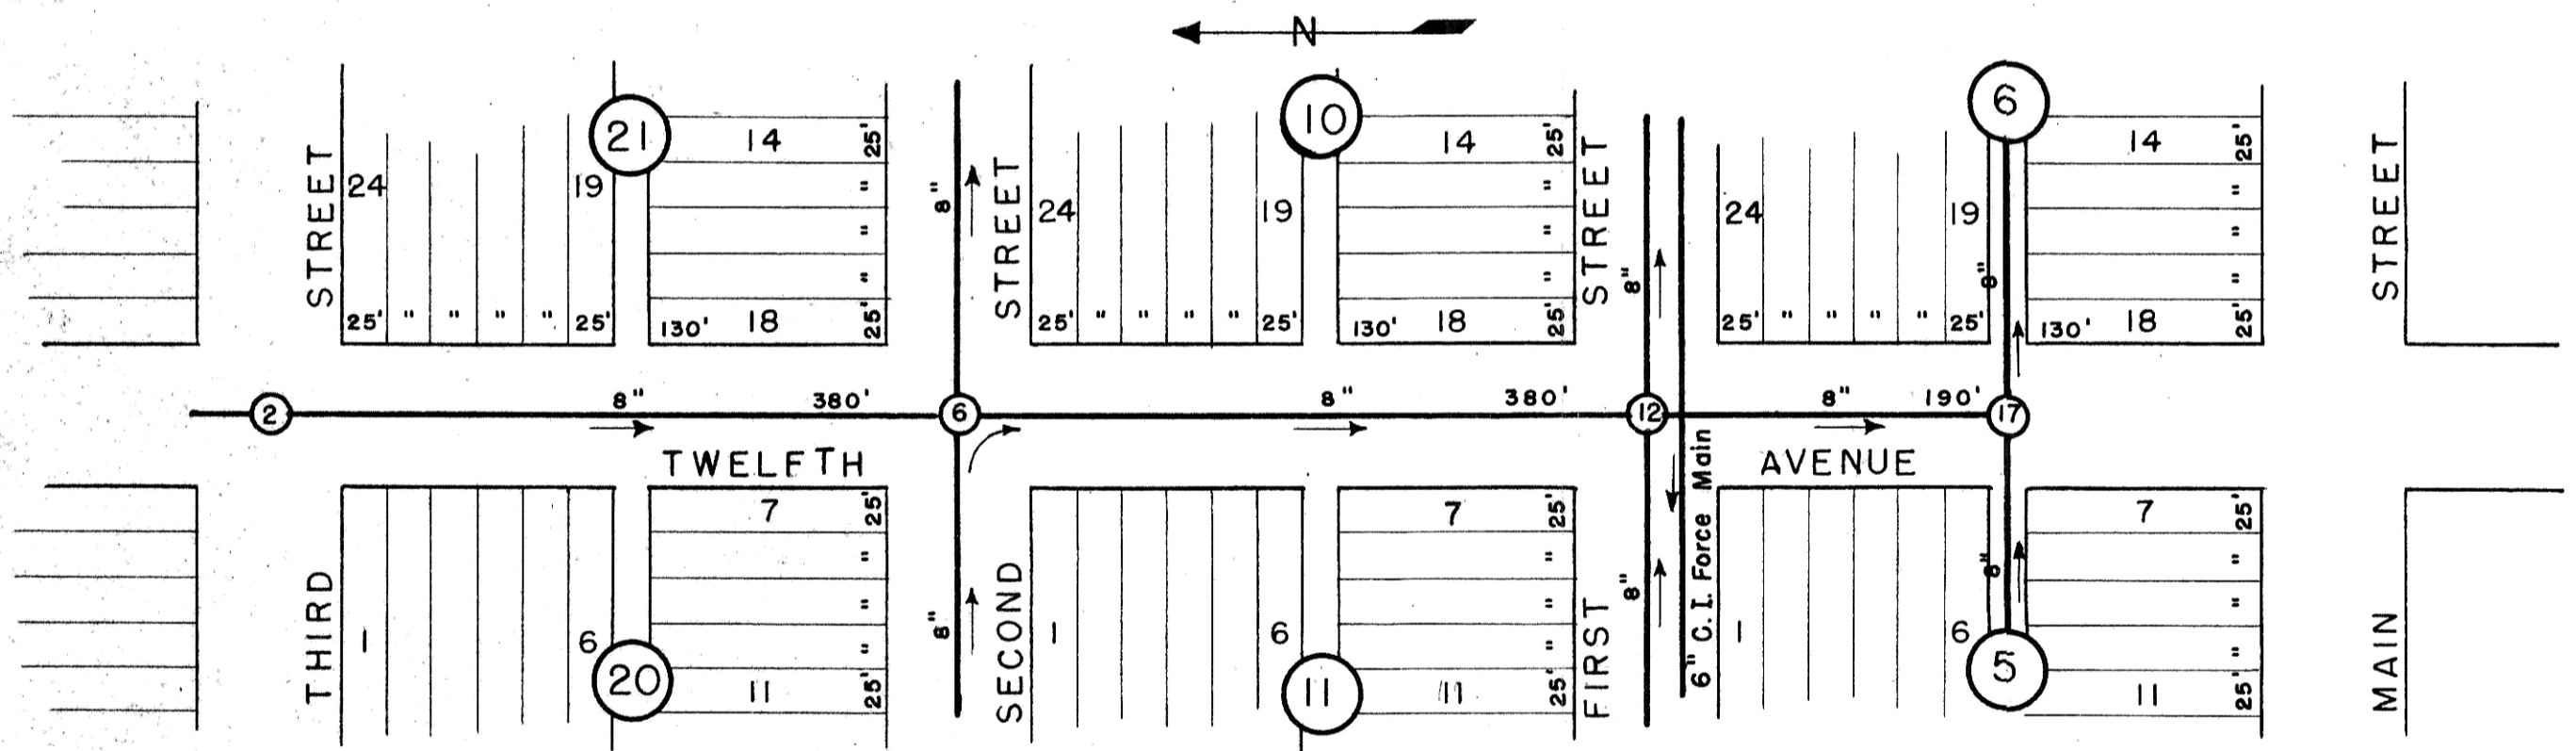
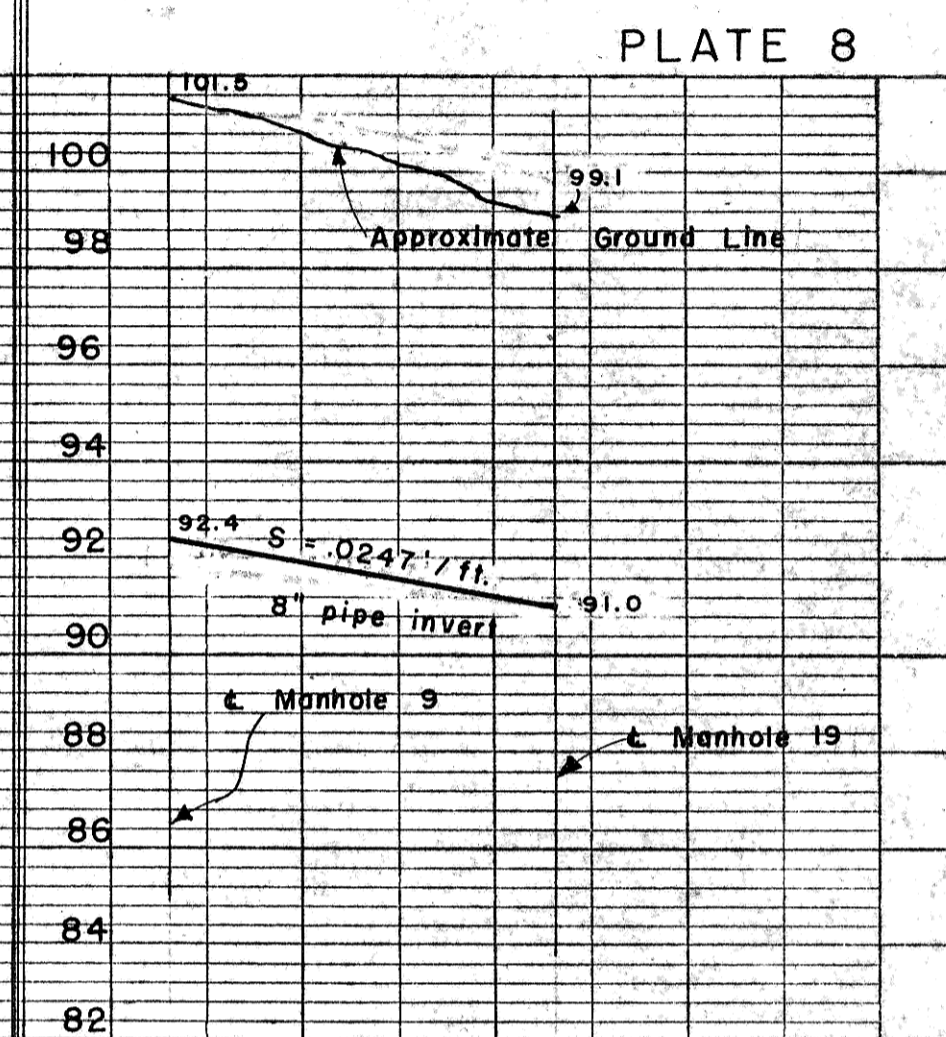


PLATE 9



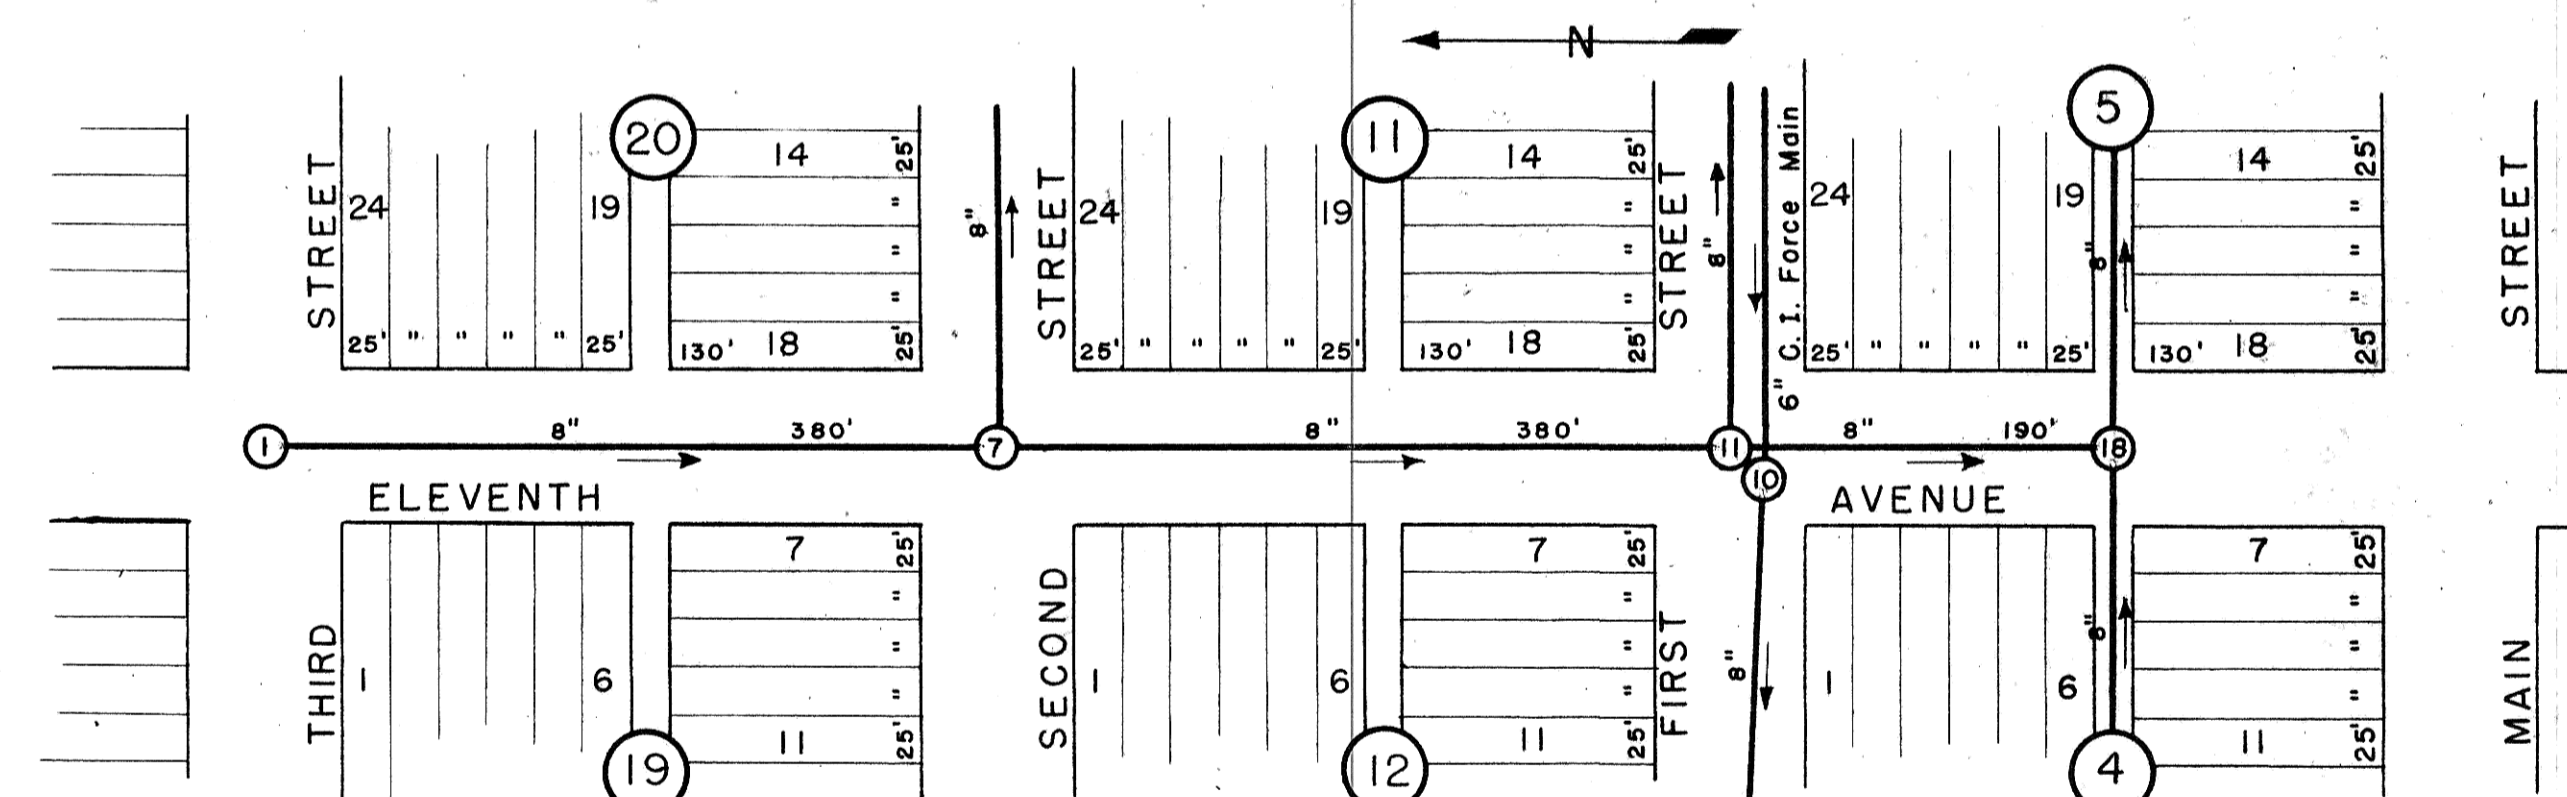


PLATE 10

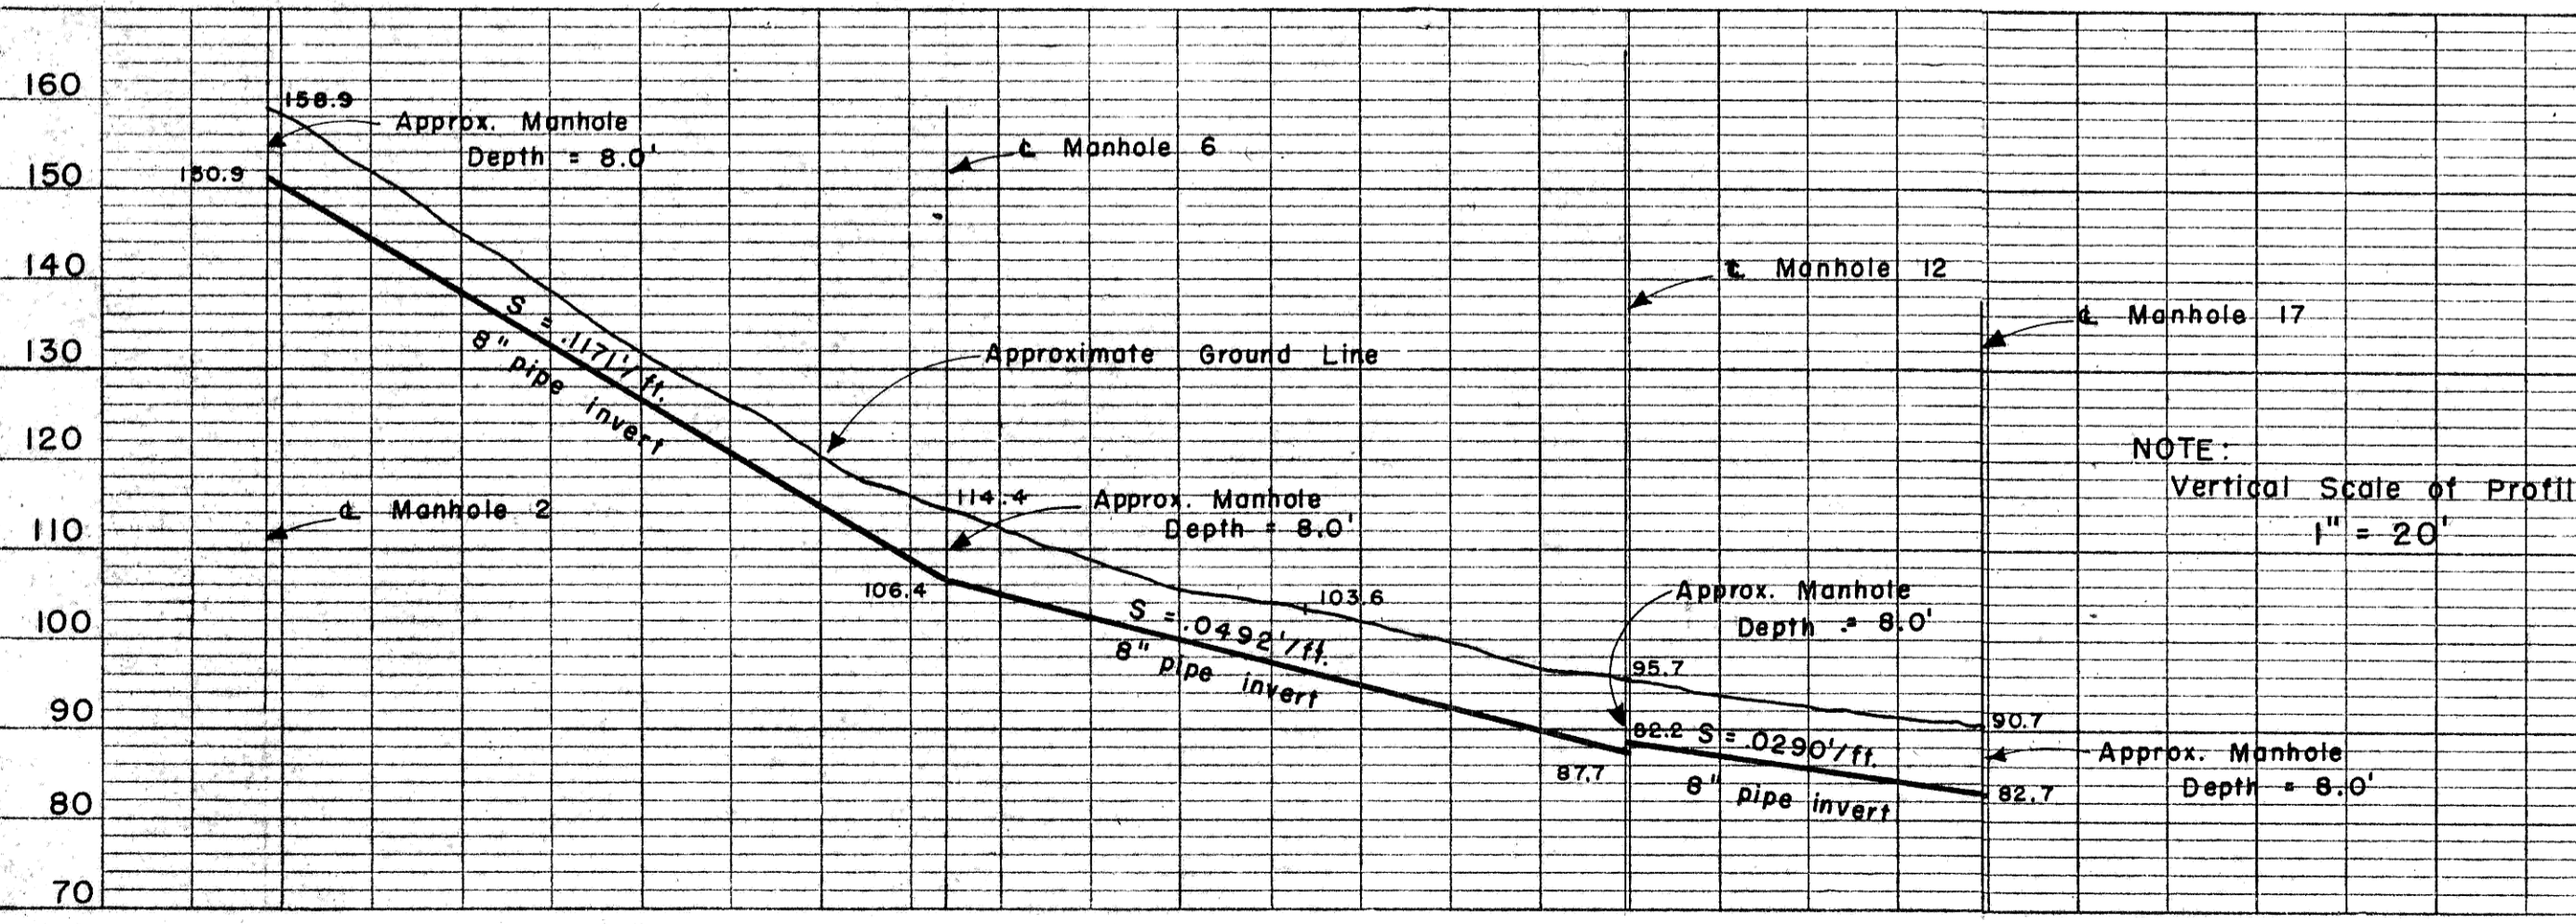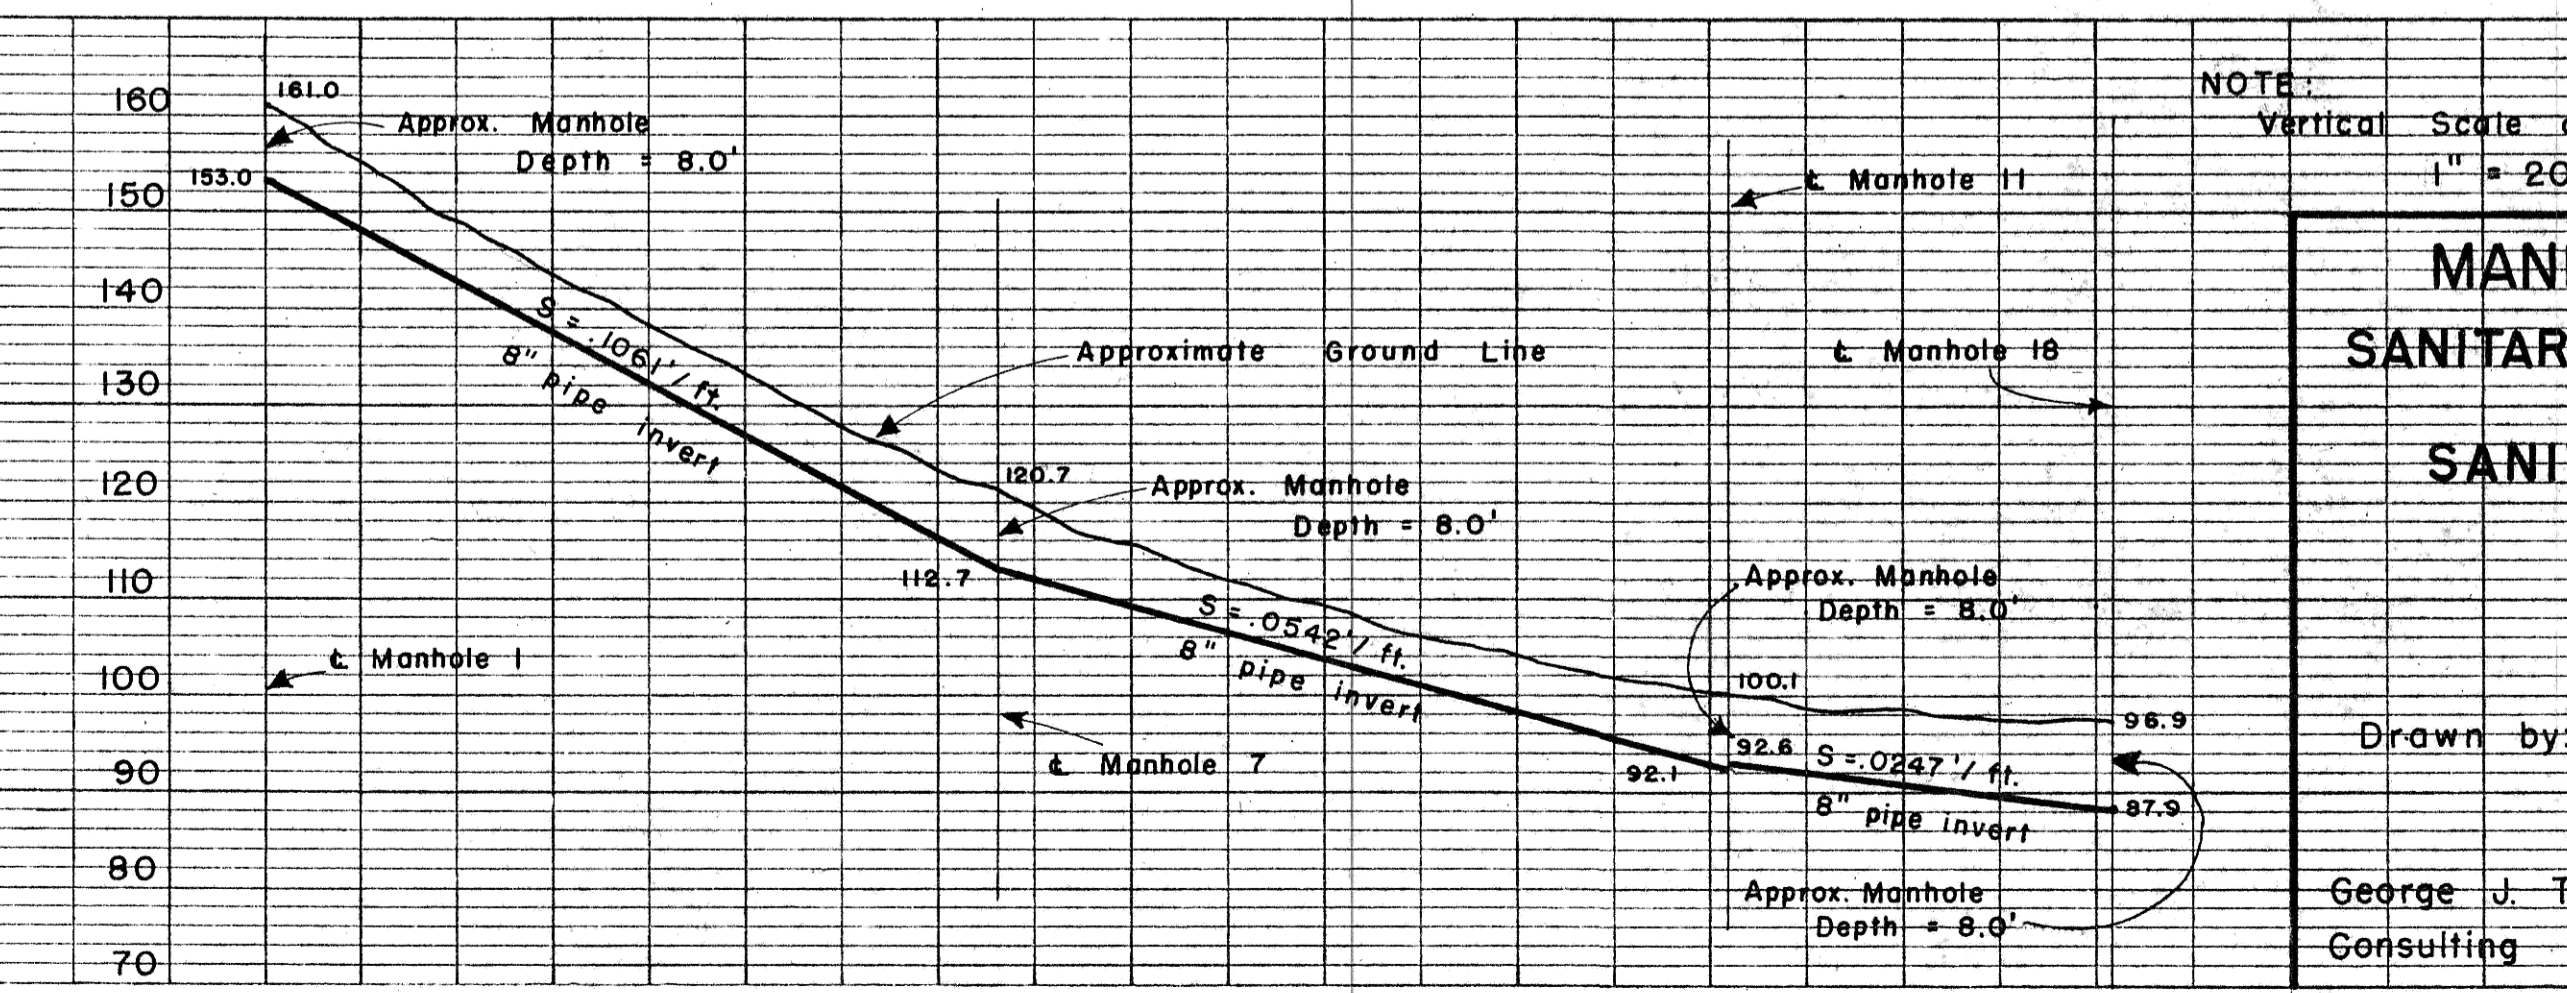

NOTE:
 Vertical Scale of Profile
 1" = 20'

MANDAN, NORTH DAKOTA
SANITARY SEWER DISTRICT NO. 8
SANITARY SEWER DETAILS

SCALE 1" = 100'

Drawn by: RVT
 Checked by: [Signature]

George J. Toman
 Consulting Engineer

SHEET NO. 3
 7-18-28

Mandan, N. Dak.