






PHASE III

REV.	DATE	DESCRIPTION	BY

MANDAN INTERCEPTOR 1987		
MANDAN, NORTH DAKOTA		
LOCATION MAP		
<small>ULTEIG ENGINEERS, INC. CONSULTING ENGINEERS • ARCHITECT FARGO • BISMARCK • MINNEAPOLIS</small>		
DRAWN BY: JRB	SCALE: AS SHOWN	PROJECT NO. 4242
CHECKED BY: RL	DATE: JANUARY 1987	SHEET G-2 of
APPROVED BY: BK		

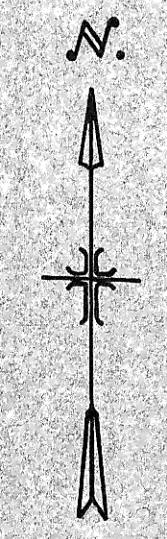

STREETS AND ALLEYS VACATED

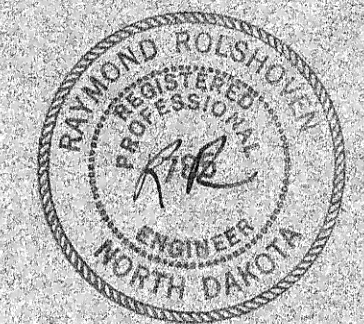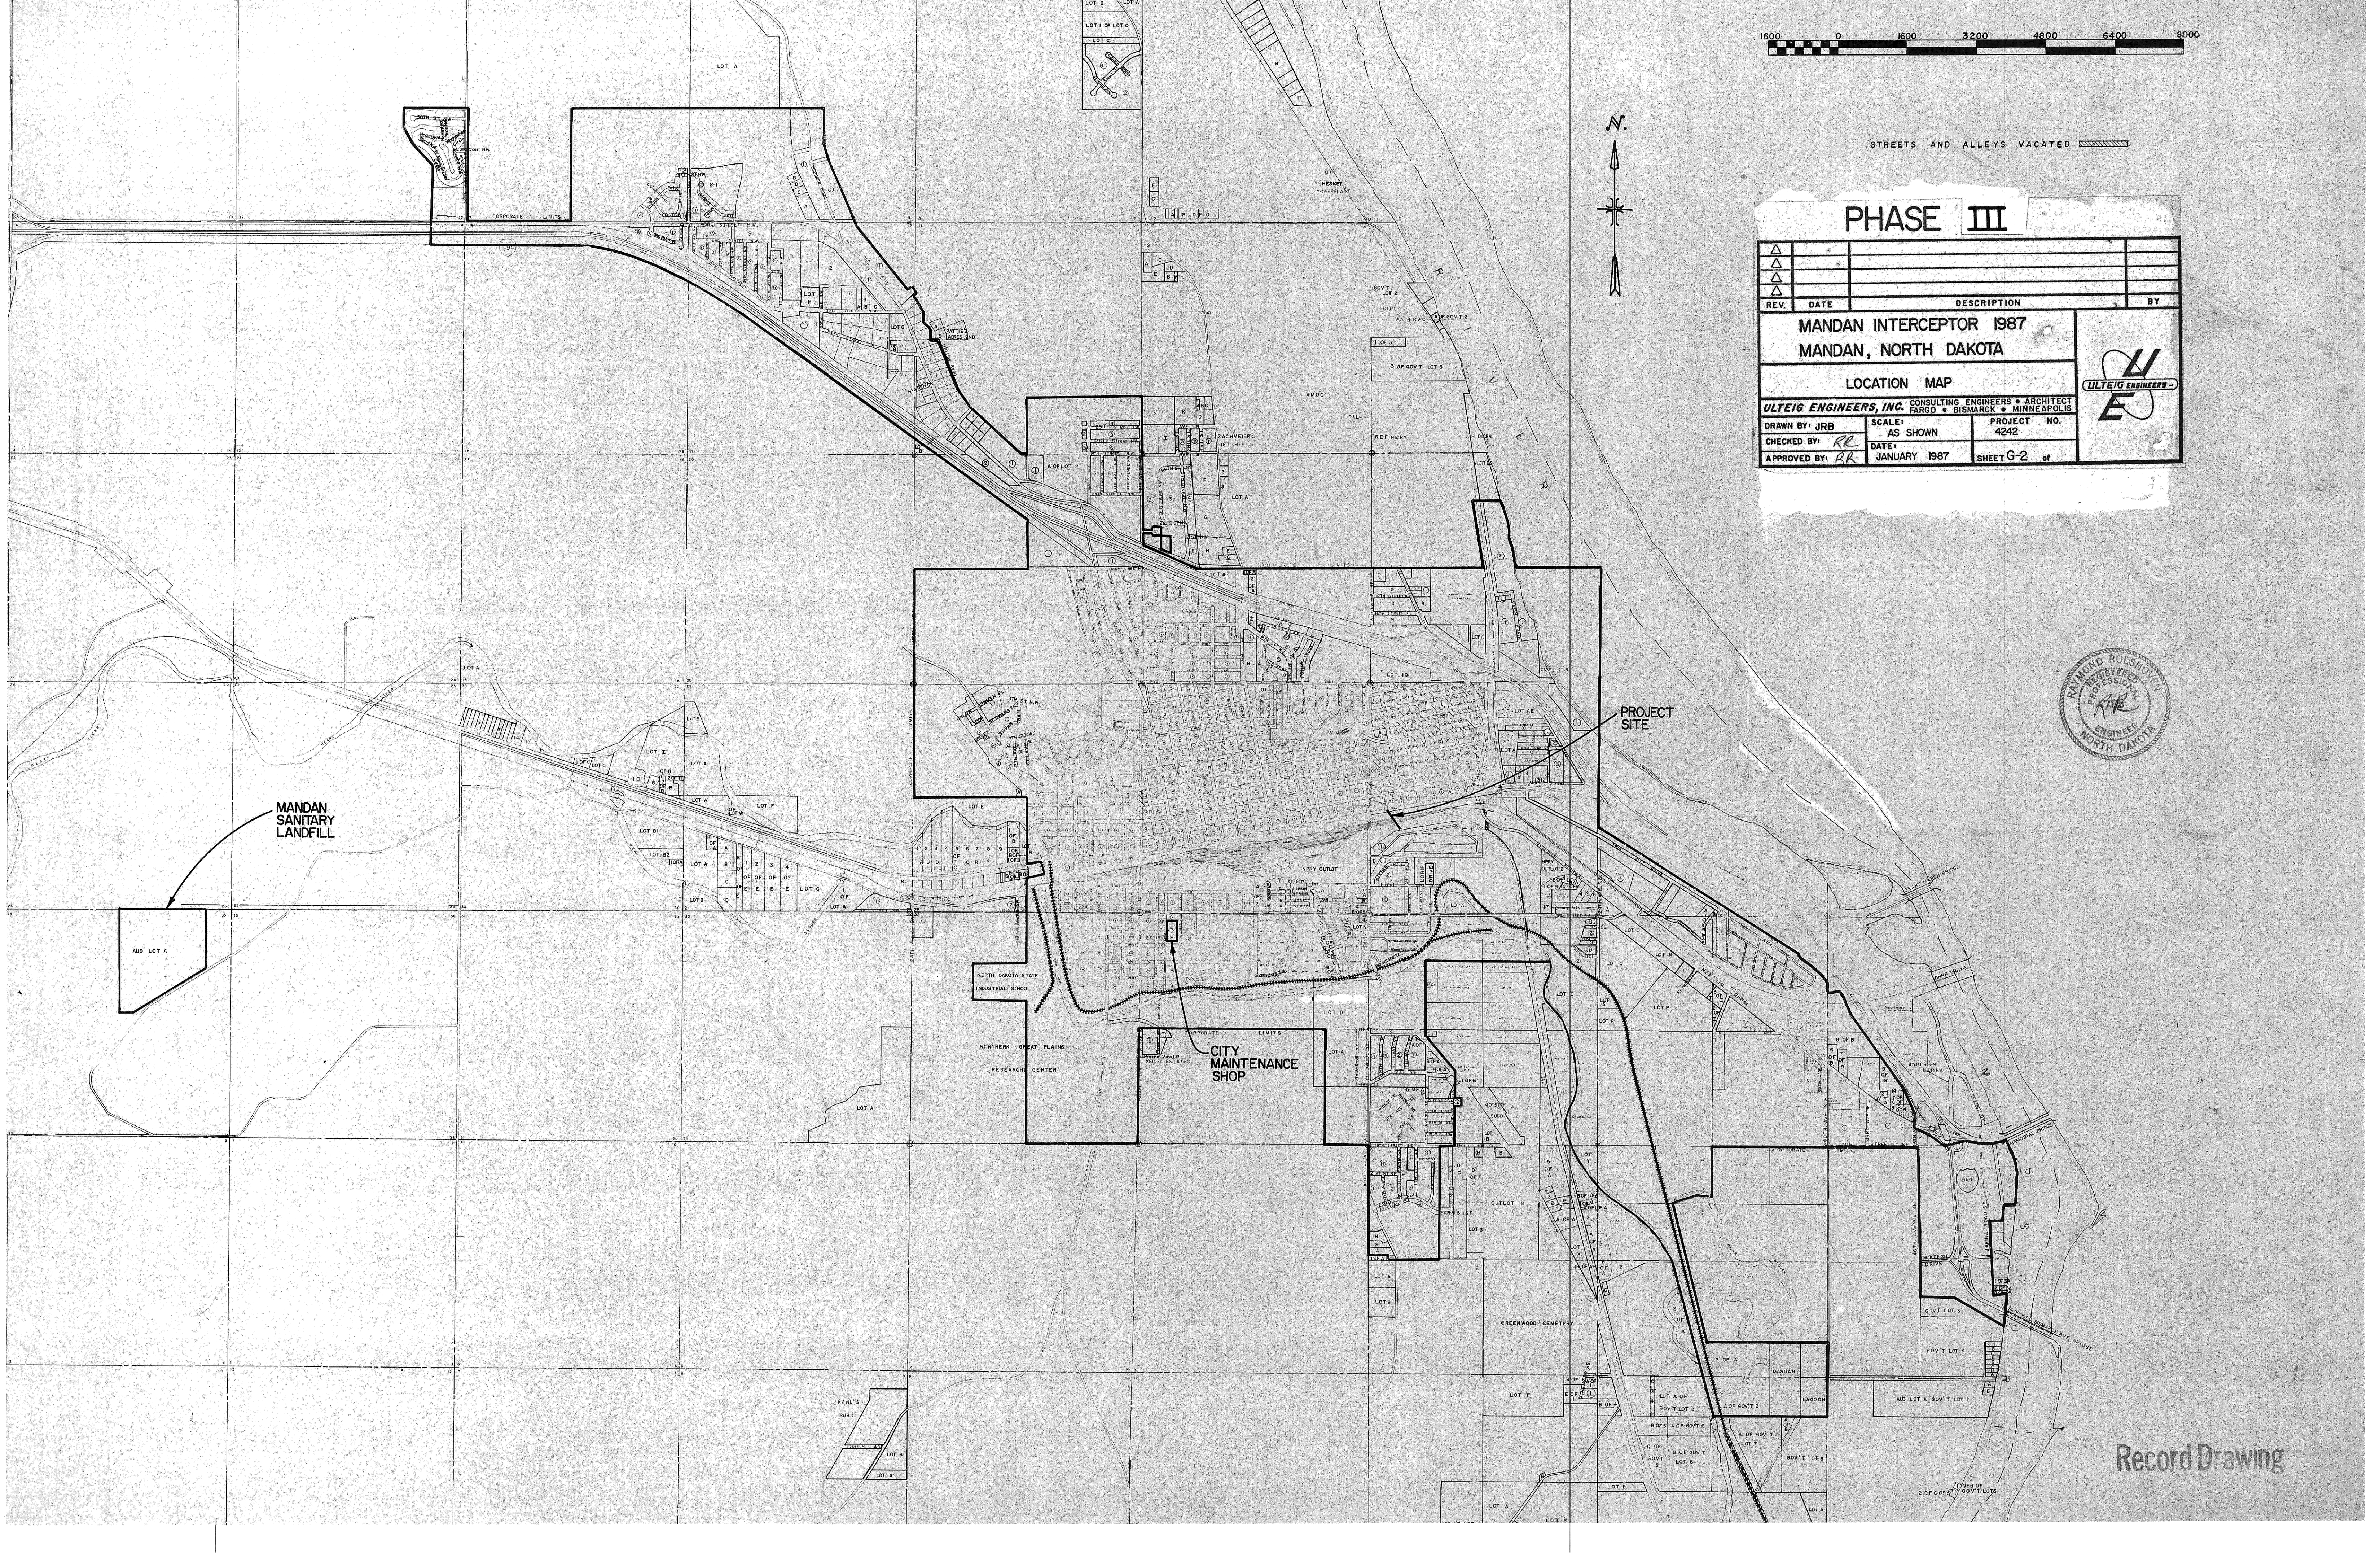

Record Drawing