

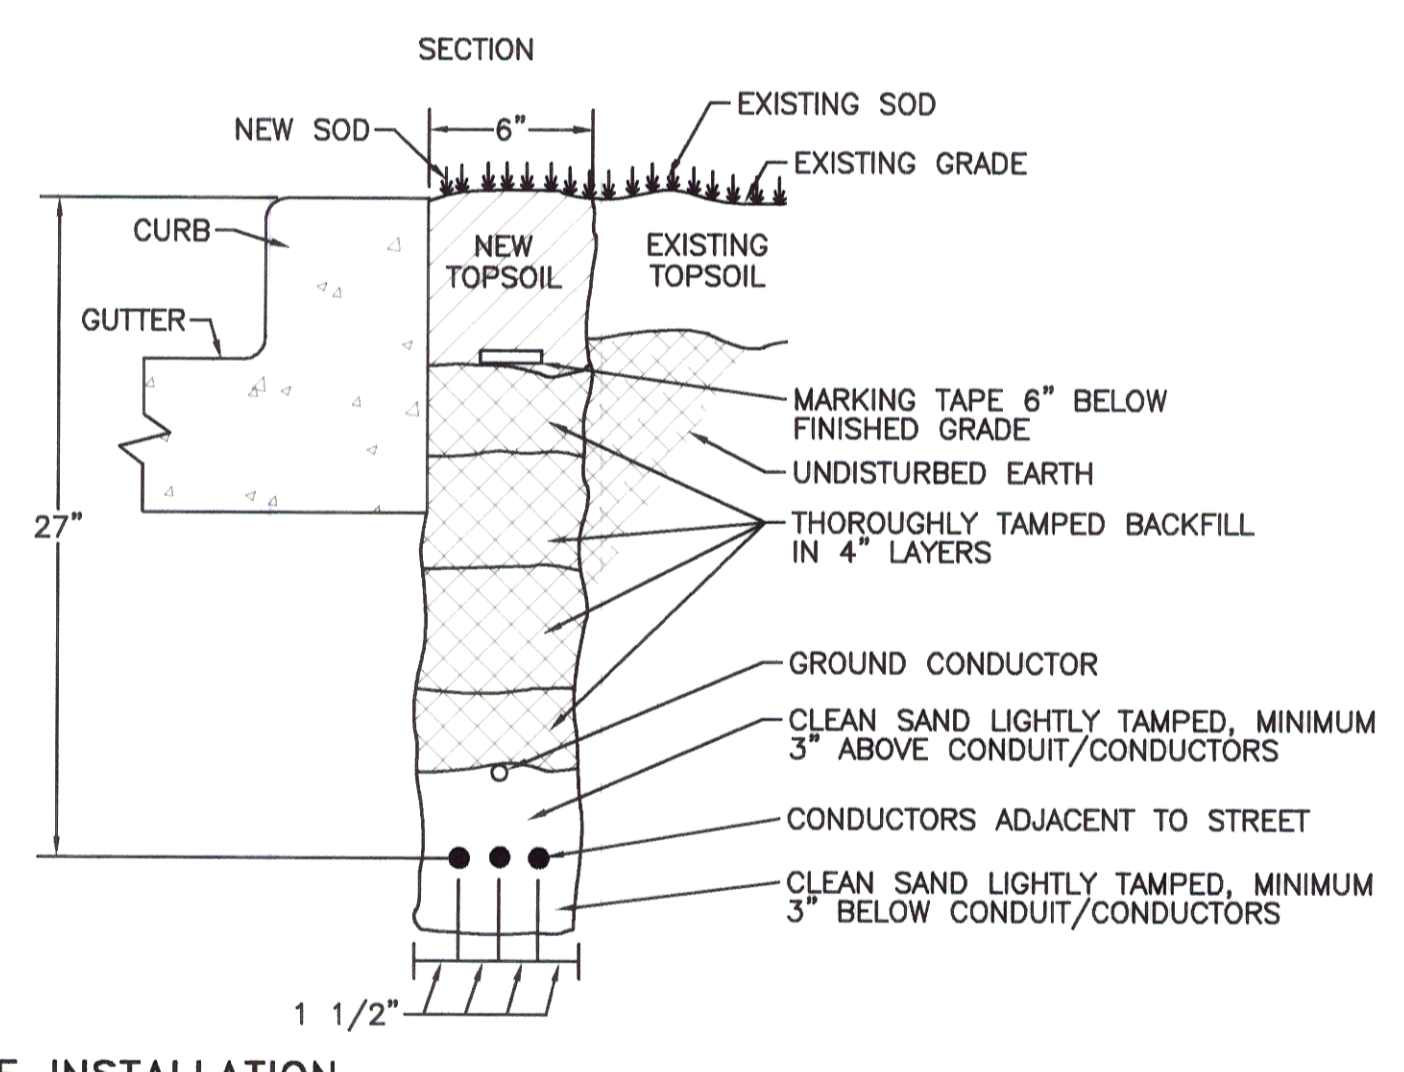
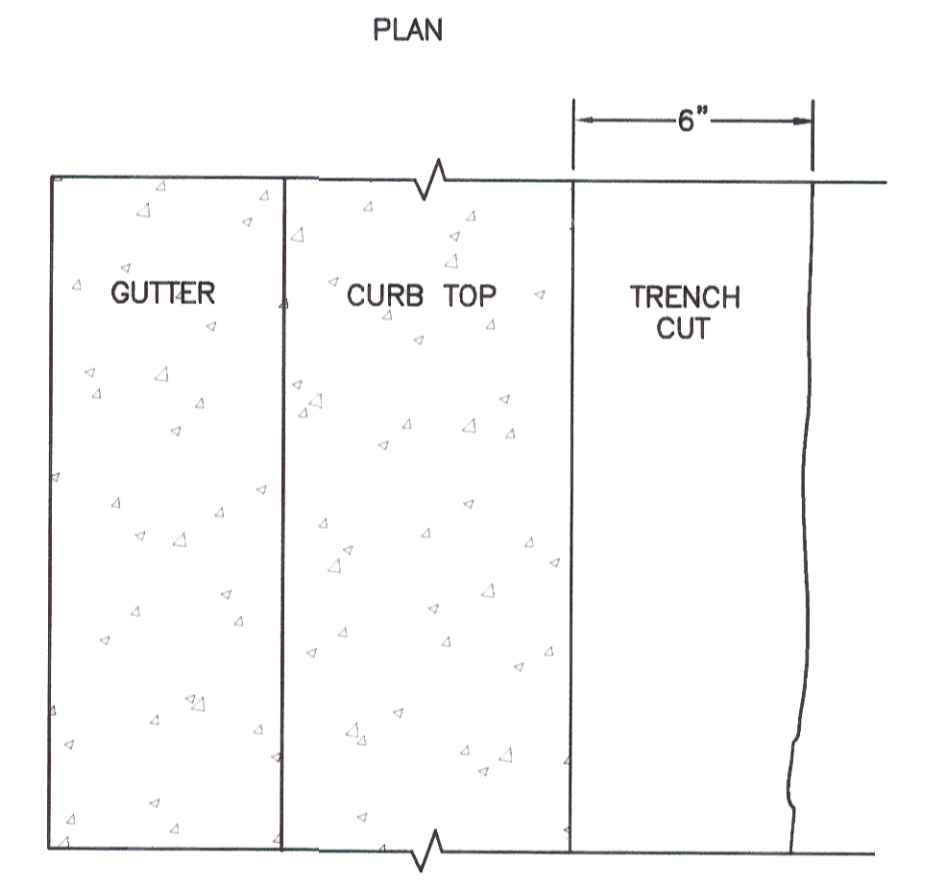
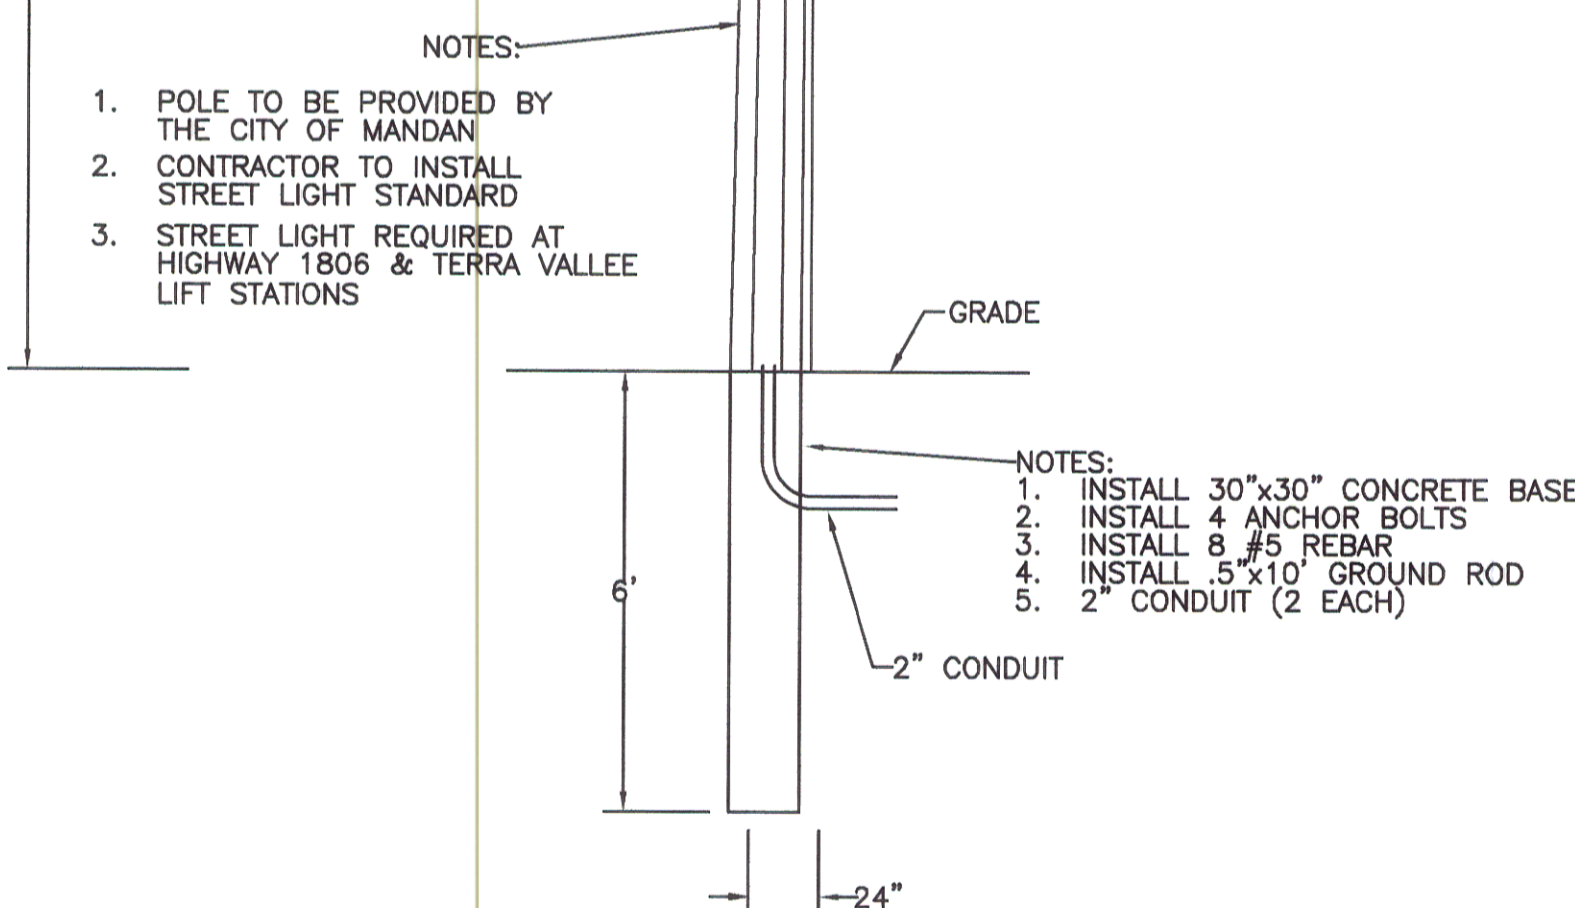
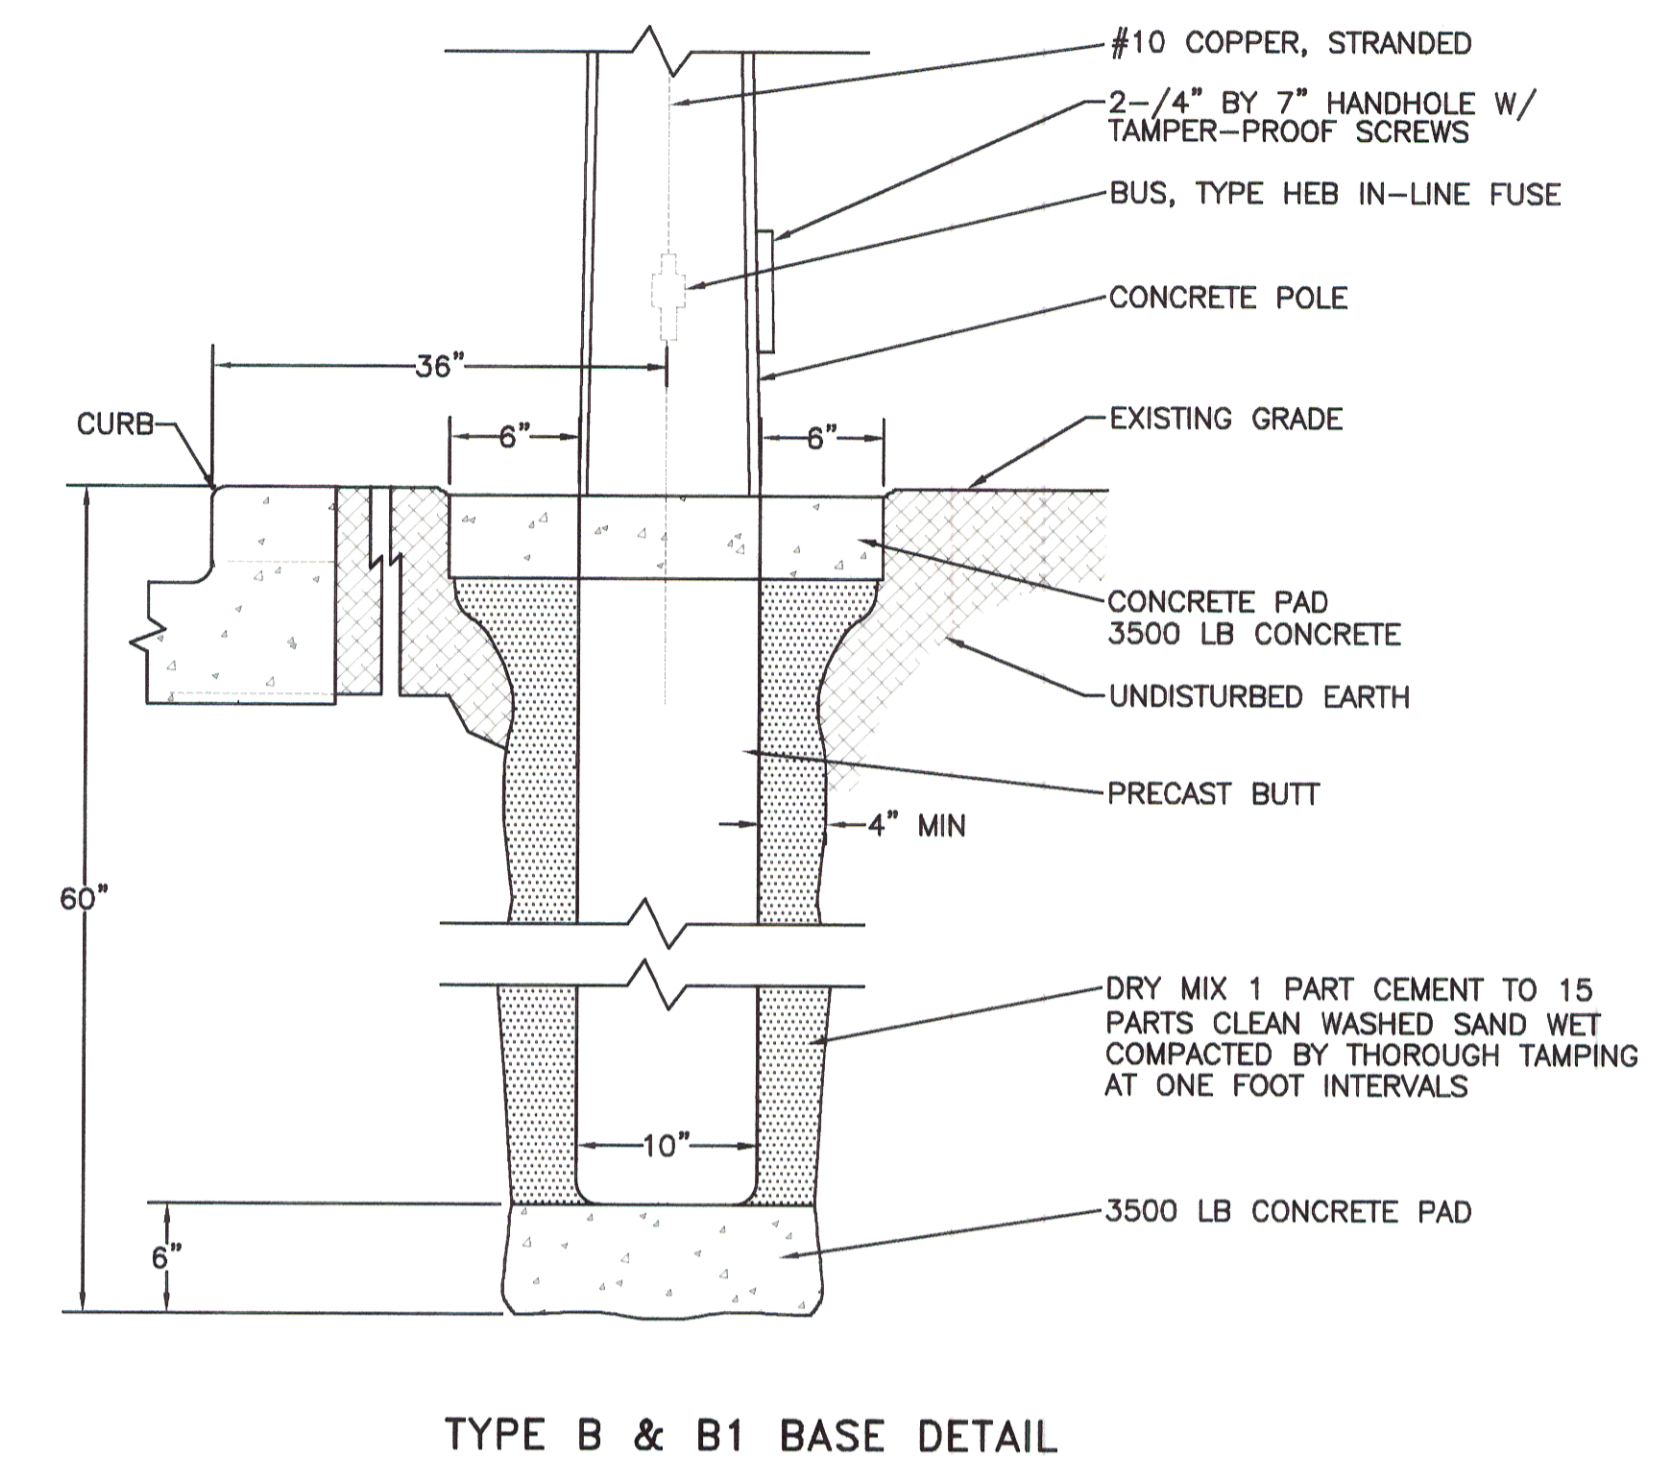
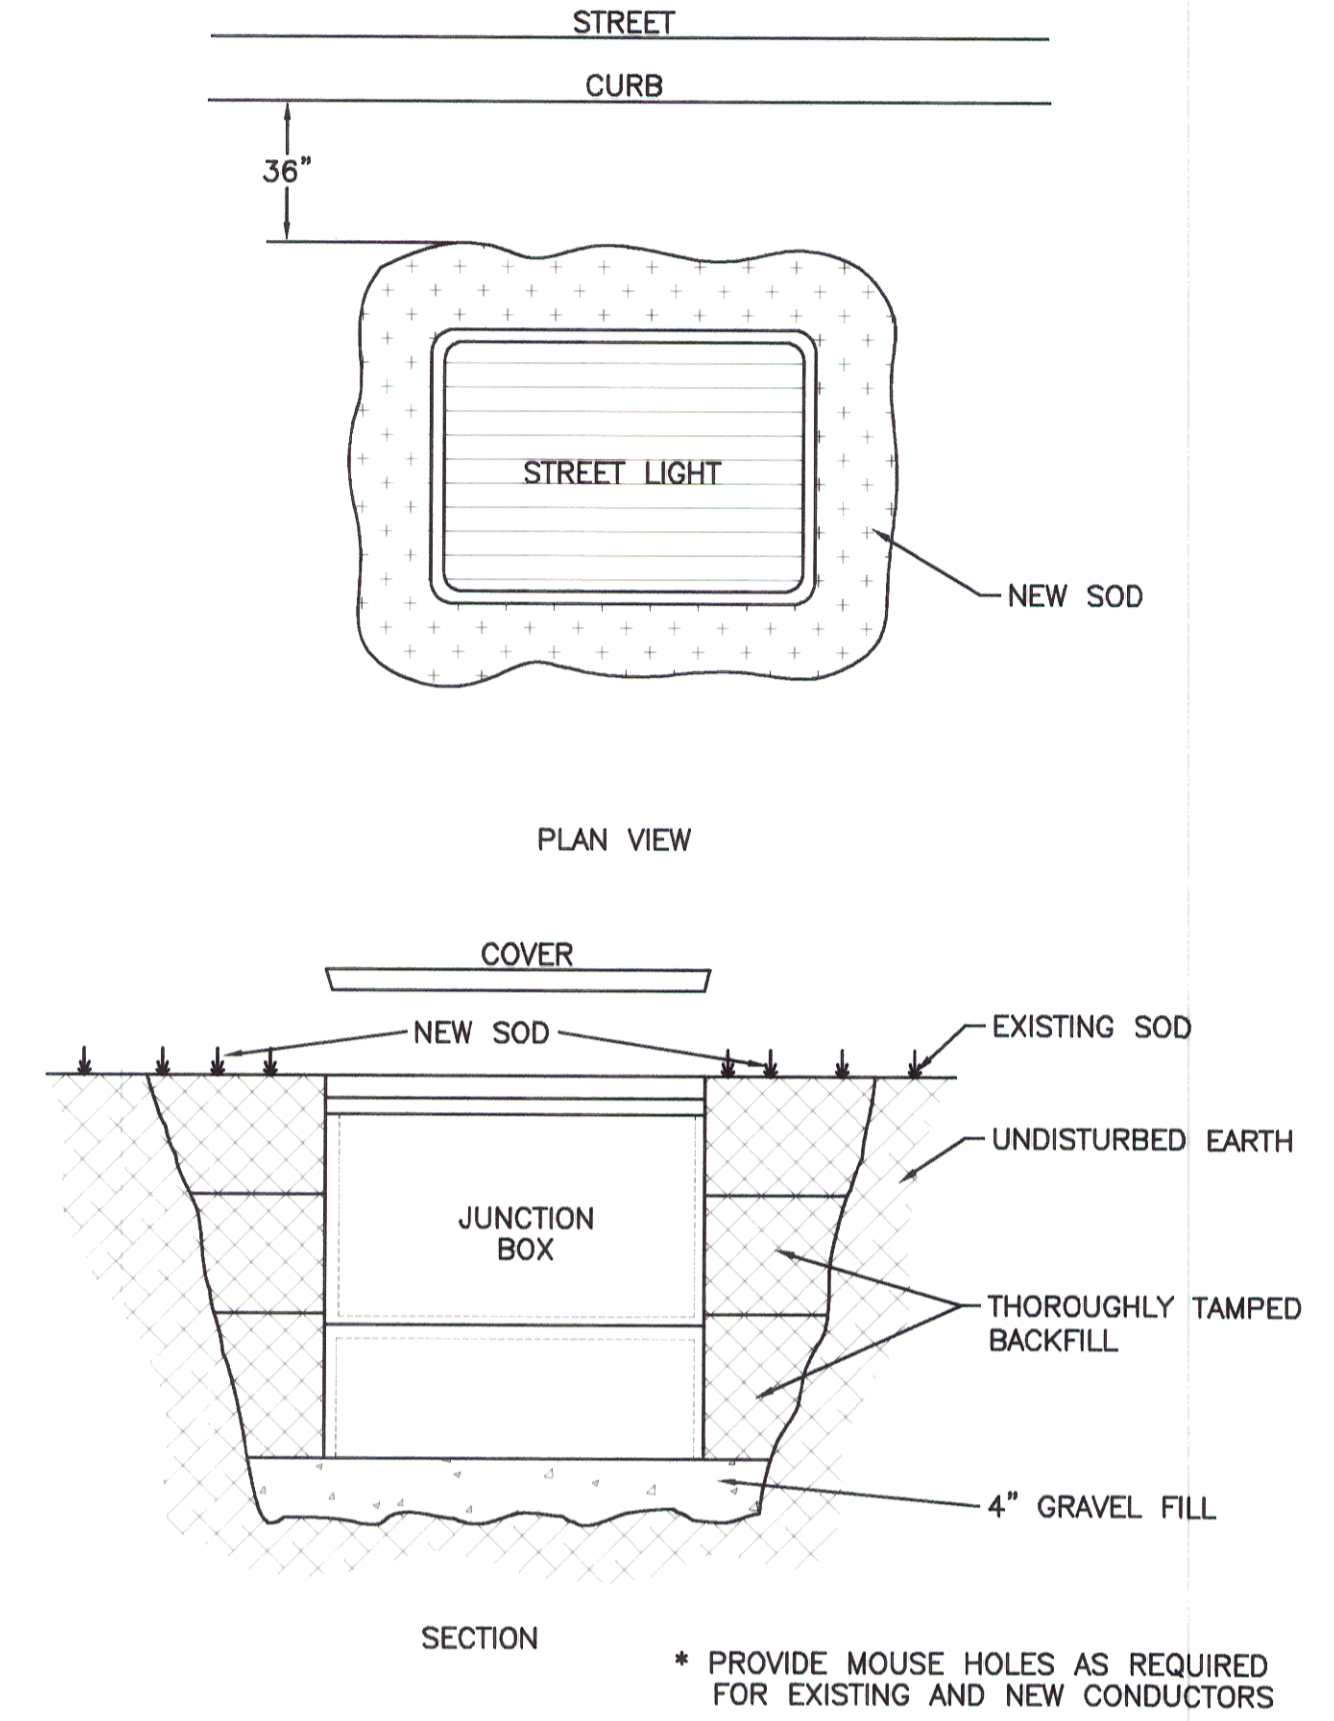
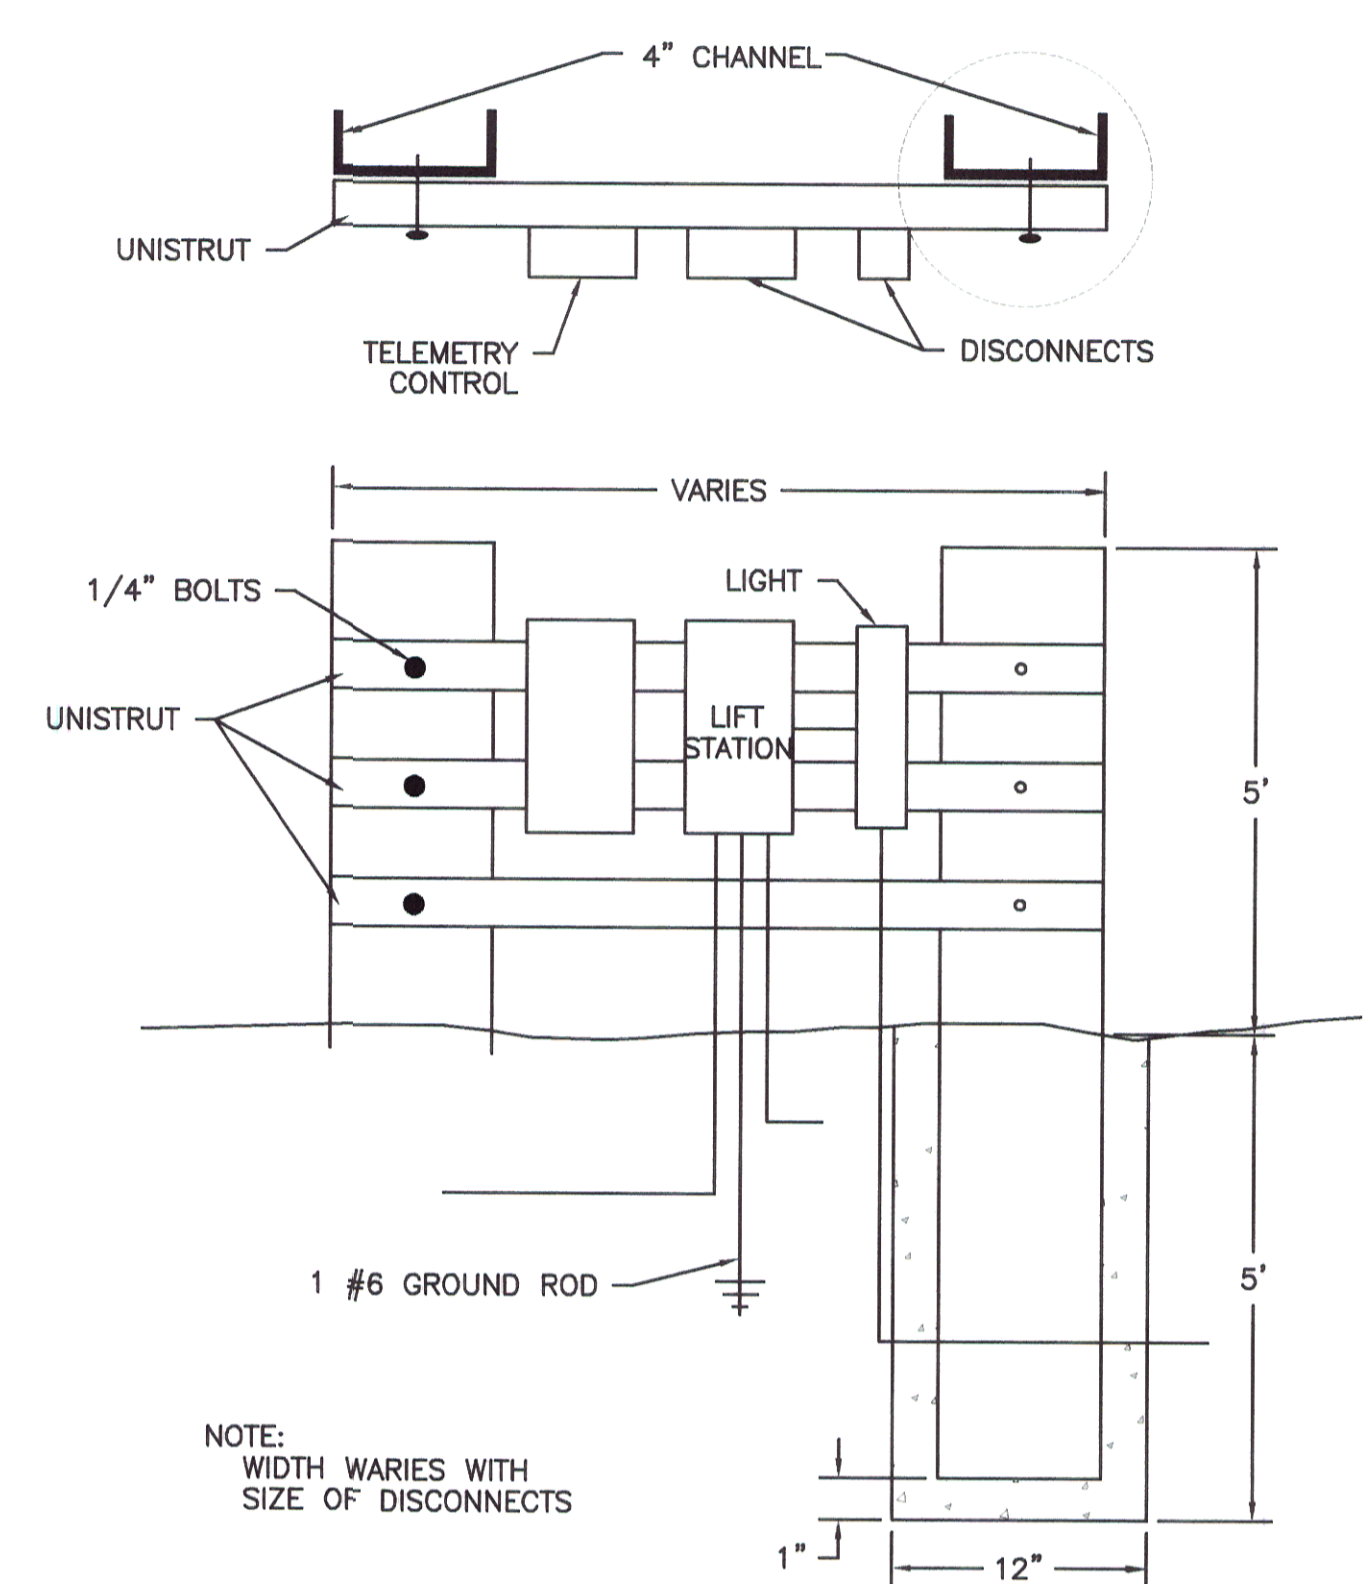


# DETAIL SHEET


## NO SCALE

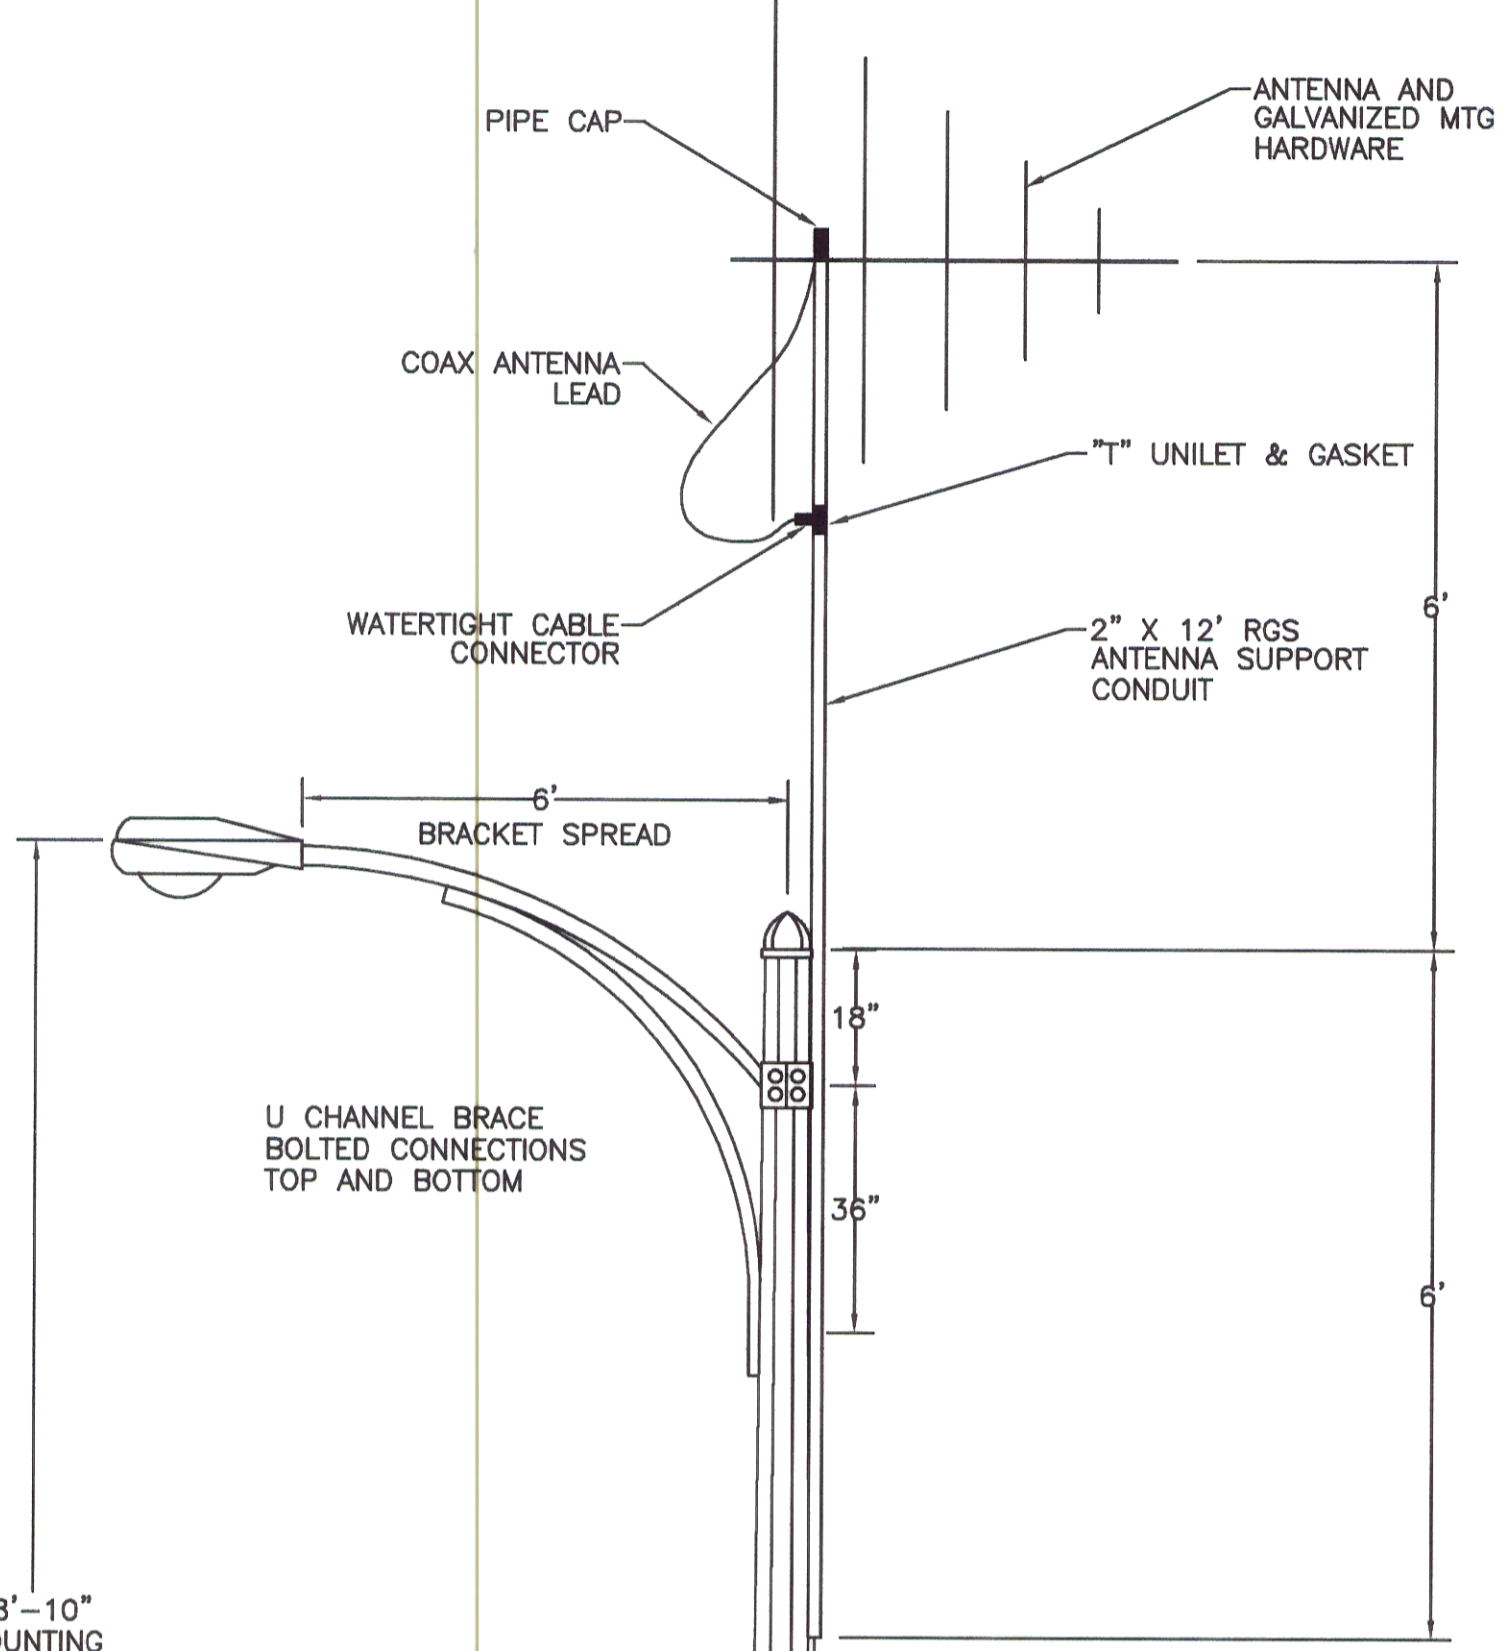


UNDERGROUND CABLE INSTALLATION

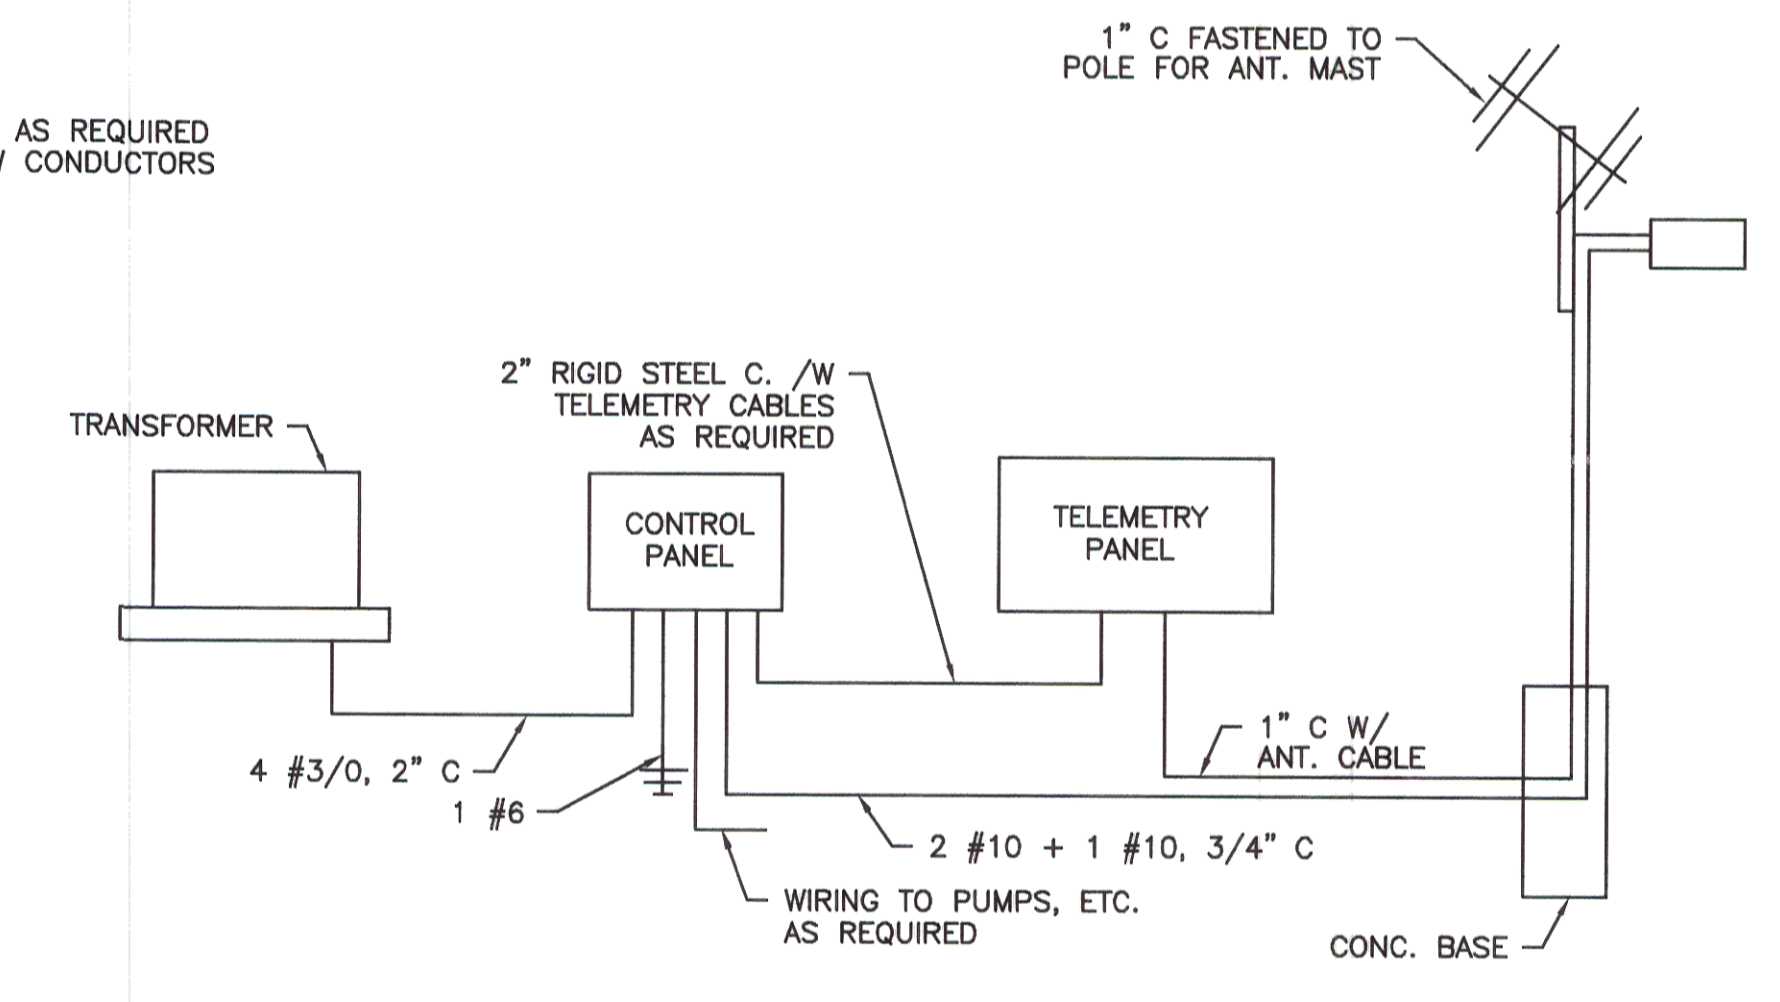

RISER DIAGRAM HIGHWAY 1806

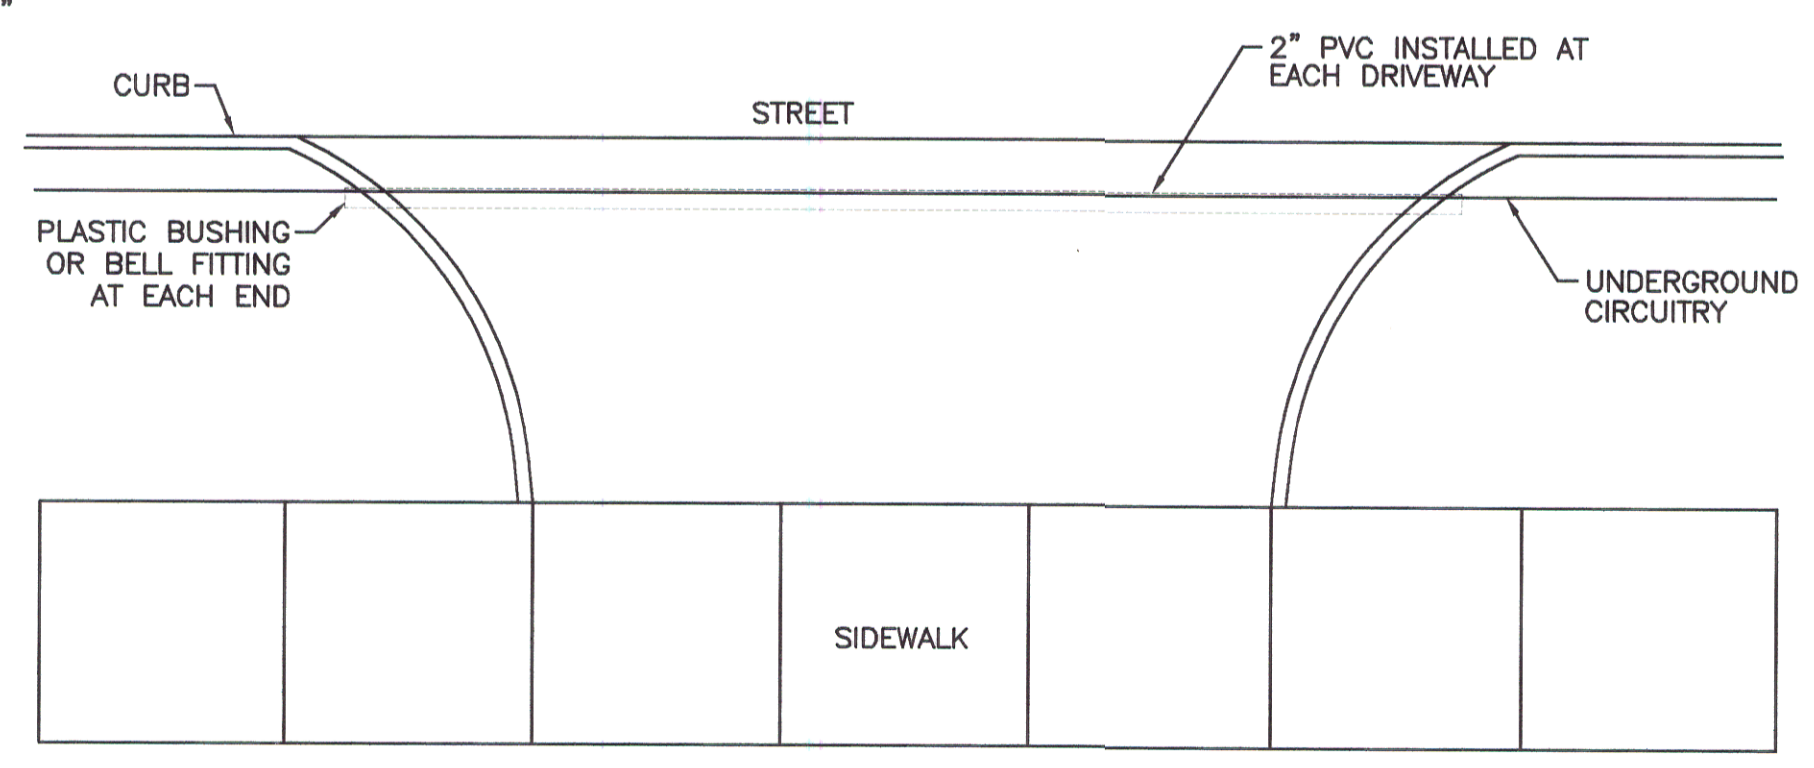


DRIVEWAY DETAIL

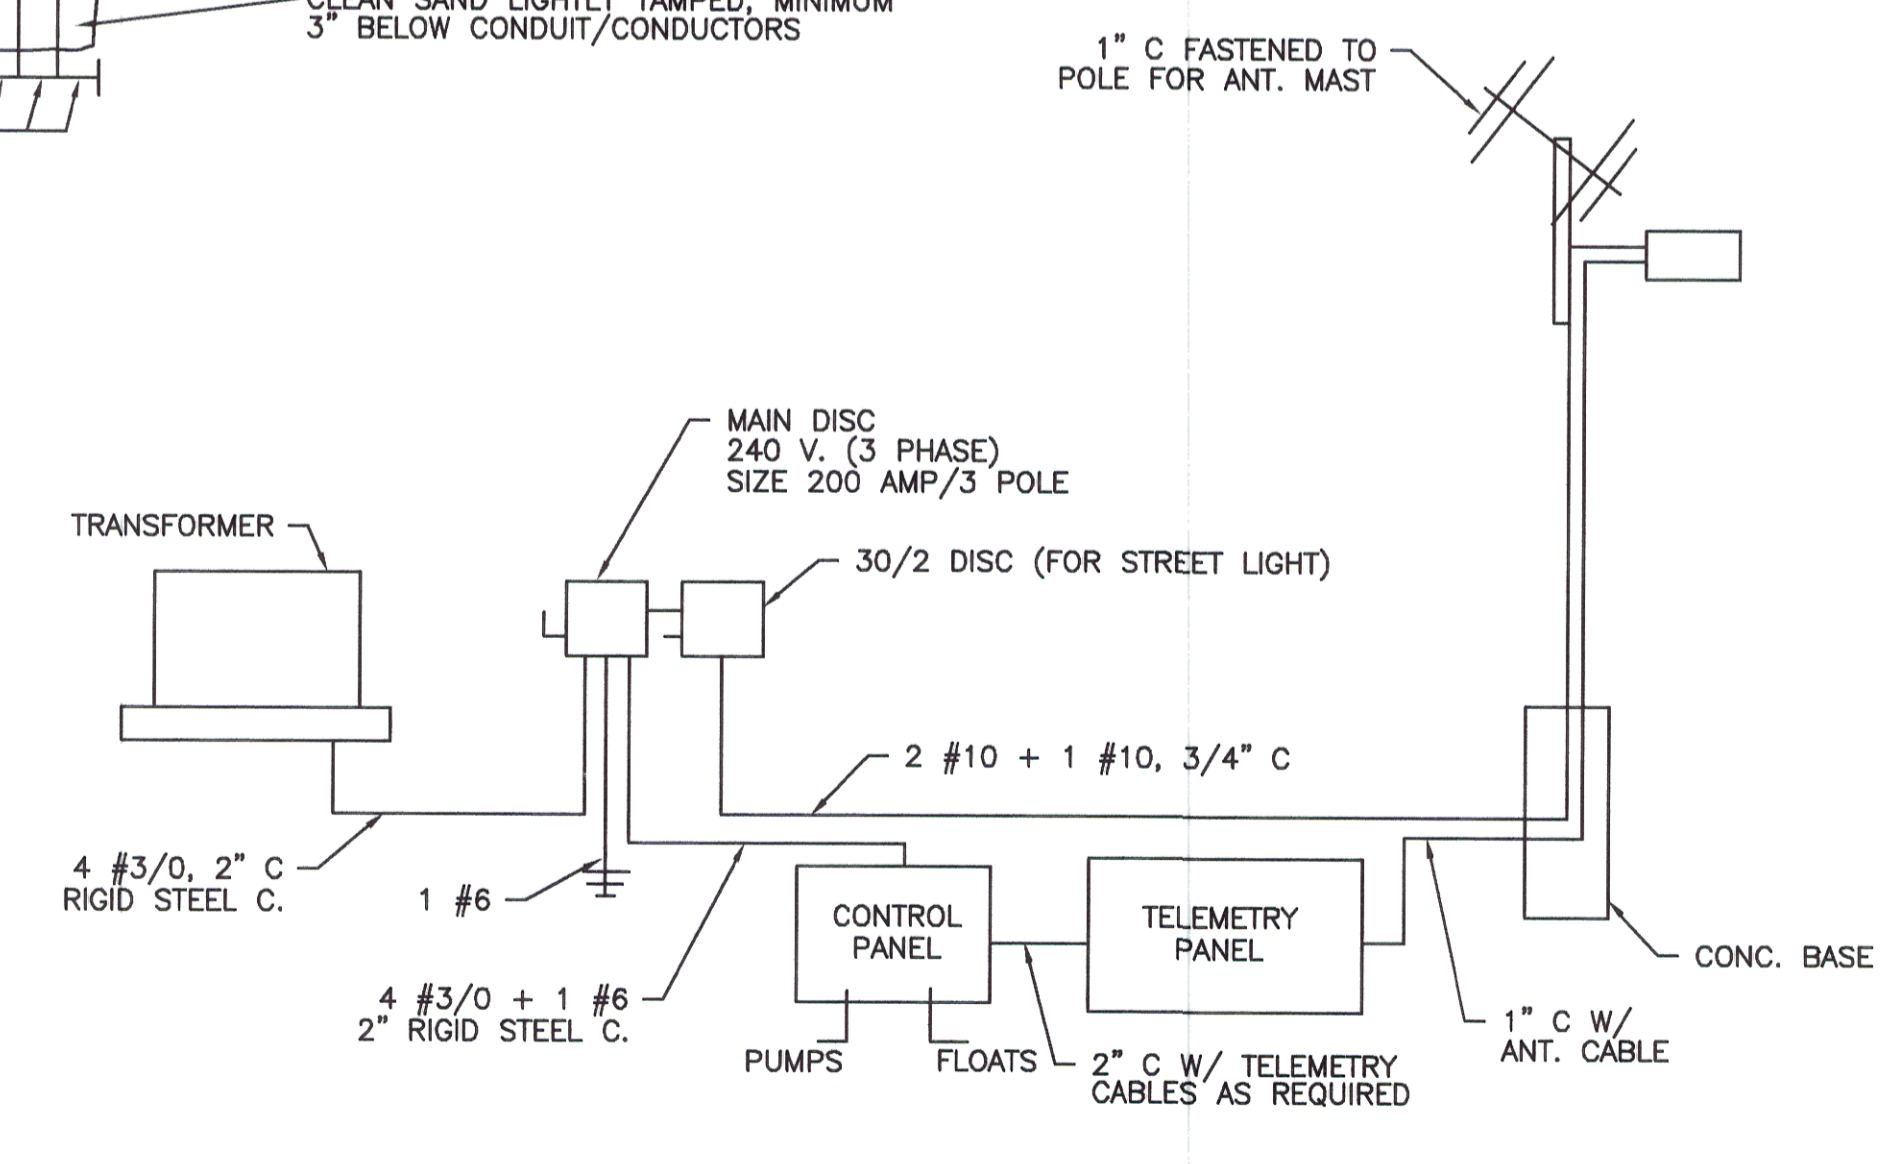

RISER DIAGRAM TERRA VALLEE

**CAUTION**  
LOCATE ALL BURIED UTILITIES BEFORE DIGGING  
OVERHEAD POWER

- NOTE:  
1. ALL CONSTRUCTION SIGNING INCIDENTAL TO PROJECT.  
2. ALL EXCESS EXCAVATION MATERIAL TO BE HAULED TO THE WASTE AREA AND GRADED.

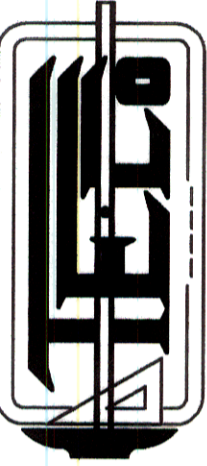

NO.	DATE	BY	REVISIONS
1	2/29	AR	AS-BUILTS