




TERRA VALLEE LIFT STATION

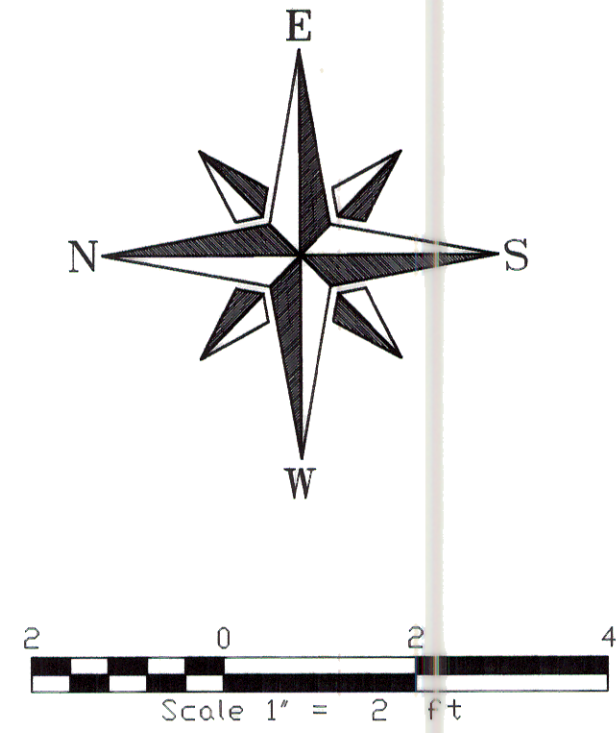

PROFILE

PLAN

CAUTION
LOCATE ALL BURIED
UTILITIES BEFORE DIGGING
OVERHEAD POWER

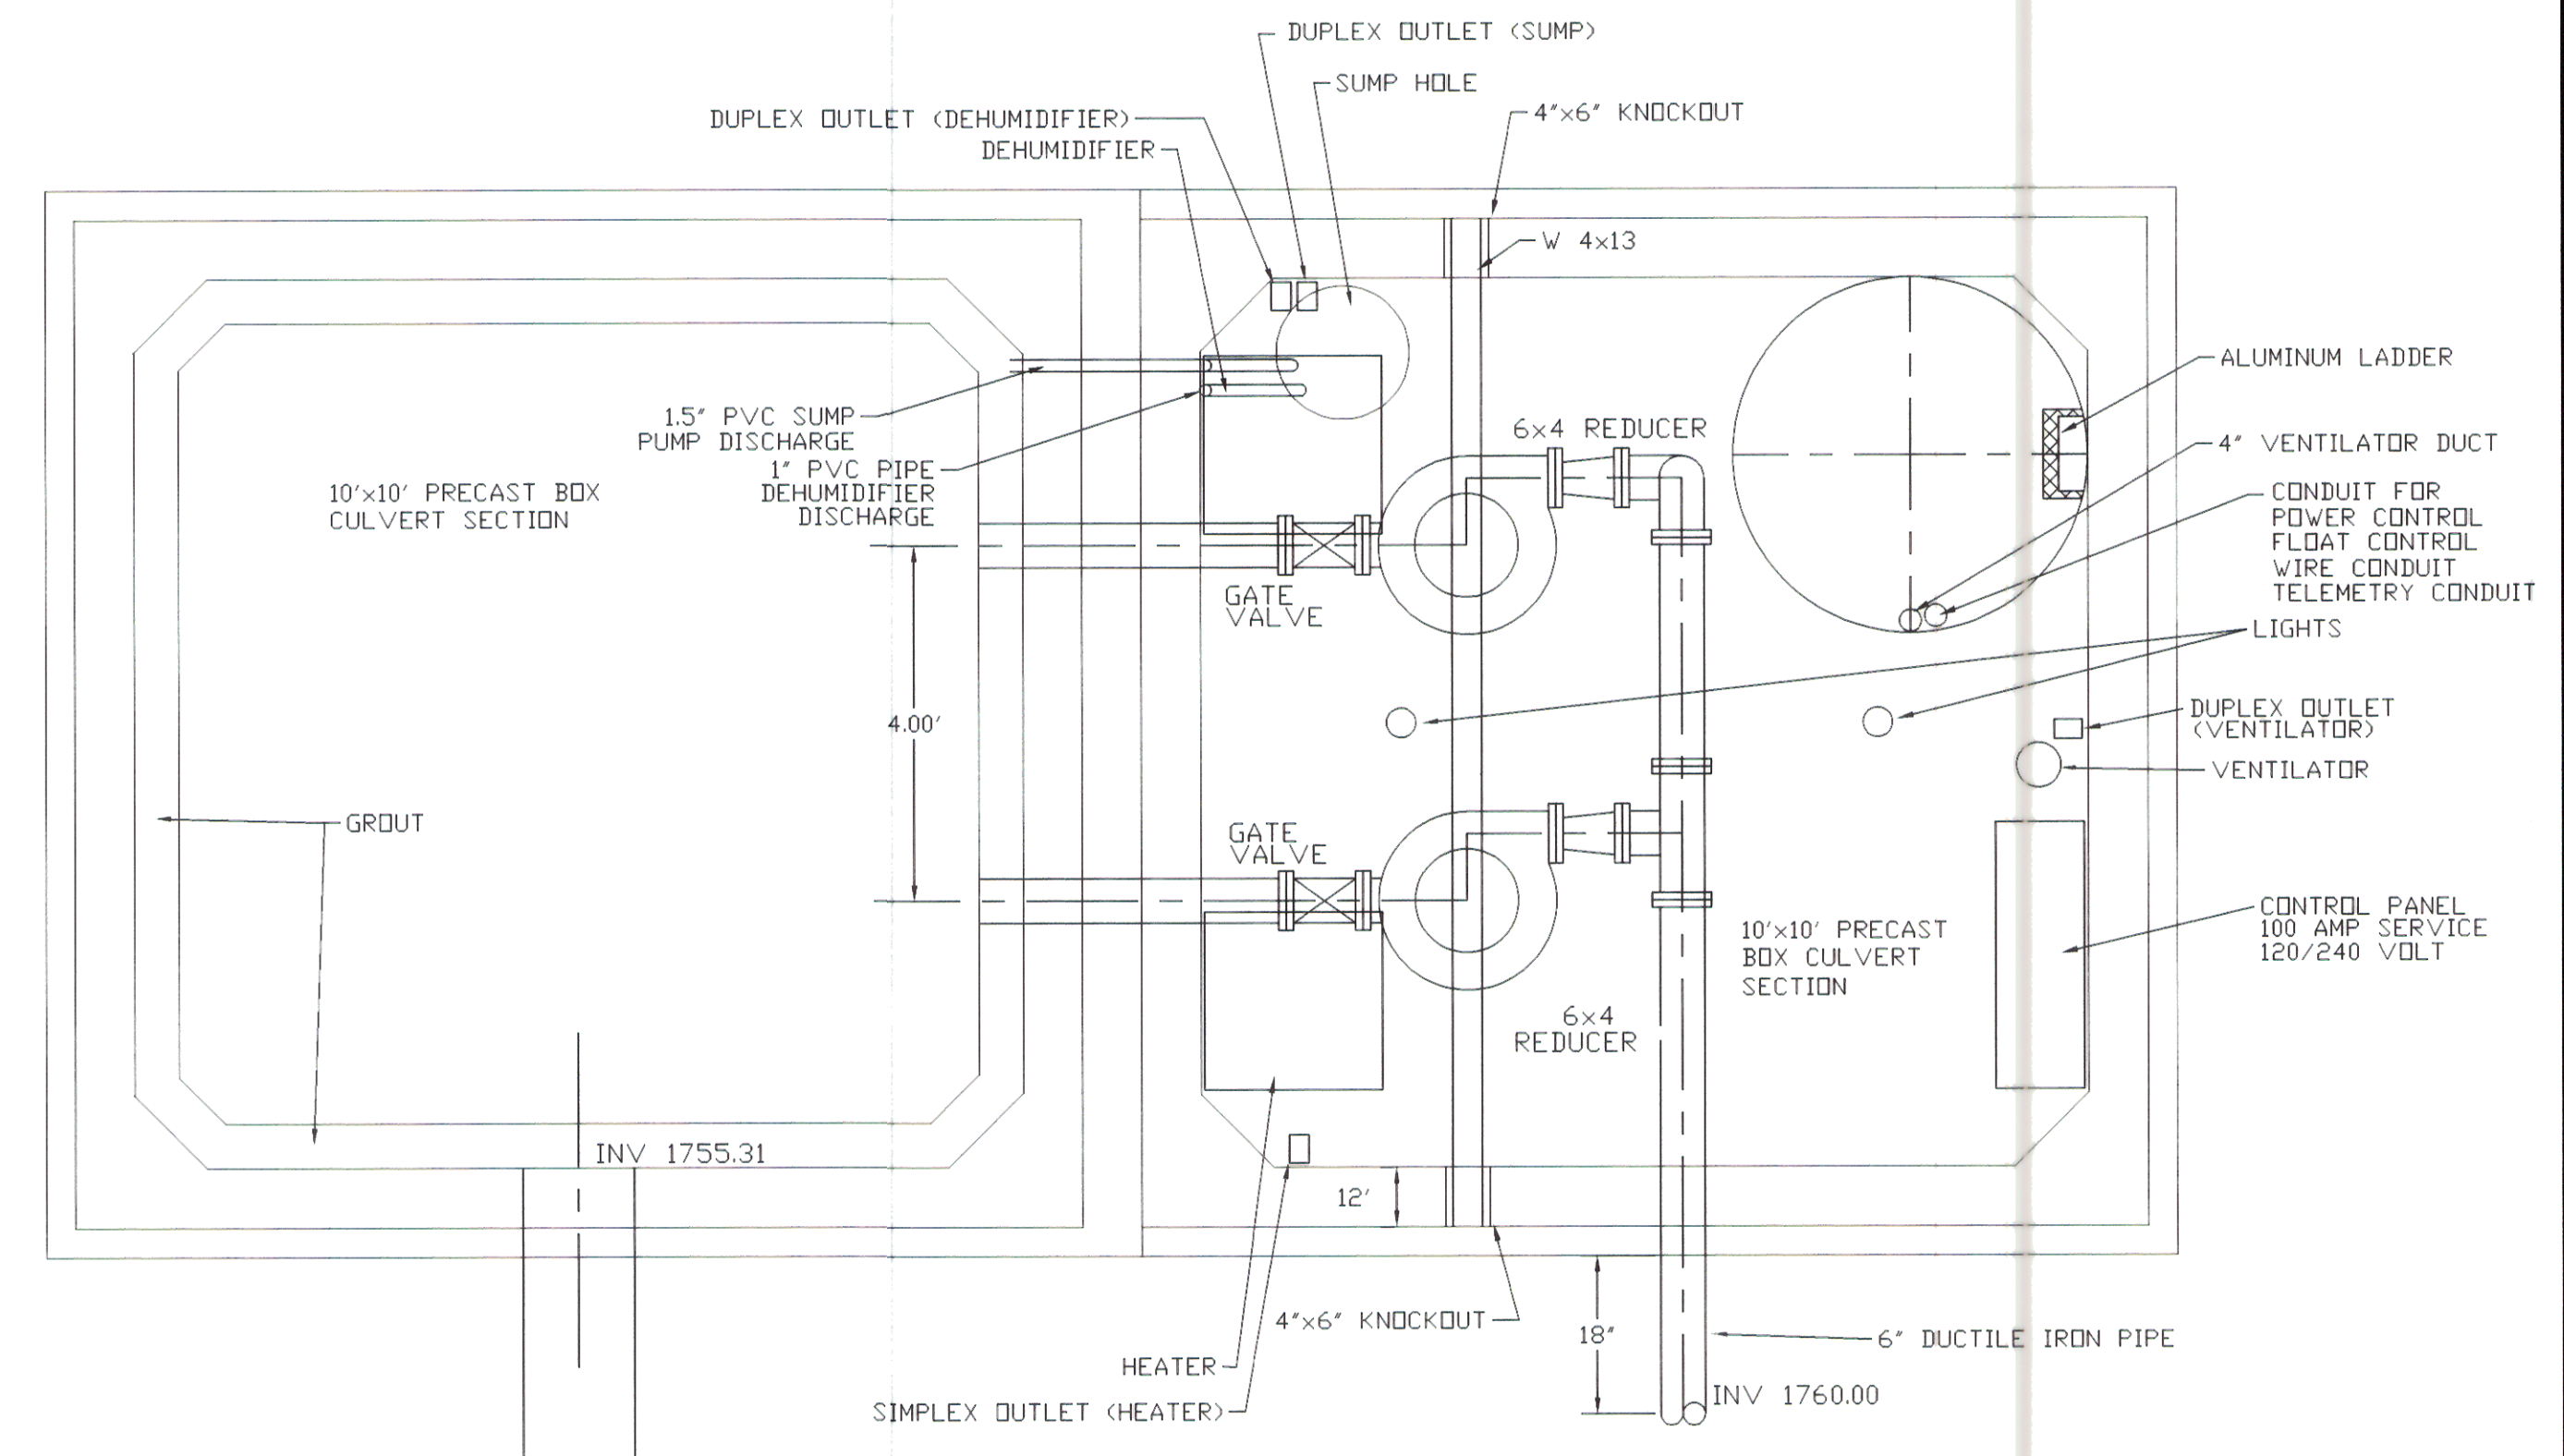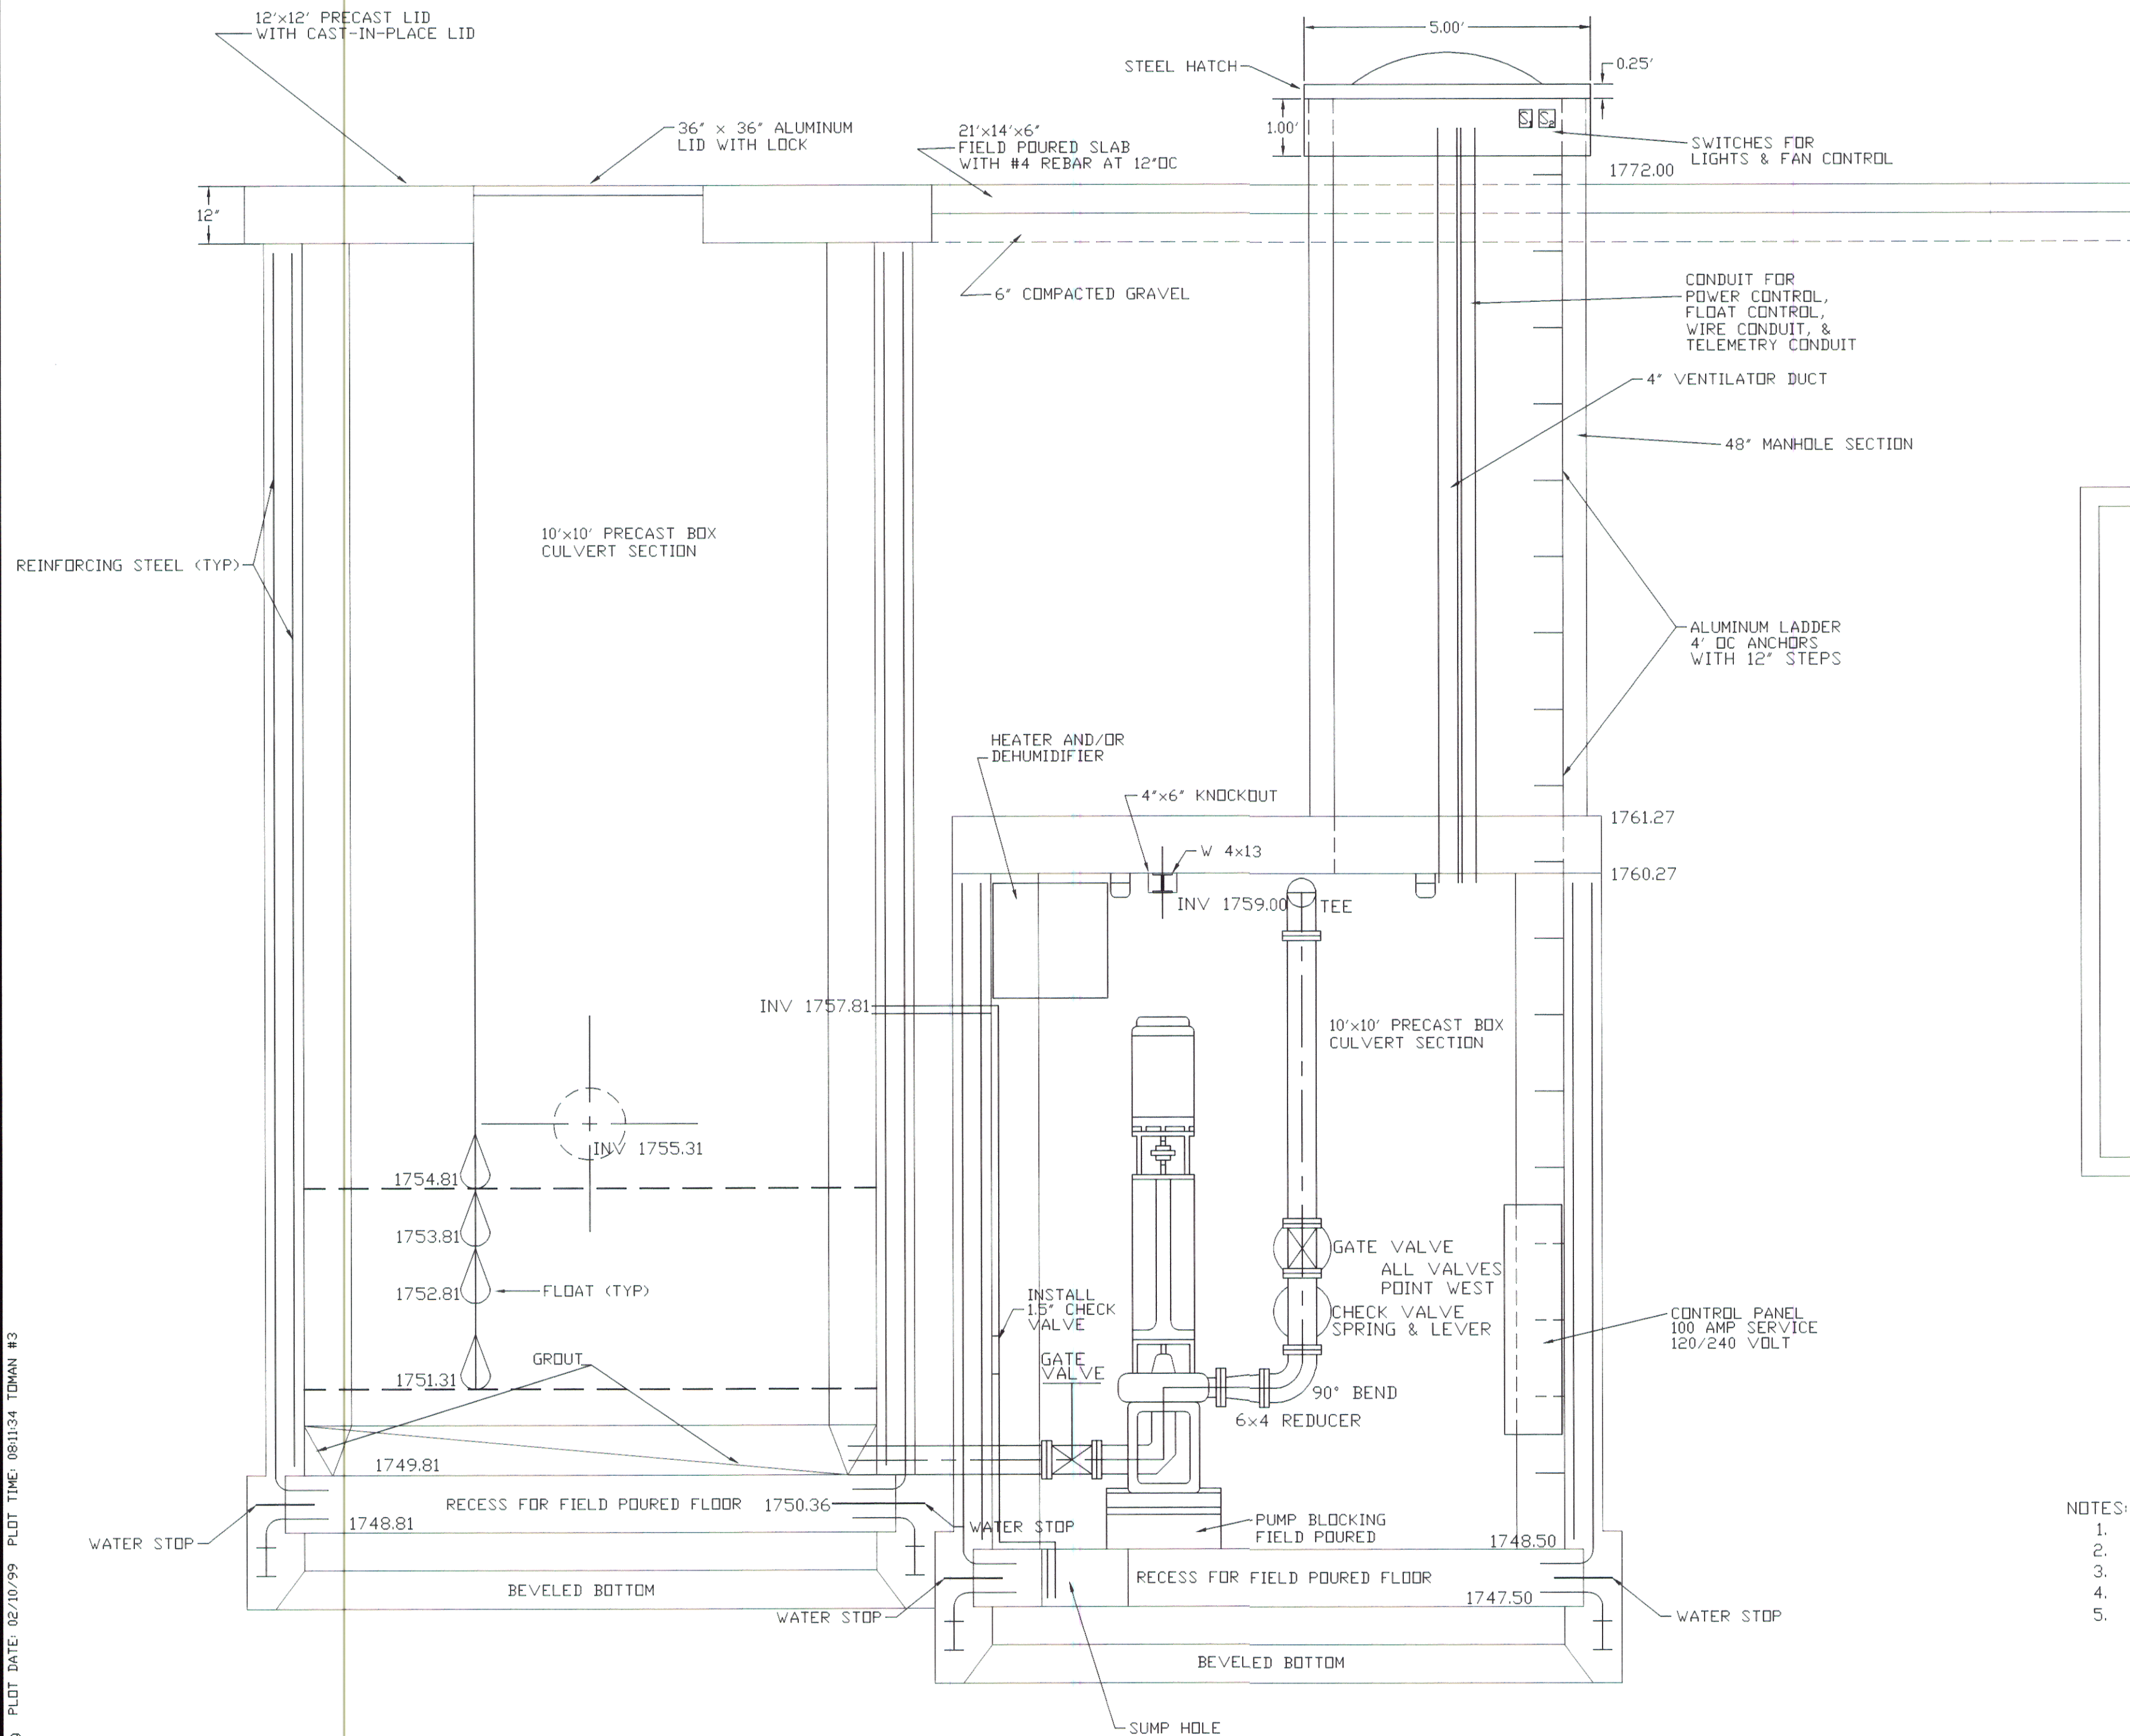

- NOTES:
1. FAN SWITCH TO BE SPRING TYPE FOR AUTOMATIC START UPON HATCH OPENING
 2. ALL INTERIOR 6" PIPING SHALL BE DUCTILE IRON
 3. PROVIDE SEPARATE CIRCUITS FOR EACH PIECE OF EQUIPMENT
 4. ALL EQUIPMENT TO PLUG INTO OUTLETS
 5. SALVAGE EXISTING WET WELL & EQUIPMENT (SEE SHOP DRAWINGS)



TOMAN ENGINEERING COMPANY
 CONSULTING CIVIL & ENVIRONMENTAL ENGINEERS
 900 2ND ST. N.W. • MADISON, NORTH DAKOTA 58504 • 701-463-4483

PROJECT: SANITARY LIFT STATION
 DISTRICT NO. 40 - AREA "C"
 CITY PROJECT NO. 96-9

NO.	DATE	BY	REVISIONS
1	2/79	AR	AS-BUILT

TITLE: TERRA VALLEE LIFT STATION
SHEET NUMBER: 8
 OF 11 SHEETS

DWGNAME: 231s.dwg PLOT DATE: 02/10/99 PLOT TIME: 08:11:34 TDMAN #3