

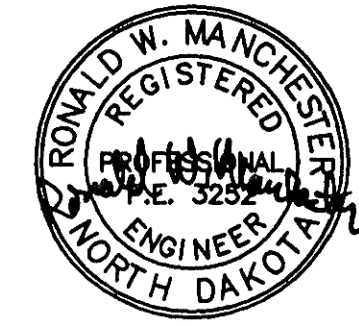
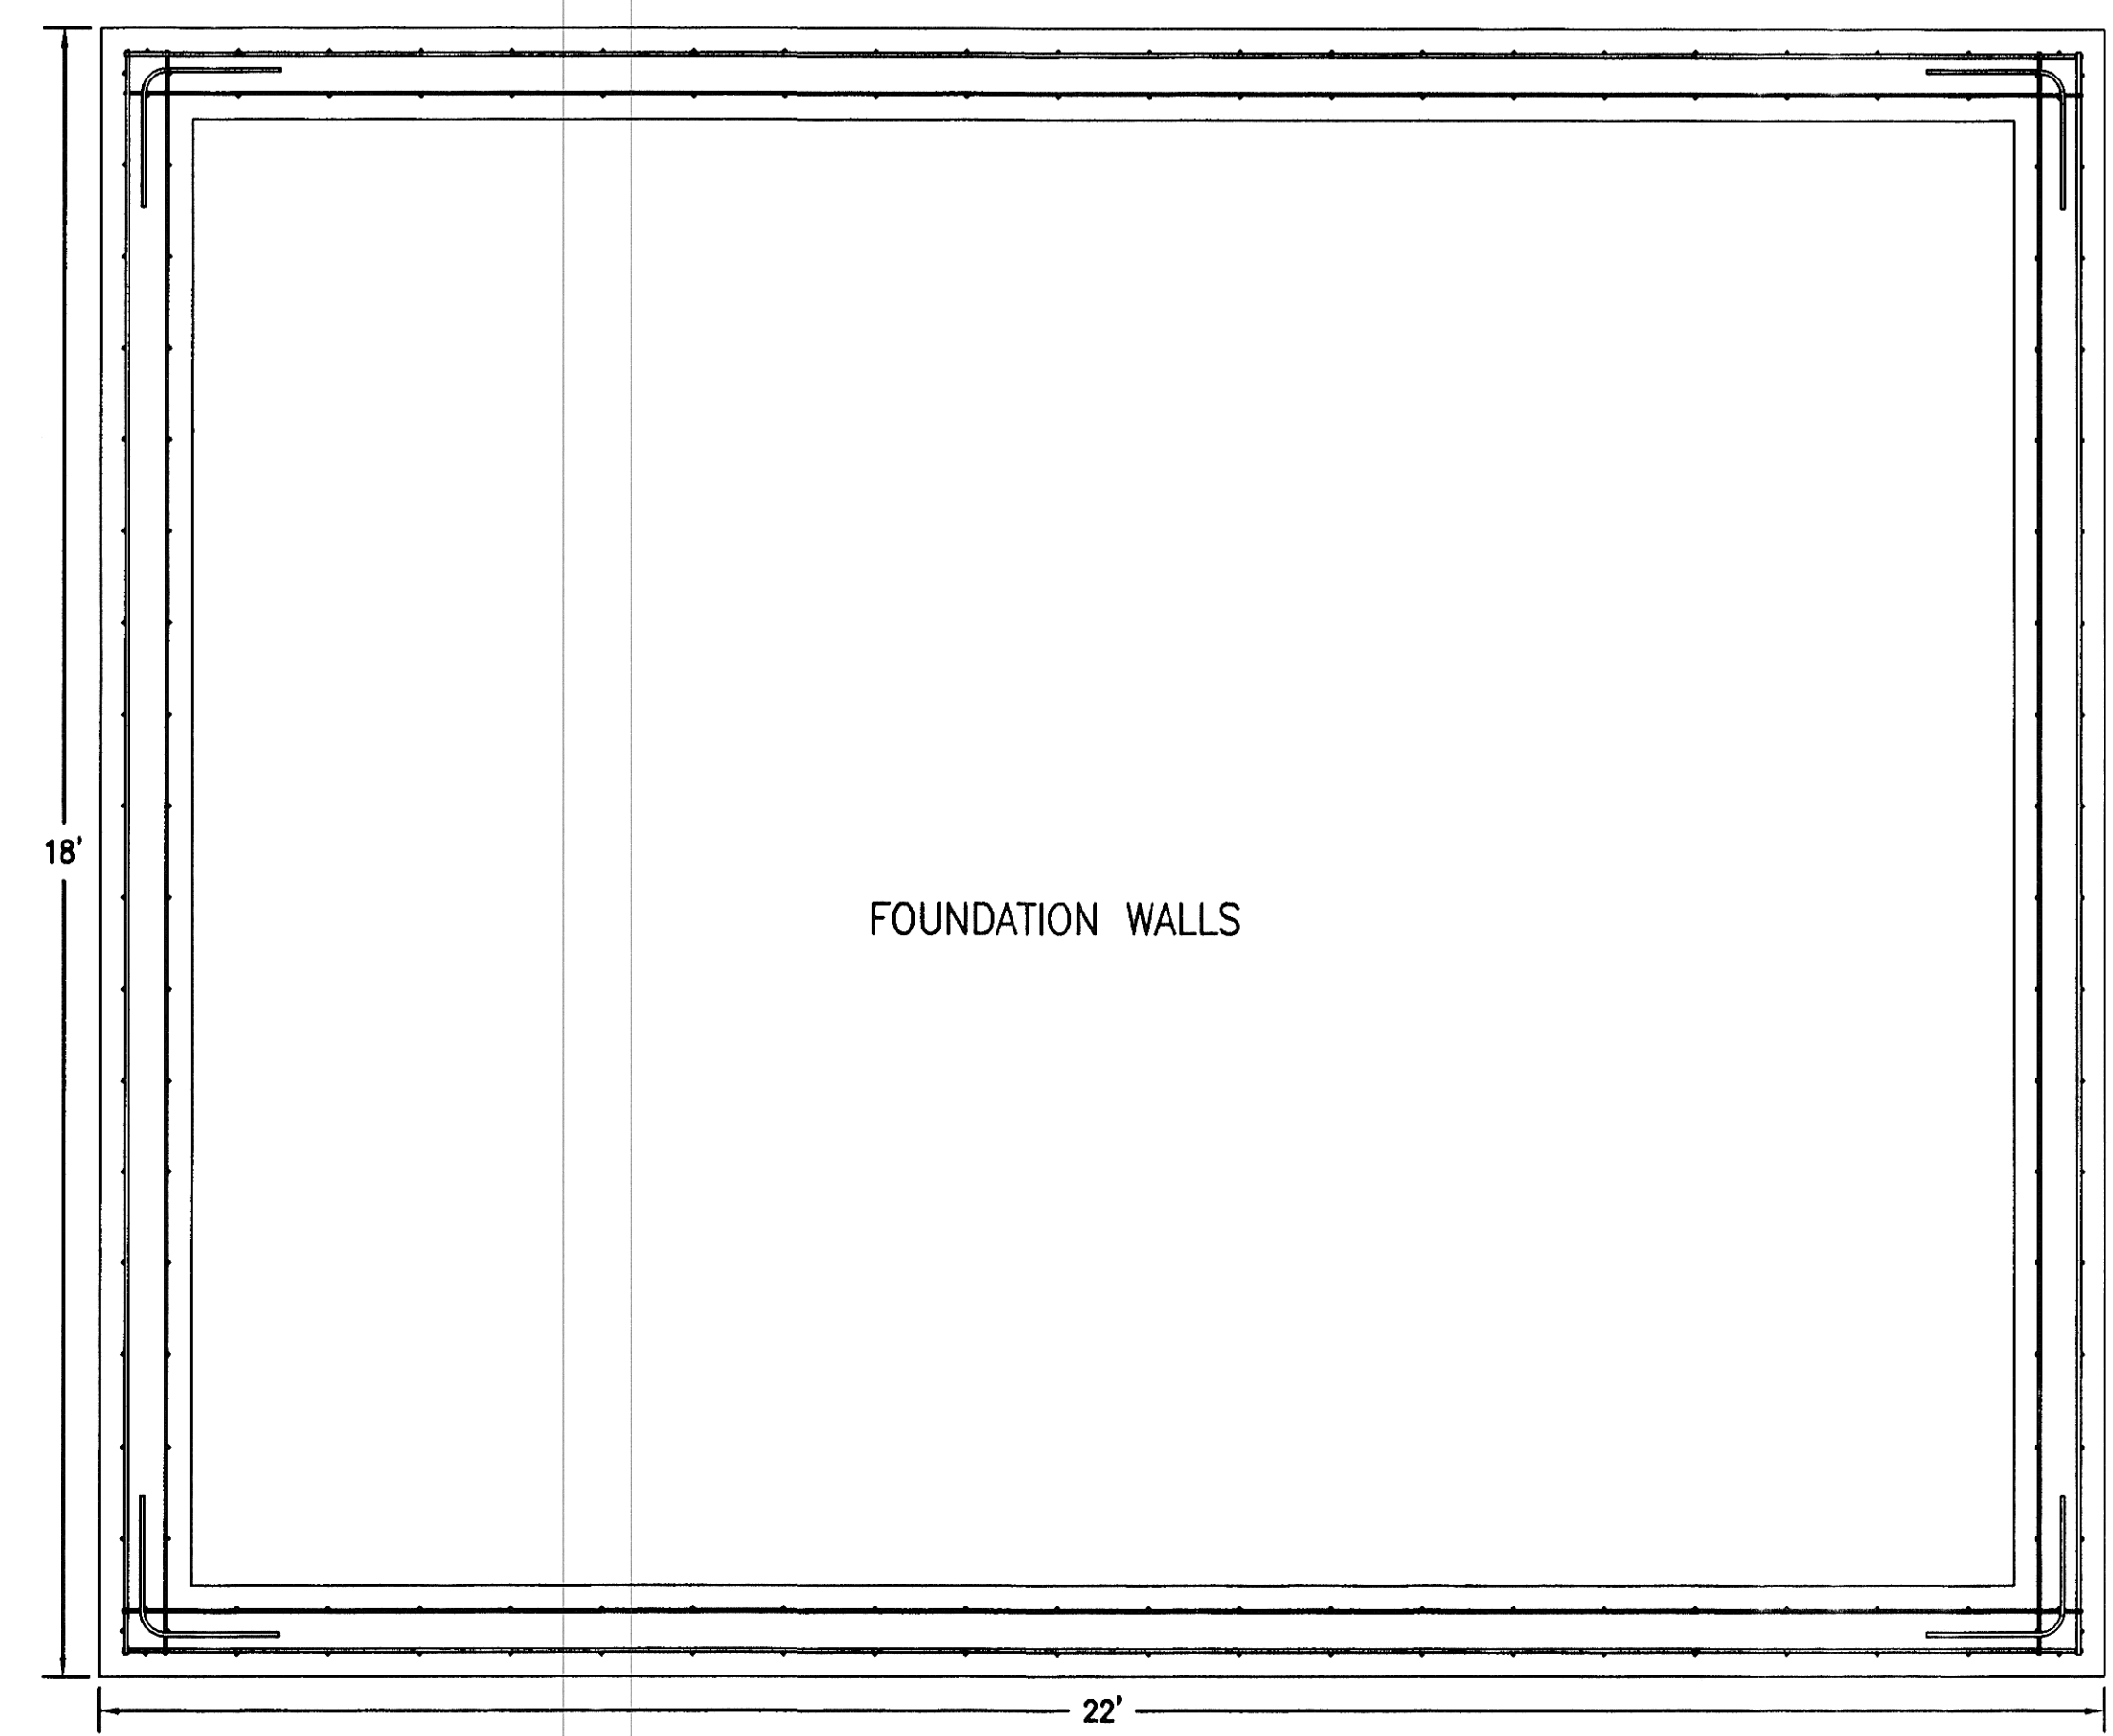
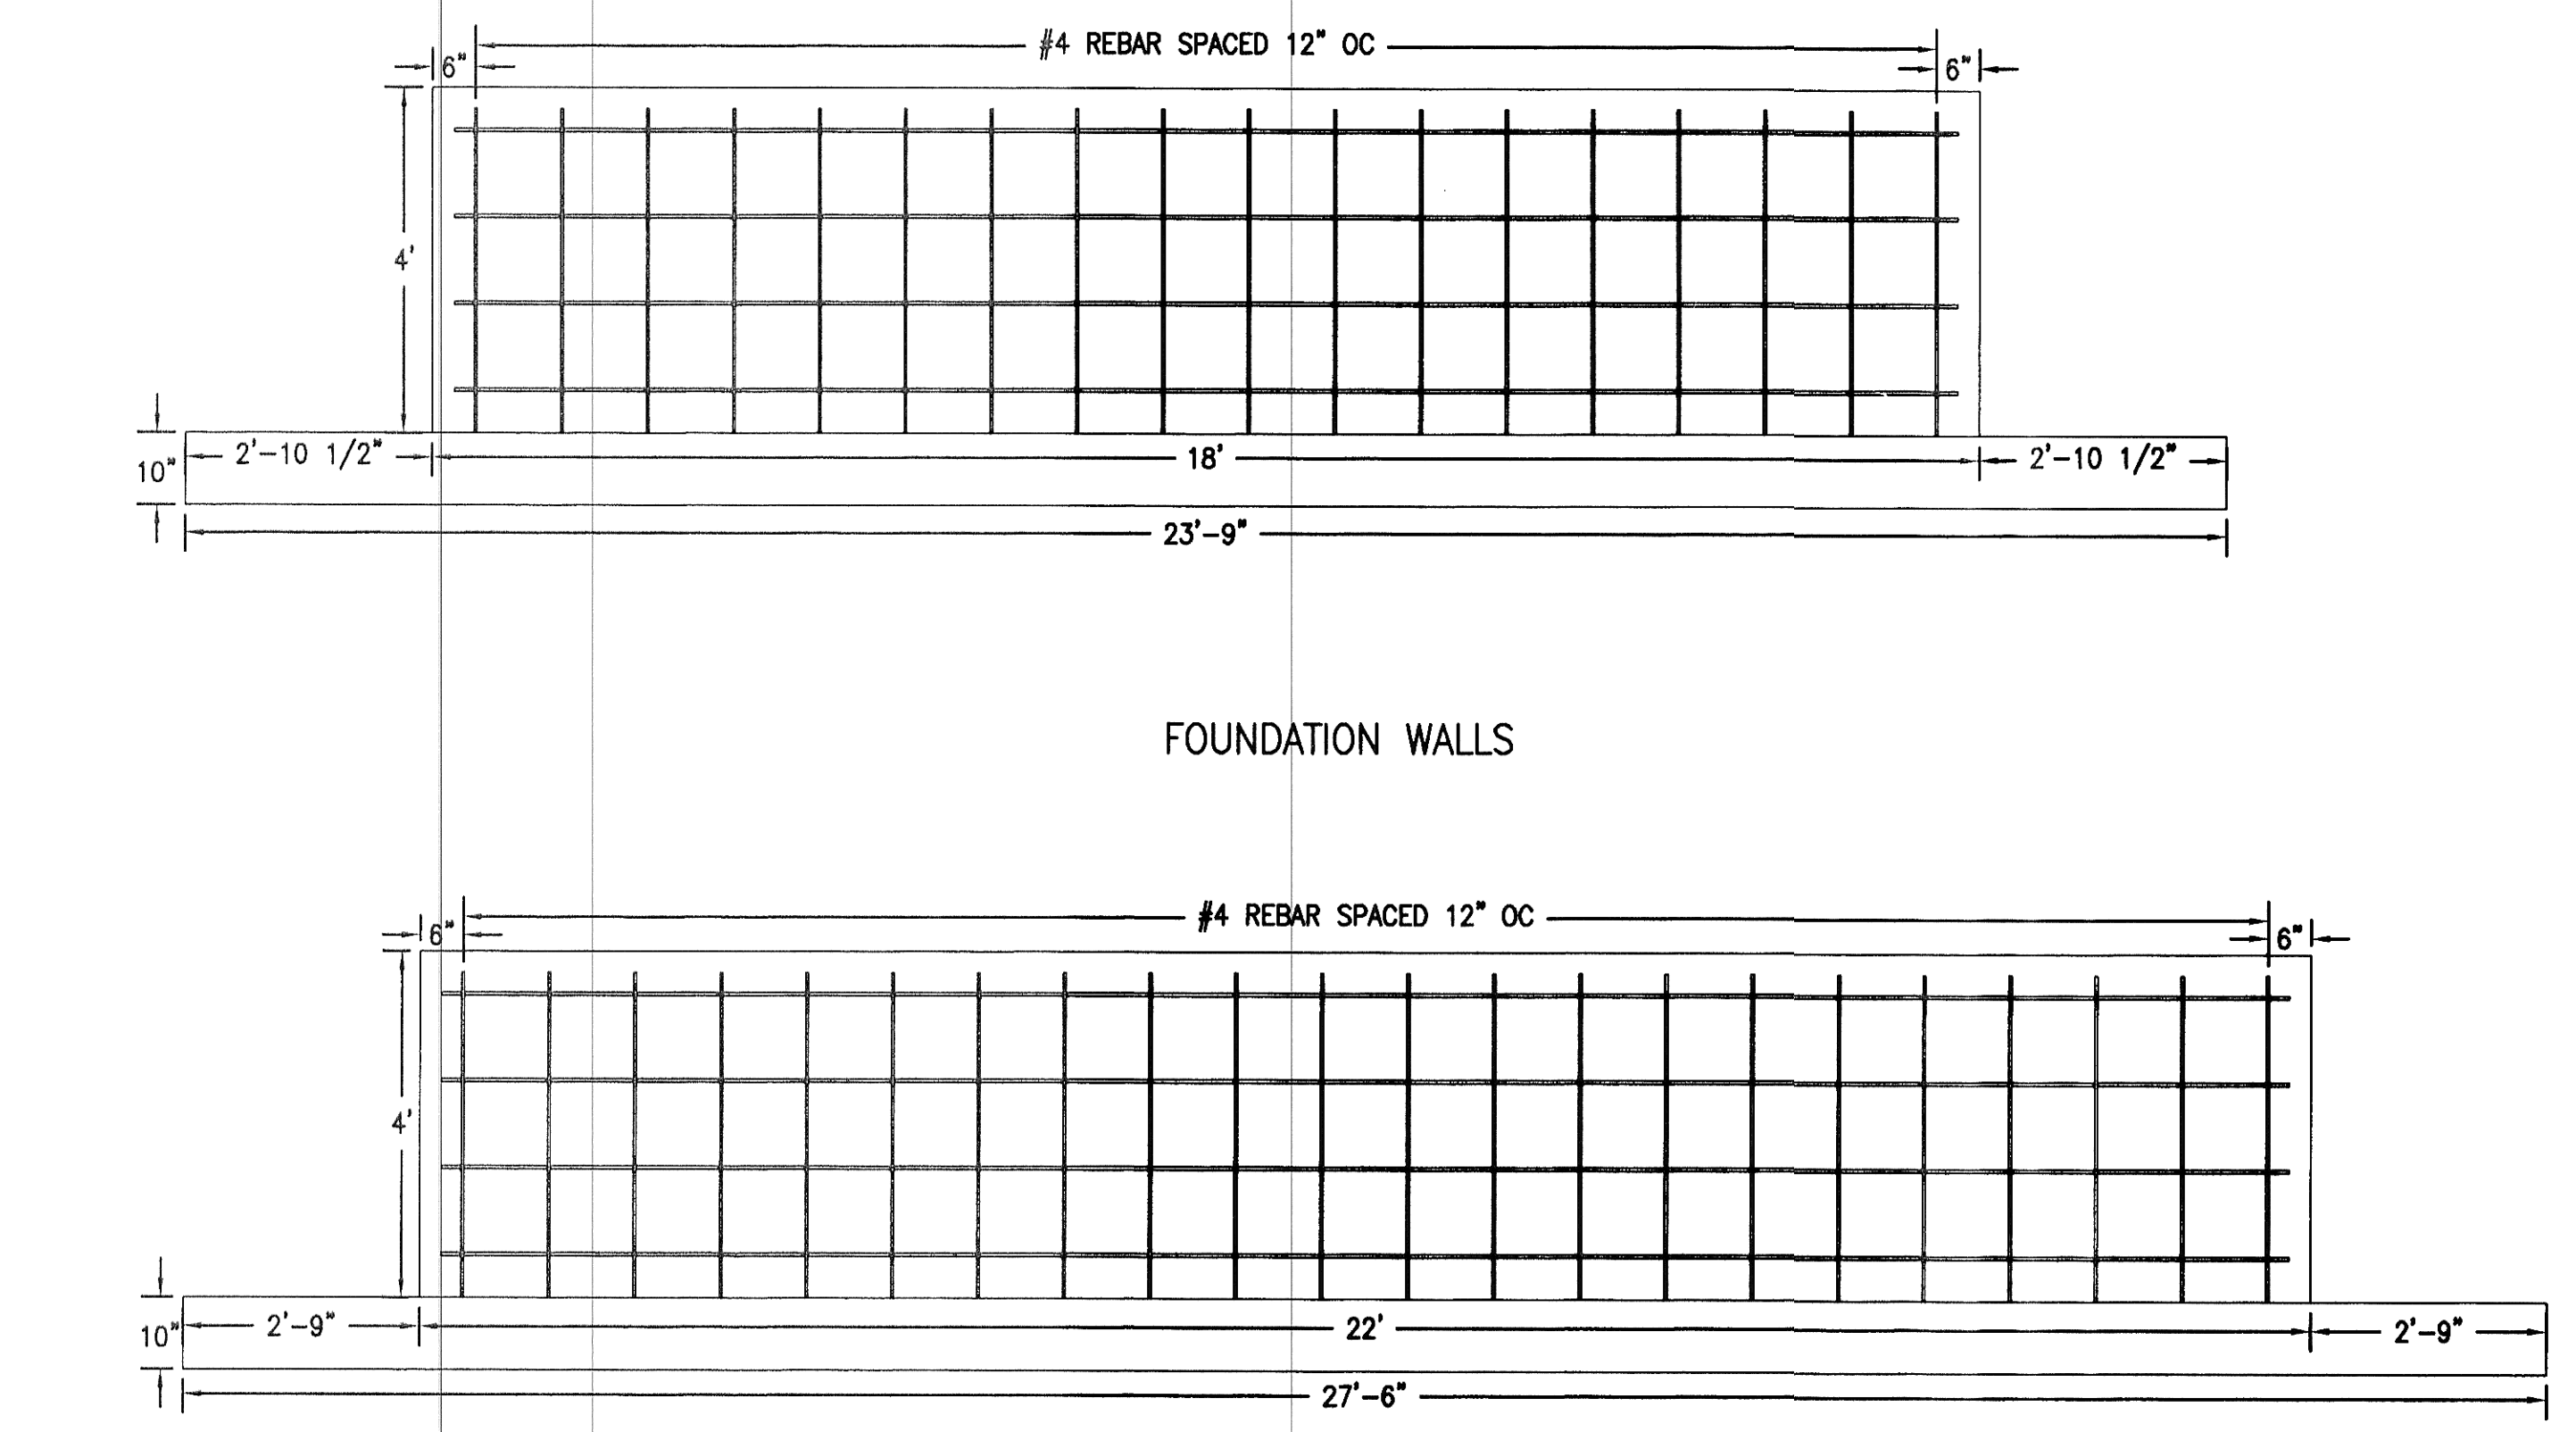
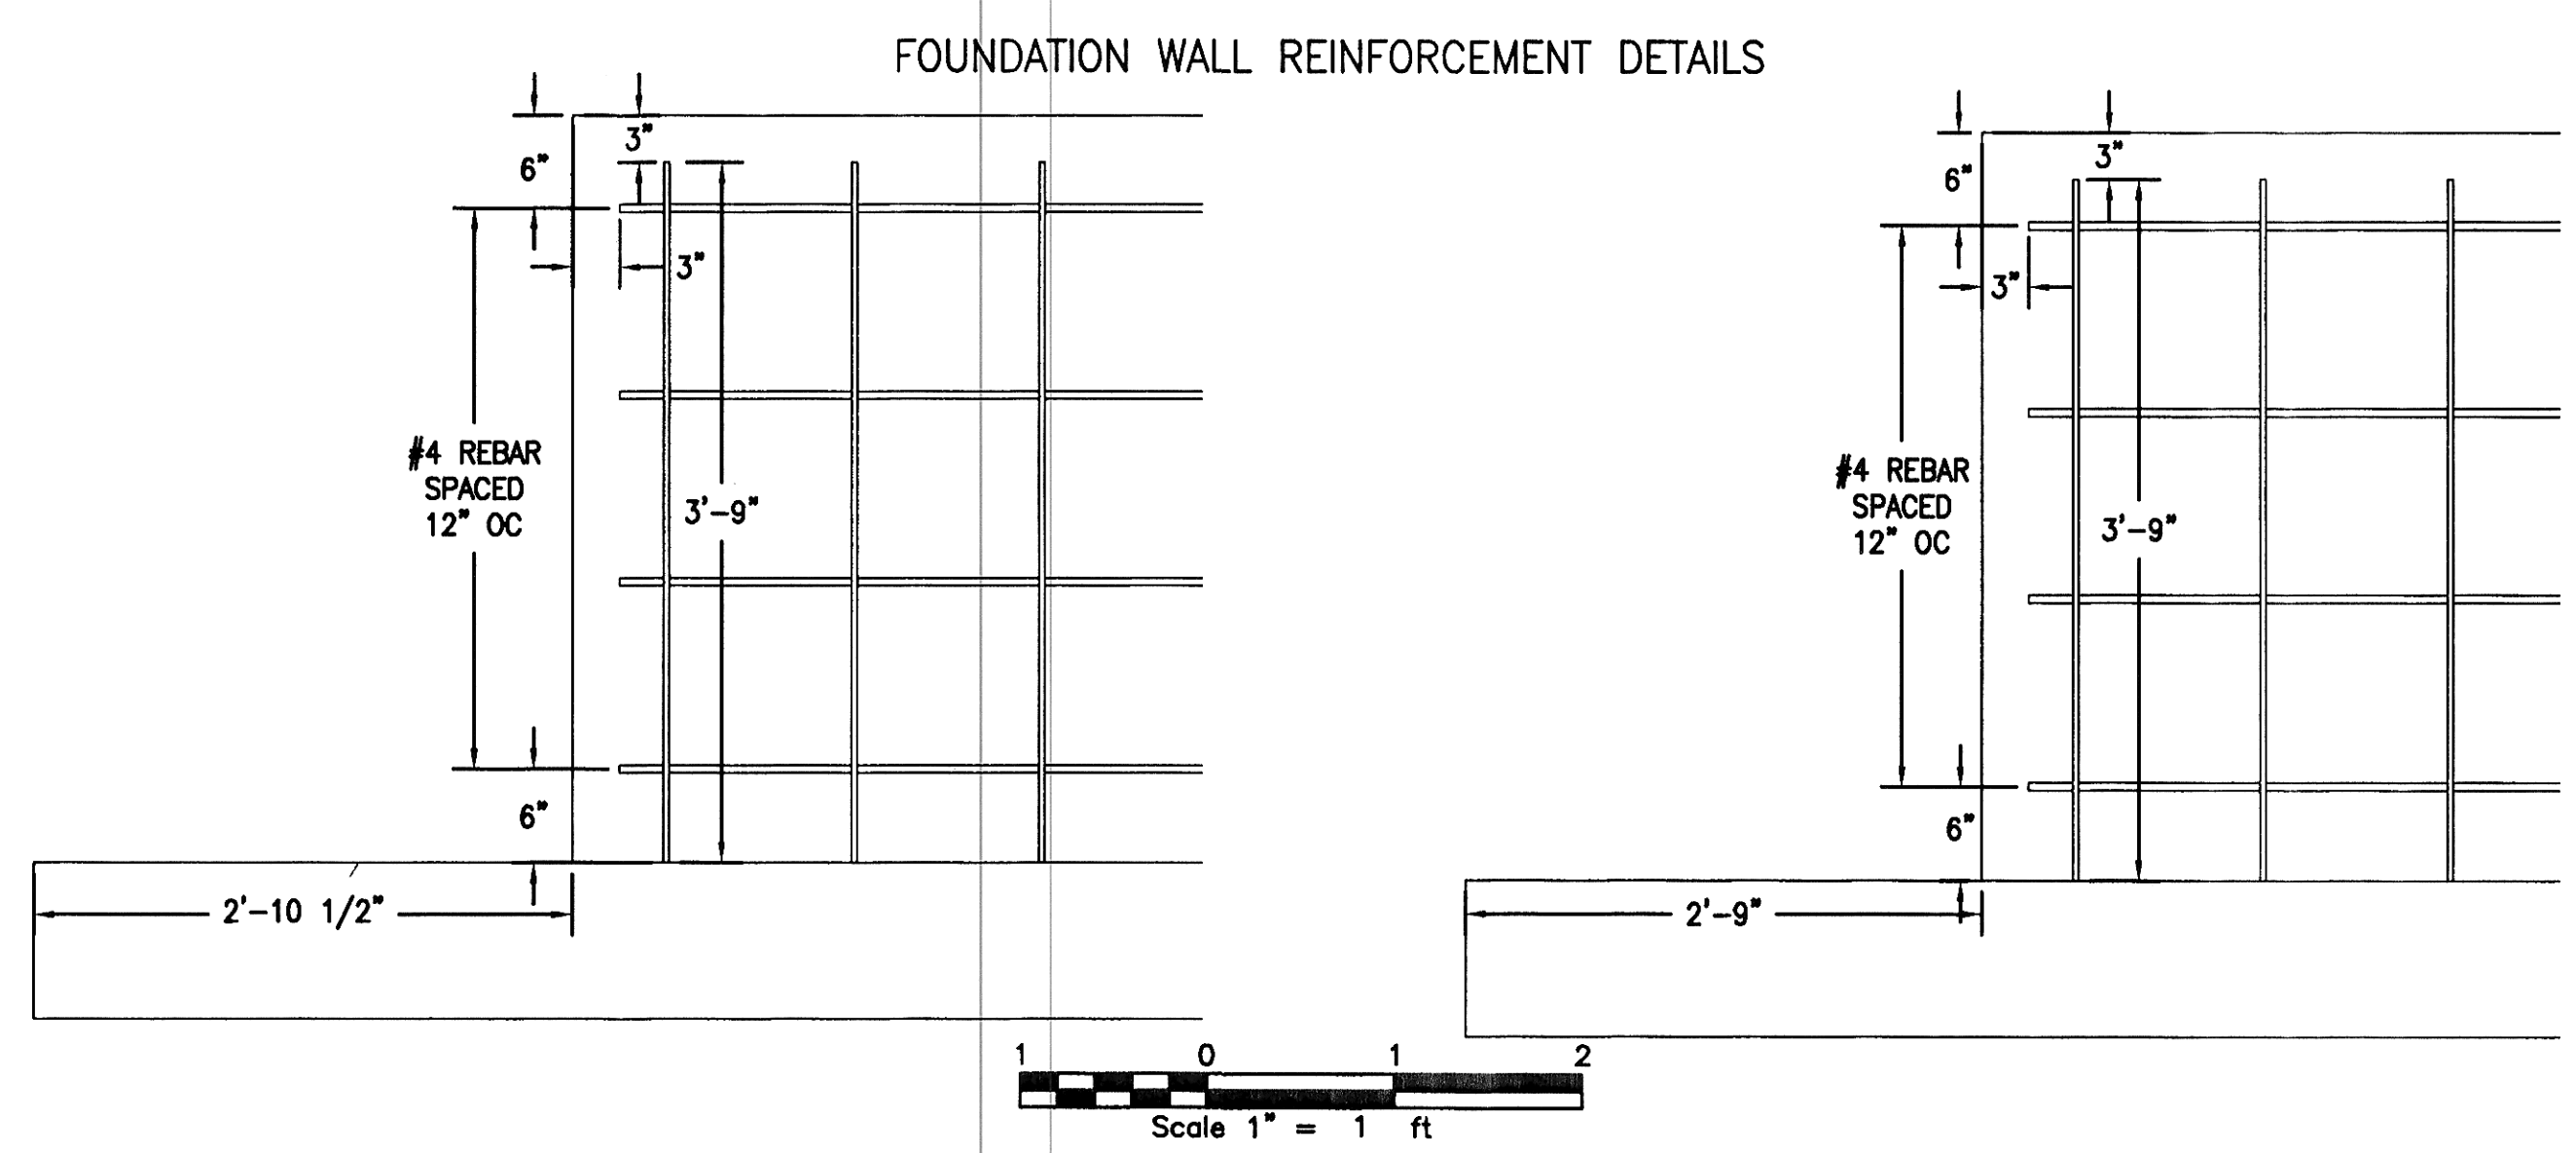
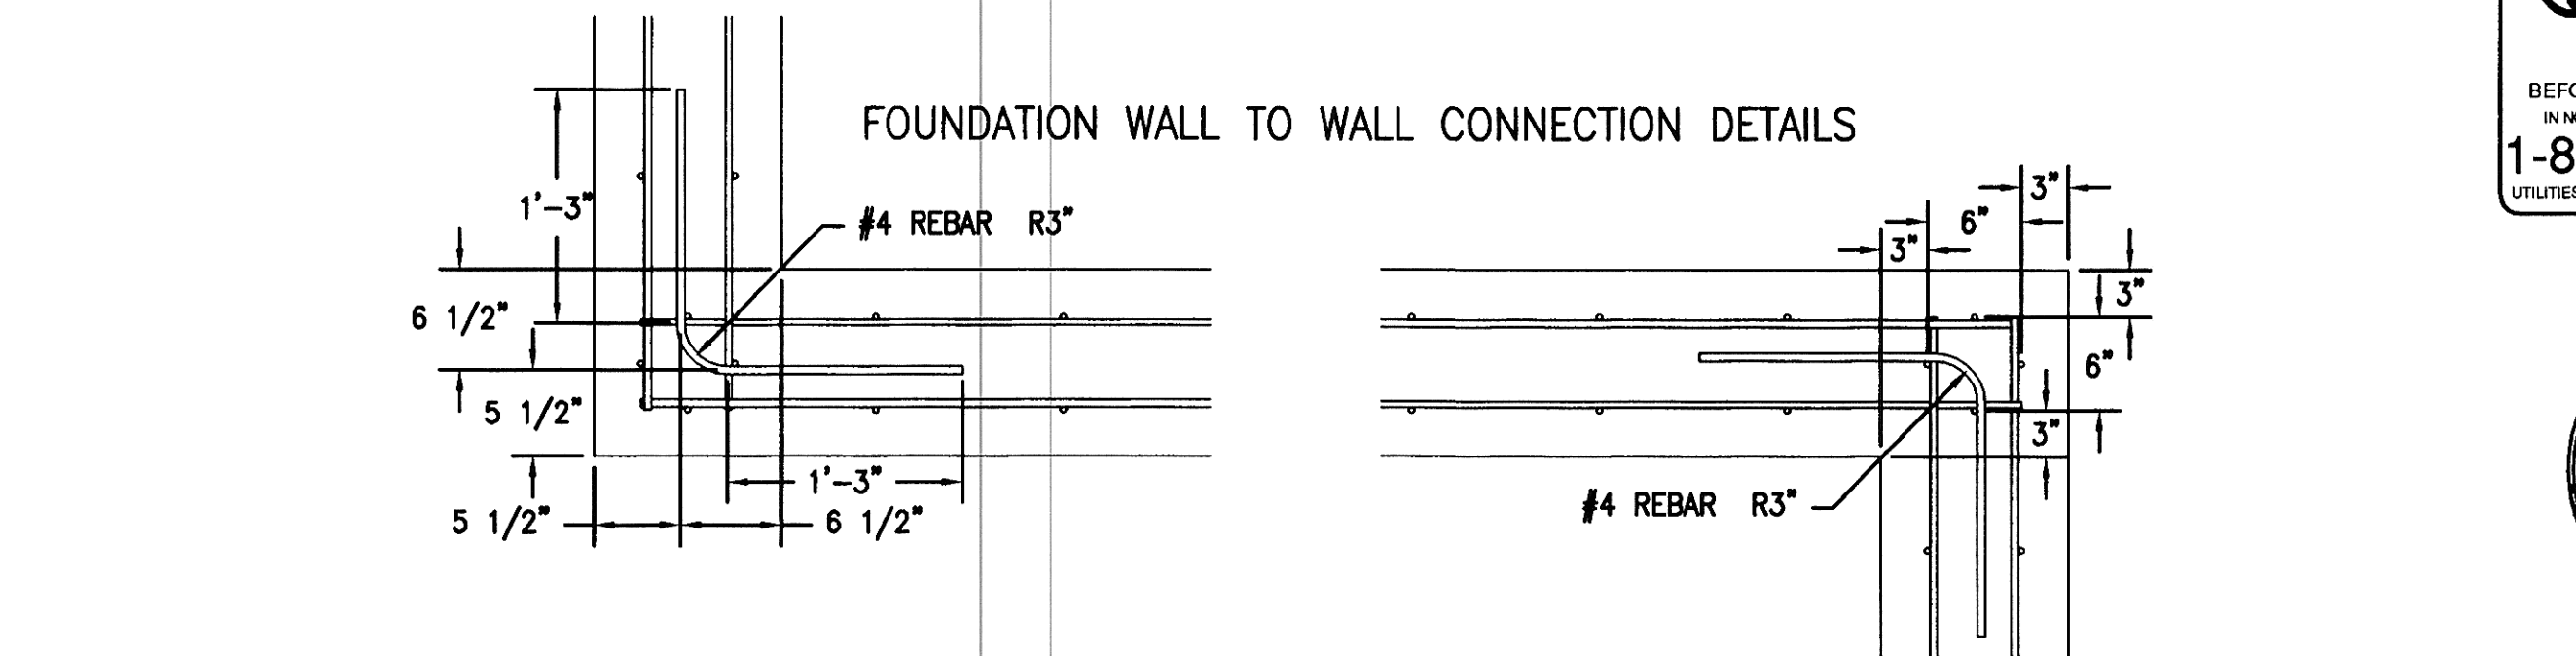


# AS BUILT FOUNDATION WALL DETAILS

AVOID CUTTING  
UNDERGROUND UTILITY  
LINES IN YOUR AREA  
TWO WORKING DAYS  
BEFORE YOU DIG-DRILL-BLAST  
IN NORTH DAKOTA - CALL TOLL FREE  
1-800-795-0555  
UTILITIES UNDERGROUND LOCATION CENTER

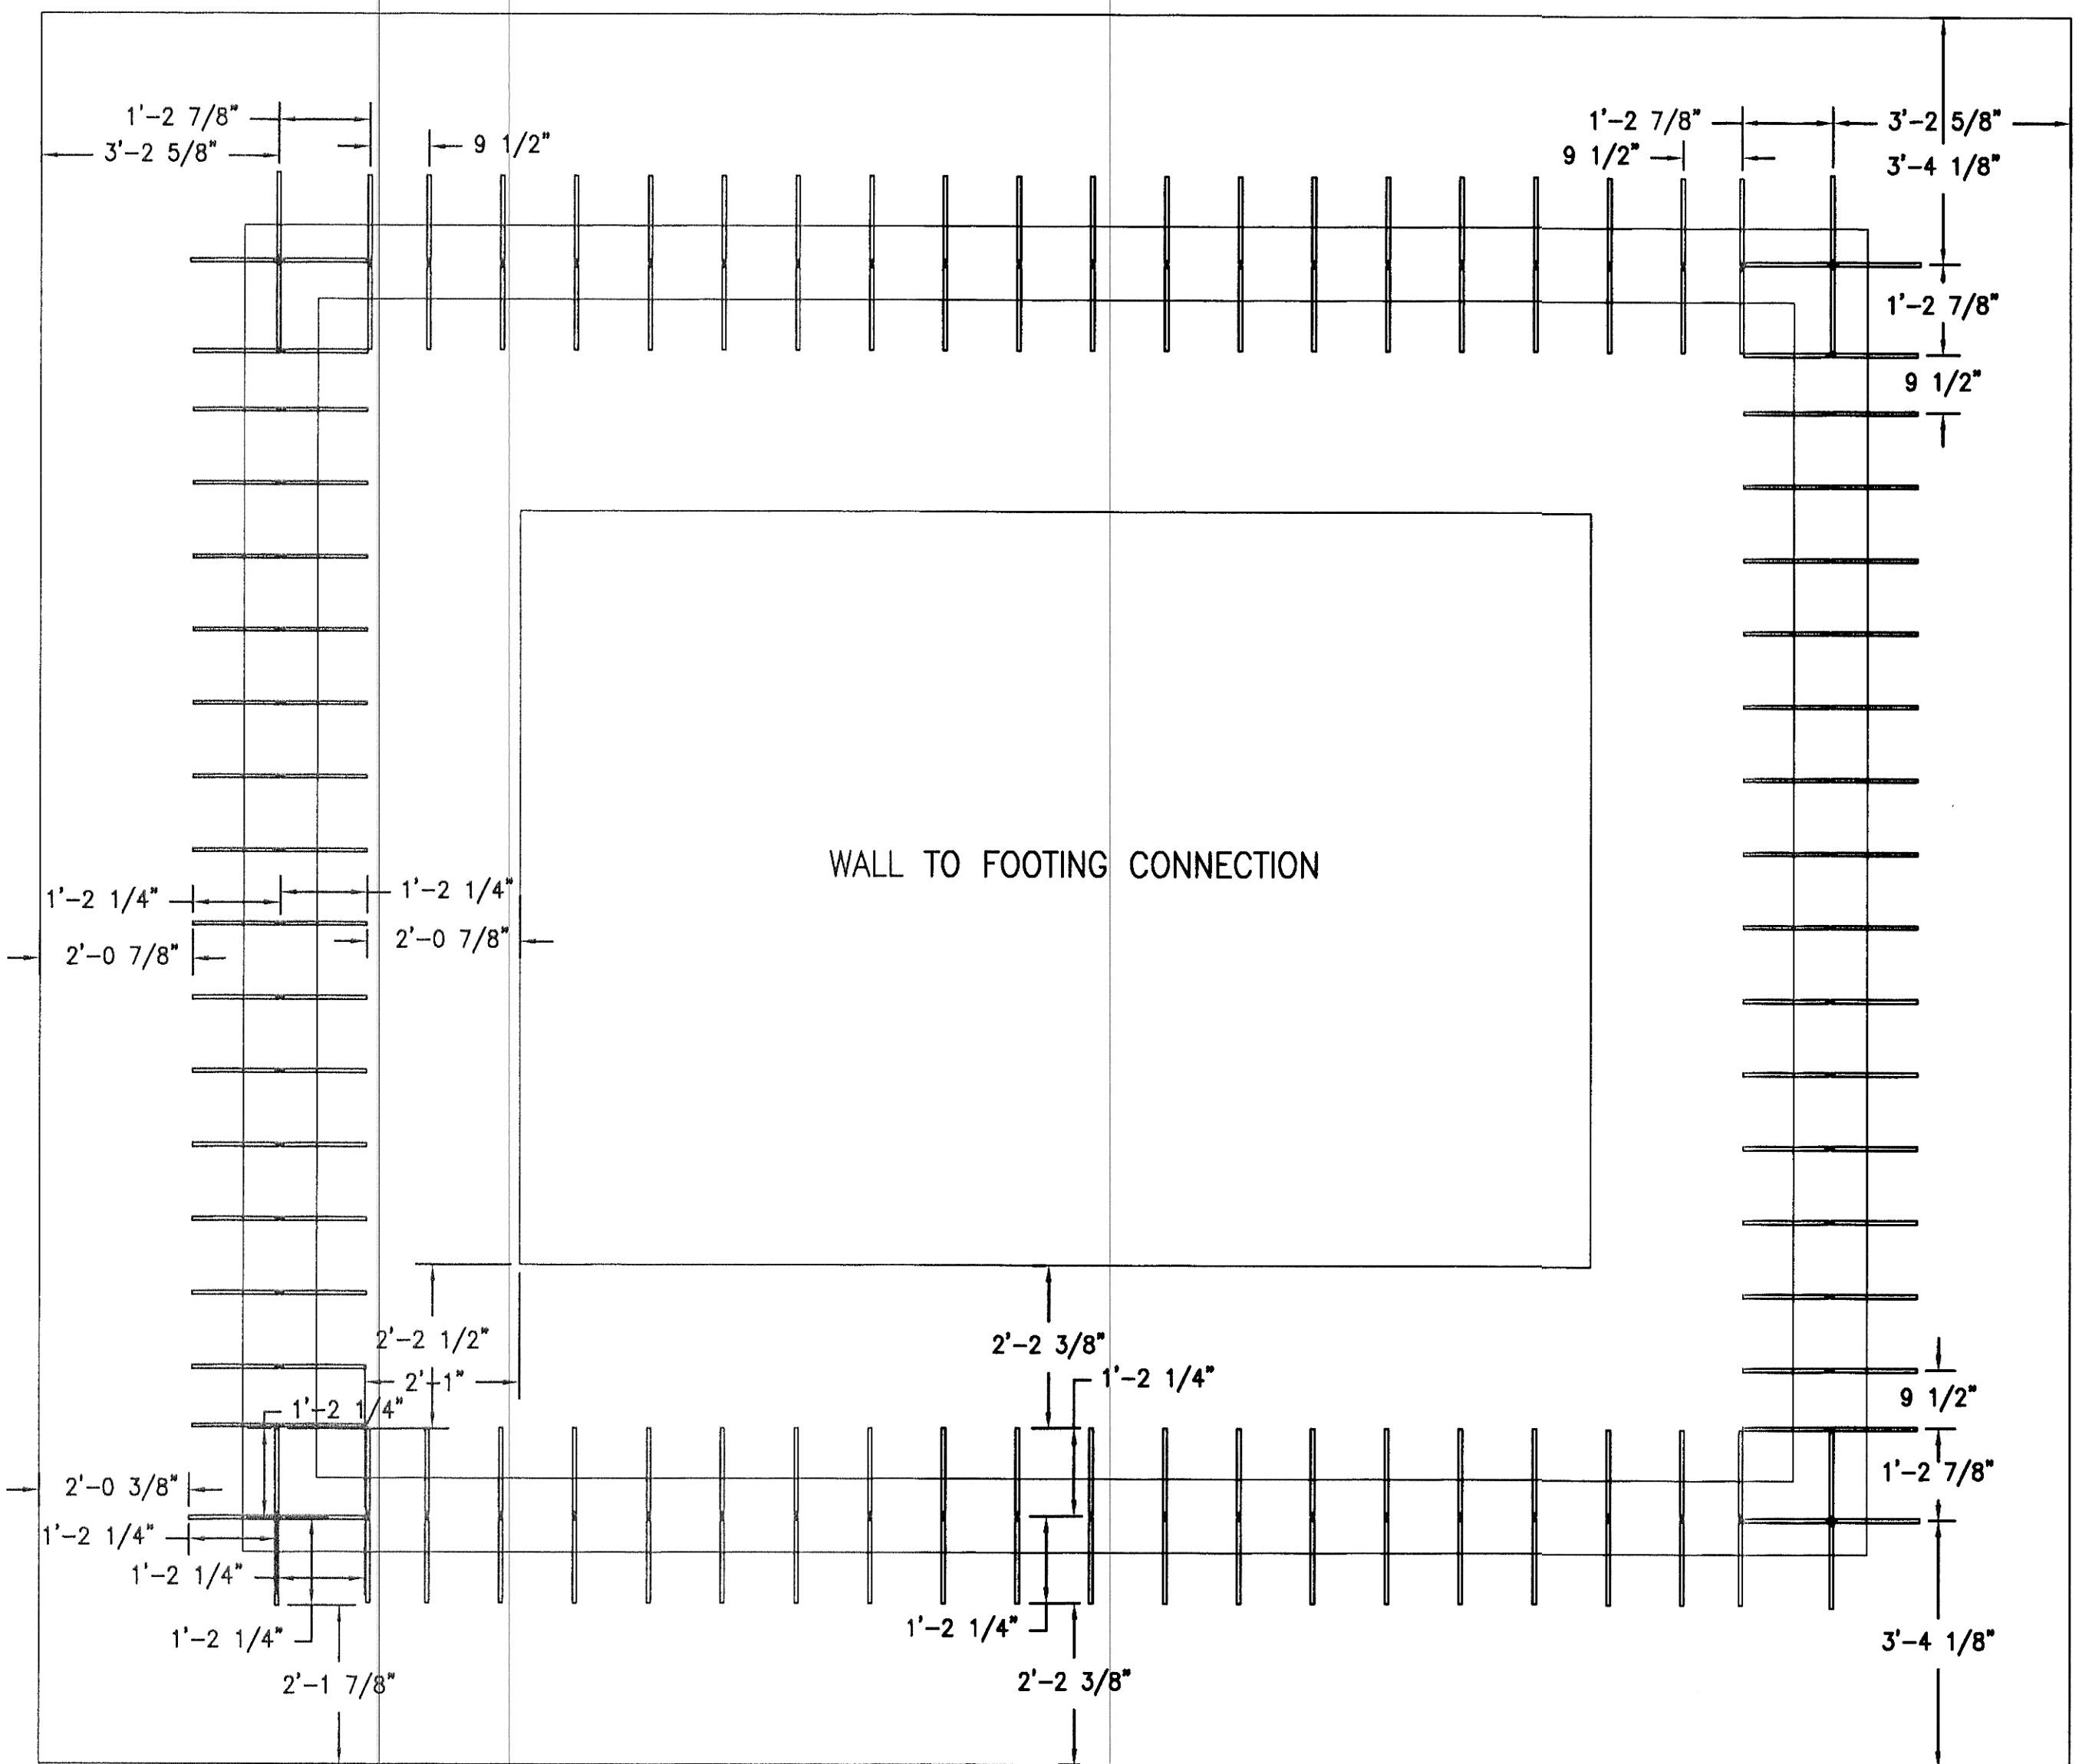

TOMAN ENGINEERING COMPANY  
CONSULTING CIVIL ENGINEERS  
908 2ND ST. N.W. • GRAND FORK, NORTH DAKOTA 58004 • 701-663-4485

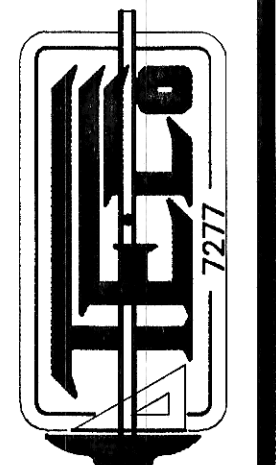

PROJECT:  
STANDBY GENERATOR &  
GENERATOR BUILDING REPLACEMENT  
AS BUILT FOUNDATION WALL DETAILS

NO.	BY	DATE	REVISIONS	APP'D BY	DATE
1					
2					
3					
4					
5					
6					
7					
8					
9					
10					

TITLE: STORM WATER PUMP REPLACEMENT  
SHEET NUMBER  
**12**  
OF 17 SHEETS

d:\7000\7277 Mandan lift station generator & bldg\new structure details.dwg, pg. 12 24x36, 05/09/2003 09:46:03 AM