



# AS BUILT SITE LAYOUT

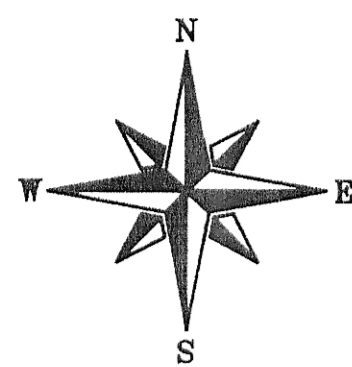

Scale 1" = 8 ft

AVOID CUTTING UNDERGROUND UTILITY LINES IN YOUR AREA  
TWO WORKING DAYS BEFORE YOU DIG-DRILL-BLAST IN NORTH DAKOTA - CALL TOLL FREE 1-800-795-0555 UTILITIES UNDERGROUND LOCATION CENTER

- LEGEND**
- EXISTING
- [P] ELECTRICAL BOX
  - POWER POLE
  - LIGHT POLE
  - GUY WIRE
  - GATE VALVE
  - MANHOLE
  - CATCH BASIN
  - x- FENCE
  - - - - - ELECTRIC
  - - - - - SANITARY SEWER
  - - - - - STORM SEWER
  - - - - - WATER
  - - - - - EXISTING DRIVEWAY
  - - - - - INSTALLED DRIVEWAY
  - - - - - INSTALLED CONCRETE
  - - - - - INSTALLED BUILDING

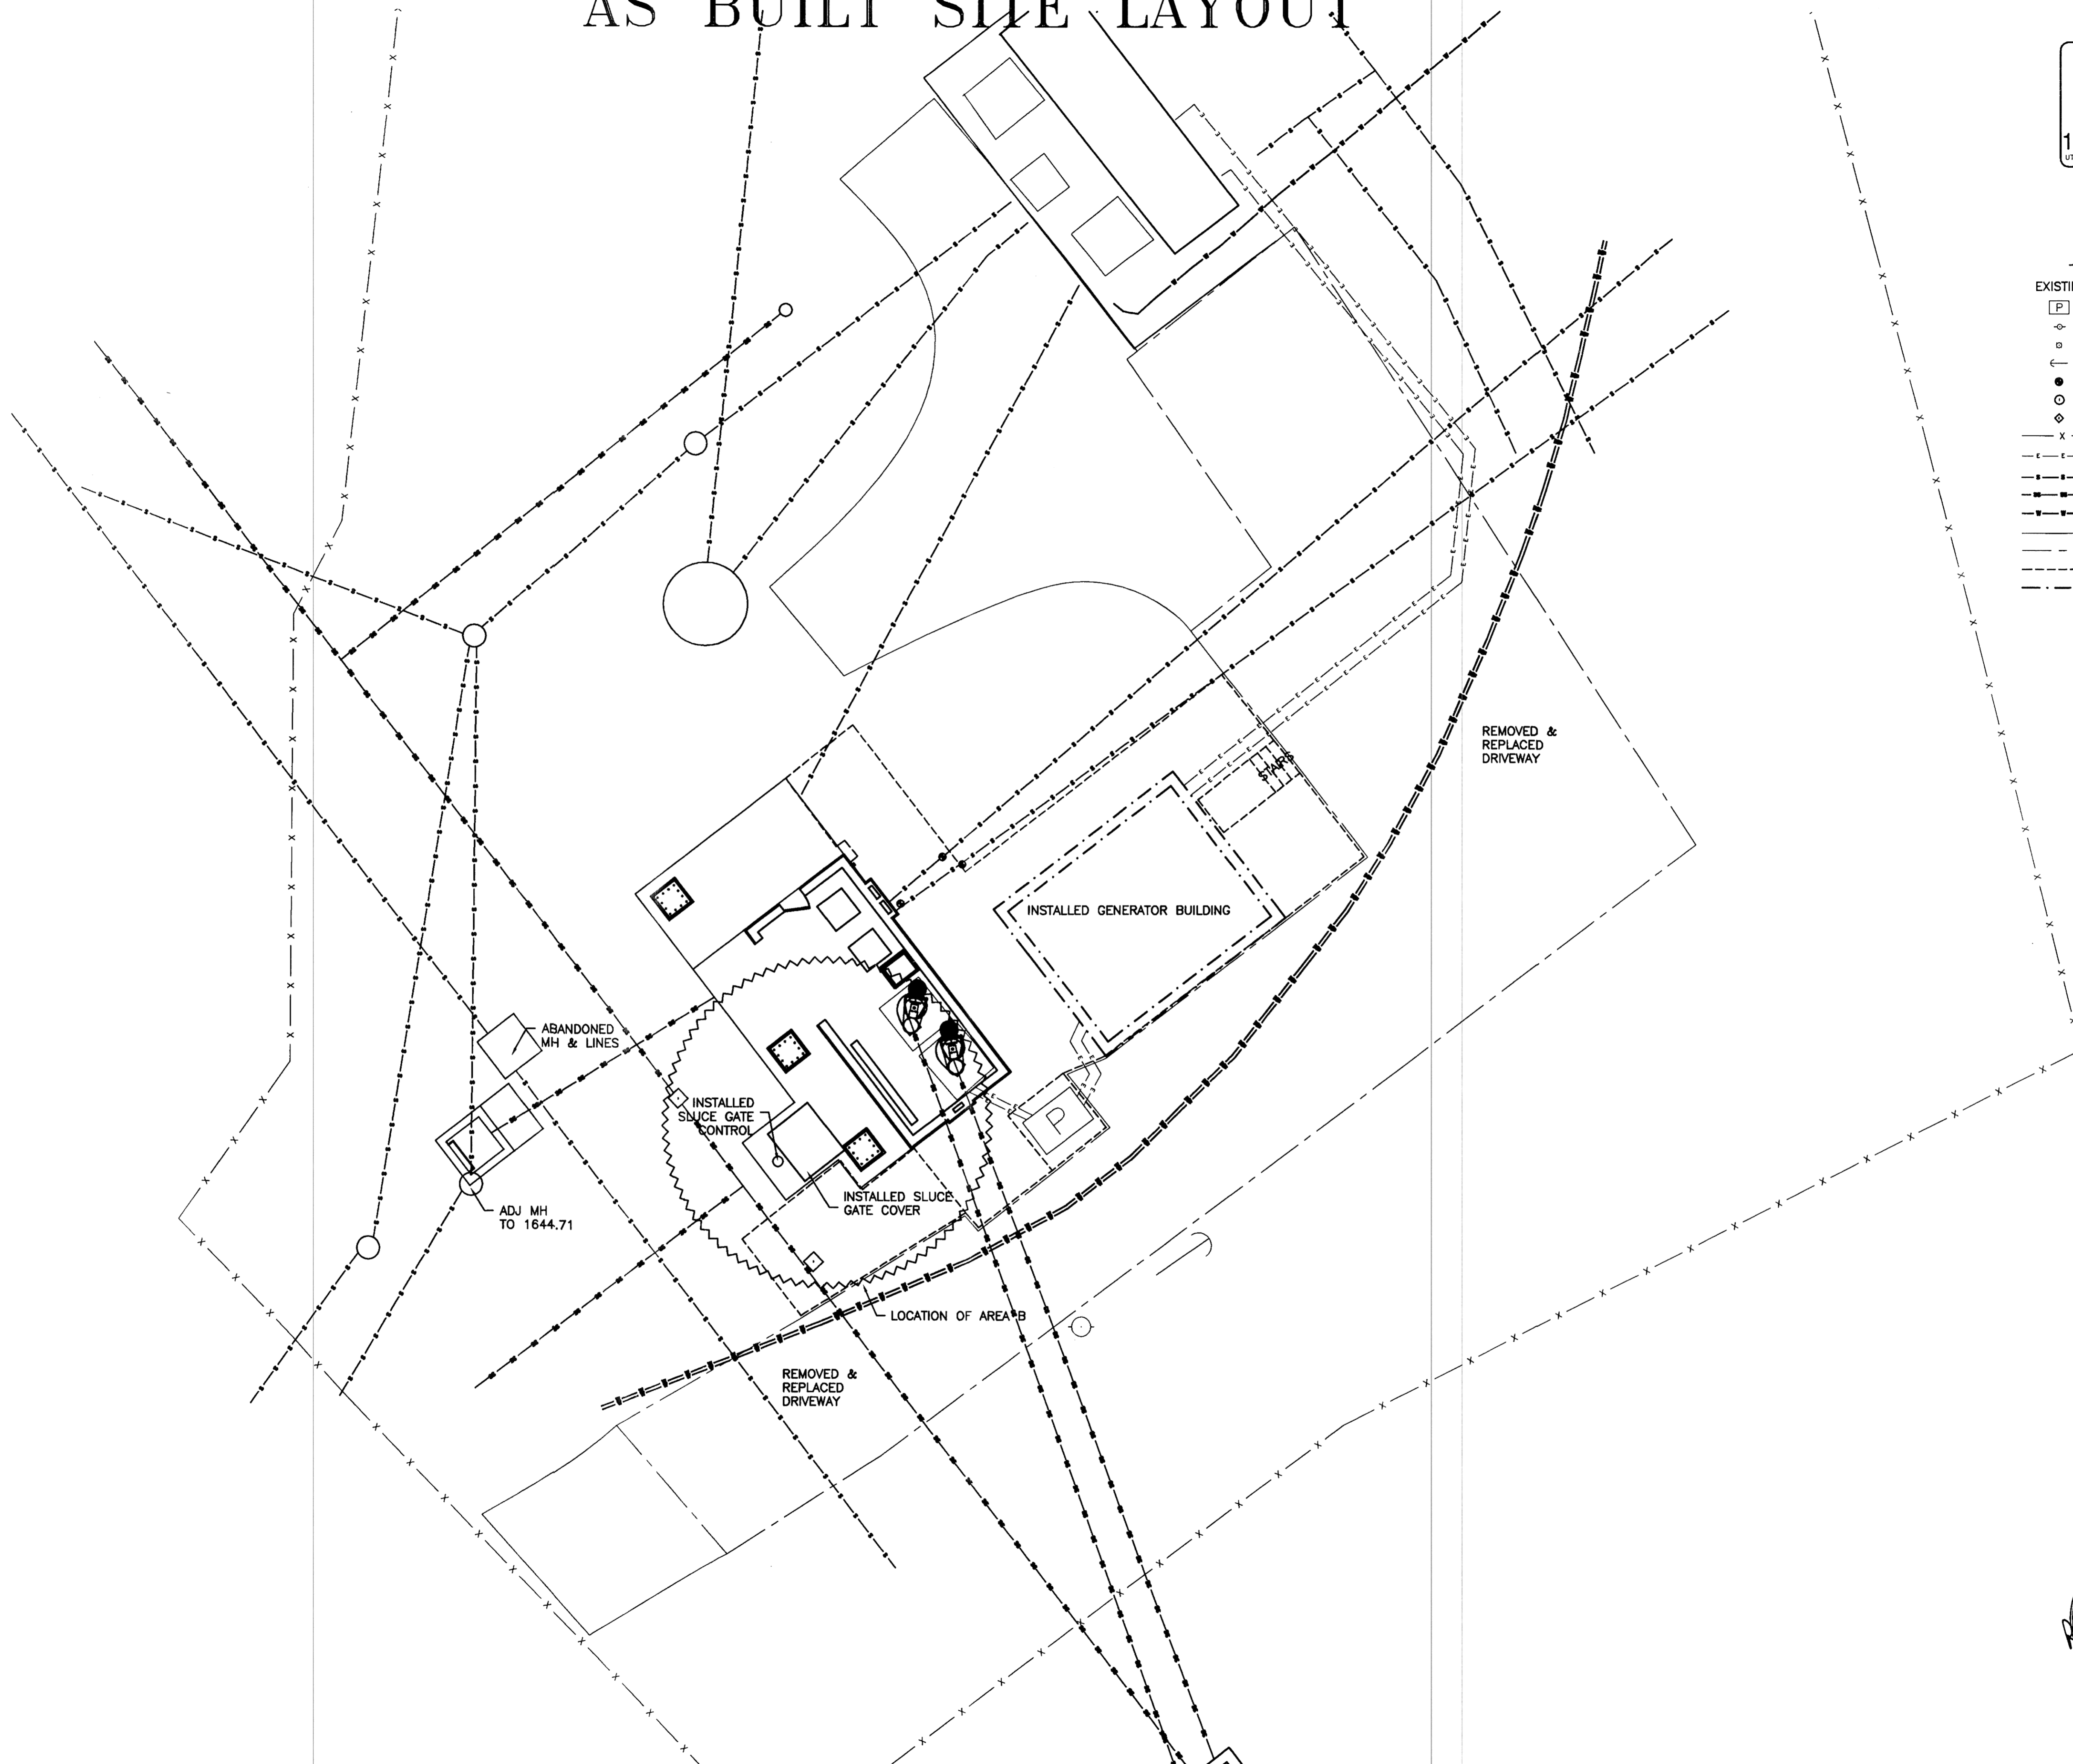

TOMAN ENGINEERING COMPANY  
CONSULTING CIVIL ENGINEERS  
808 2ND ST. N.E. • MINNAPOLIS, NORTH DAKOTA 58004 • 701-663-4465



PROJECT: STANDBY GENERATOR & BUILDING REPL.  
STORM WATER PUMP REPLACEMENT  
AS BUILT SITE LAYOUT

TITLE	BY	DATE	ISSUE NO.	REVISED BY	DATE	PROPOSED BY	DATE
STORM WATER PUMP REPLACEMENT							
REVISIONS							

SHEET NUMBER  
**2**  
OF 17 SHEETS