
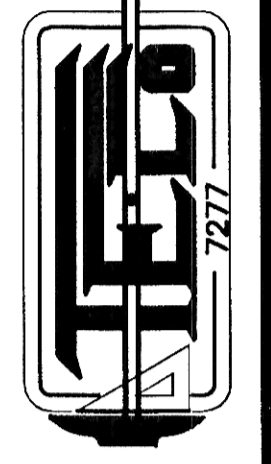


AS BUILT WALL OPENINGS & LAYOUTS


AVOID CUTTING UNDERGROUND UTILITY LINES IN YOUR AREA
 TWO WORKING DAYS BEFORE YOU DIG-DRILL-BLAST IN NORTH DAKOTA - CALL TOLL FREE 1-800-795-0555
 UTILITIES UNDERGROUND LOCATION CENTER

TOMAN ENGINEERING COMPANY
 CONSULTING CIVIL ENGINEERS
 908 2ND ST. N.W. • MINNETONKA, NORTH DAKOTA 58045 • 701-863-6463


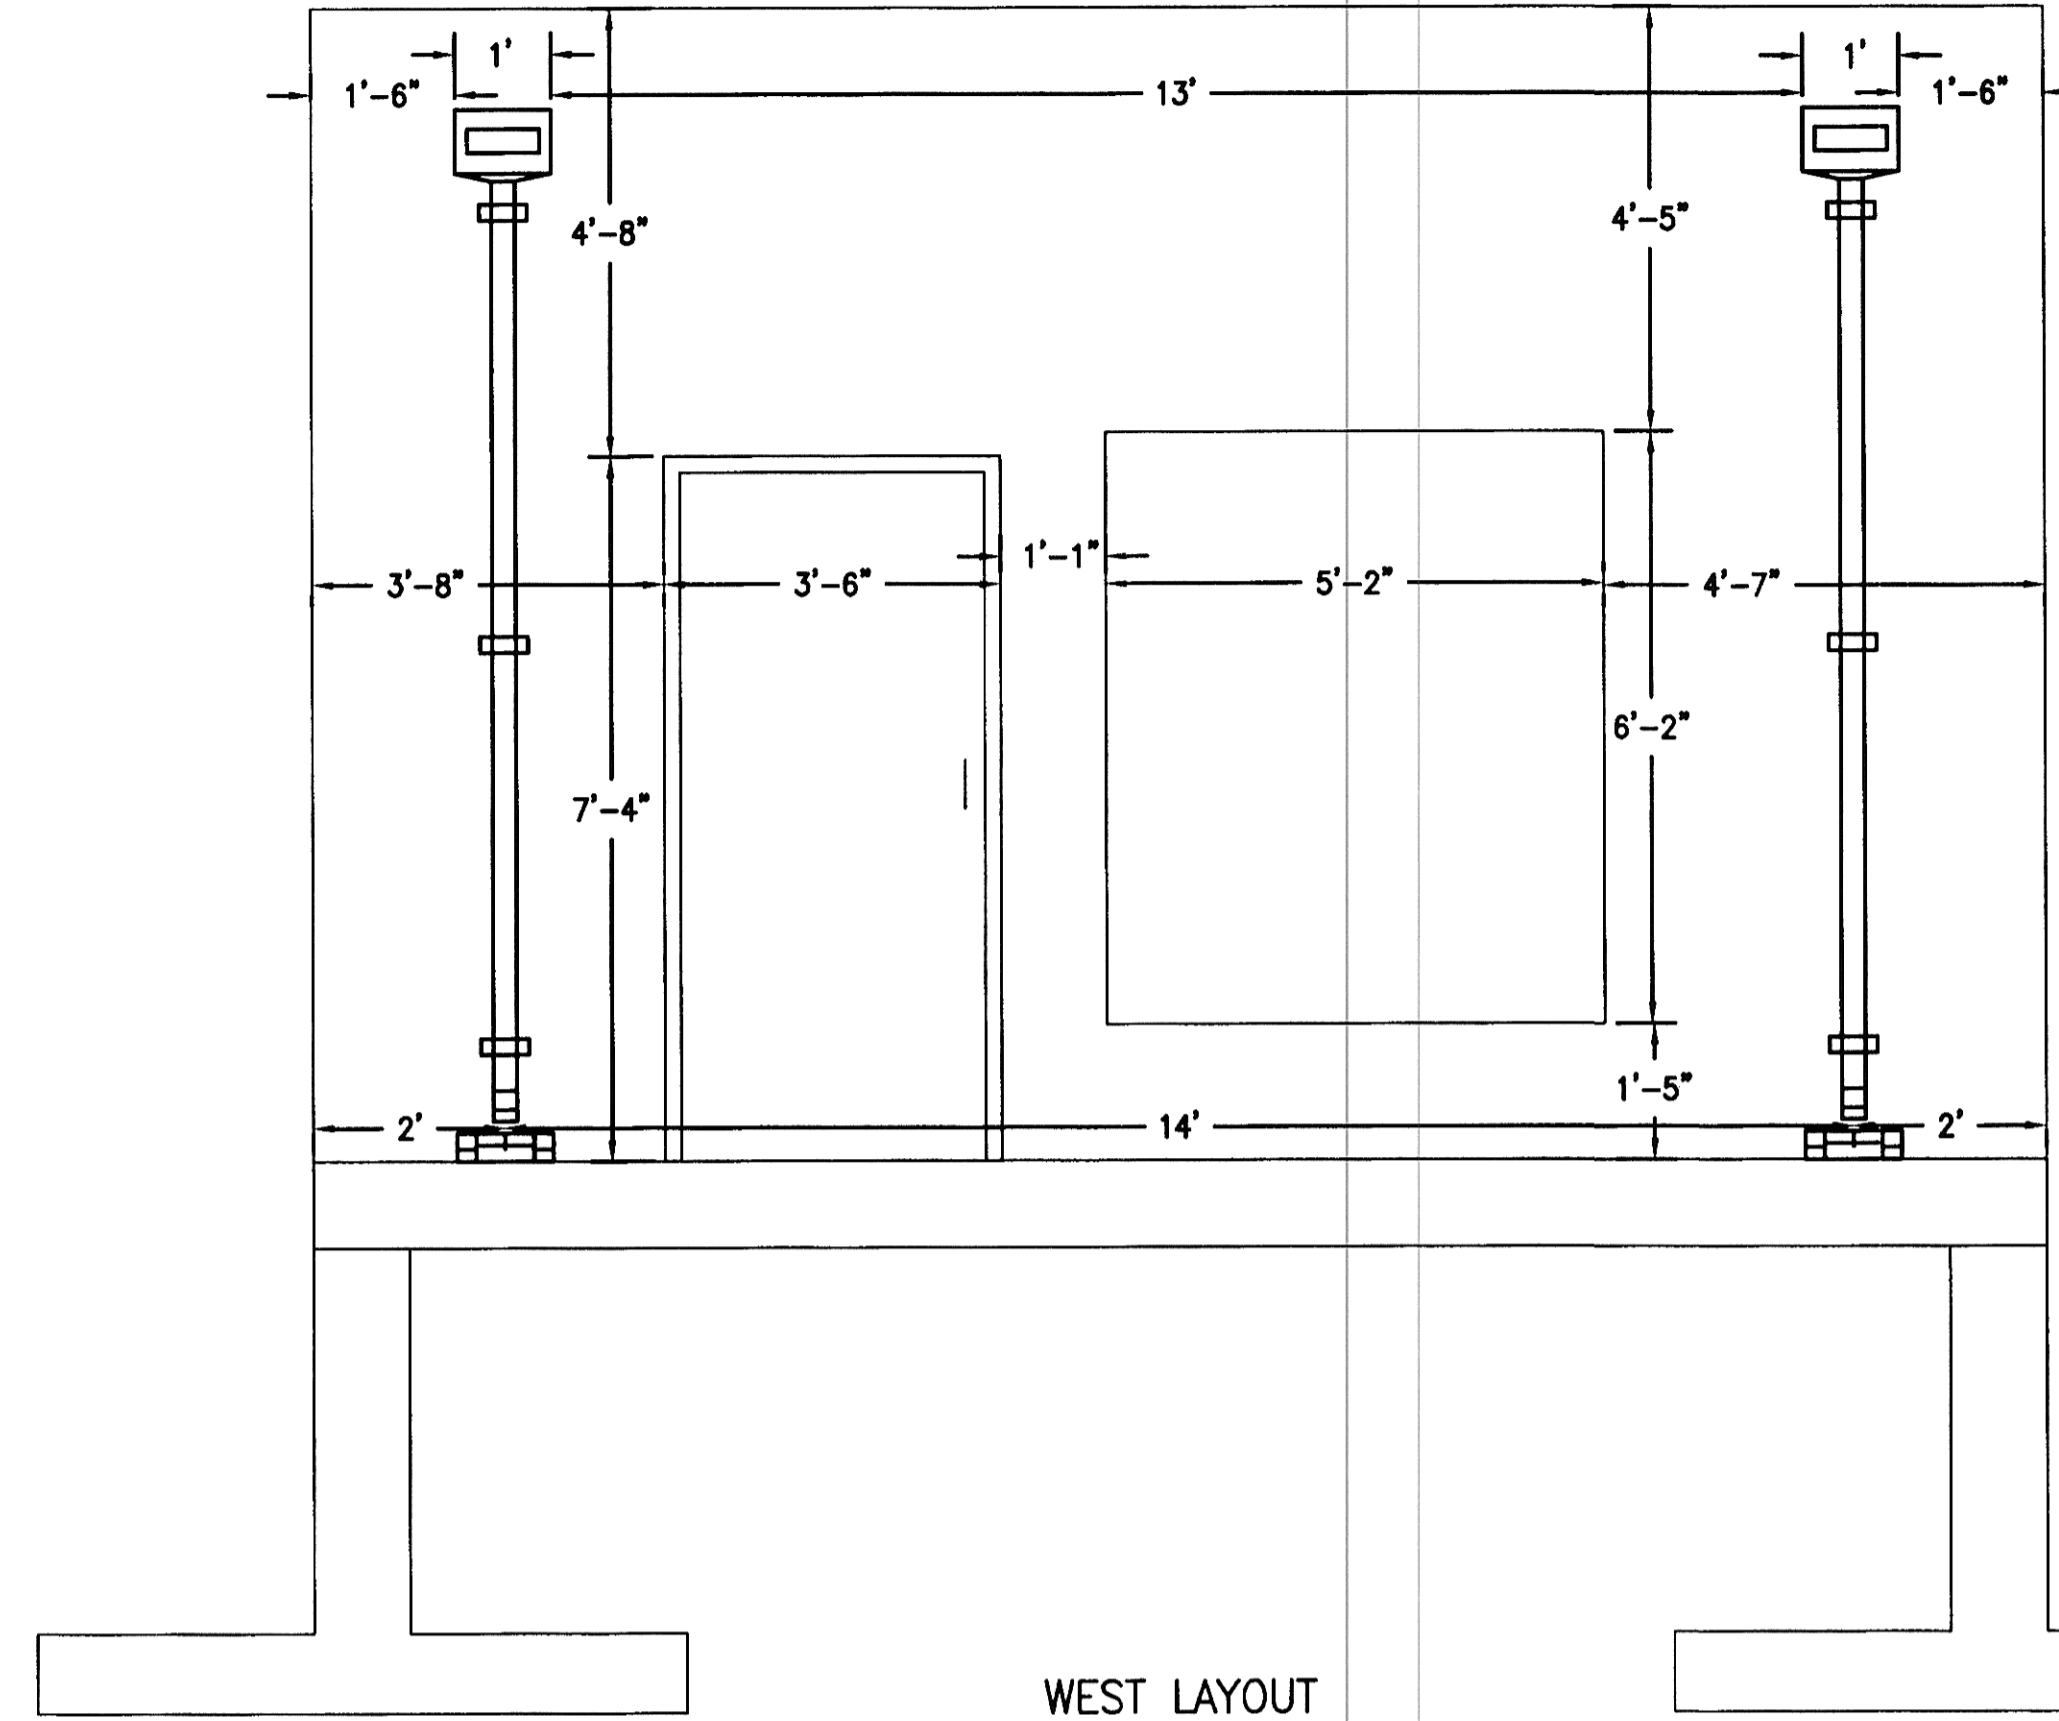
PROJECT: **STANDBY GENERATOR & GENERATOR BUILDING REPLACEMENT AS BUILT WALL OPENINGS & LAYOUTS**

NO.	DATE	BY	REVISIONS
1	8/29/2001		ISSUE FOR PERMIT
2	9/17/2001		PERMIT NO. 9712001


TITLE: AS BUILT STORM WATER PUMP REPLACEMENT
 SHEET NUMBER **9**
 OF 17 SHEETS




NORTH LAYOUT




WEST LAYOUT

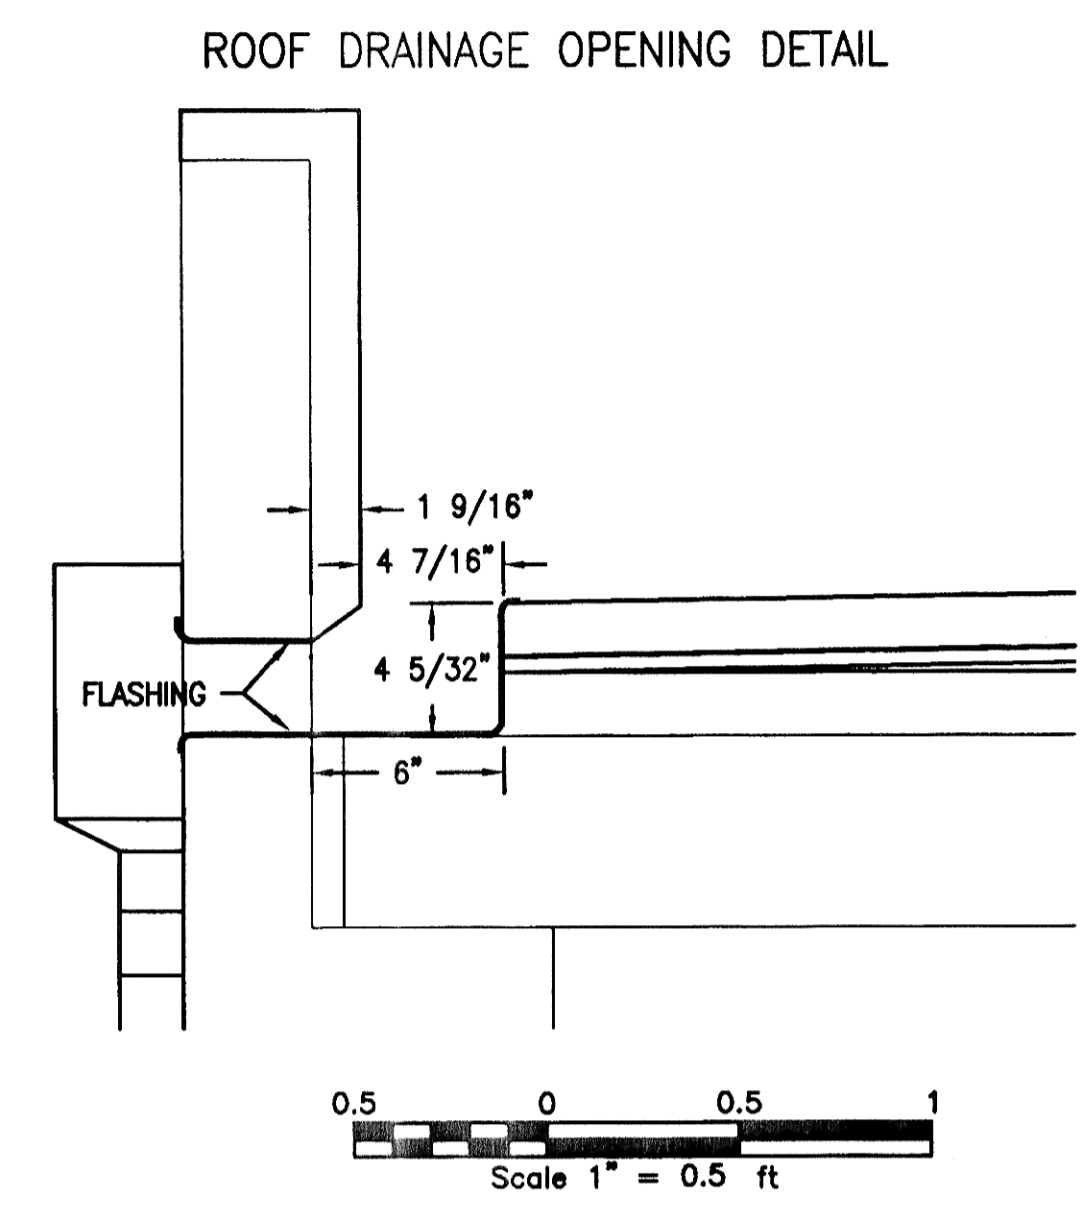


ROOF DRAINAGE OPENING DETAIL

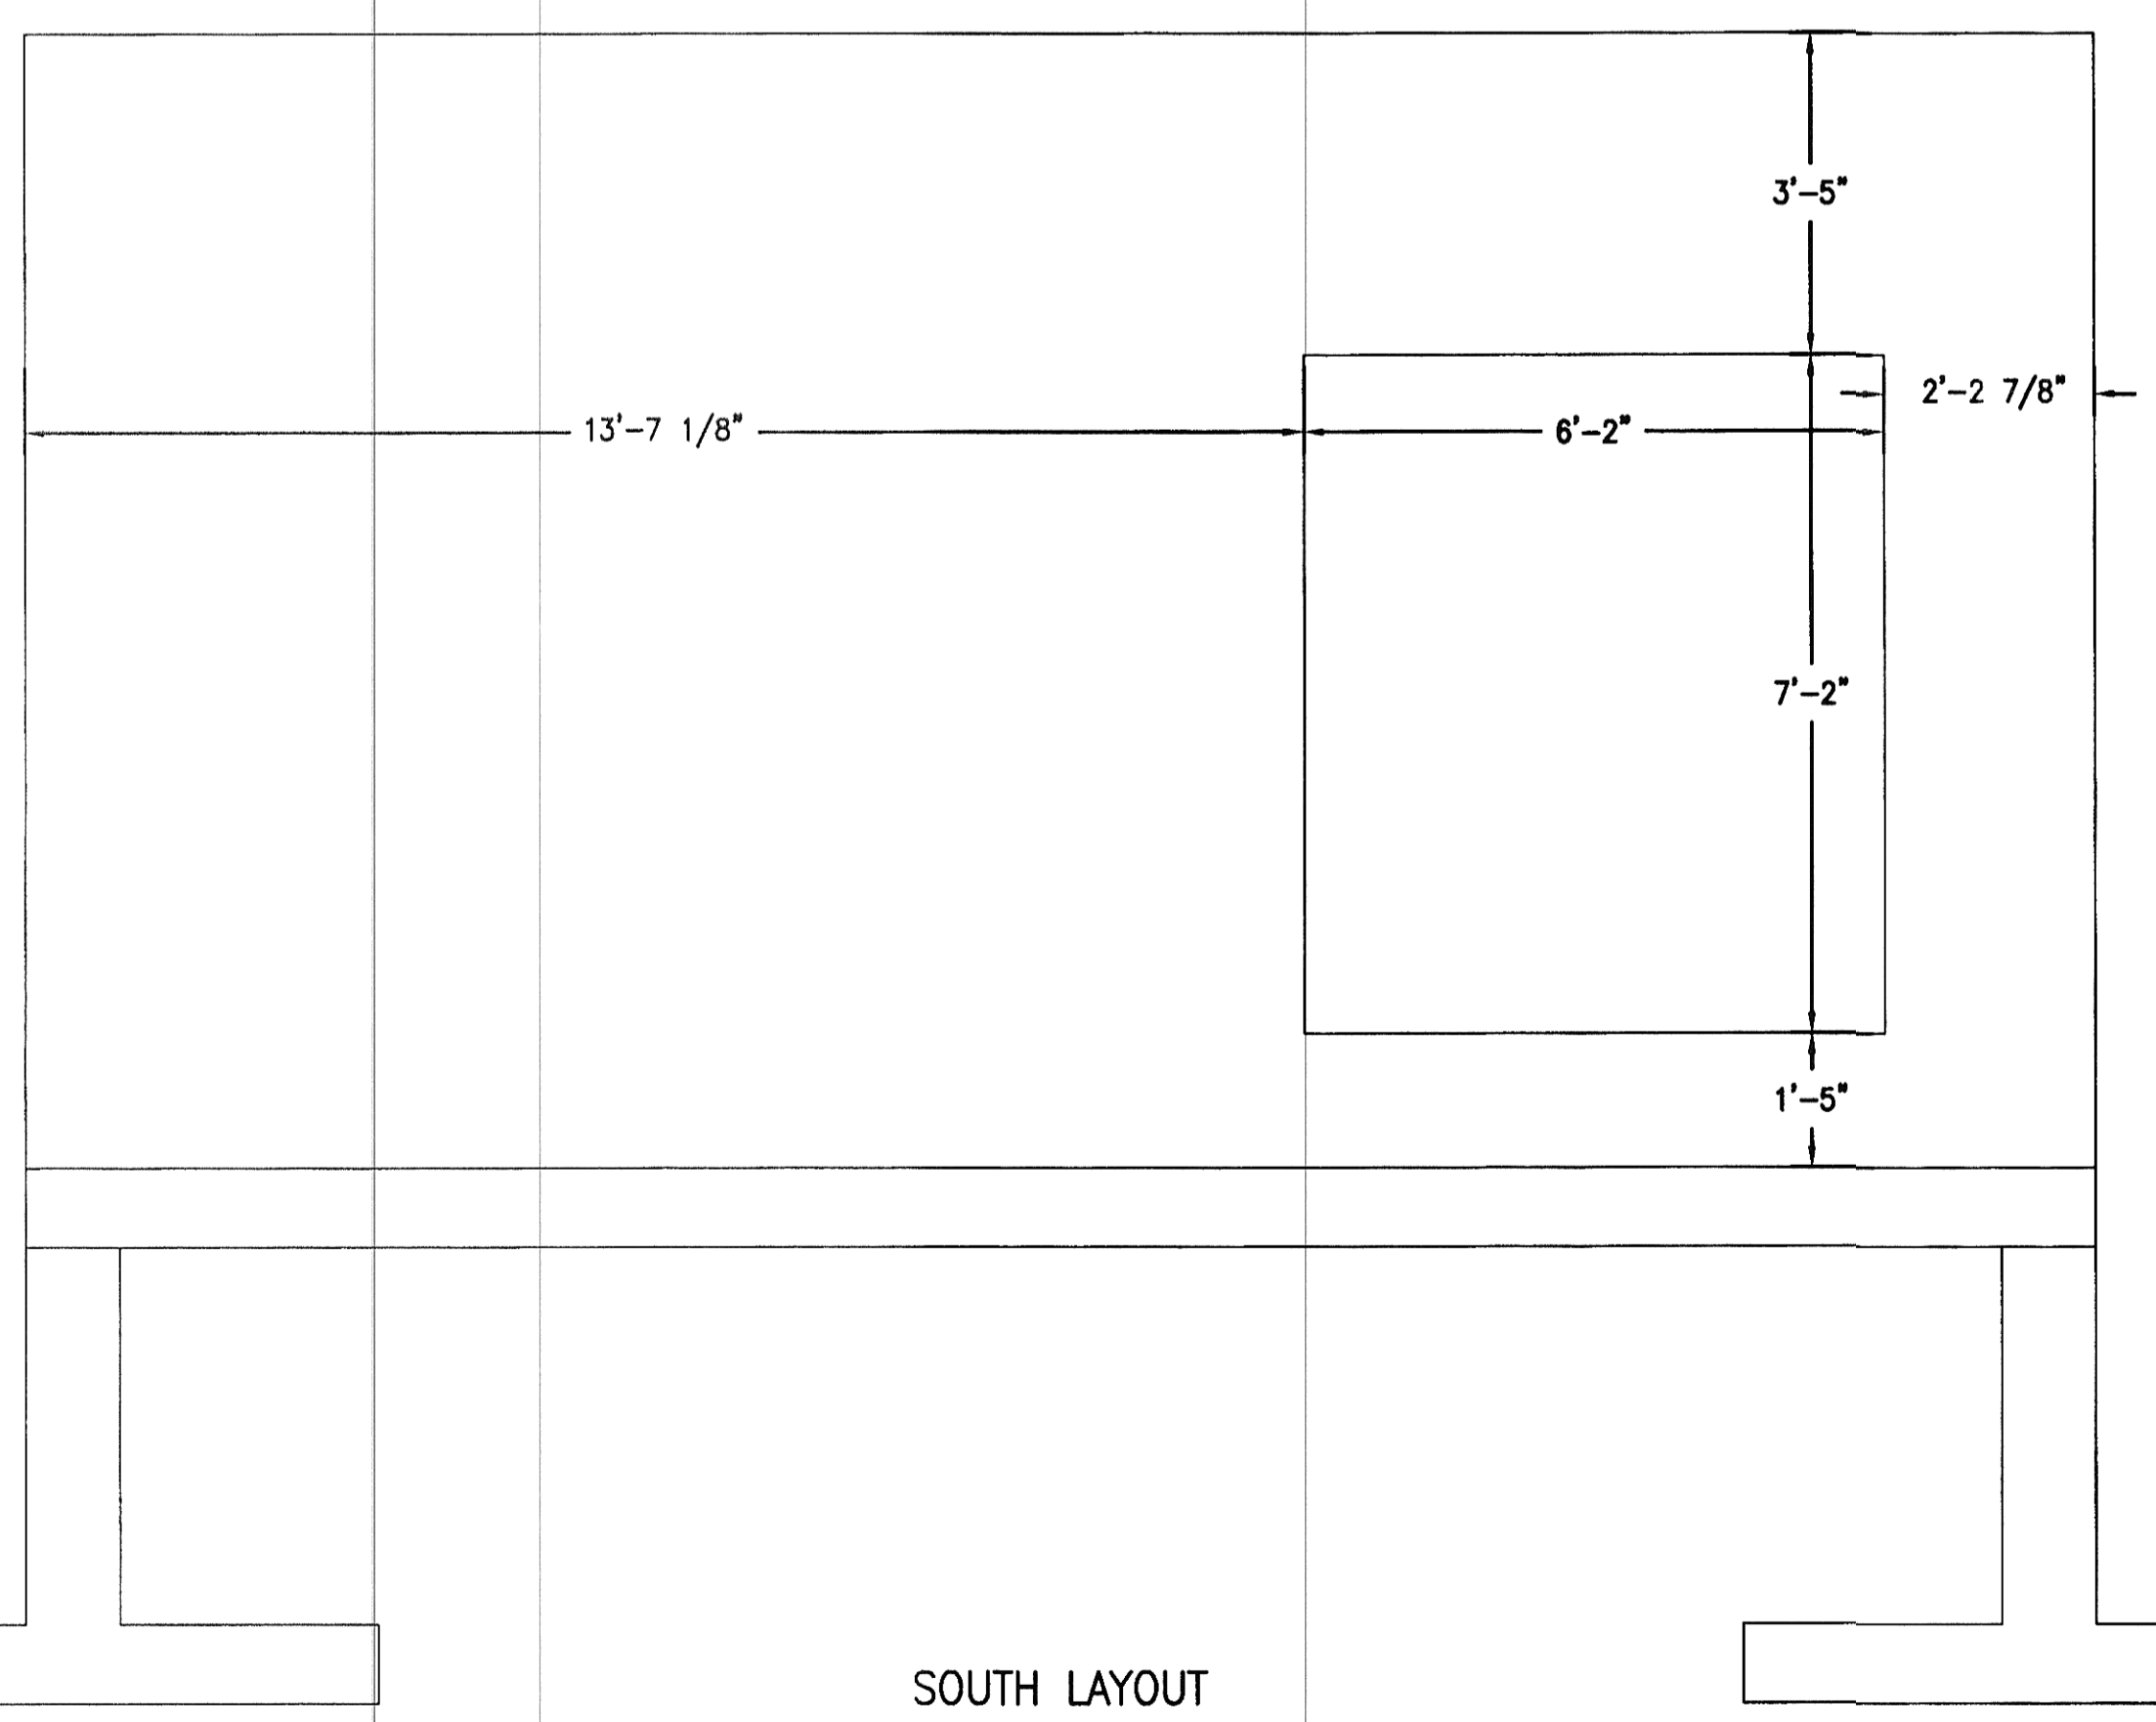

SOUTH LAYOUT

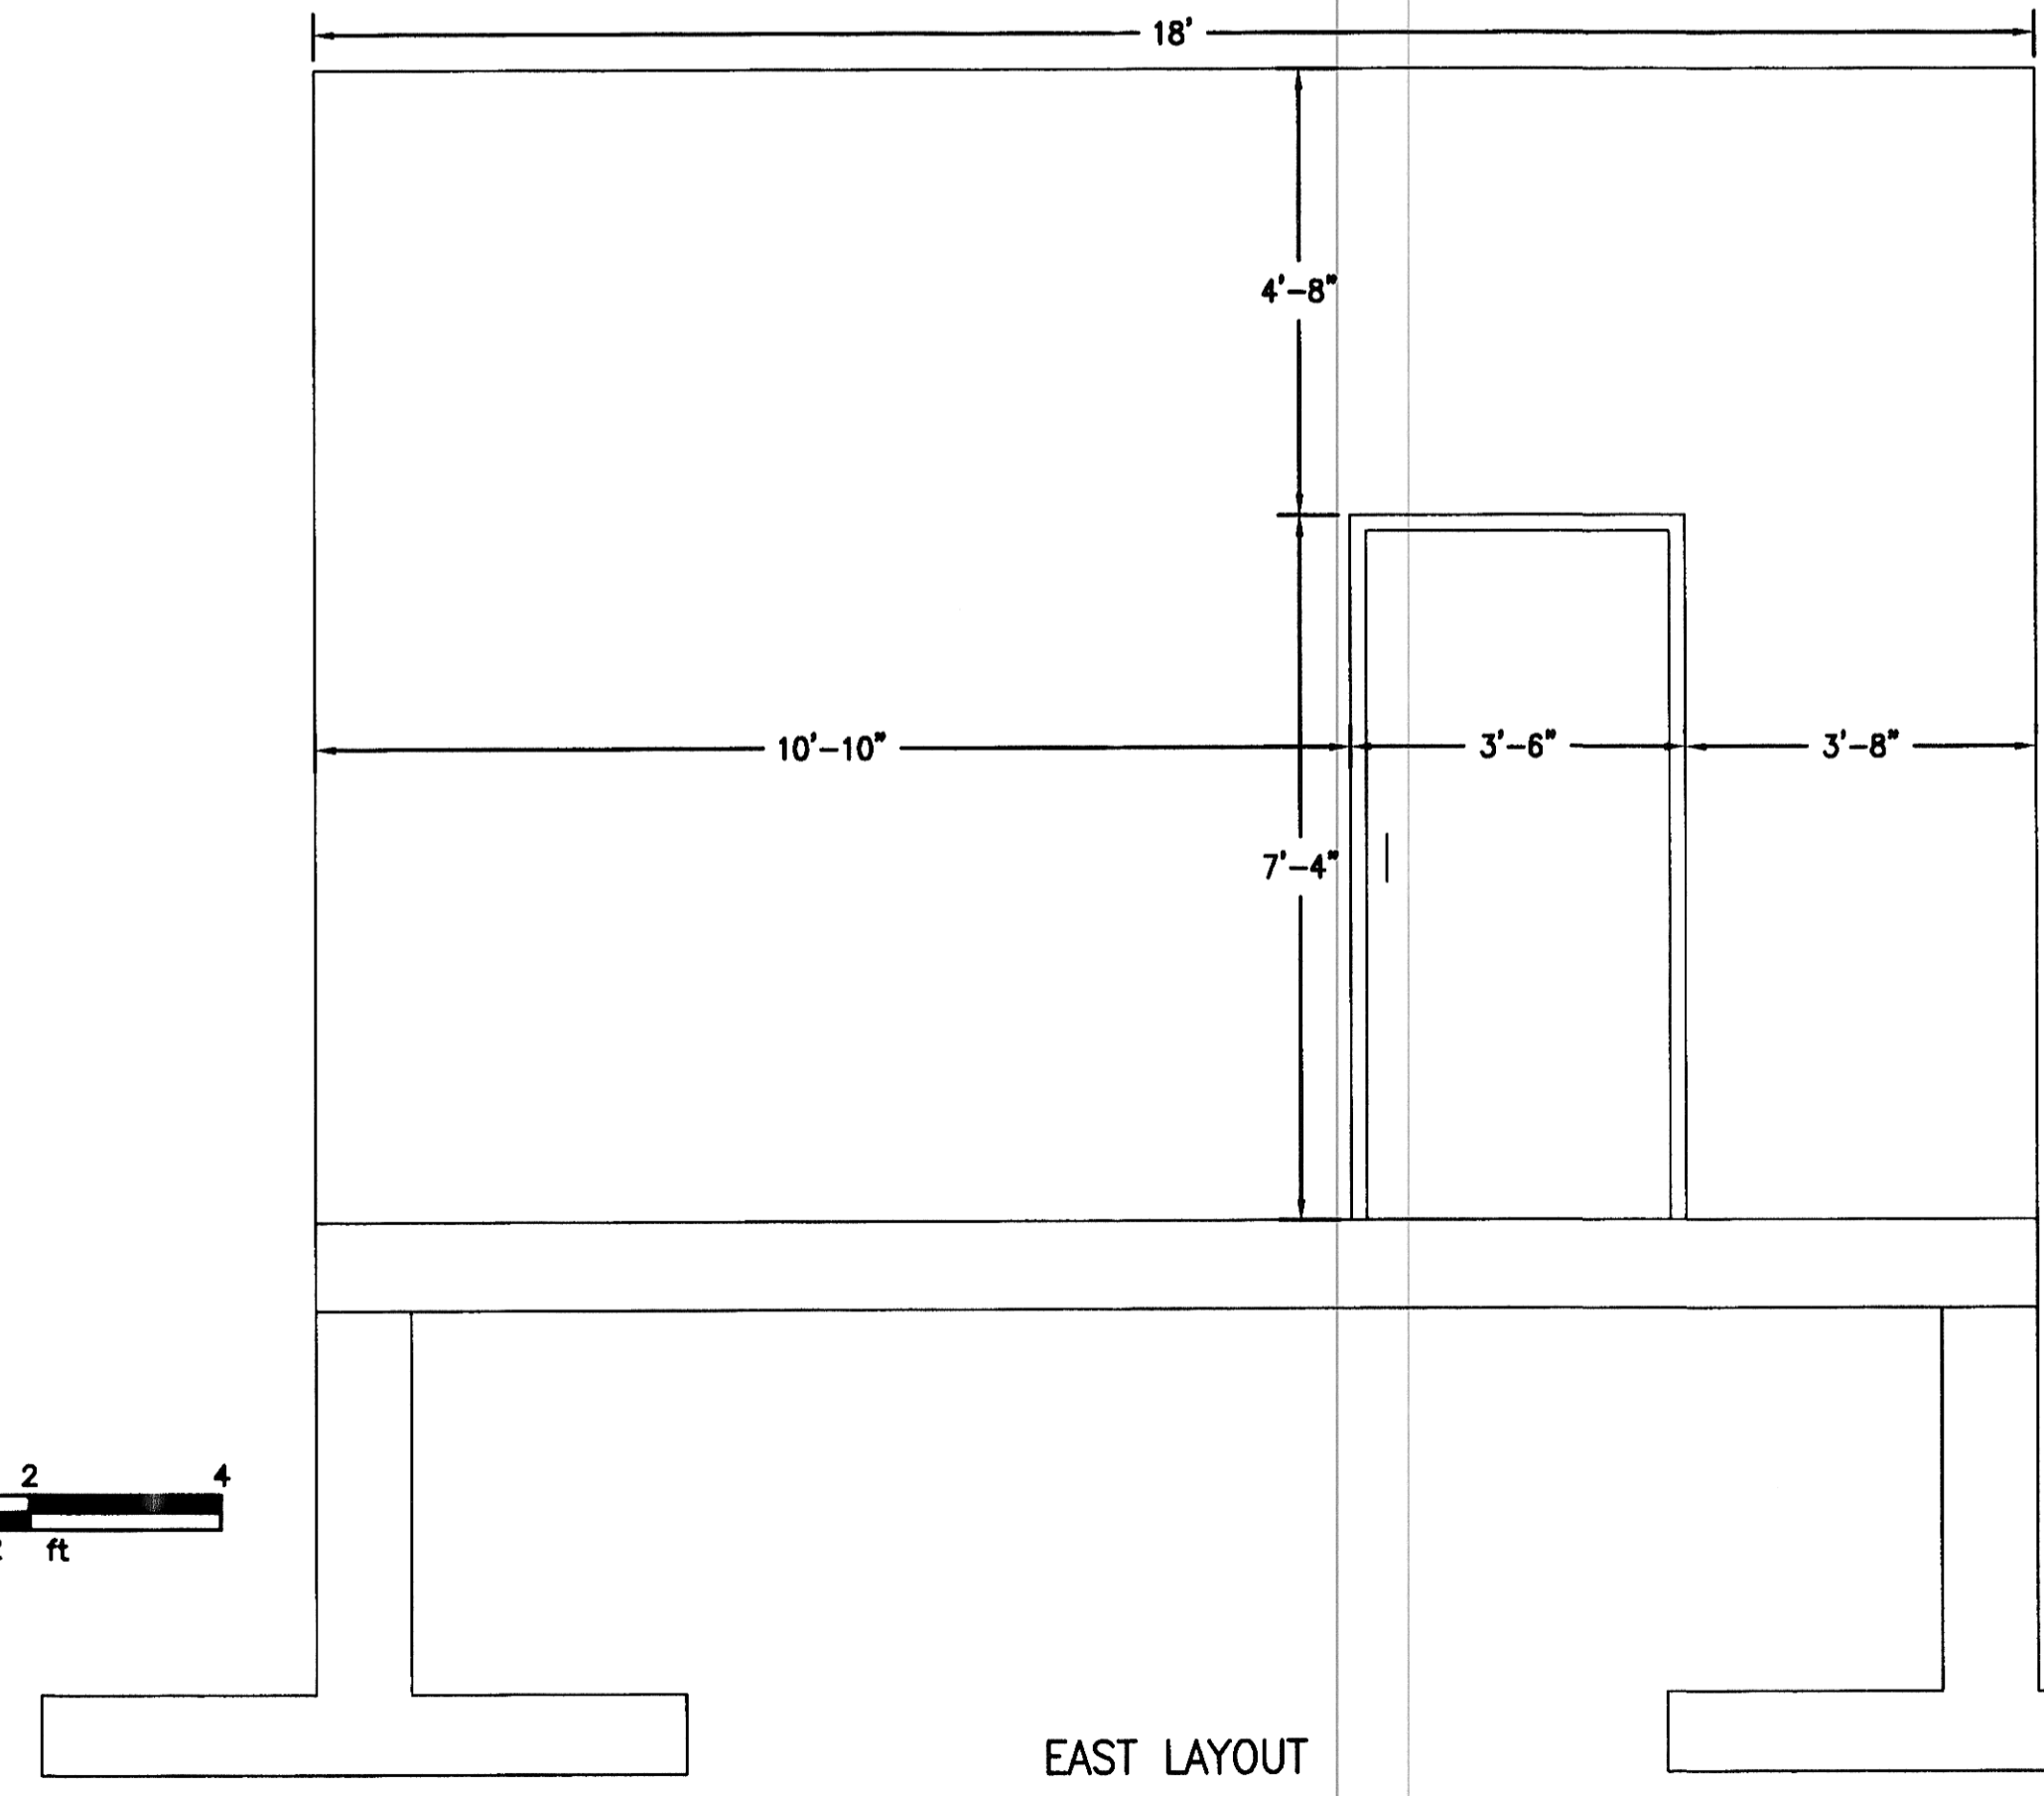

EAST LAYOUT

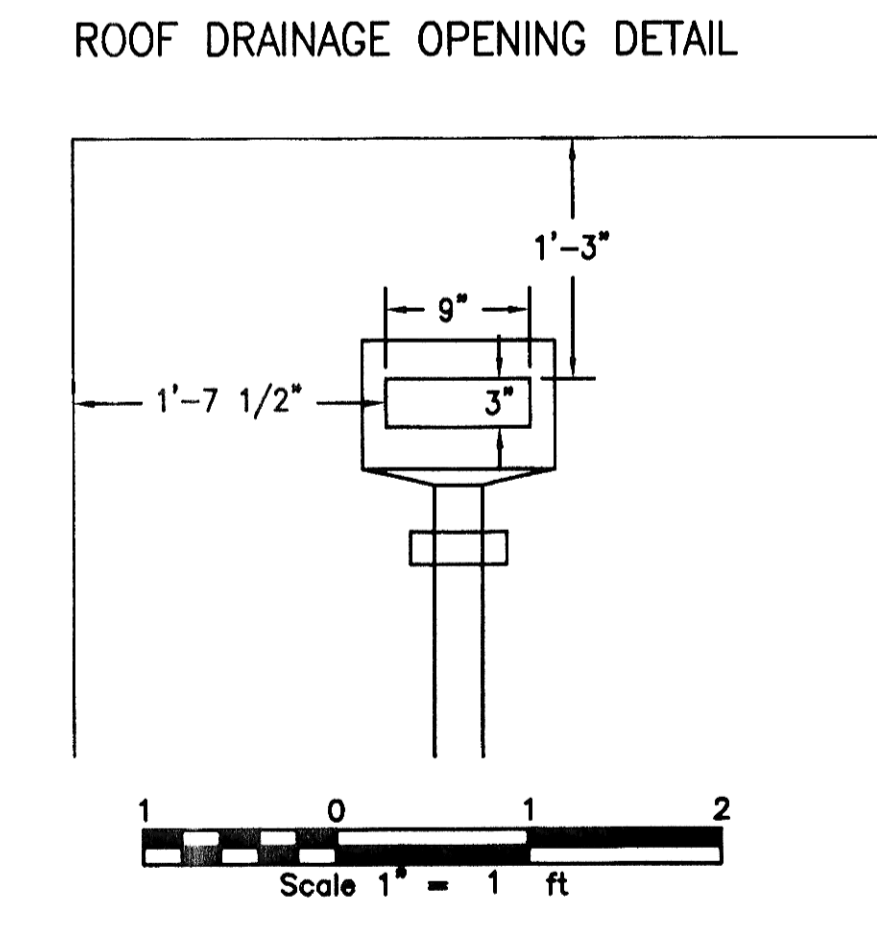

ROOF DRAINAGE OPENING DETAIL

