

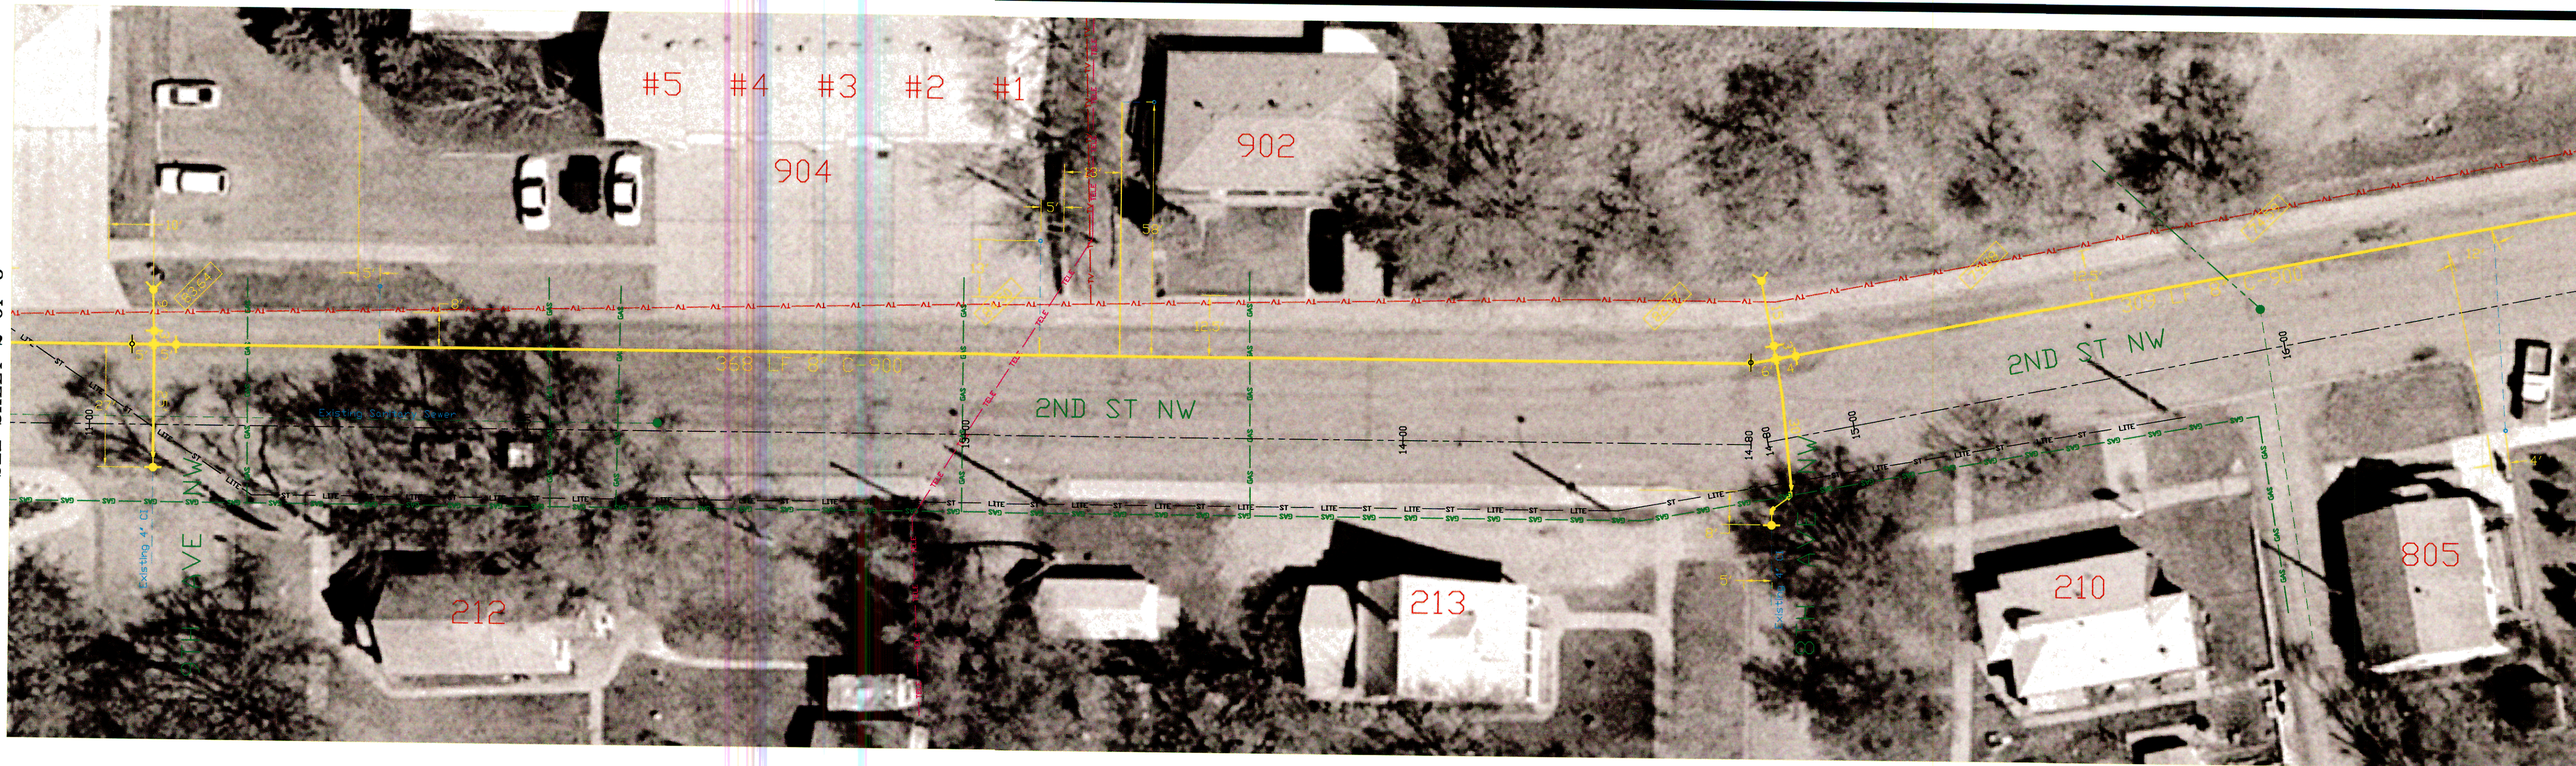


SEE SHEET 2 OF 8

SEE SHEET 5 OF 8

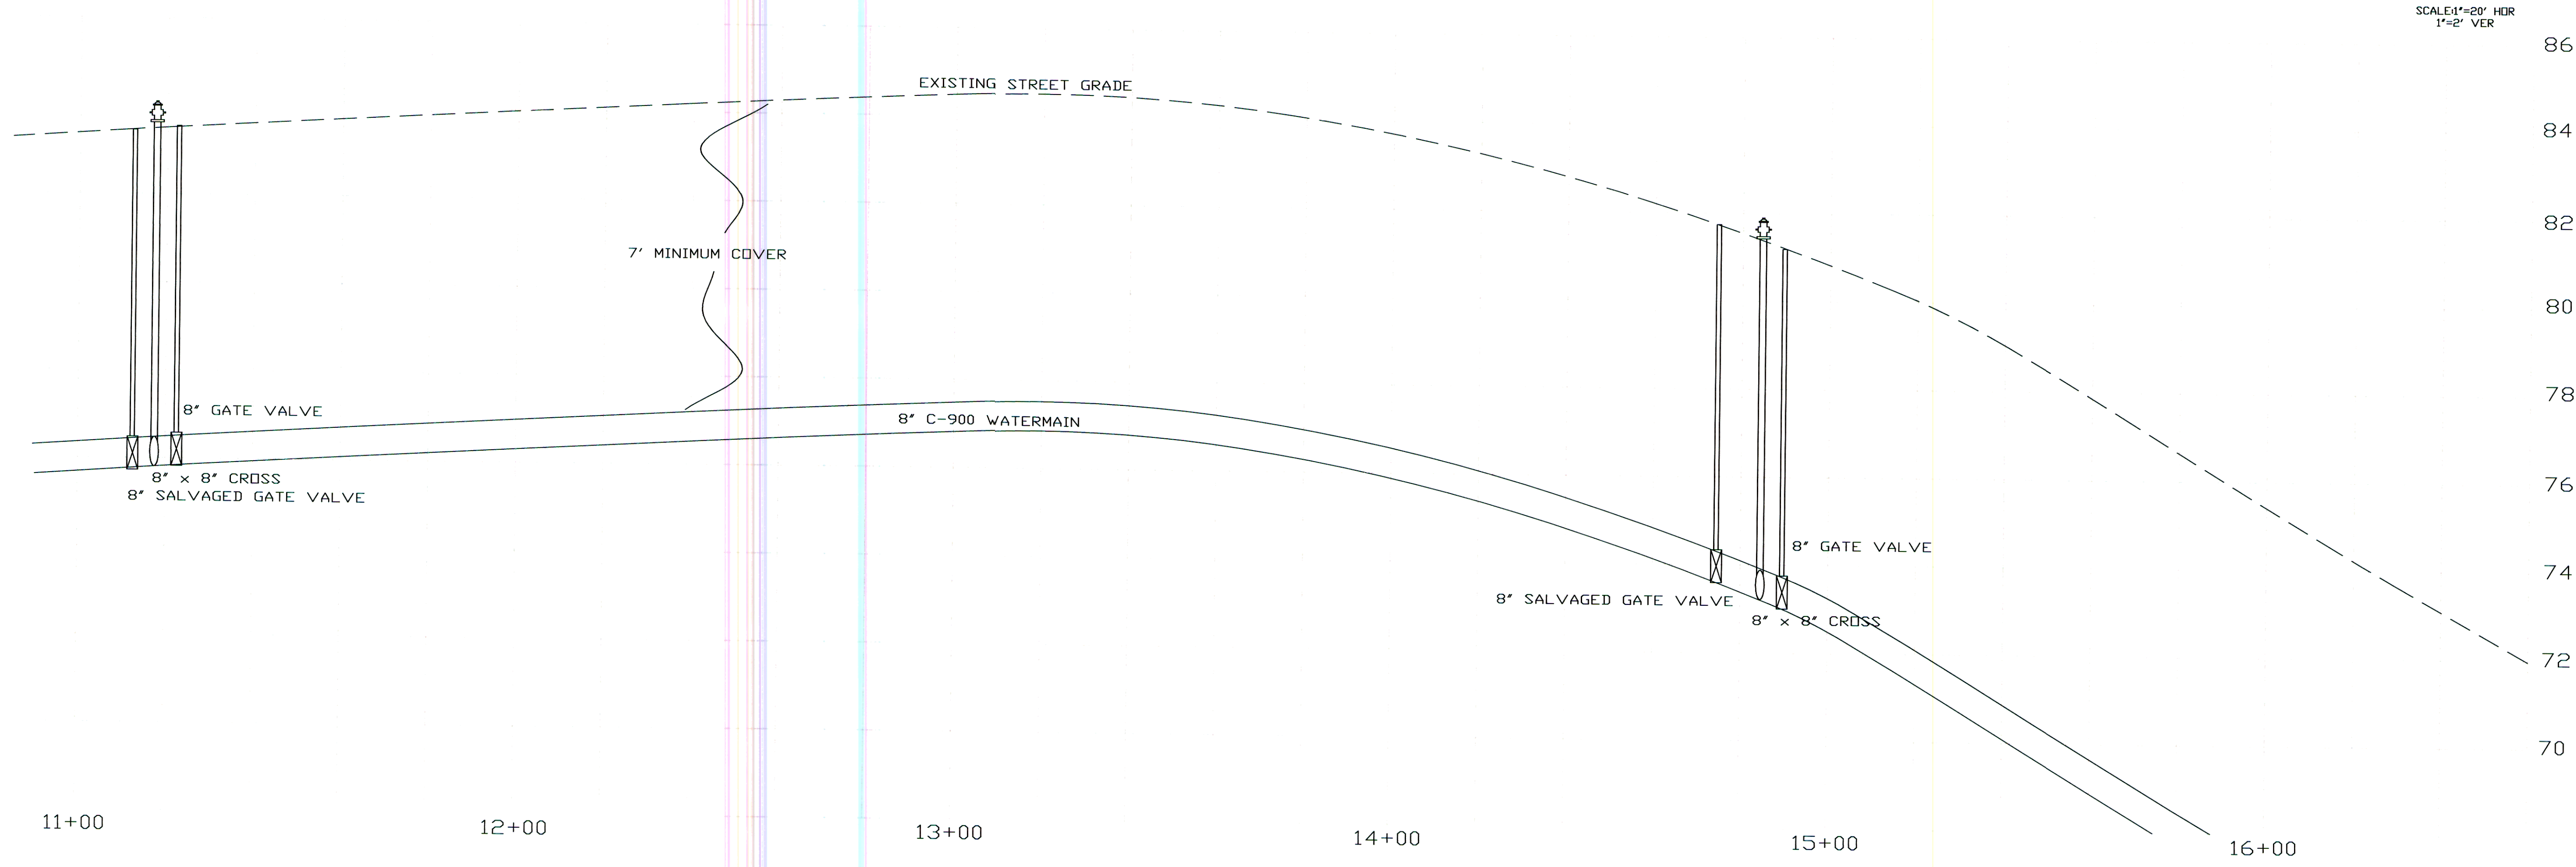

--- Warning --- All utilities are to be located before digging.
Overhead utilities may be present.

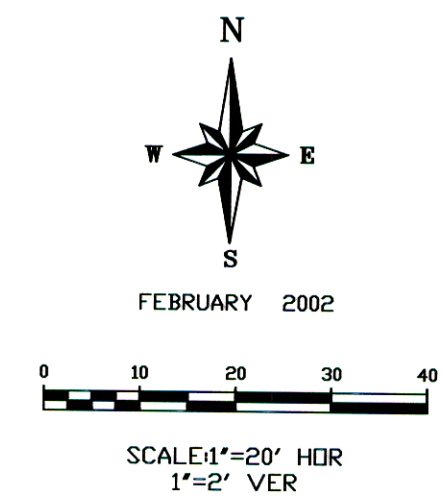

Description	Date	Drawn By	Checked By
Abuilt	10/02	jlw	jlw

City of Mandan
Watermain Replacement Project 2002-03
2ND ST NW - FROM 9TH AVE TO 7TH AVE

City Eng. T LITTLE	Drawn By: J L W
Approved By: T R L	Checked By: T R L
Project No. 2002-03	Date: 2/5/2002
District No. N/A	Scale: AS SHOWN