


--- Warning --- All utilities are to be located before digging.
Overhead utilities may be present.

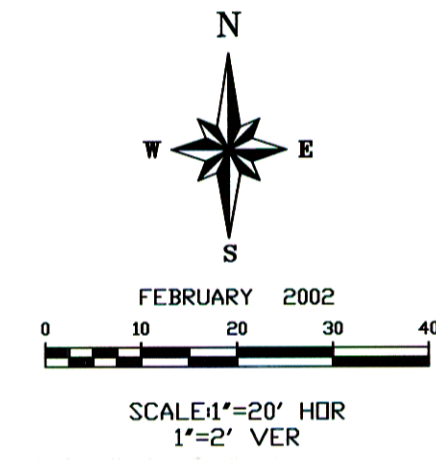

<i>City Eng. T LITTLE</i>	<i>Drawn By: J L W</i>	<i>Checked By: jlw</i>	<i>Checked By: jlw</i>
<i>Approved By: T R L</i>	<i>Checked By: T R L</i>	<i>Date: 10/02</i>	<i>Date: 10/02</i>
<i>Project No. 2002-03</i>	<i>Date: 2/5/2002</i>	<i>Description: Asbuilt</i>	
<i>District No. N/A</i>	<i>Scale: AS SHOWN</i>		

City of Mandan

Watermain Replacement Project 2002-03
3RD ST NW - FROM 9TH AVE EAST TO CUL-DE-SAC