

Project For

CITY OF MANDAN NORTH DAKOTA

PROJECT NO. 83-11

MANDAN INTERCEPTOR 1983


E.P.A. PROJECT NO. C380647-03

PHASE II


Engineering By

ULTEIG ENGINEERS INC.

Bismarek - Fargo

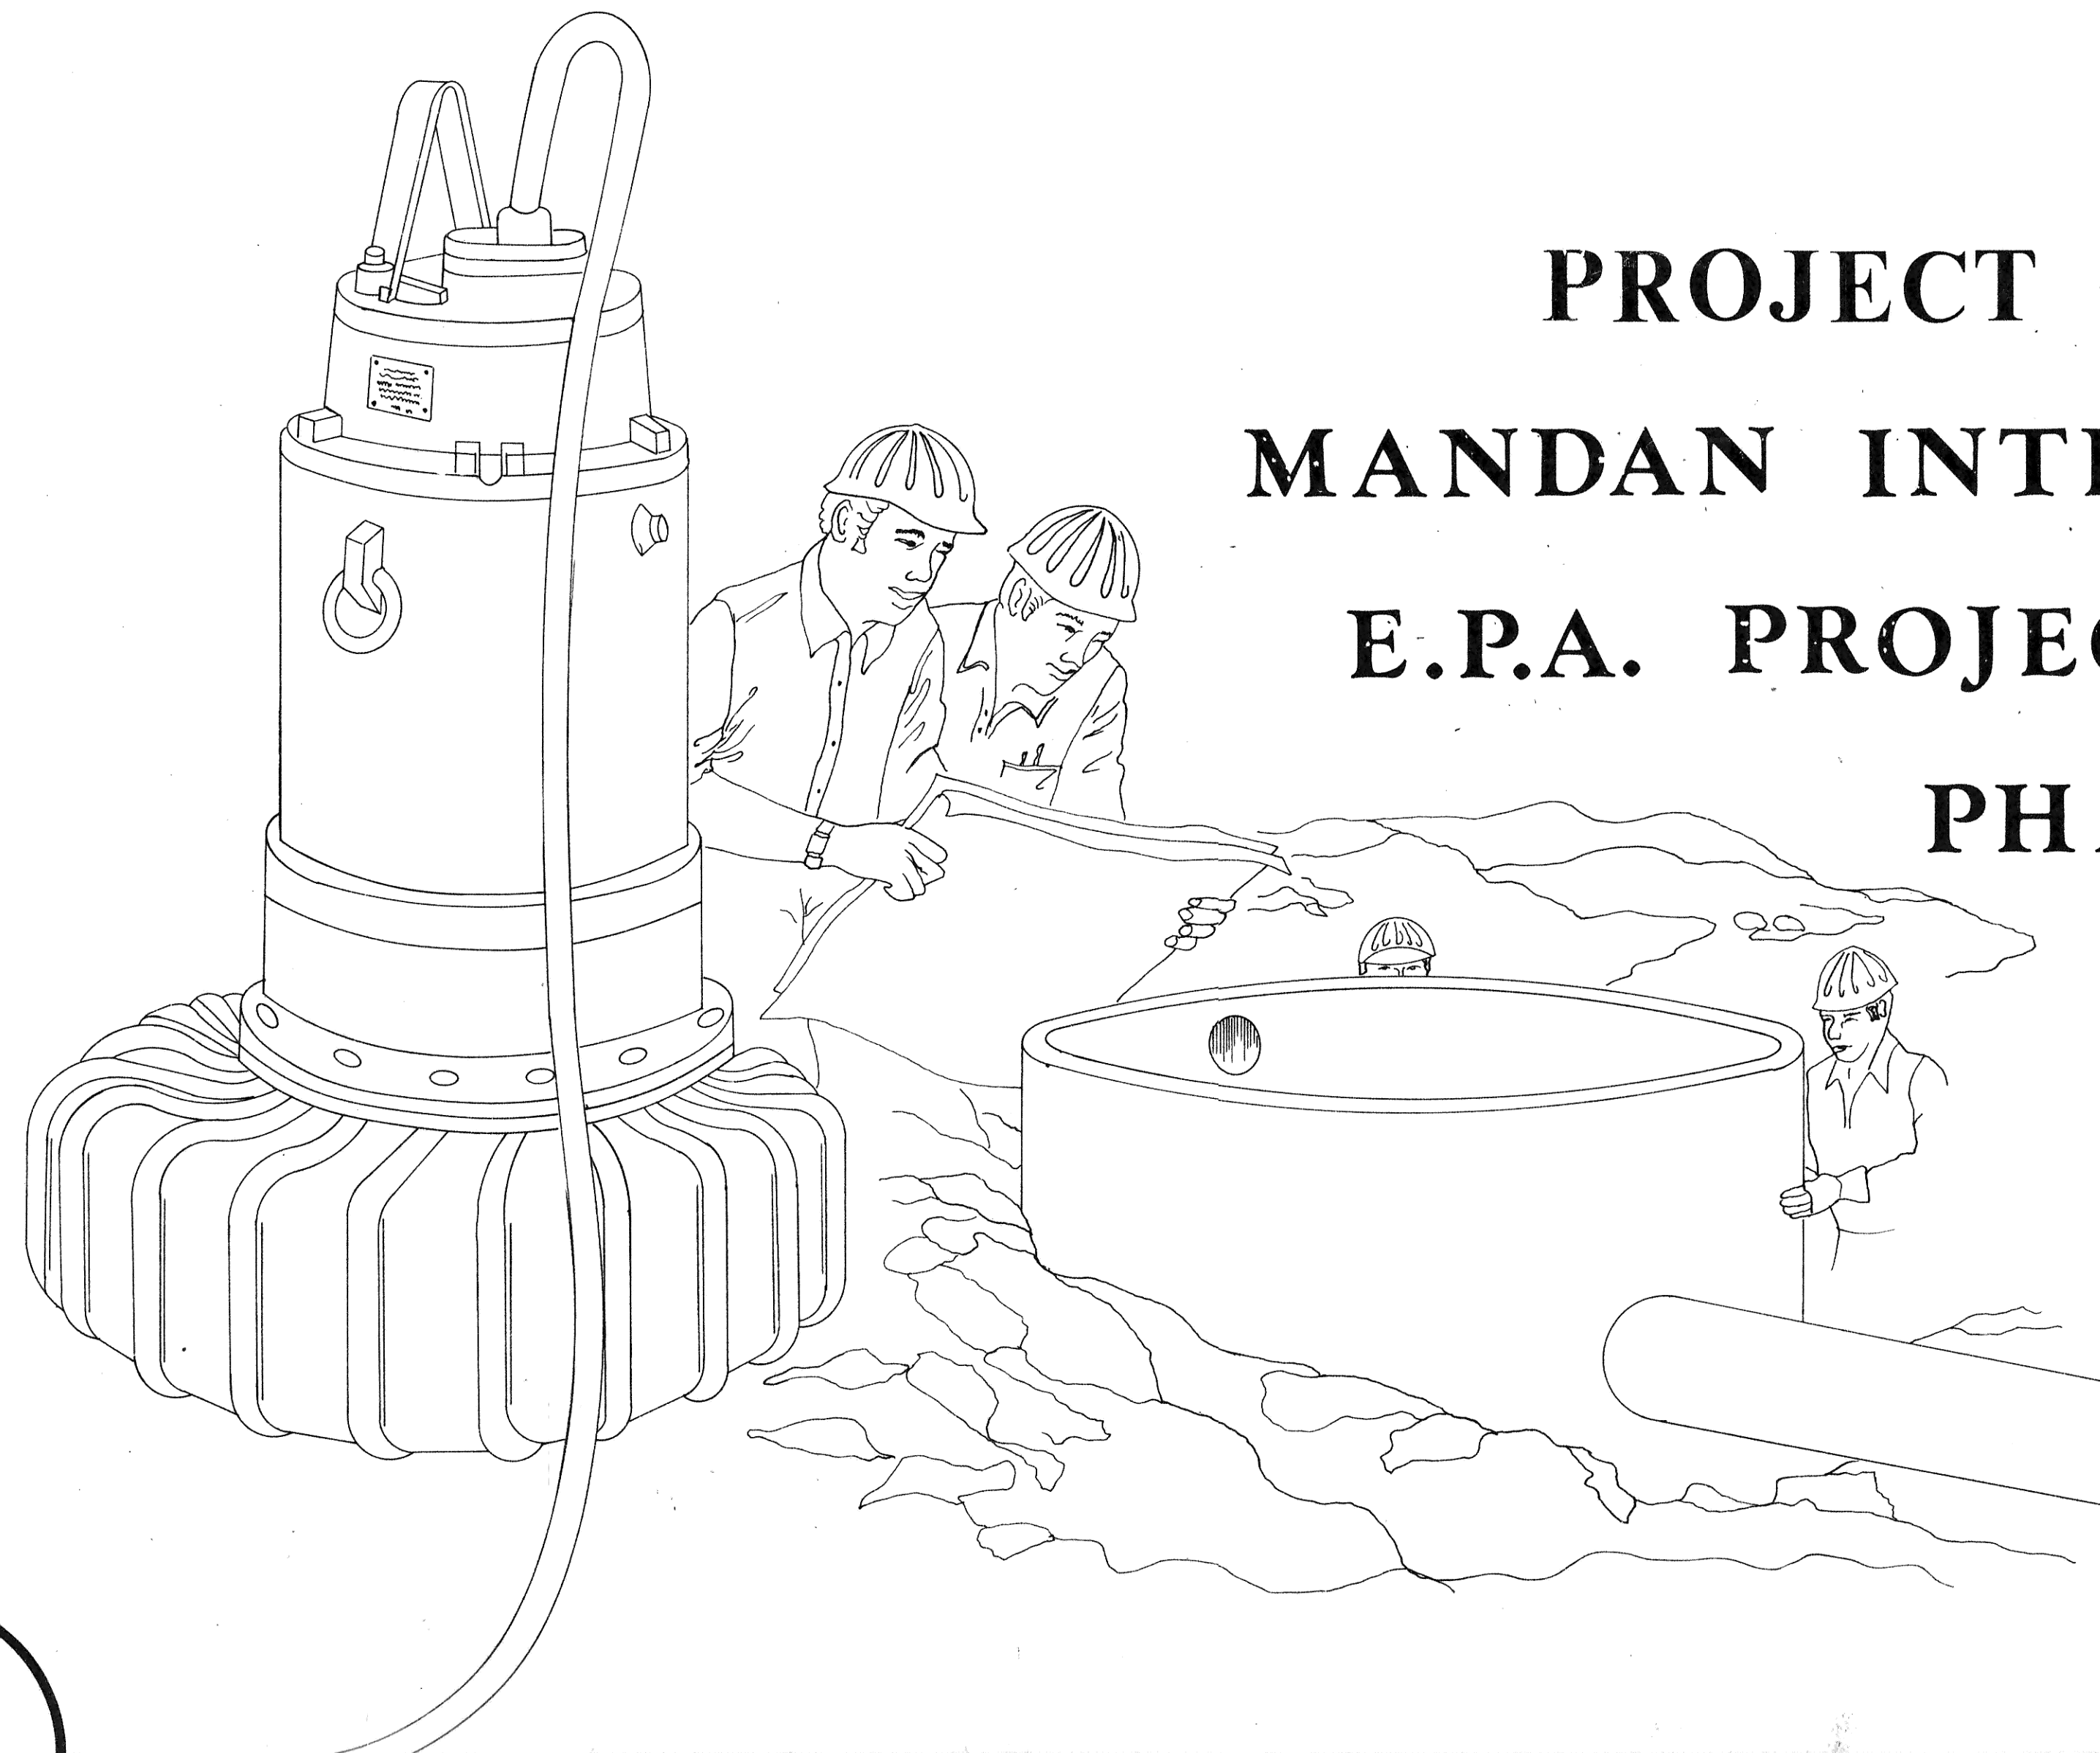

Record Drawing

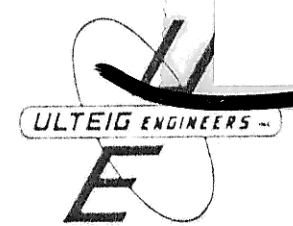

8