

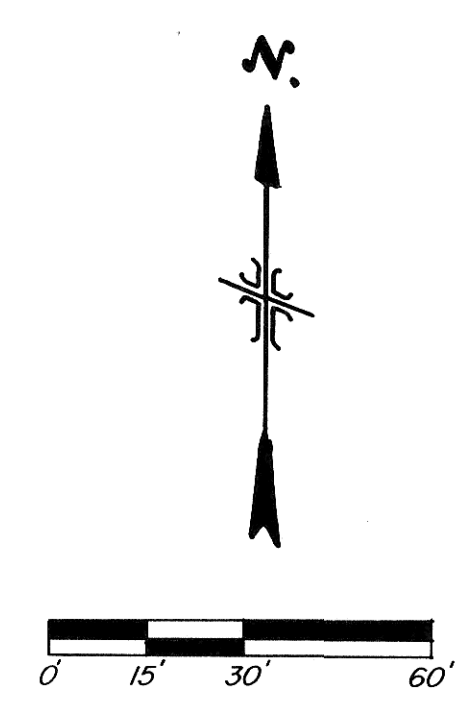


NOTE: Contractor to field verify location of all underground utilities prior to construction.

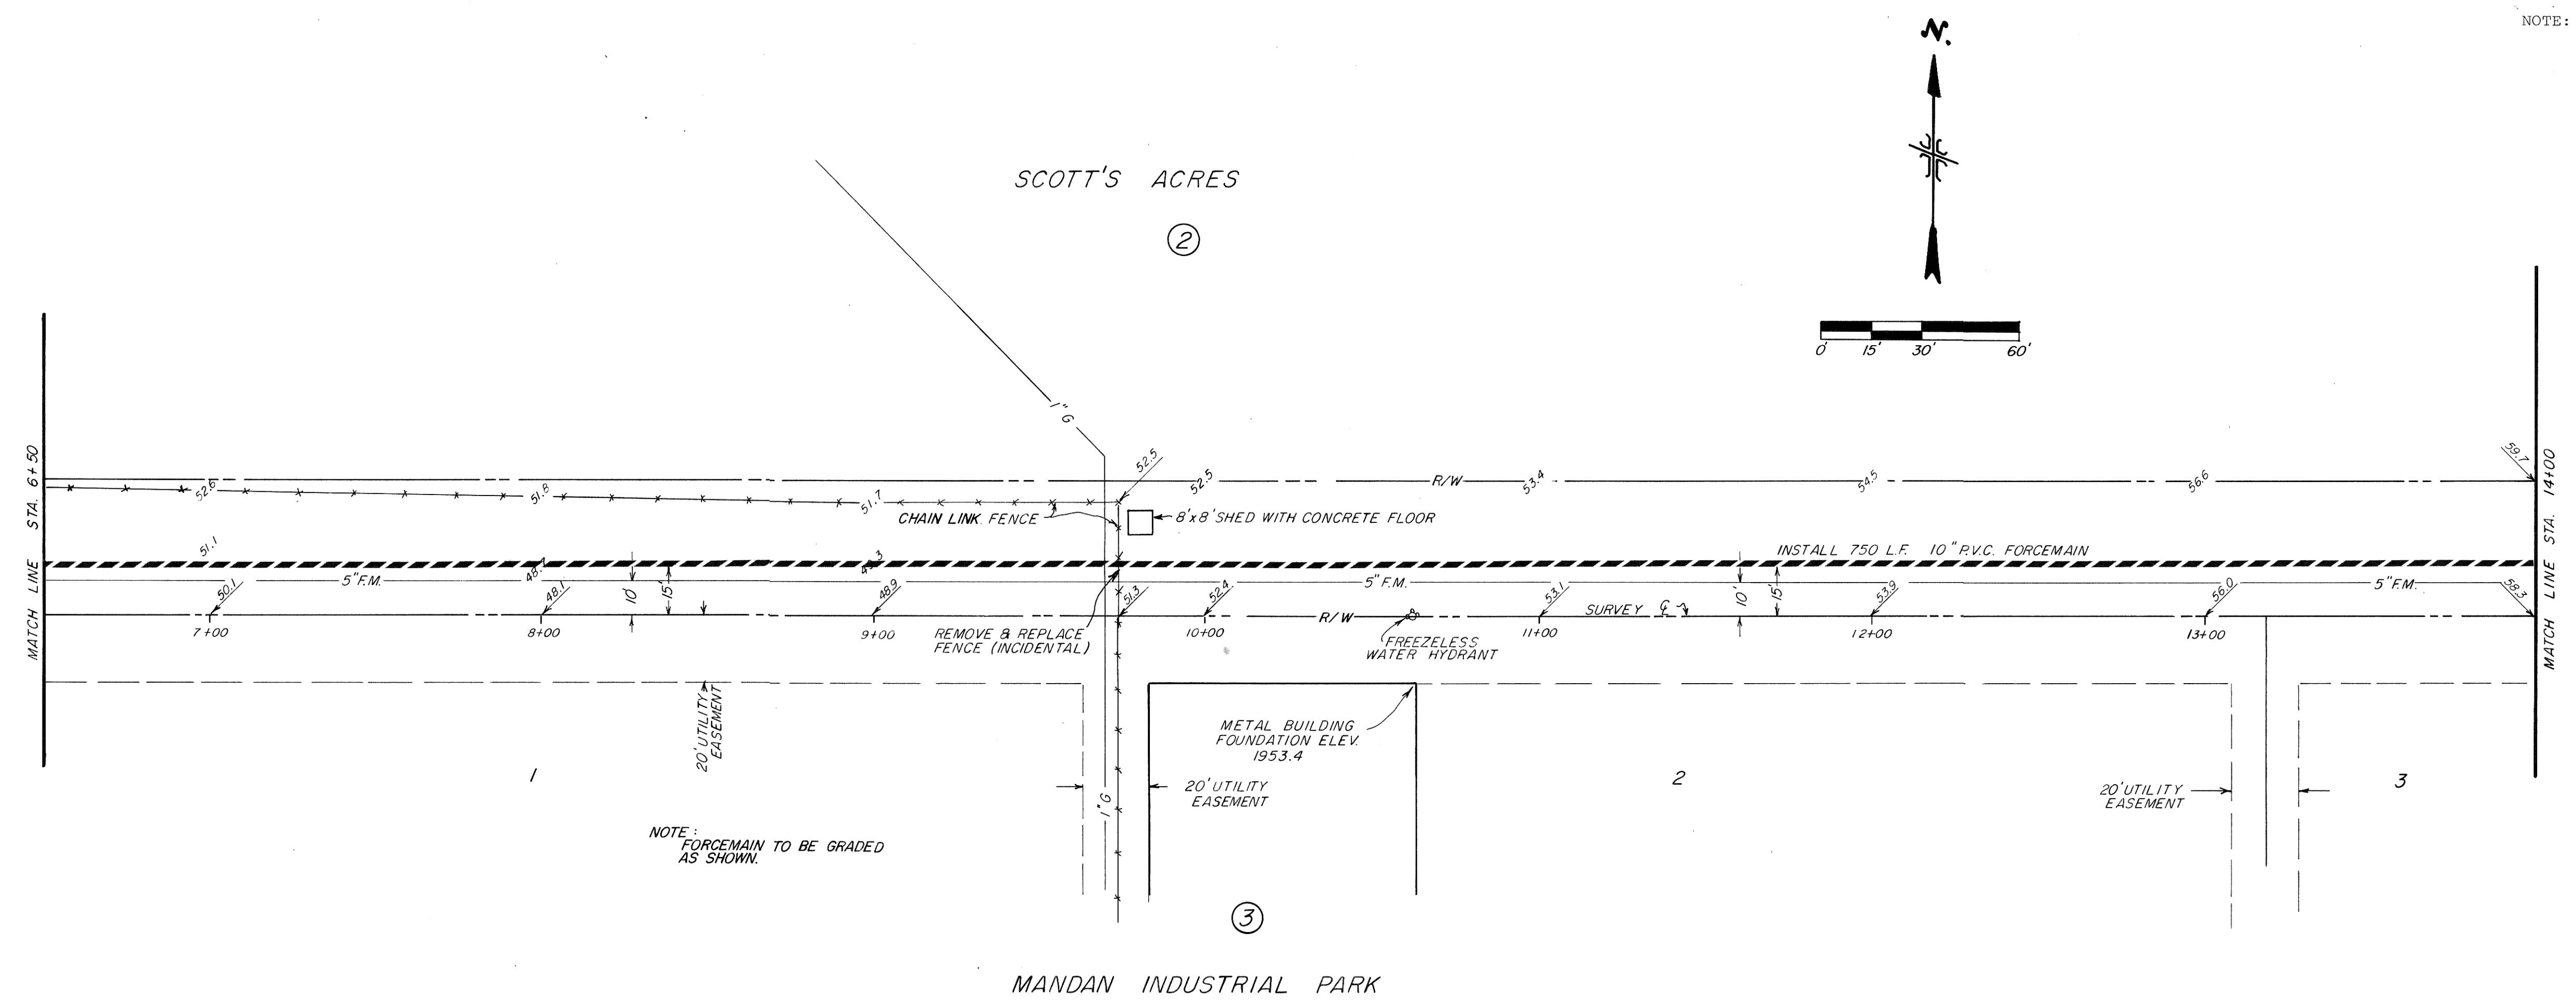

SUMMARY OF QUANTITIES	
10" P.V.C. FORCEMAIN	750 L.F.
SEEDING	0.5 AC.

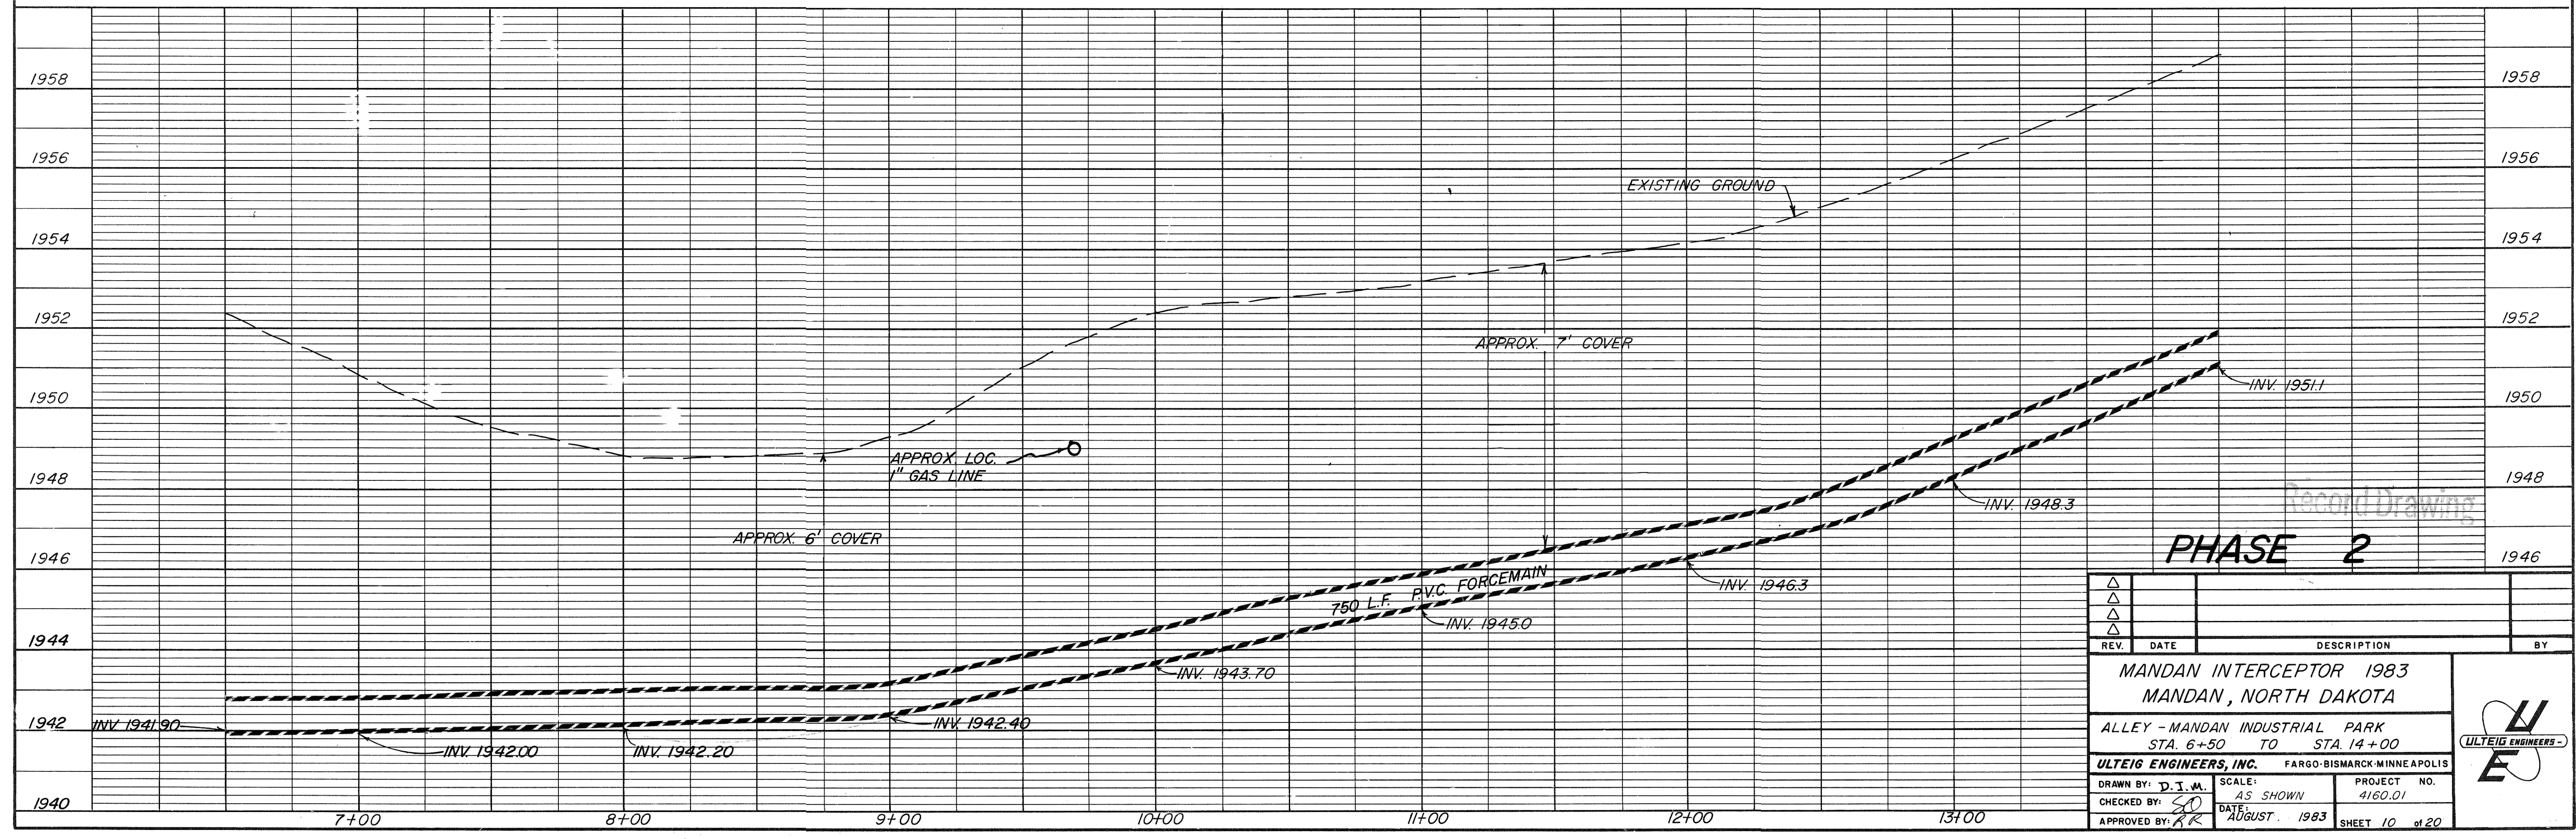

Record Drawing  
**PHASE 2**

REV.	DATE	DESCRIPTION	BY

MANDAN INTERCEPTOR 1983	
MANDAN, NORTH DAKOTA	
ALLEY - MANDAN INDUSTRIAL PARK	
STA. 6+50 TO STA. 14+00	
ULTEIG ENGINEERS, INC.	FARGO-BISMARCK-MINNEAPOLIS
DRAWN BY: D.I.M.	SCALE: AS SHOWN
CHECKED BY: SO	PROJECT NO. 4160.01
APPROVED BY: RR	DATE: AUGUST, 1983
	SHEET 10 of 20