

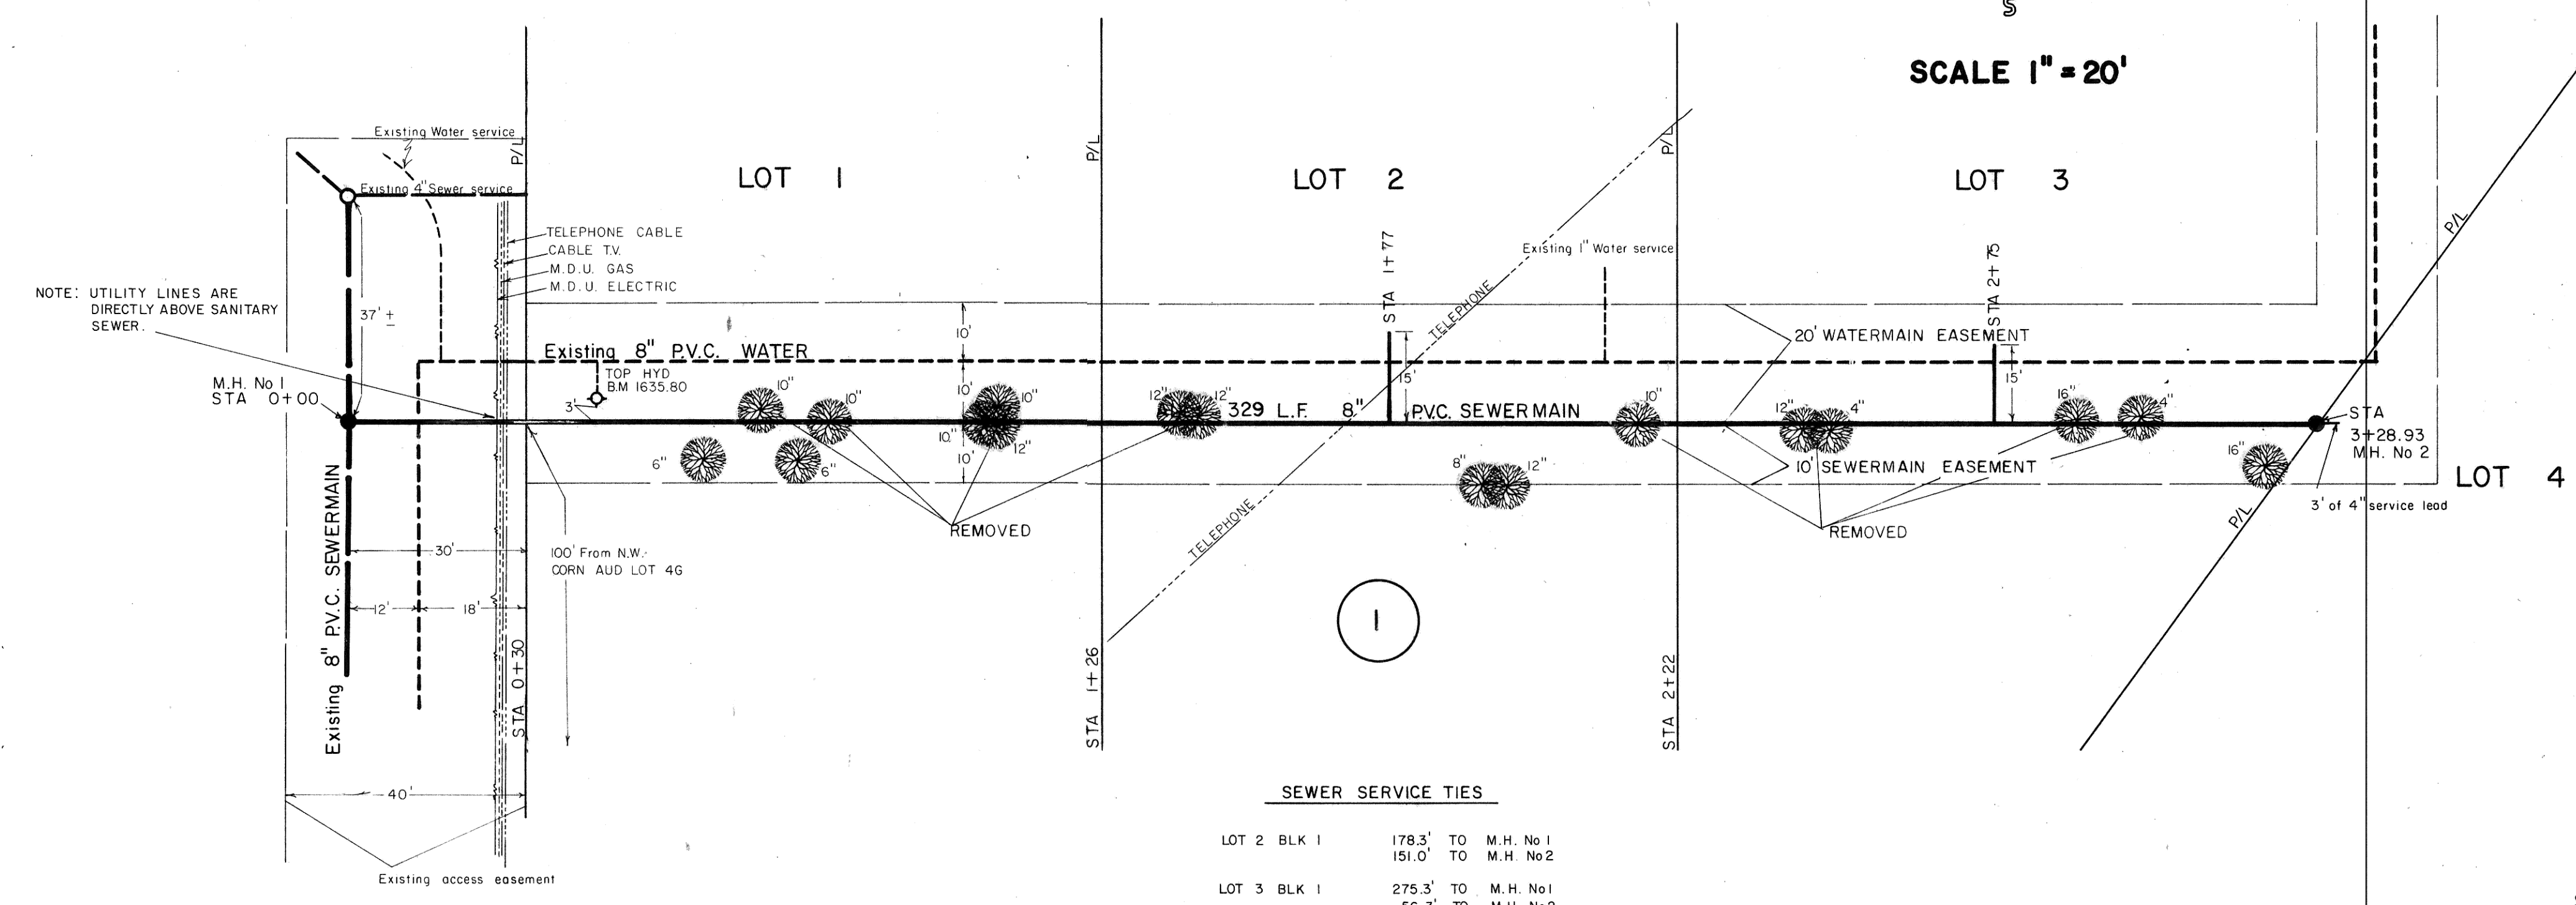


SCALE 1" = 20'

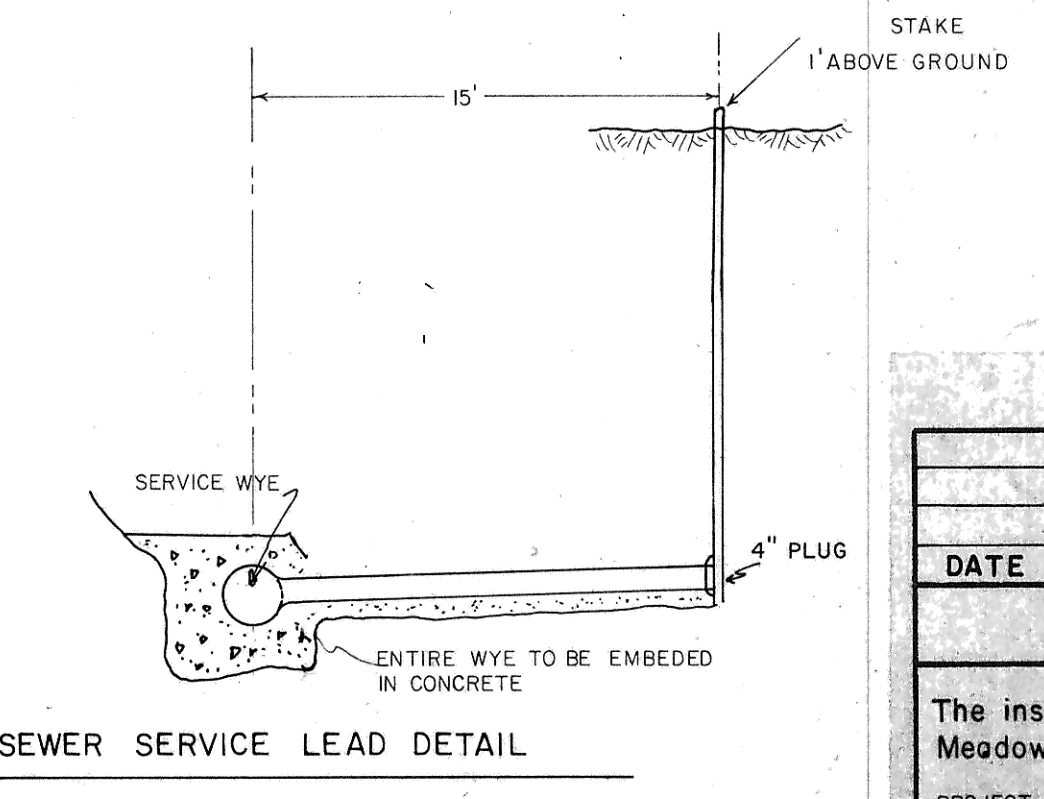

SEWER SERVICE TIES

LOT 2 BLK 1	178.3' TO M.H. No 1 151.0' TO M.H. No 2
LOT 3 BLK 1	275.3' TO M.H. No 1 56.3' TO M.H. No 2
LOT 4 BLK 1	3' DUE EAST M.H. No 2

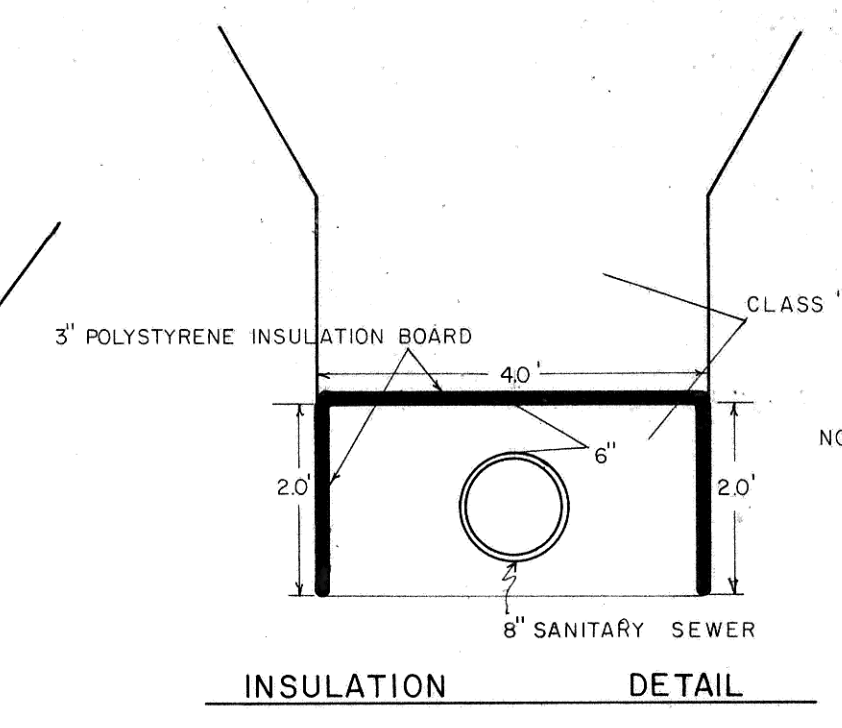


DATE	REV. BY	APPR. BY	DESCRIPTION
			CITY OF MANDAN, NORTH DAKOTA ENGINEERING DEPARTMENT

The installation of a sanitary sewer to serve Missouri Meadows Second Addition.

PROJECT FINALED 10-4-88			
CITY ENGR. THOMAS LITTLE	DRAWN BY BILL BEMENT	SCALE: 1" = 20'	
APPROVED BY THOMAS LITTLE	CHECKED BY	DATE: AUGUST 1988	
PROJECT NO. 88-11	DISTRICT NO. 19	SHEET 2 OF 2	

Sandy Lane

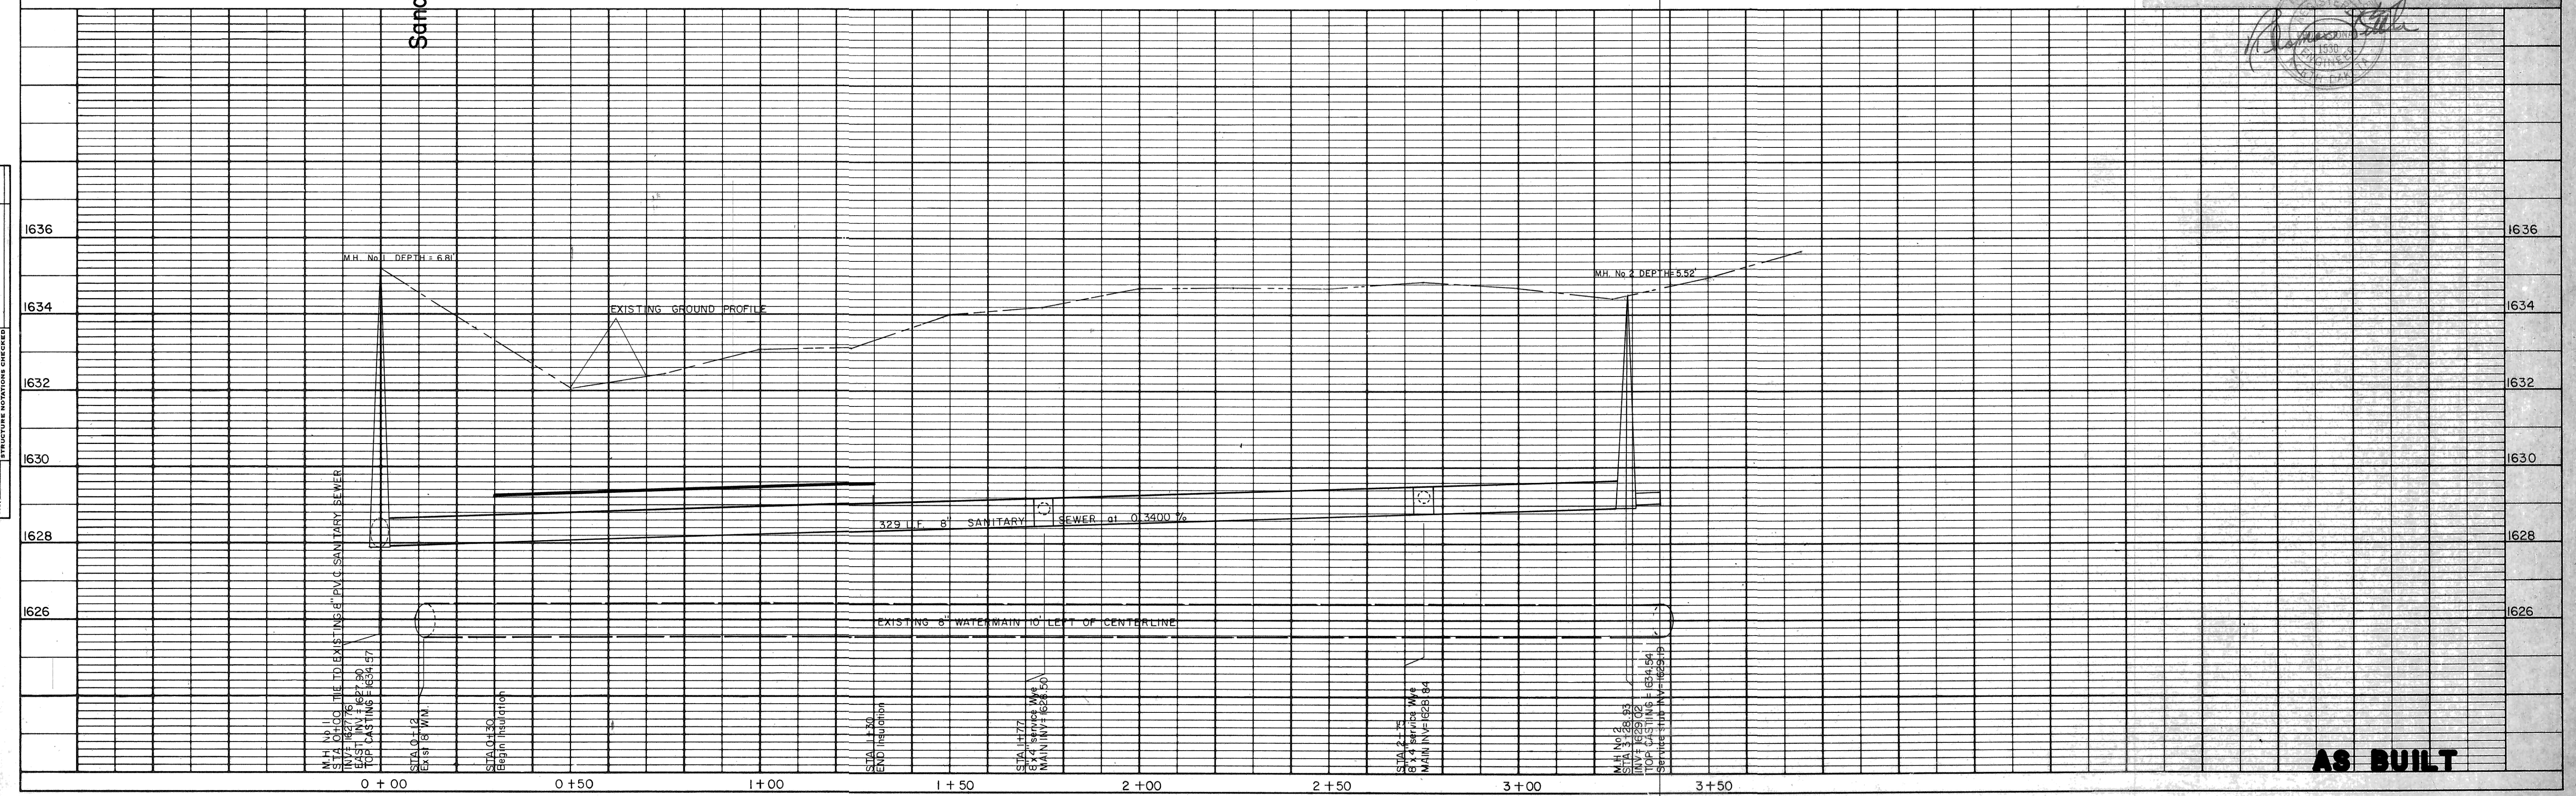

AS BUILT