


SEE 2 FOR CONNECTION DETAIL

SEE 3 FOR CLEANOUT DETAILS

NOTES  
1. ADD 1600 TO ELEVATIONS SHOWN

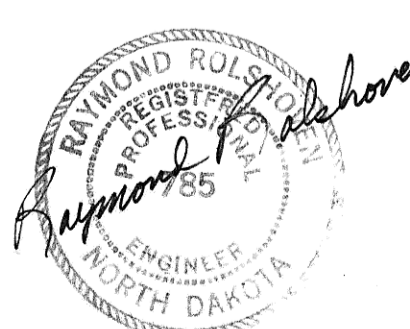

REV.	DATE	DESCRIPTION	BY

<b>SITE PLANS</b> <b>BLOWER AND SWITCHGEAR BUILDING</b> <b>AERATOR CONTROL BUILDING</b>			
<b>BLOWER AND SWITCHGEAR BUILDING</b> <b>MANDAN, NORTH DAKOTA</b>			
<b>ULTEIG ENGINEERS, INC.</b> CONSULTING ENGINEERS FARGO • BISMARCK • MINNEAPOLIS			
DRAWN BY: <i>awl</i>	SCALE: AS SHOWN		PROJECT NO. 88649
CHECKED BY: <i>RR</i>	DATE: NOV. 1988		SHEET C-1 of