


AS-BUILT WATER & SEWER IMPROVEMENT BORDEN HARBOR DR & HARBOR TRAIL SE MANDAN, NORTH DAKOTA

CITY PROJECT NUMBER: 97-10

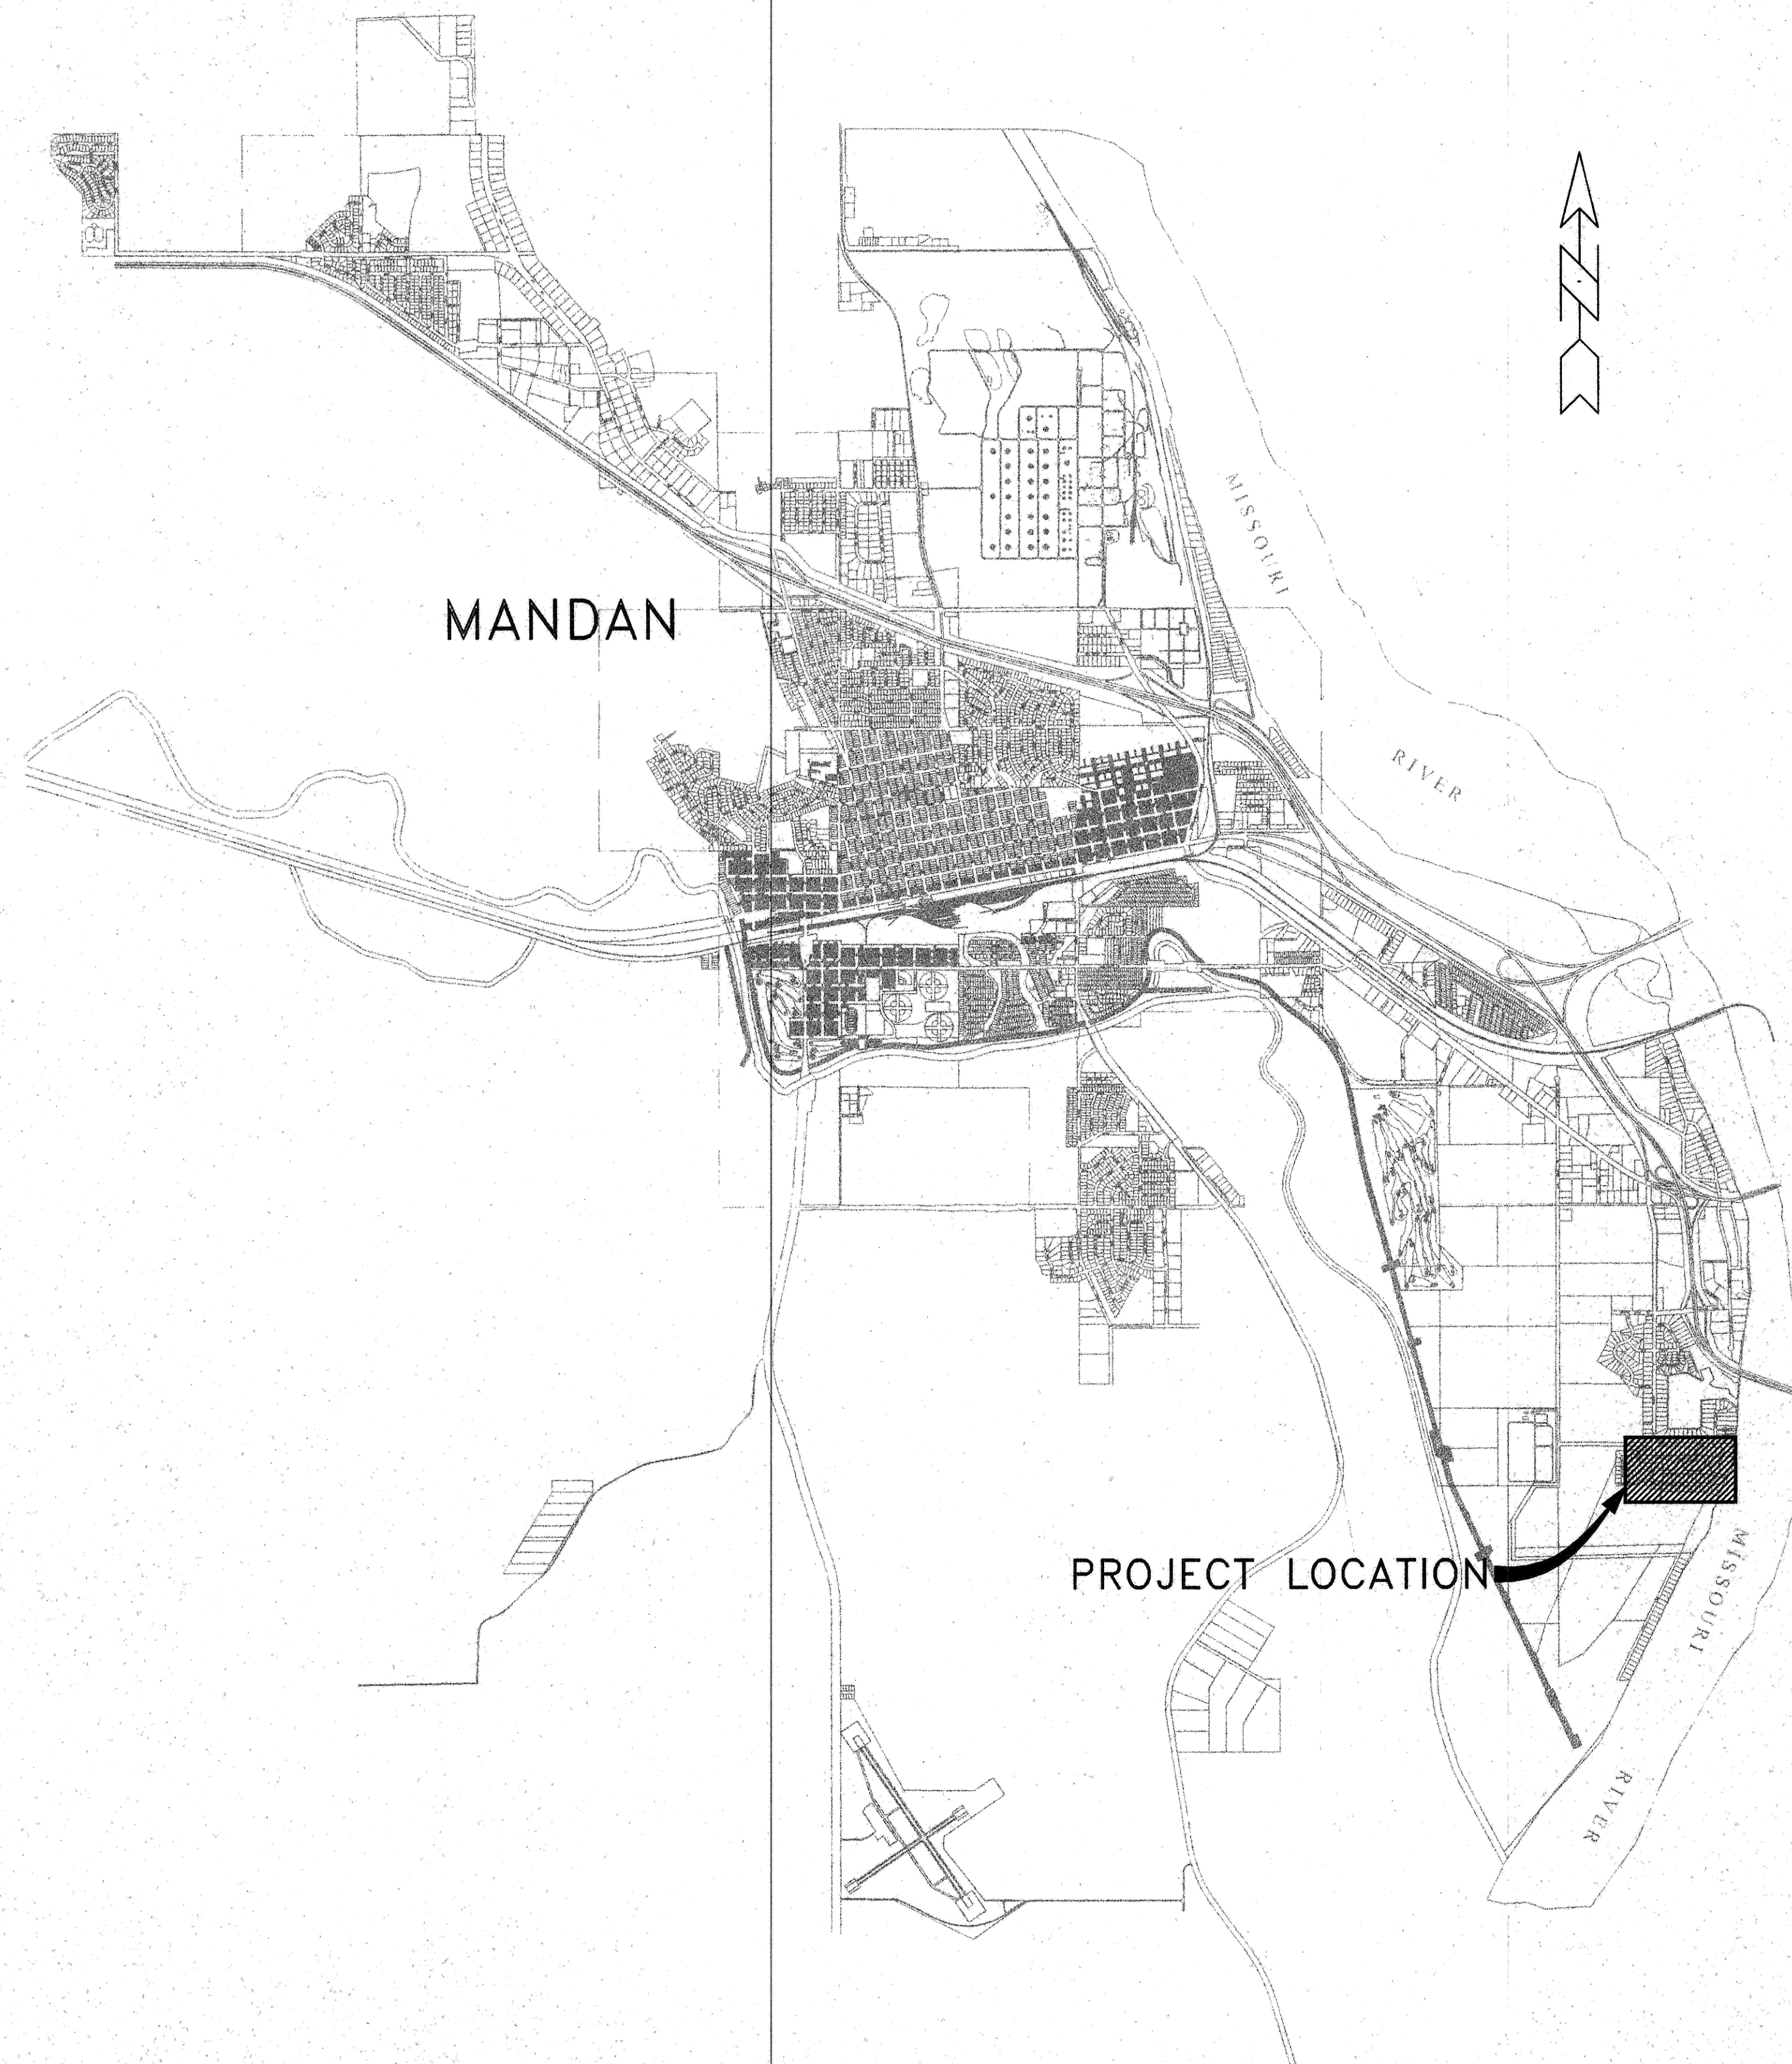


INDEX OF DRAWINGS

| SHEET NO. | TITLE |
|-----------|---------------------|
| 1 | TITLE SHEET |
| 2 | BORDEN HARBOR DRIVE |
| 3 | HARBOR TRAIL S.E. |
| 4 | DETAIL SHEET |

APPROVED: _____ DATE: _____
THOMAS LITTLE, R.P.E. CITY ENGINEER, MANDAN, NORTH DAKOTA

PREPARED BY:
TOMAN ENGINEERING

RONALD MANCHESTER R.P.E. 3252 DATE: _____

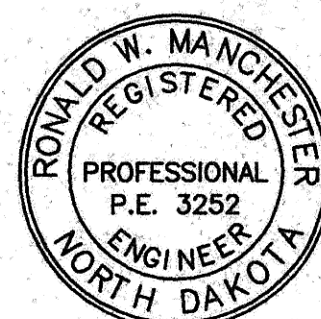

TOMAN ENGINEERING COMPANY
CONSULTING CIVIL ENGINEERS
906 2ND ST. N.W. • MANDAN, NORTH DAKOTA 58554 • 701-663-6483

