



STORM SEWER PLANS BURLINGTON STREET S.E.


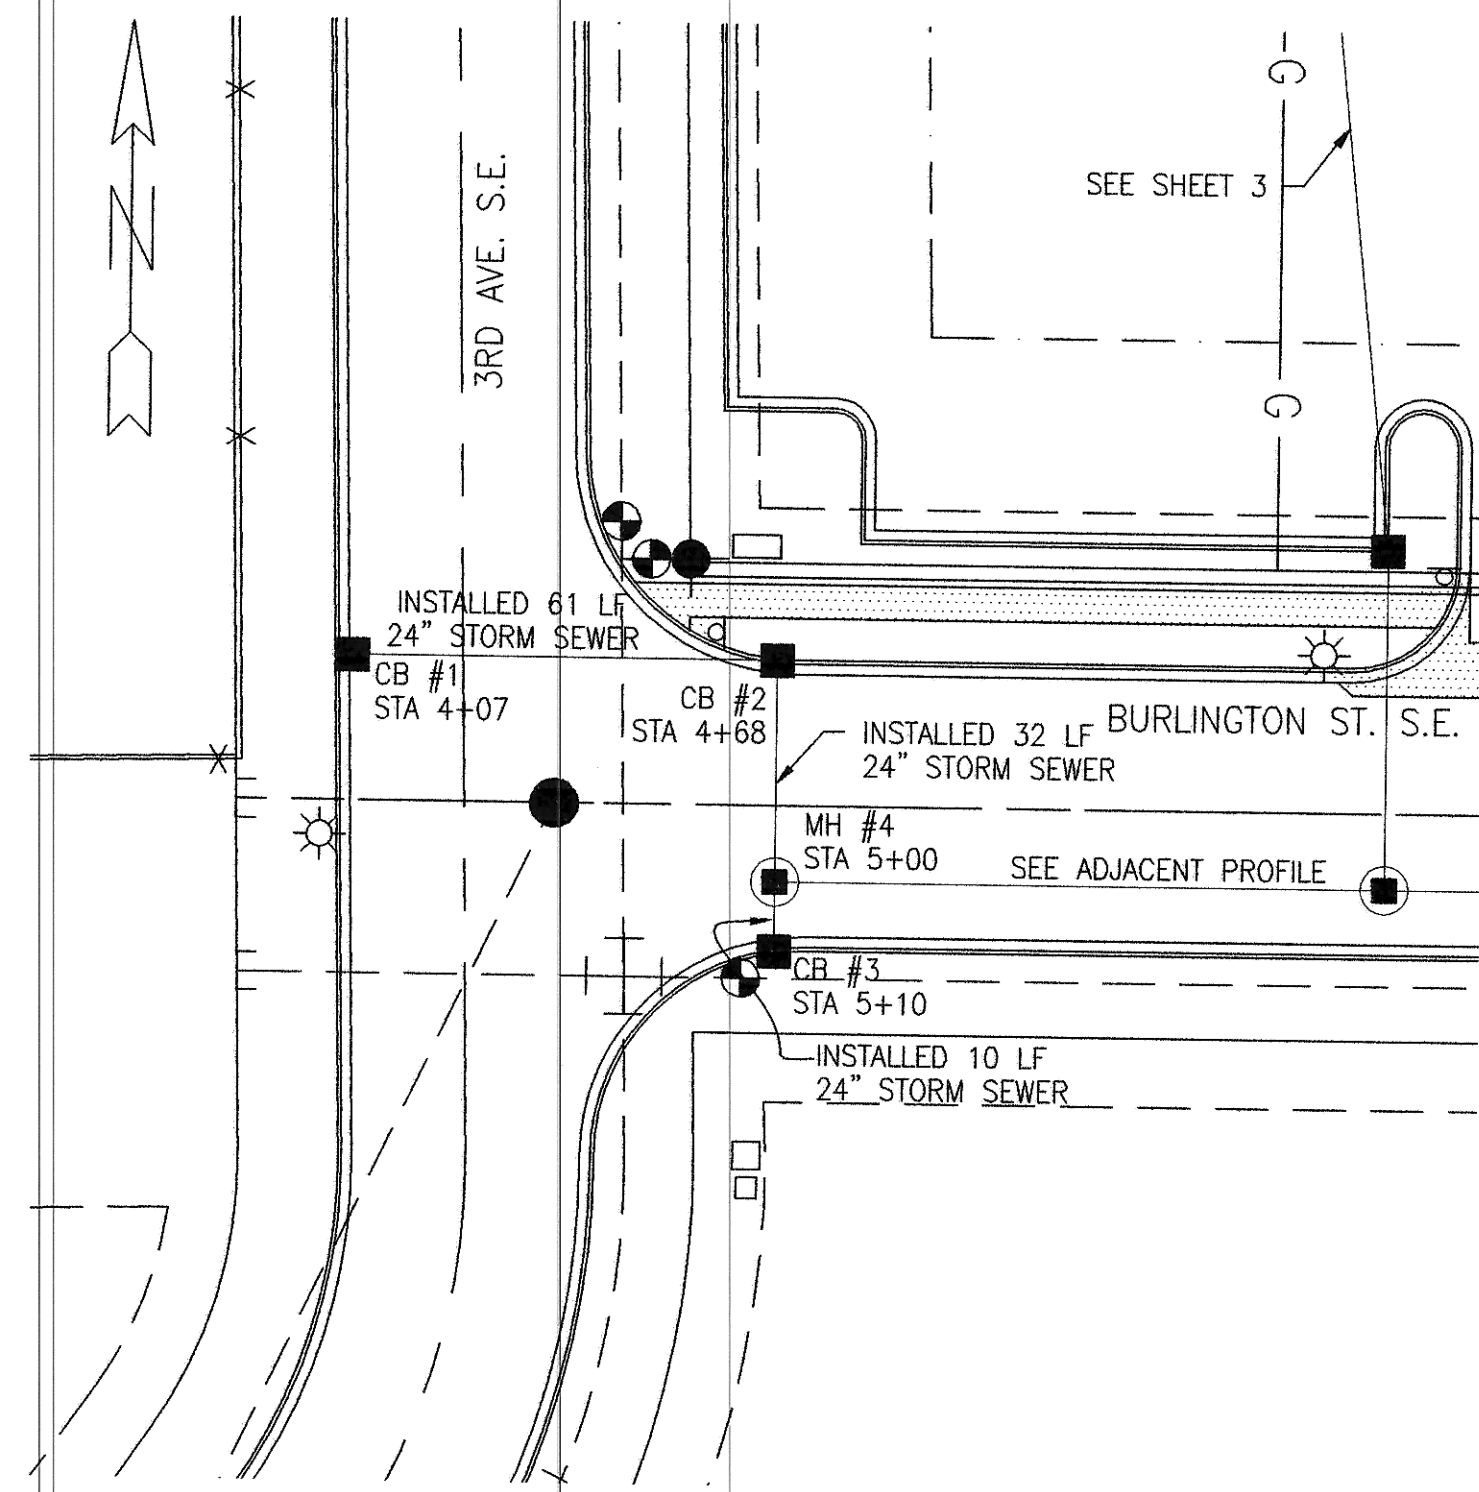


SCALES:
1" = 60' HOR
1" = 6' VER

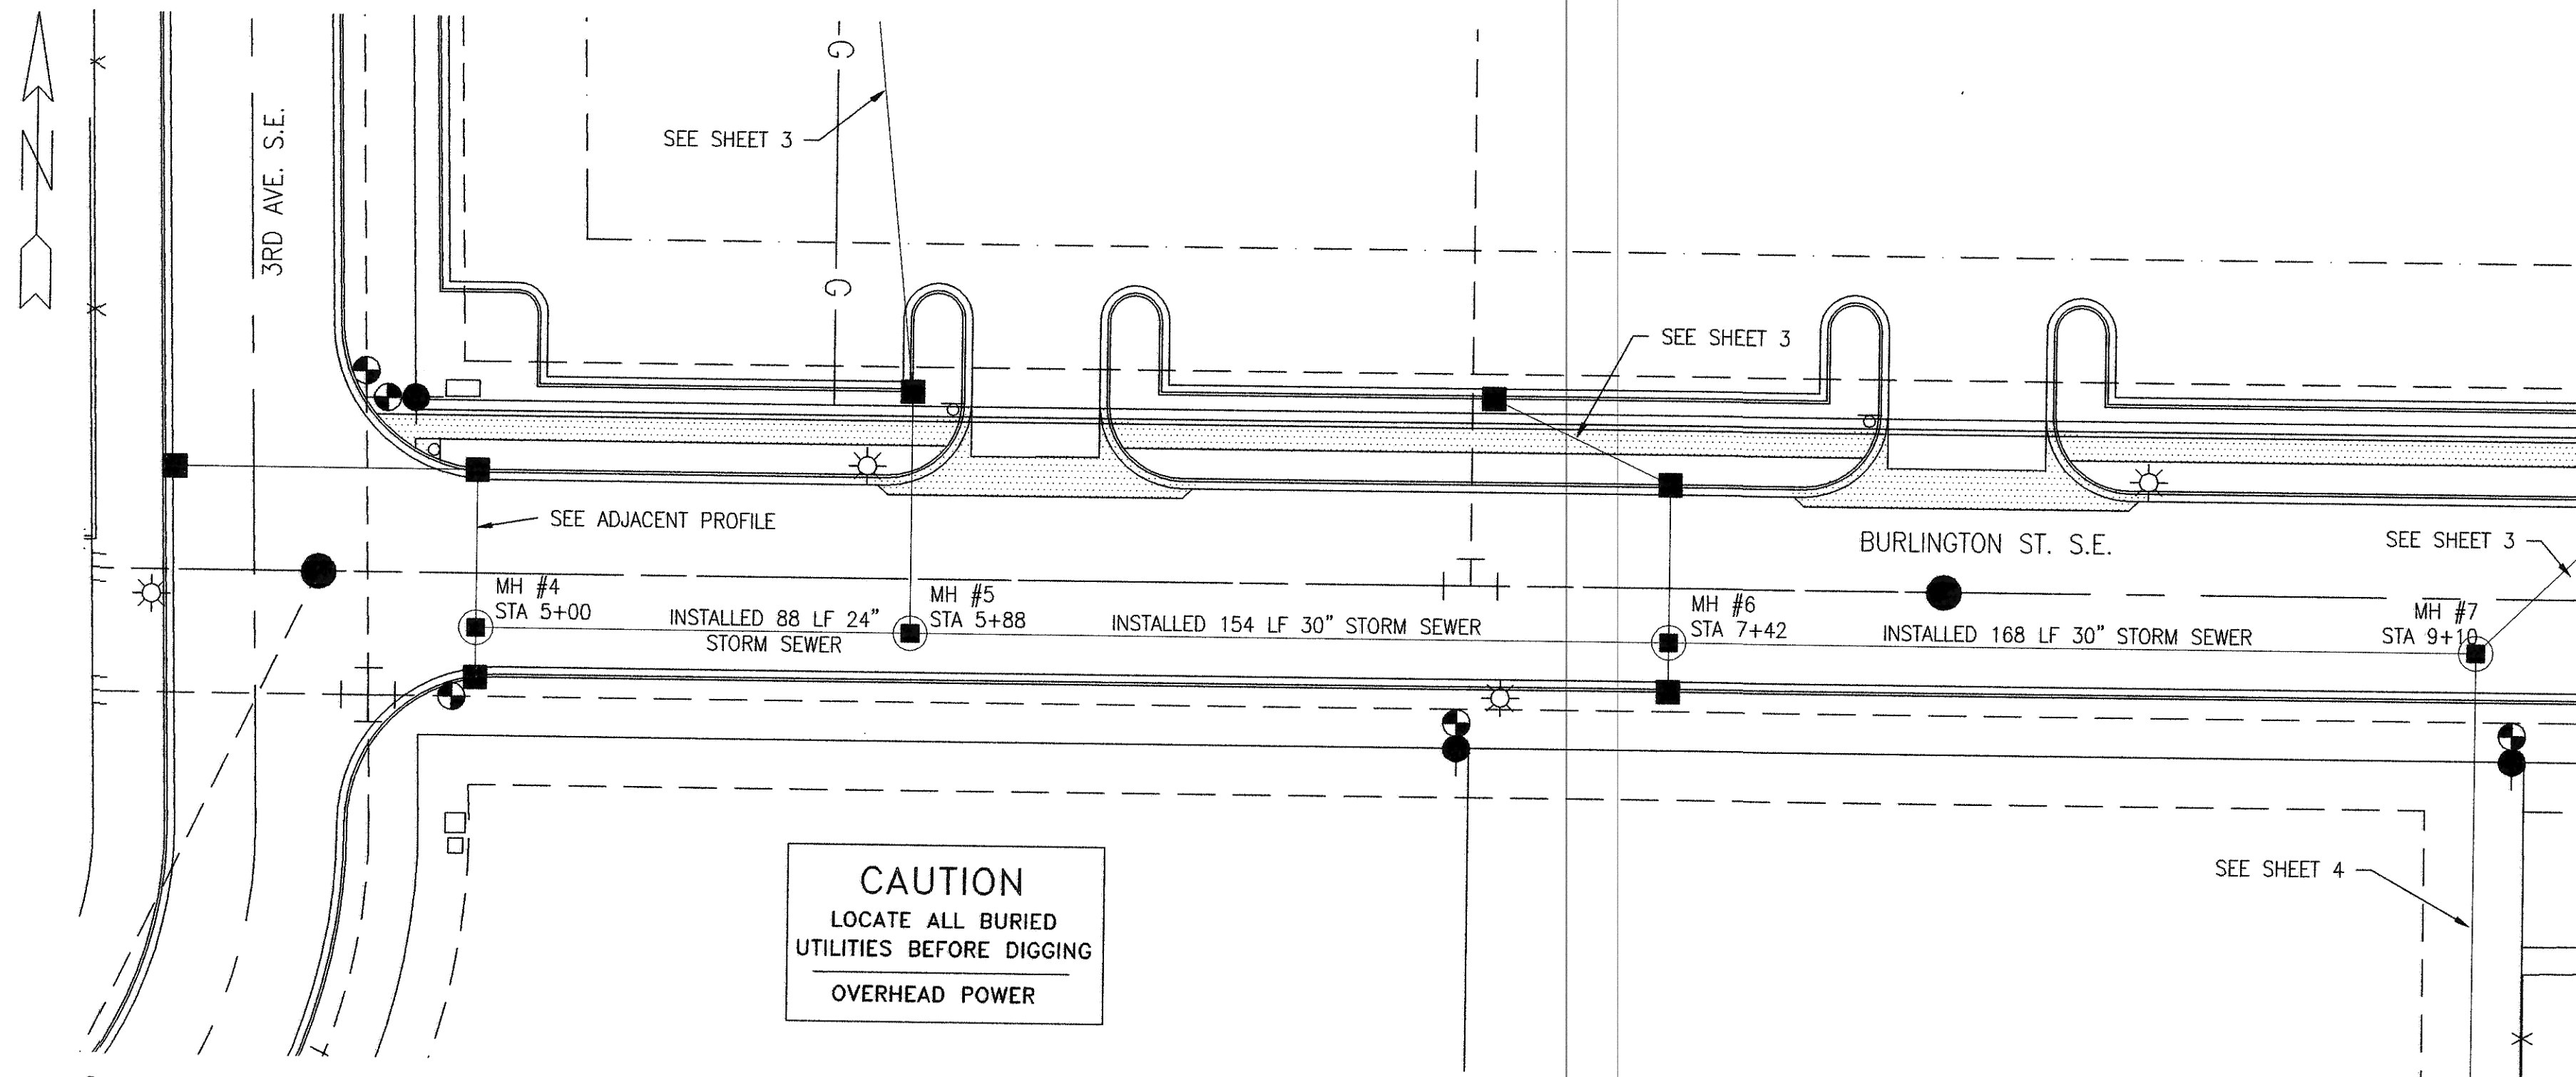

CAUTION
LOCATE ALL BURIED
UTILITIES BEFORE DIGGING
OVERHEAD POWER

SCALES:
1" = 60' HOR
1" = 6' VER

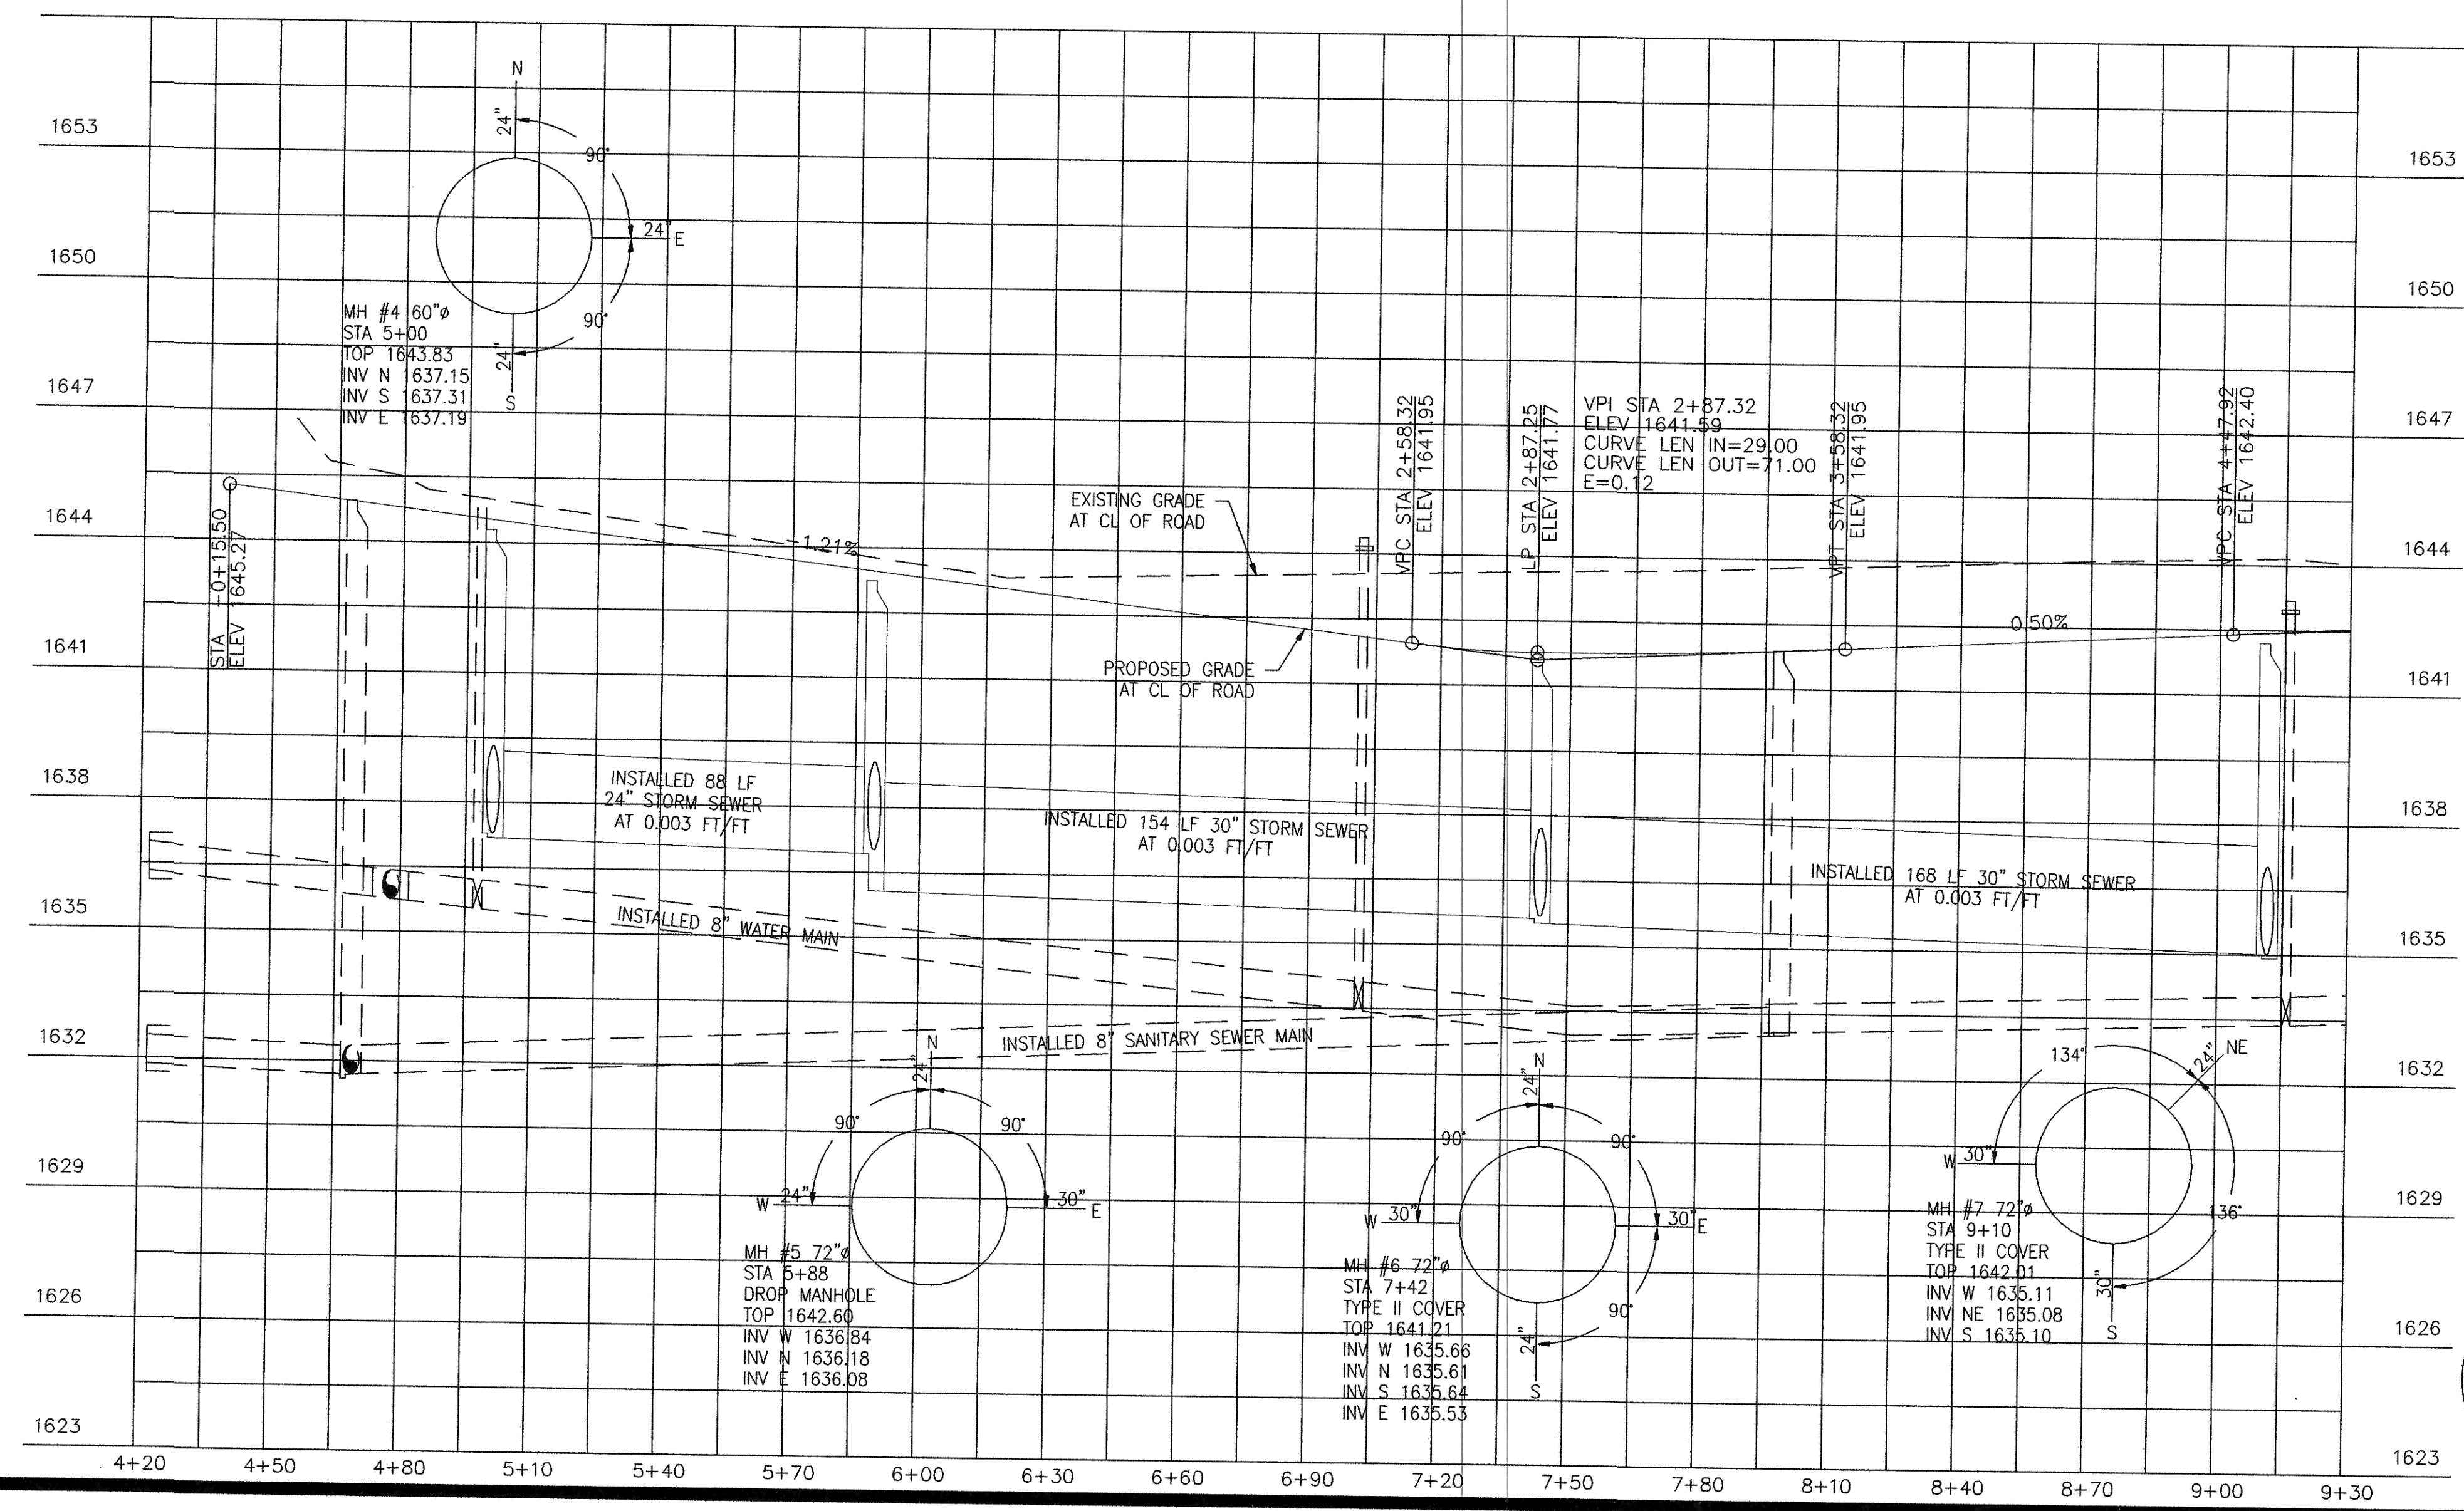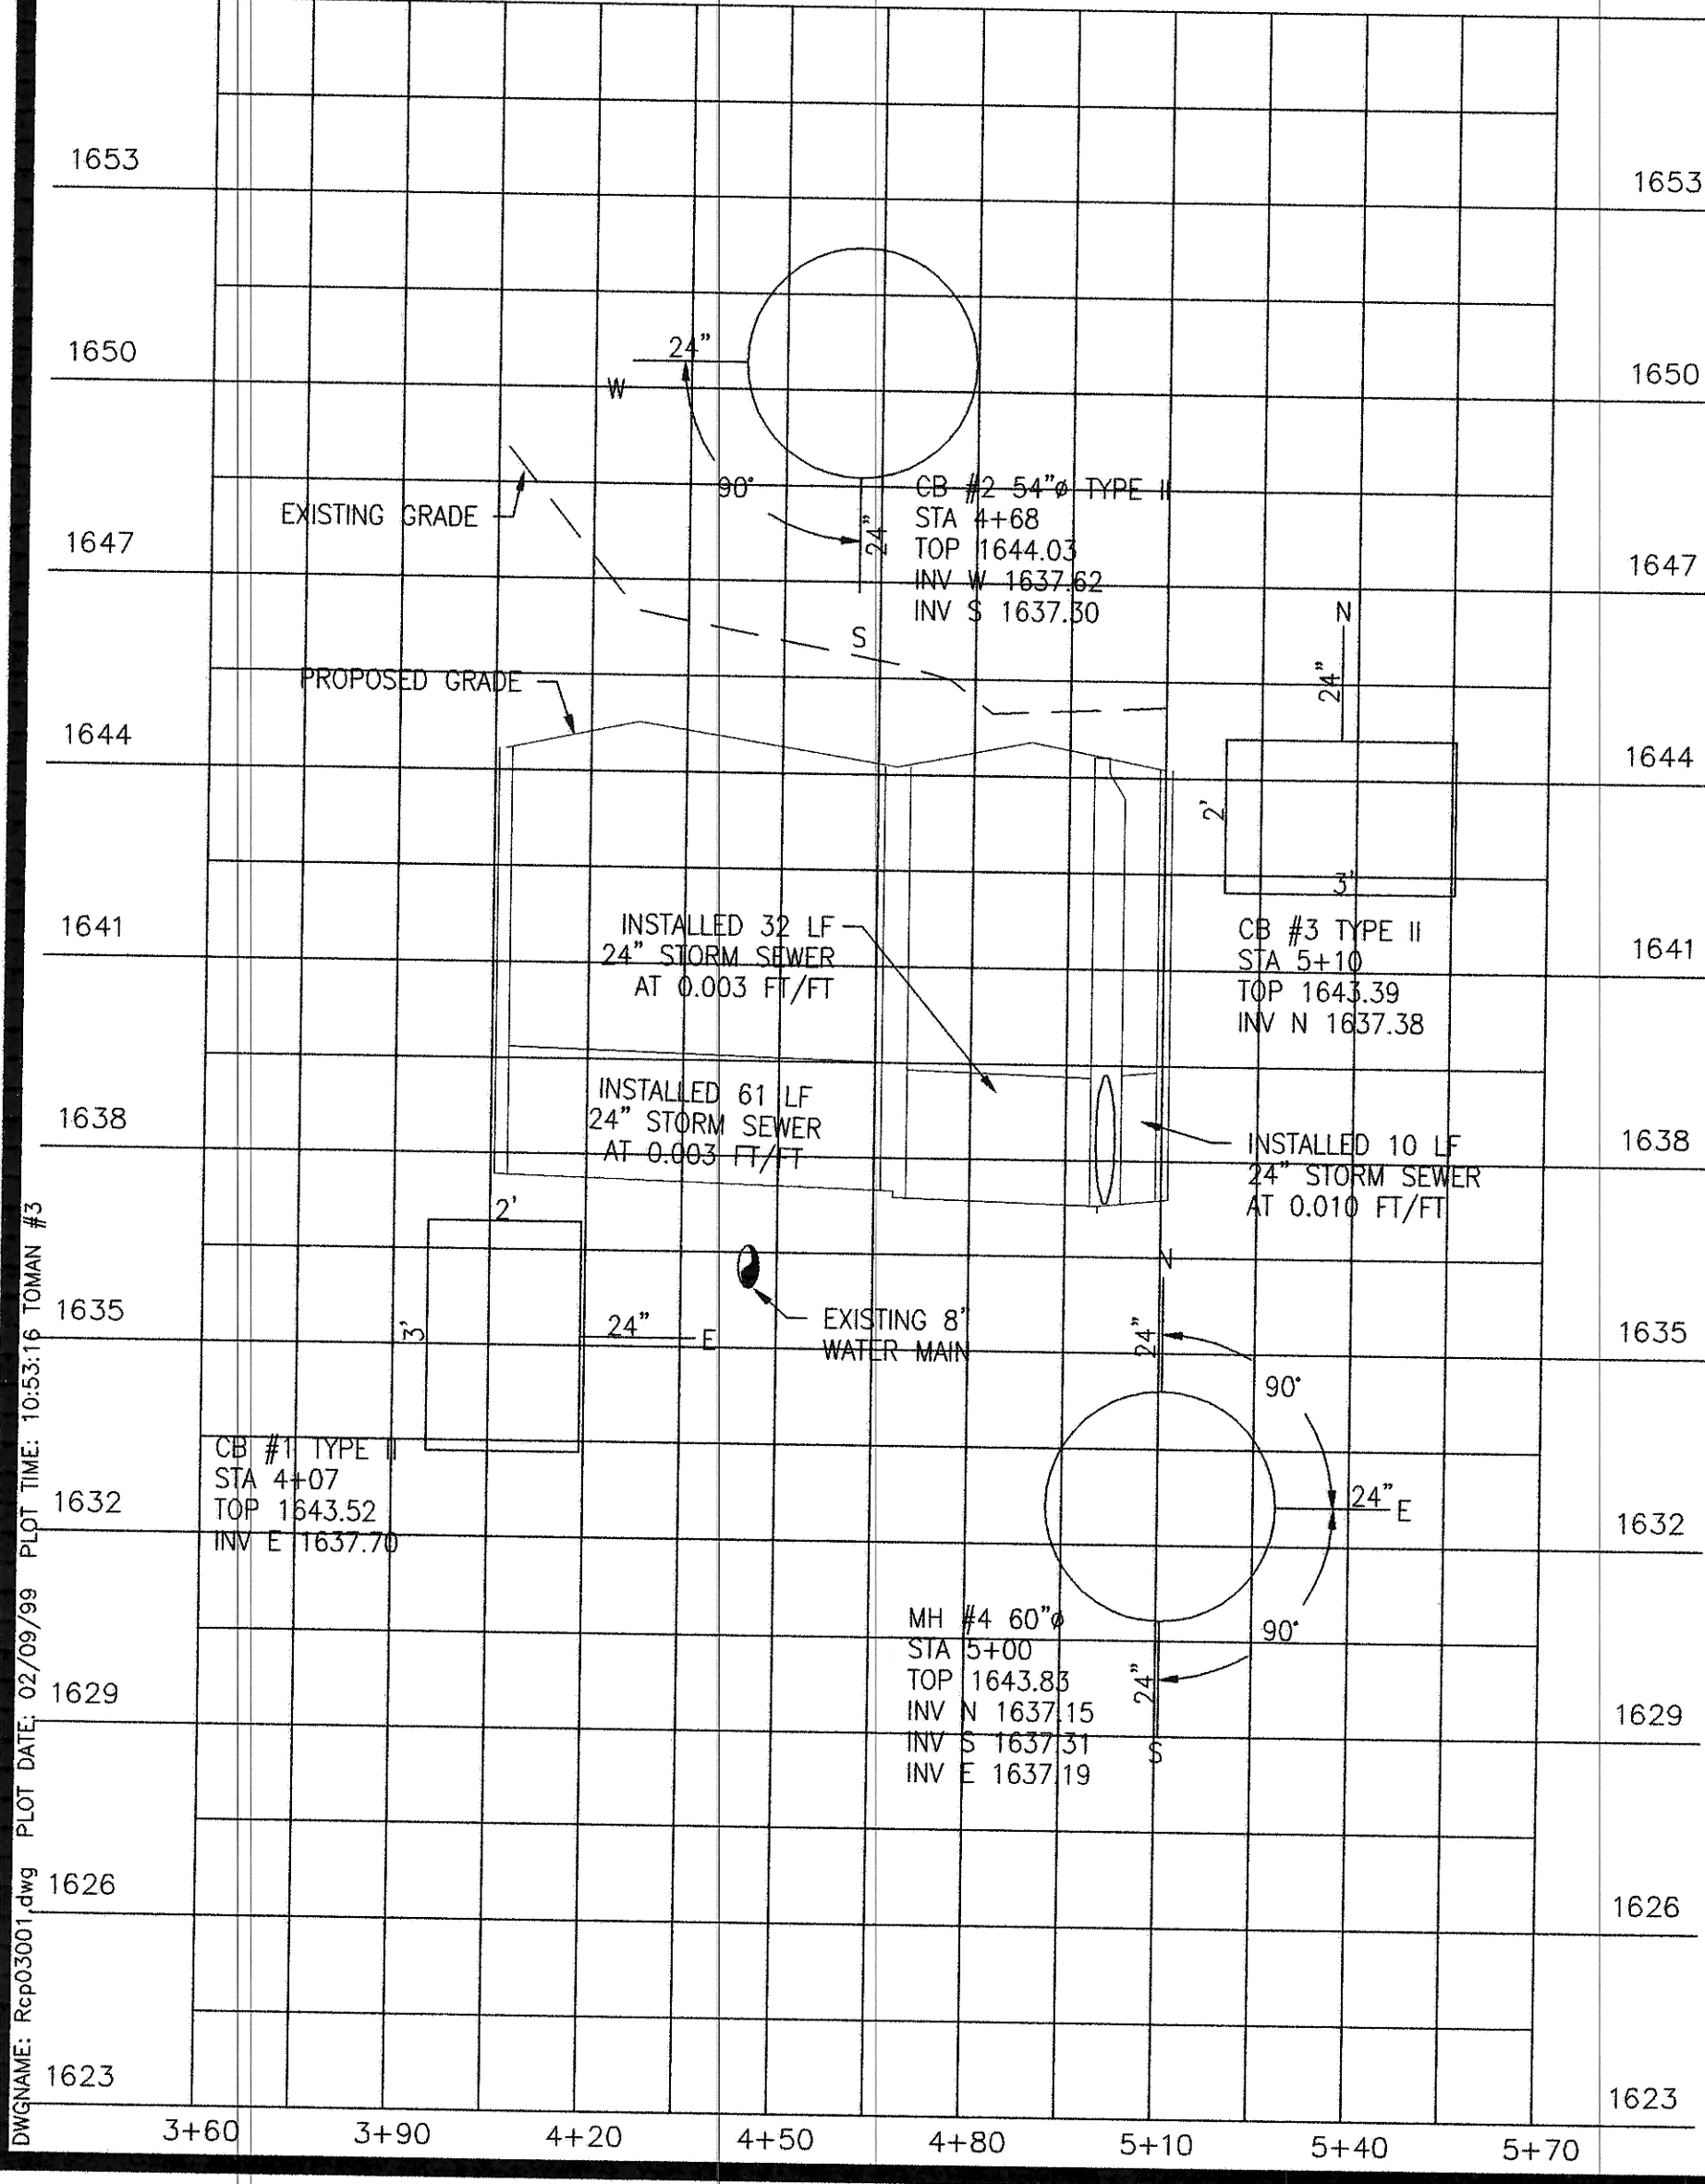

TOMAN ENGINEERING COMPANY
CONSULTING CIVIL & ENVIRONMENTAL ENGINEERS
800 5th St. W. • Wadena, North Dakota 58057 • 701-835-8465



PROJECT:
BURLINGTON STREET S.E.
STORM SEWER PLANS
PLAN & PROFILES

BY: DATE: 11/14/97
AR: 2/99

NO. 1
REVISIONS: AS-BUILT DRAWINGS

TITLE: DAN'S SUPERMARKET

SHEET NUMBER
2
OF 4 SHEETS

