




STORM SEWER PLANS MANHOLES 7&8 SOUTH TO OUTFALL

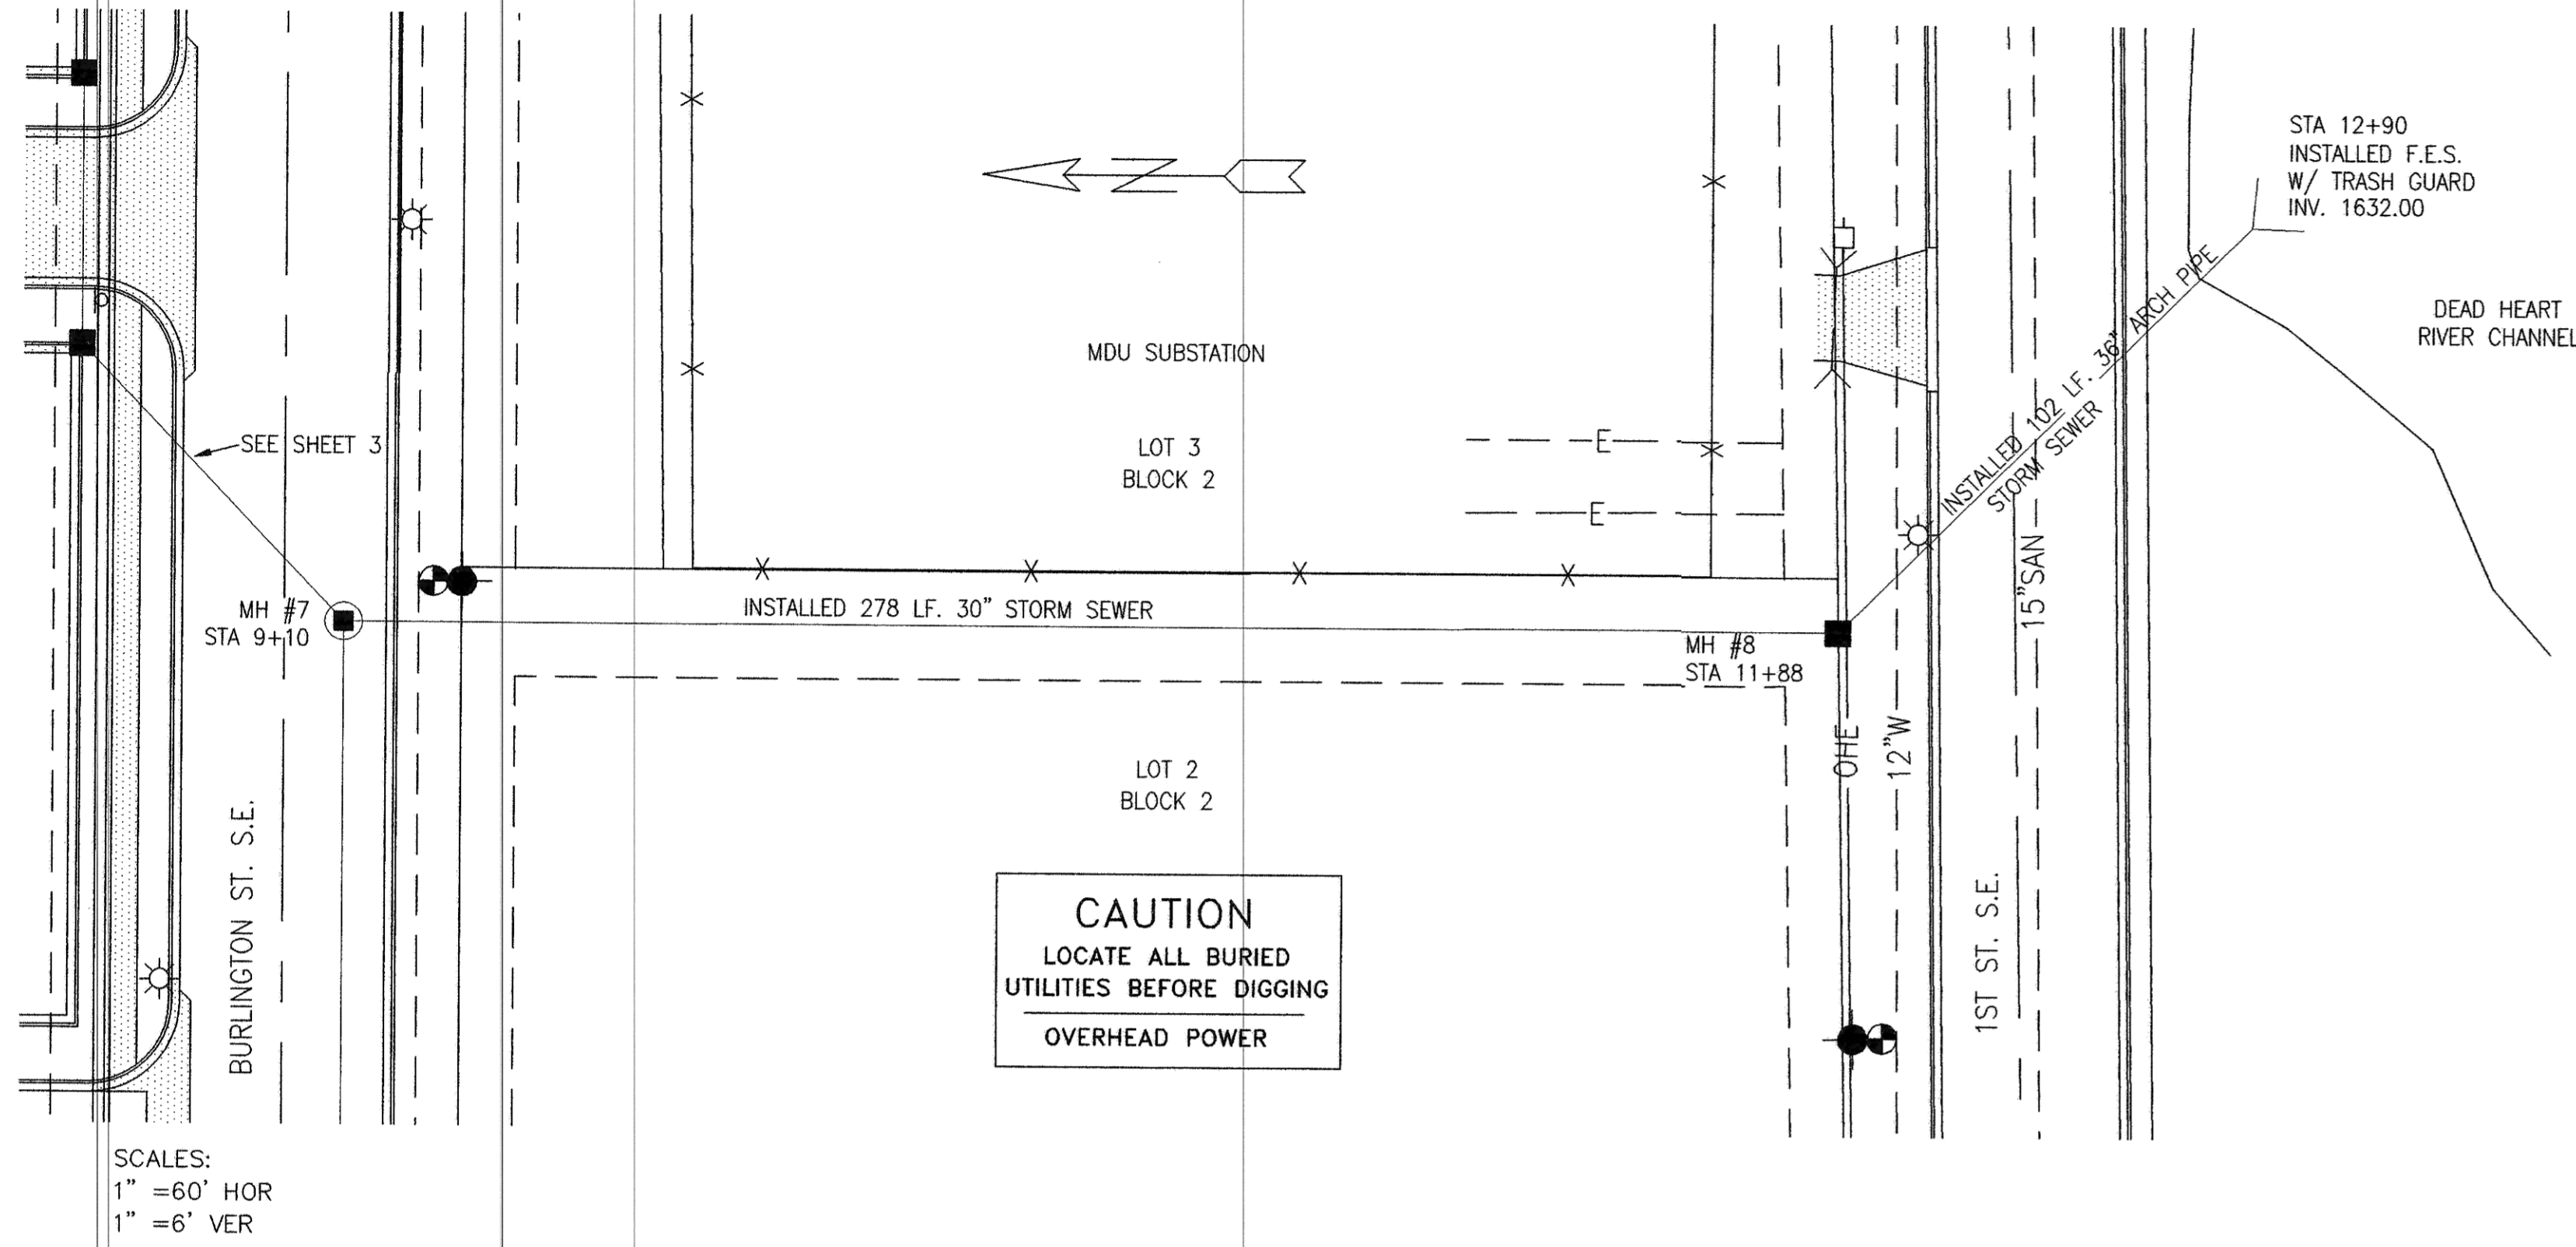

SCALES:
1" = 60' HOR
1" = 6' VER

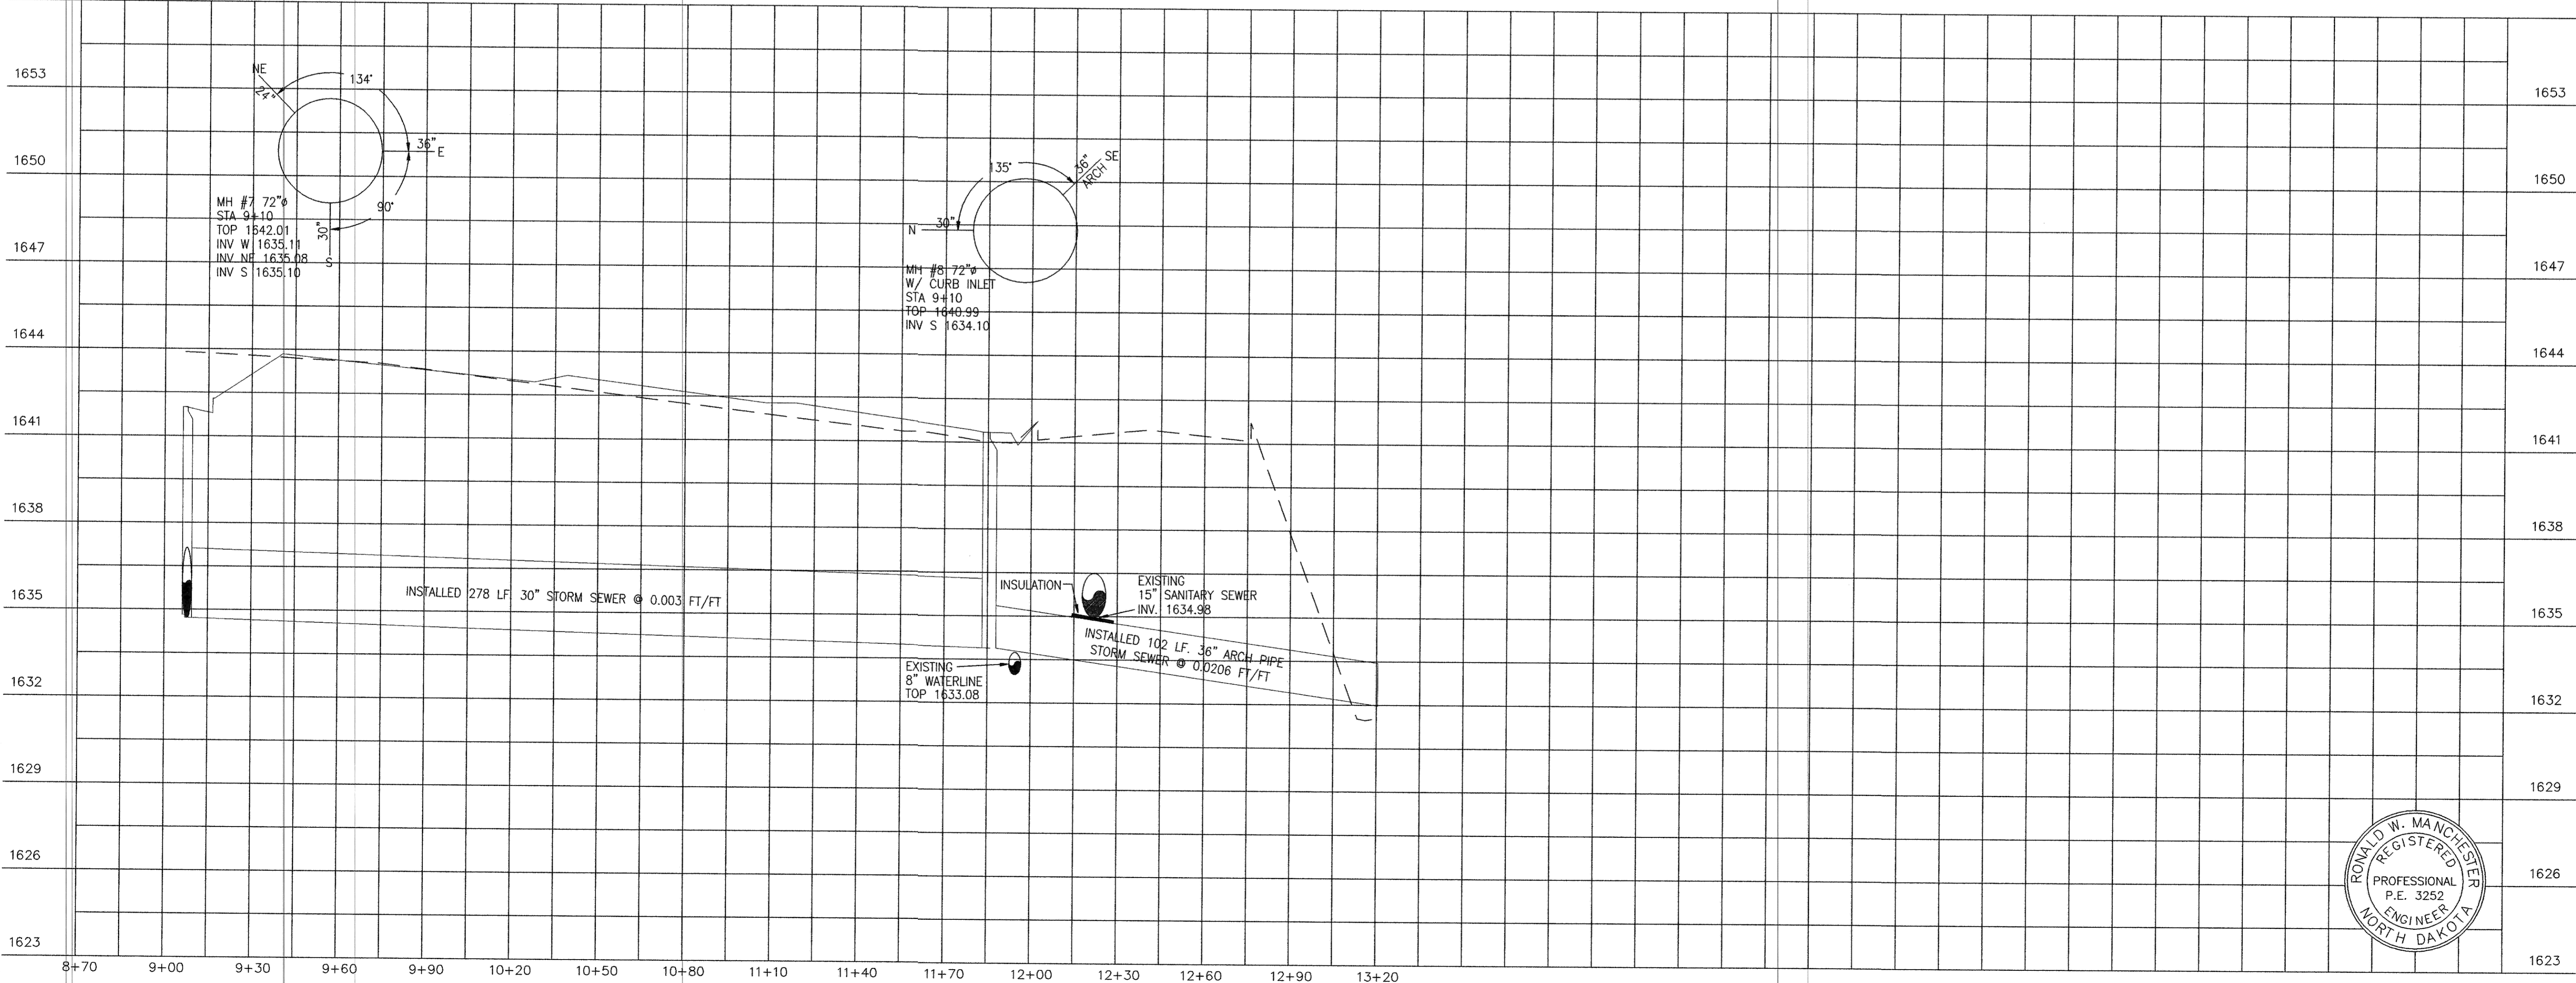

TOMAN ENGINEERING COMPANY
 CONSULTING CIVIL & ENVIRONMENTAL ENGINEERS
 908 2ND ST. N.W. • MINNAPOLIS, NORTH DAKOTA 58504 • 701-663-4483

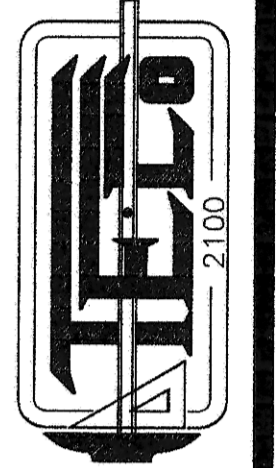

PROJECT: MANHOLES 7&8 SOUTH TO OUTFALL
 STORM SEWER PLANS
 PLAN & PROFILES

NO.	REVISIONS	DATE	BY	DATE	BY	DATE	BY
1	AS-BUILT DRAWINGS		AR	11/14/97	AM		

TITLE: DAN'S SUPERMARKET
 SHEET NUMBER
4
 OF 4 SHEETS