
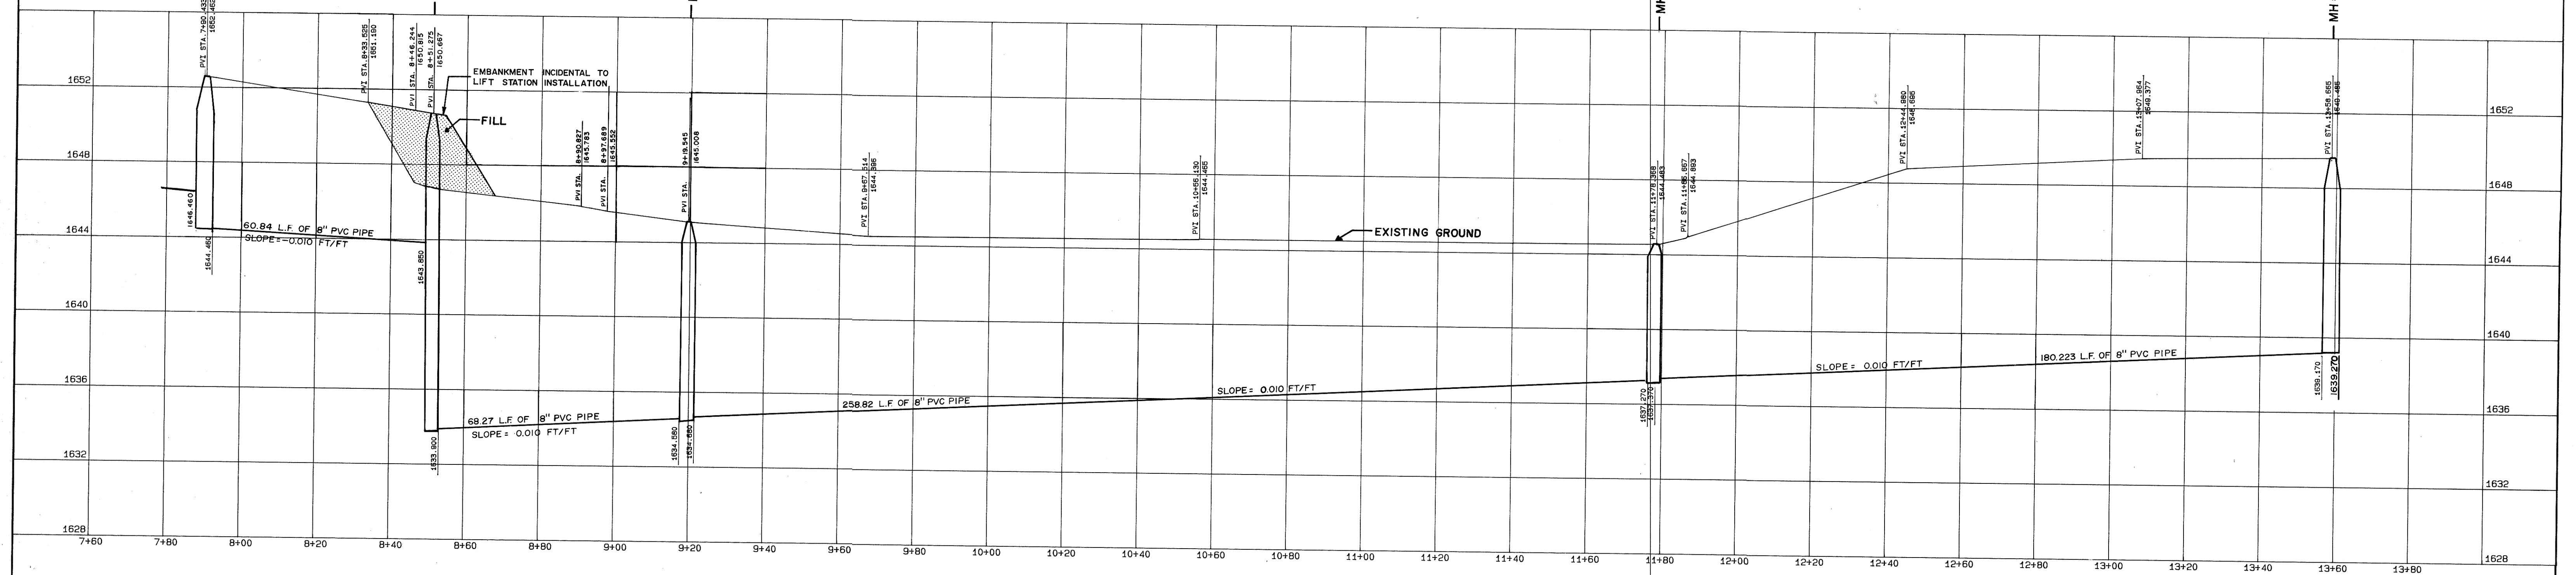
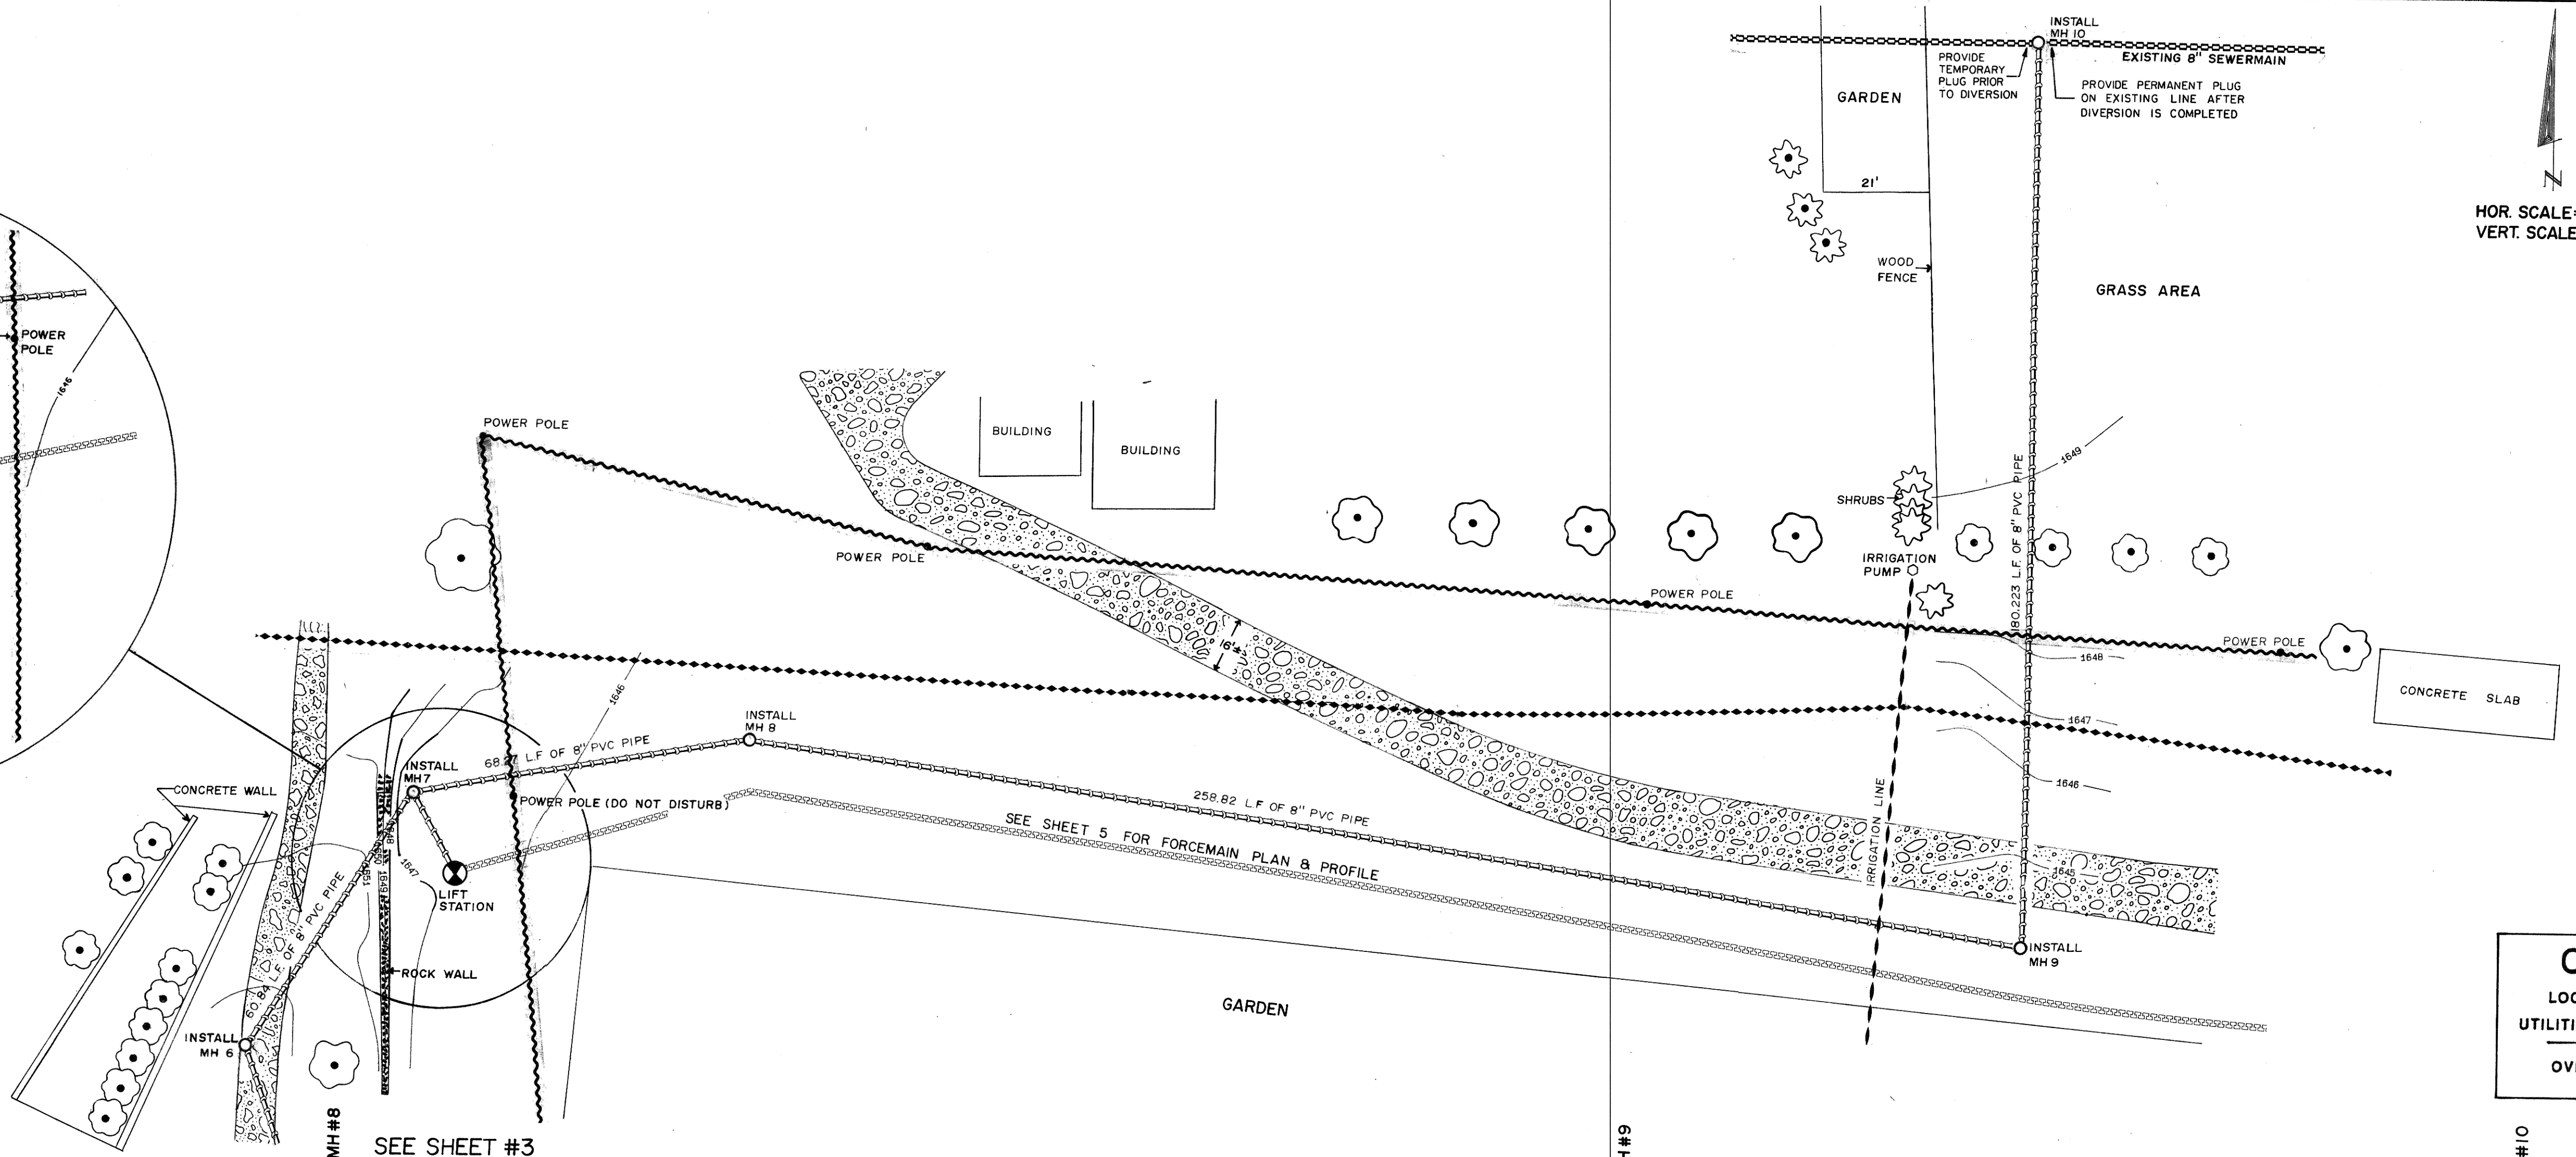


HOR. SCALE: 1" = 20'
VERT. SCALE: 1" = 4'

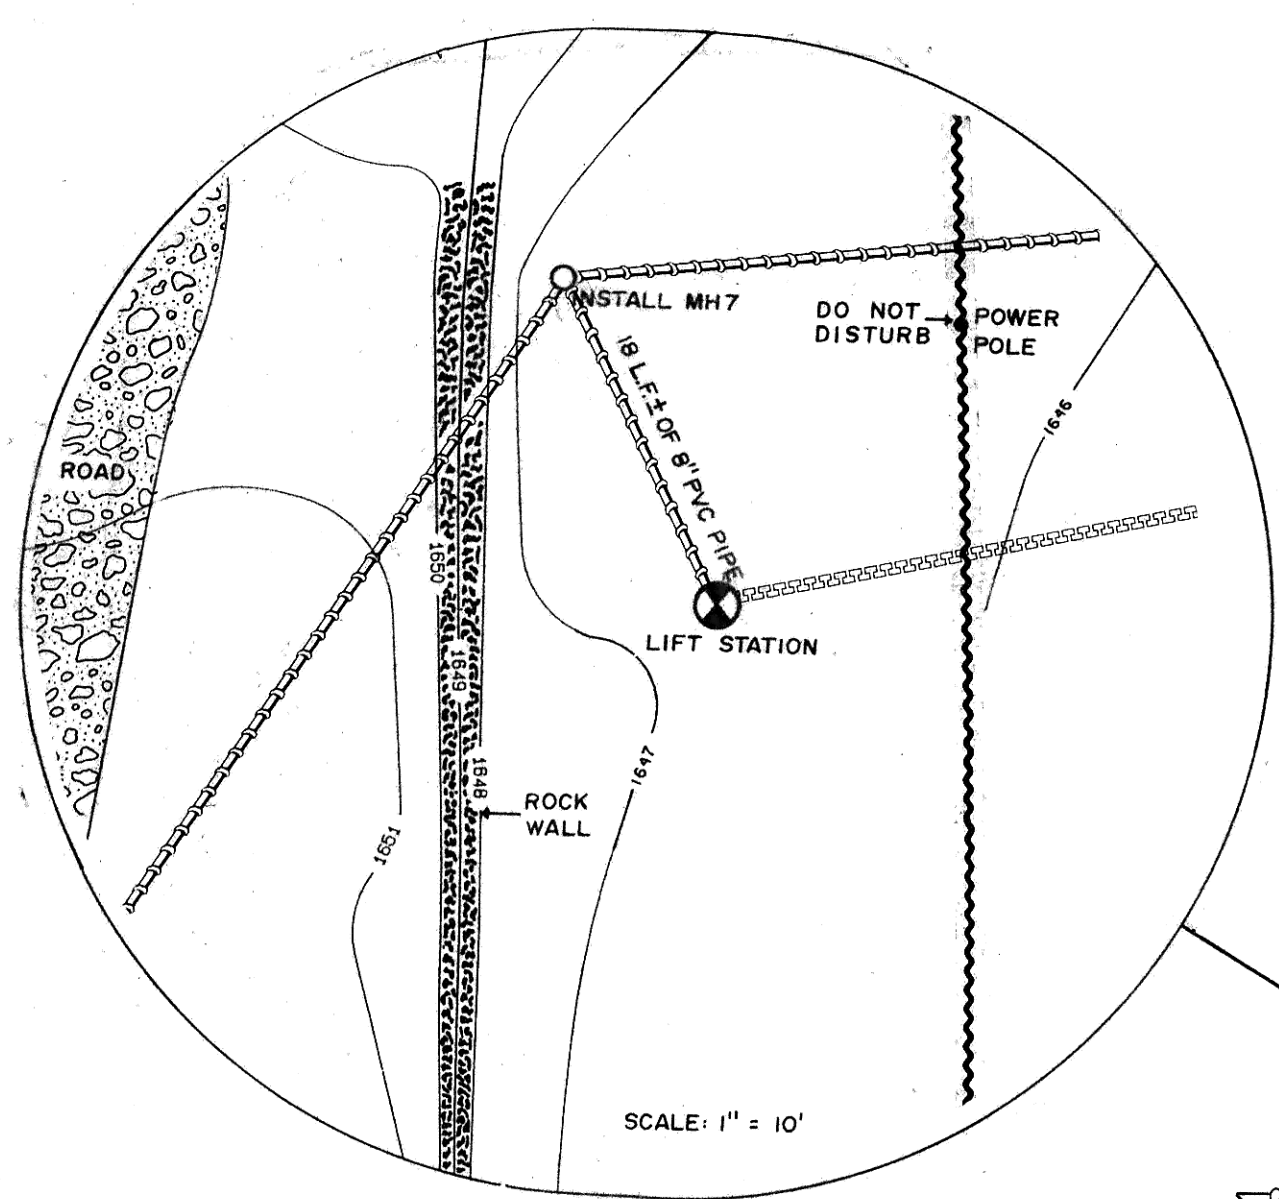

252°10'04" 48" 8"

DROP MANHOLE NO. 6	
TOP OF CASTING	1652.46
NE INVERT	1644.46
SE INVERT	1646.46
TOTAL DEPTH	8.00'

227°46'55" 48" 8"

DROP MANHOLE NO. 7	
TOP OF CASTING	1650.67
NE INVERT	1633.90
SW INVERT	1643.85
SE INVERT	1638.90
TOTAL DEPTH	16.77'

189°27'20" 48" 8"

MANHOLE NO. 8	
TOP OF CASTING	1645.01
NE INVERT	1634.68
SW INVERT	1634.58
TOTAL DEPTH	10.43'

81°41'11" 48" 8"

MANHOLE NO. 9	
TOP OF CASTING	1644.48
NORTH INVERT	1637.37
NW INVERT	1637.27
TOTAL DEPTH	7.19'



81°41'11" 48" 8"

MANHOLE NO. 10	
TOP OF CASTING	1649.49
SOUTH INVERT	1639.17
WEST INVERT	1639.27
EAST INVERT	1639.17
TOTAL DEPTH	10.22'

PROJECT NO.	1089
DATE	7-91



PLAN & PROFILE SHEET

MANHOLE NO. 6 TO MANHOLE NO. 10