



HOR. SCALE: 1" = 30'
VERT. SCALE: 1" = 4'

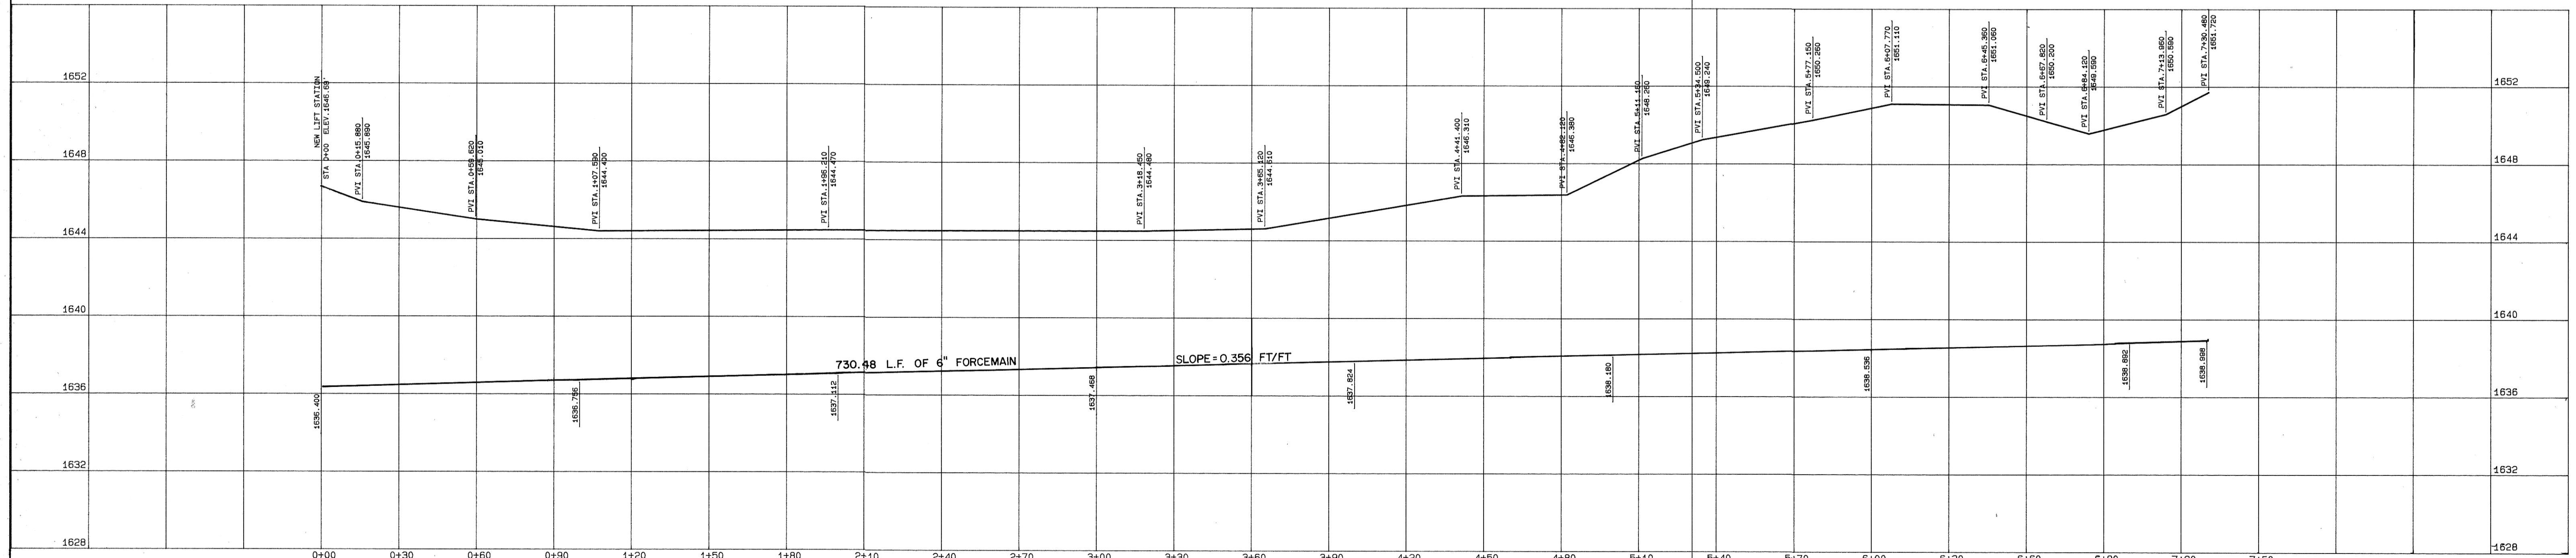

LIFT STATION
TOP OF CASTING

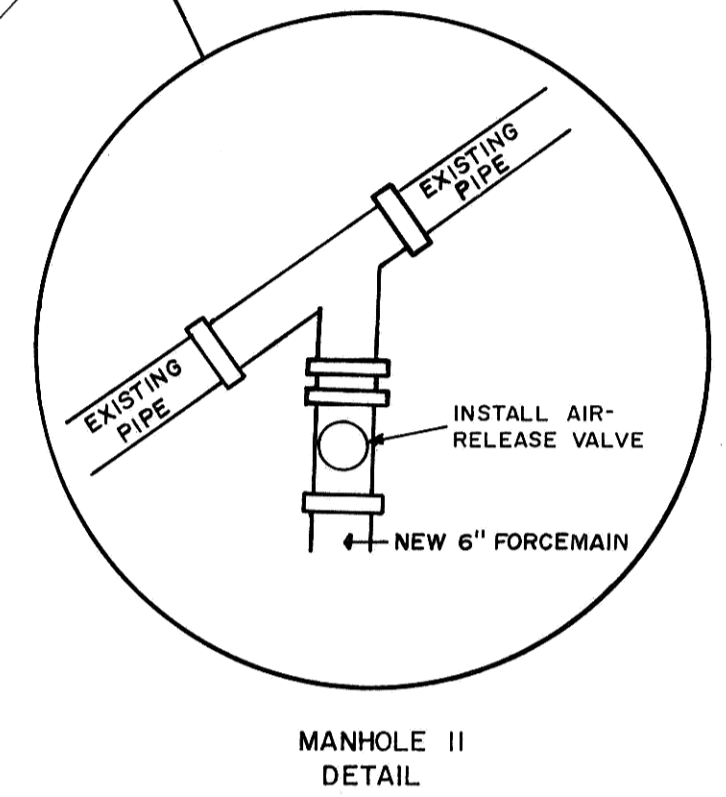

PROJECT NO.	1089	 TOMAH ENGINEERING COMPANY CONSULTING CIVIL & ENVIRONMENTAL ENGINEERS
DATE	7-91	
FORCEMAIN ROUTE		