

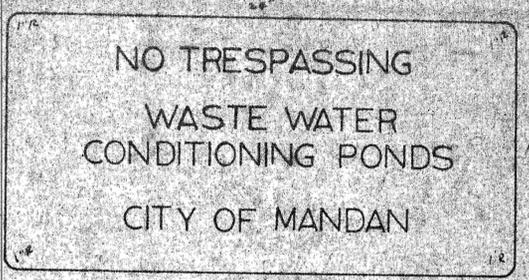
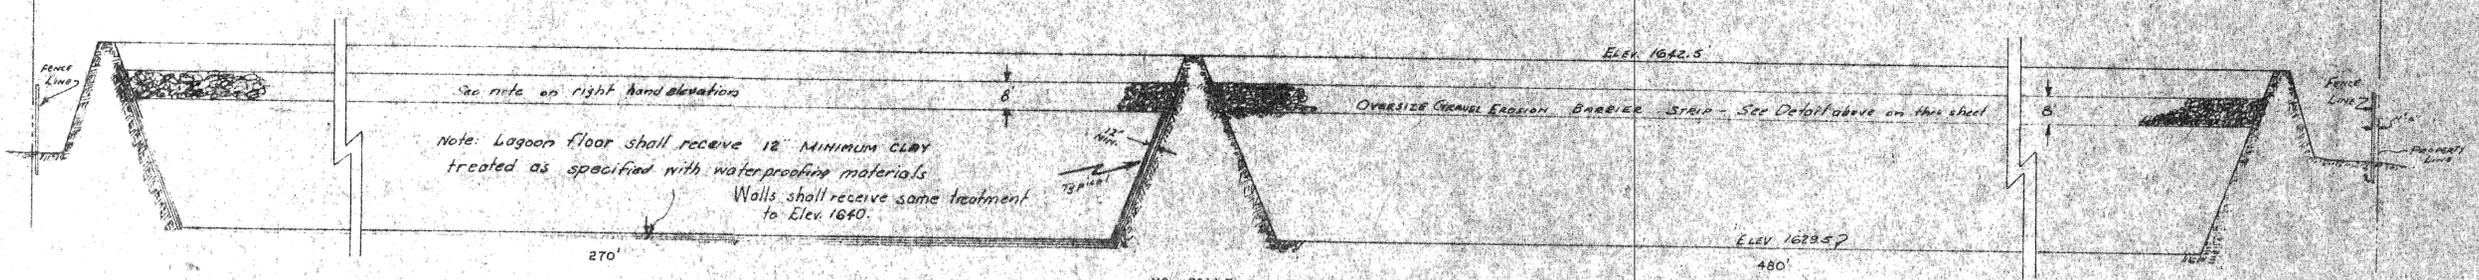
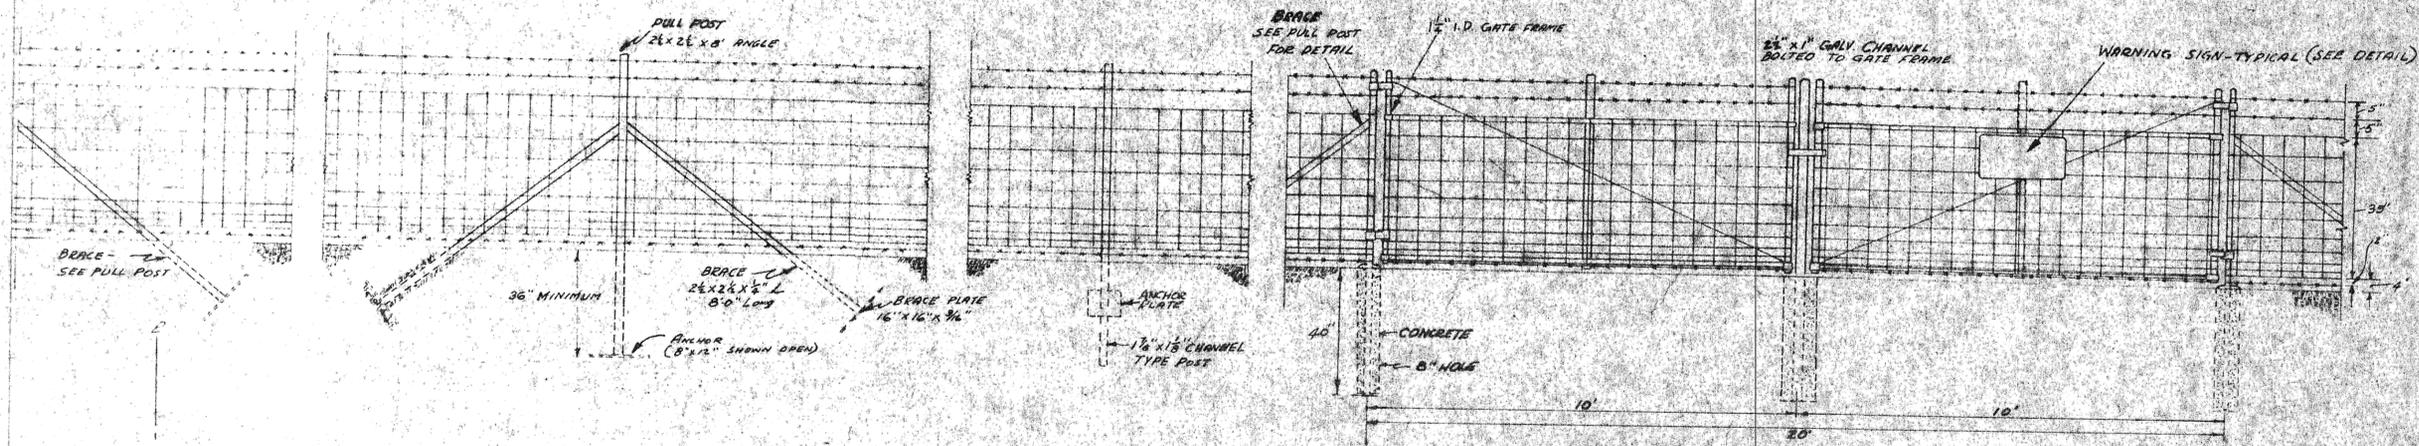


NOTE: THIS CONSTRUCTION FOR CLAY TREATMENT ONLY
IF VINYL FILM USED, SEE DETAIL LOWER CENTER THIS SHEET
TYPICAL SECTION - EROSION BARRIER
NO SCALE

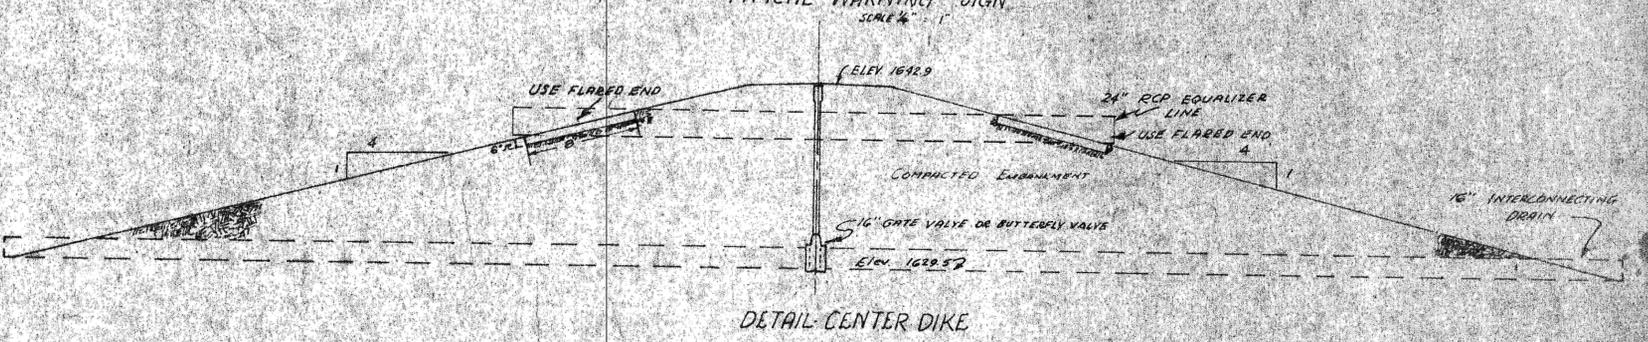

TYPICAL WARNING SIGN
SCALE 1/2" = 1'

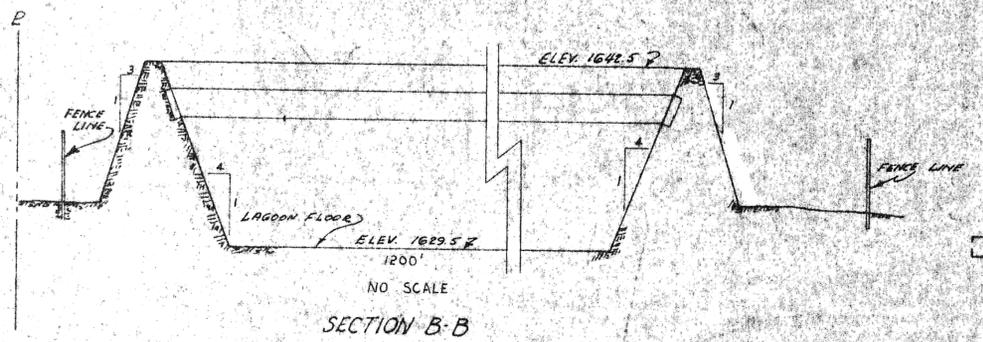

JOB		UPGRADING WASTEWATER TREATMENT FACILITIES	
INCREMENT NO. 1 E.P.A. NO. C380325-03		CONTRACTOR'S RECORD DRAWINGS (AS BUILT)	
FILE NO.	DATE	SEPTEMBER 1976	
SHEET NO. 17 OF 23 SHEETS		INCREMENT 1	
DRAWN BY: S.L.		CHECKED BY:	
DIKE & FENCE DETAILS			
GEORGE TOMAN RPE NO. 185		CONSULTING ENGINEER MANDAN, ND	