


DETAILS OF NEW MANHOLES AND PIPE INSTALLATION


SCALE  
1" = 20'-0"

NOTE:  
- - - - - EXISTING FACILITIES  
— FACILITIES TO BE INSTALLED

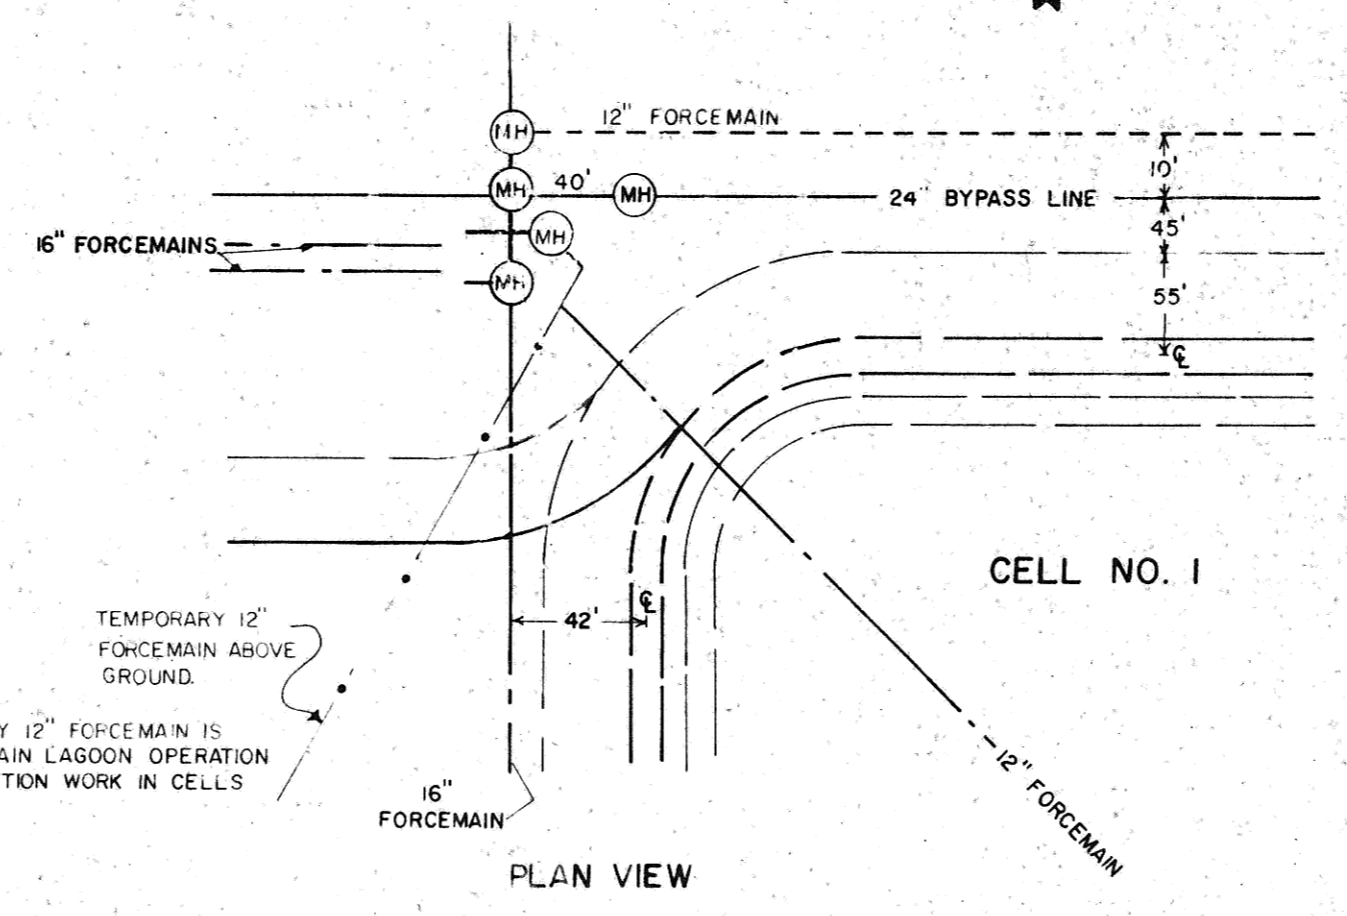

NOTE: TEMPORARY 12" FORCE MAIN IS NEEDED TO MAINTAIN LAGOON OPERATION DURING CONSTRUCTION WORK IN CELLS 1 AND 2.

PLAN VIEW

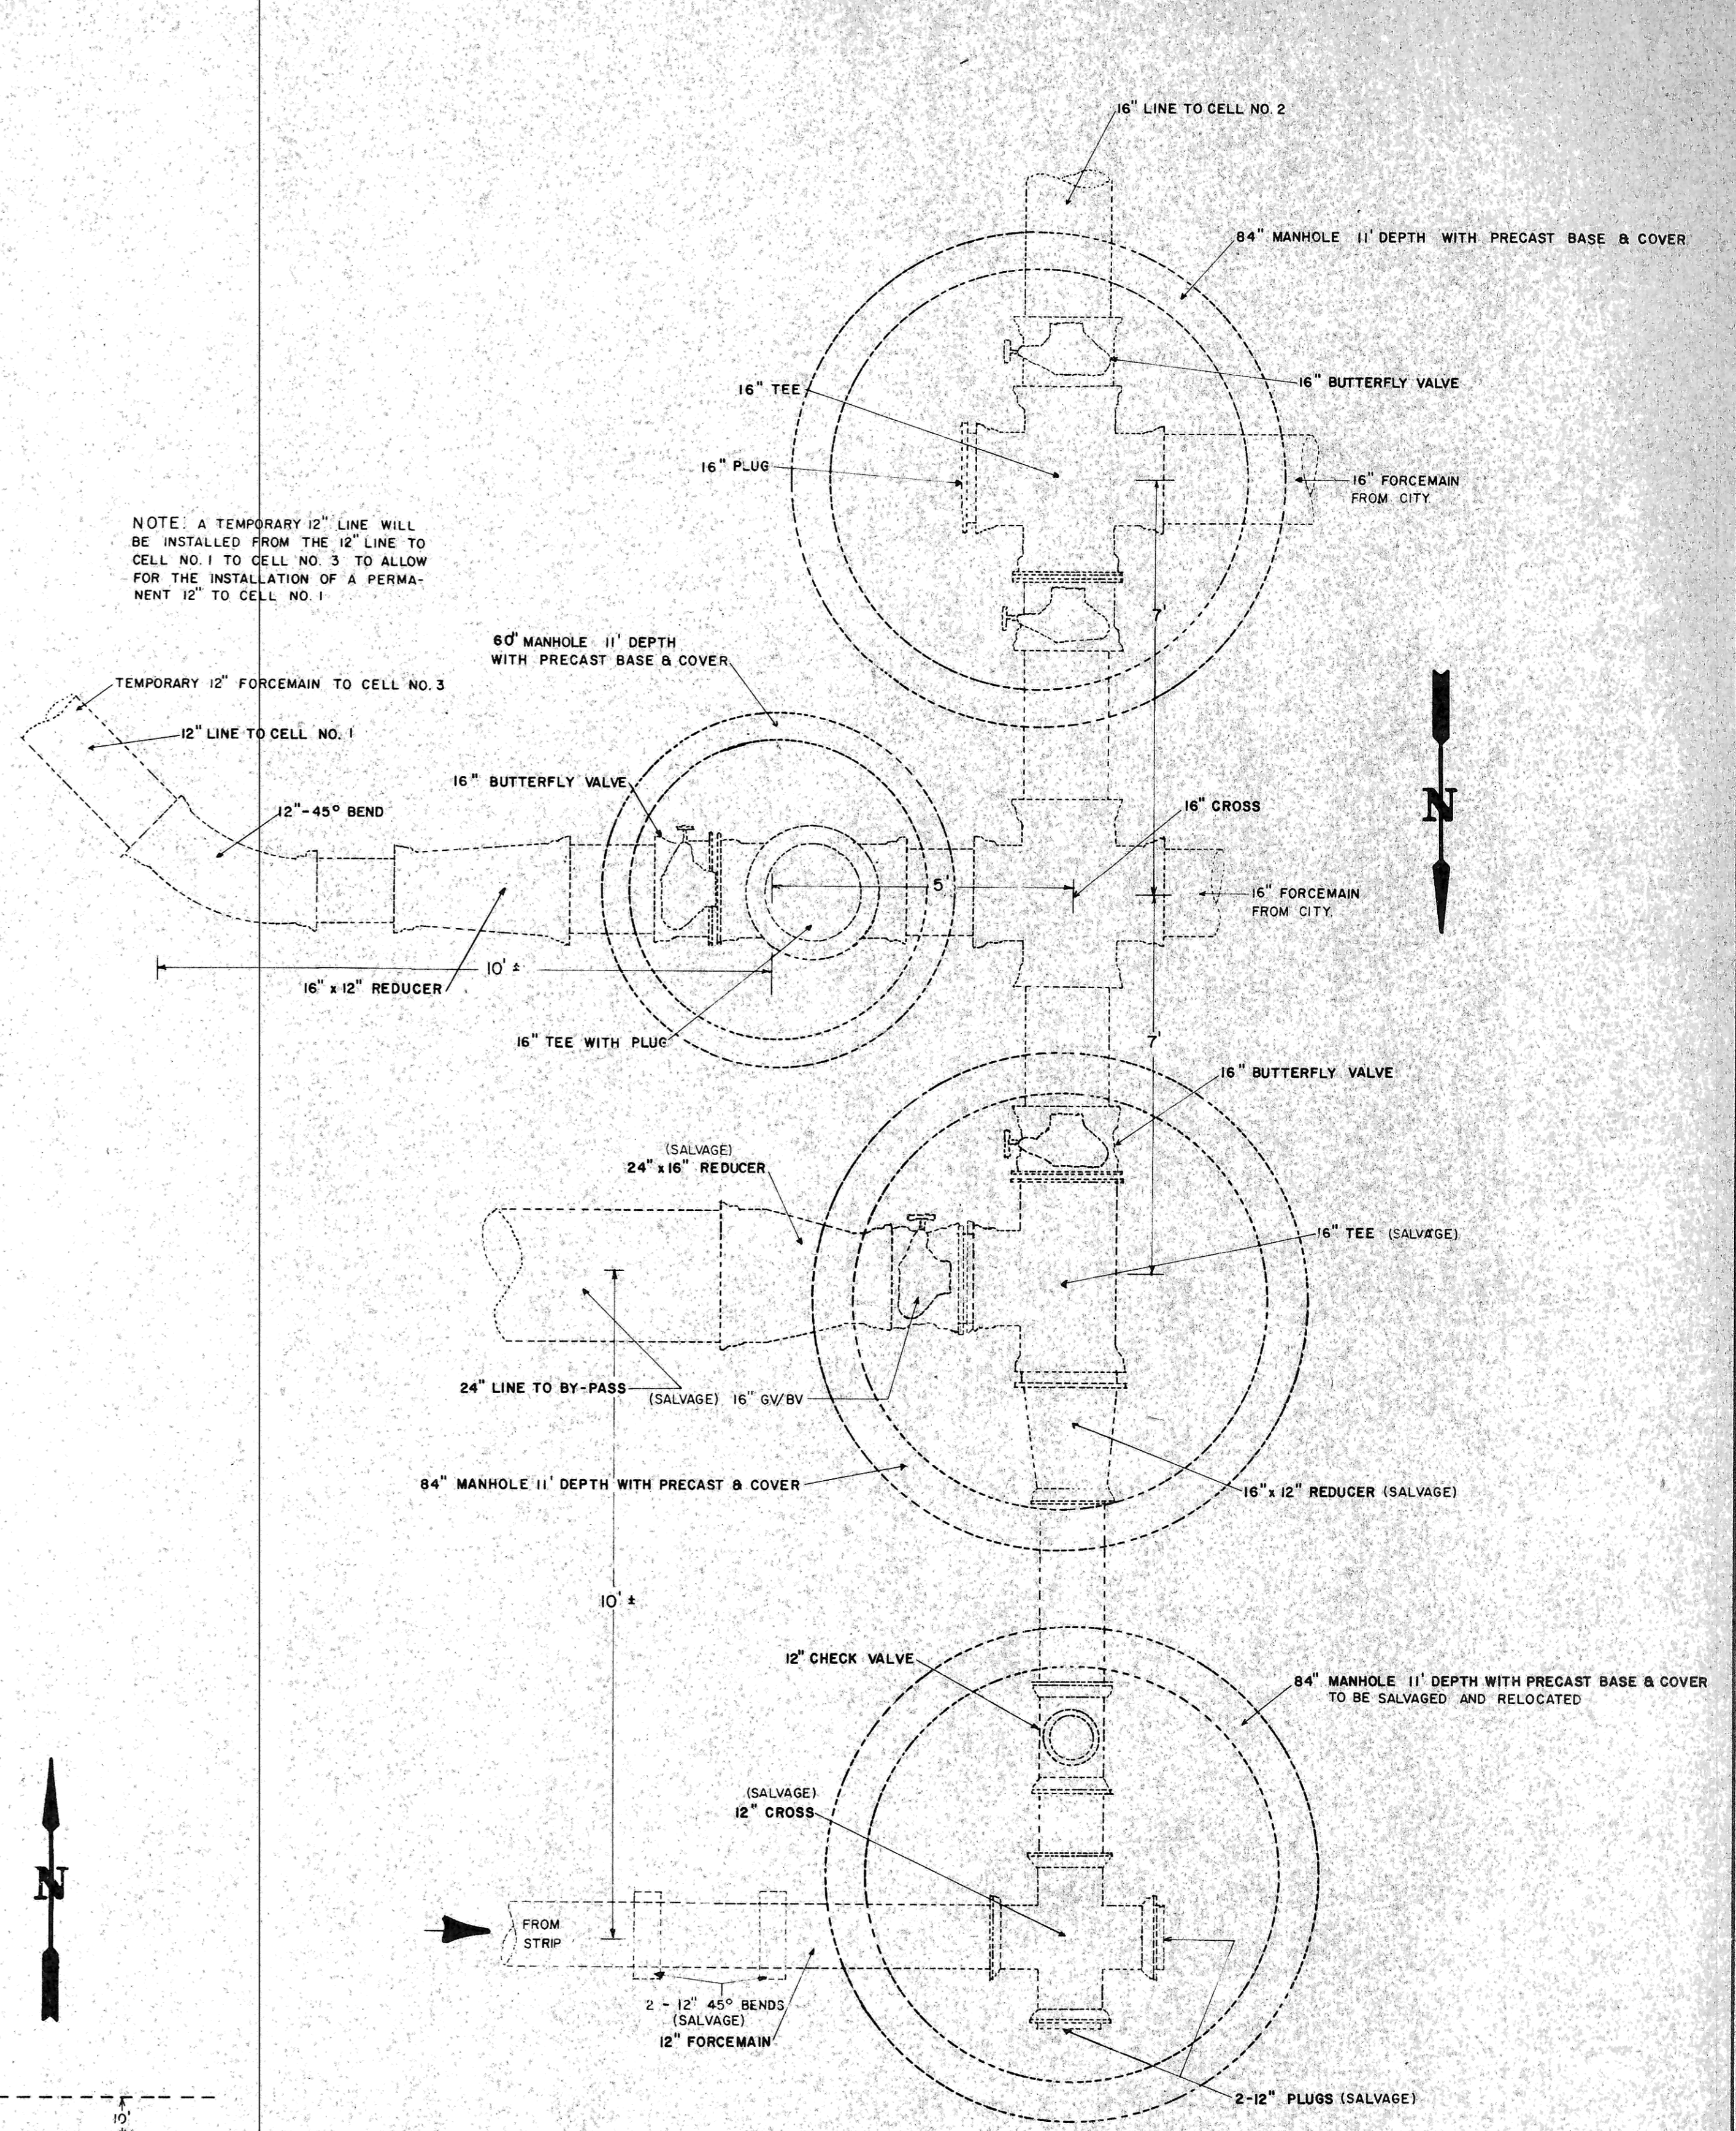

DETAIL SHOWING EXISTING MANHOLE LOCATIONS AT NORTHWEST CORNER OF CELL NO. 1

NO SCALE

JOB		UPGRADING WASTEWATER TREATMENT FACILITIES	
		INCREMENT NO. 1 E.P.A. NO. C380325-03	
		CONTRACTOR'S RECORD DRAWINGS (AS BUILT)	
FILE NO.	DATE:	SEPTEMBER 1976	
	REVISED:	MARCH, 1977	

SHEET NO. 20 OF 23 SHEETS

DRAWN BY: **RENOVATION OF MANHOLES AND FORCE MAINS** CHECKED BY:

REVISED APRIL 1977

Toman Engineering Company  
Civil & Environmental Consultants  
P. O. Box 708 P. O. Box 852  
Mandan, ND - Boissavain, Man RKO OEO