


AS BUILT WATER IMPROVEMENT PLANS RICKER'S SECOND SUBDIVISION MANDAN, NORTH DAKOTA

CITY PROJECT NUMBER: 98-8

INDEX OF DRAWINGS


SHEET NO.	TITLE
1	TITLE SHEET
2	PROJECT LAYOUT PLAN
3	PLAN & PROFILE - MCKENZIE DR & MARINA RD
4	PLAN & PROFILE - MARINA ROAD
5	DETAIL SHEET

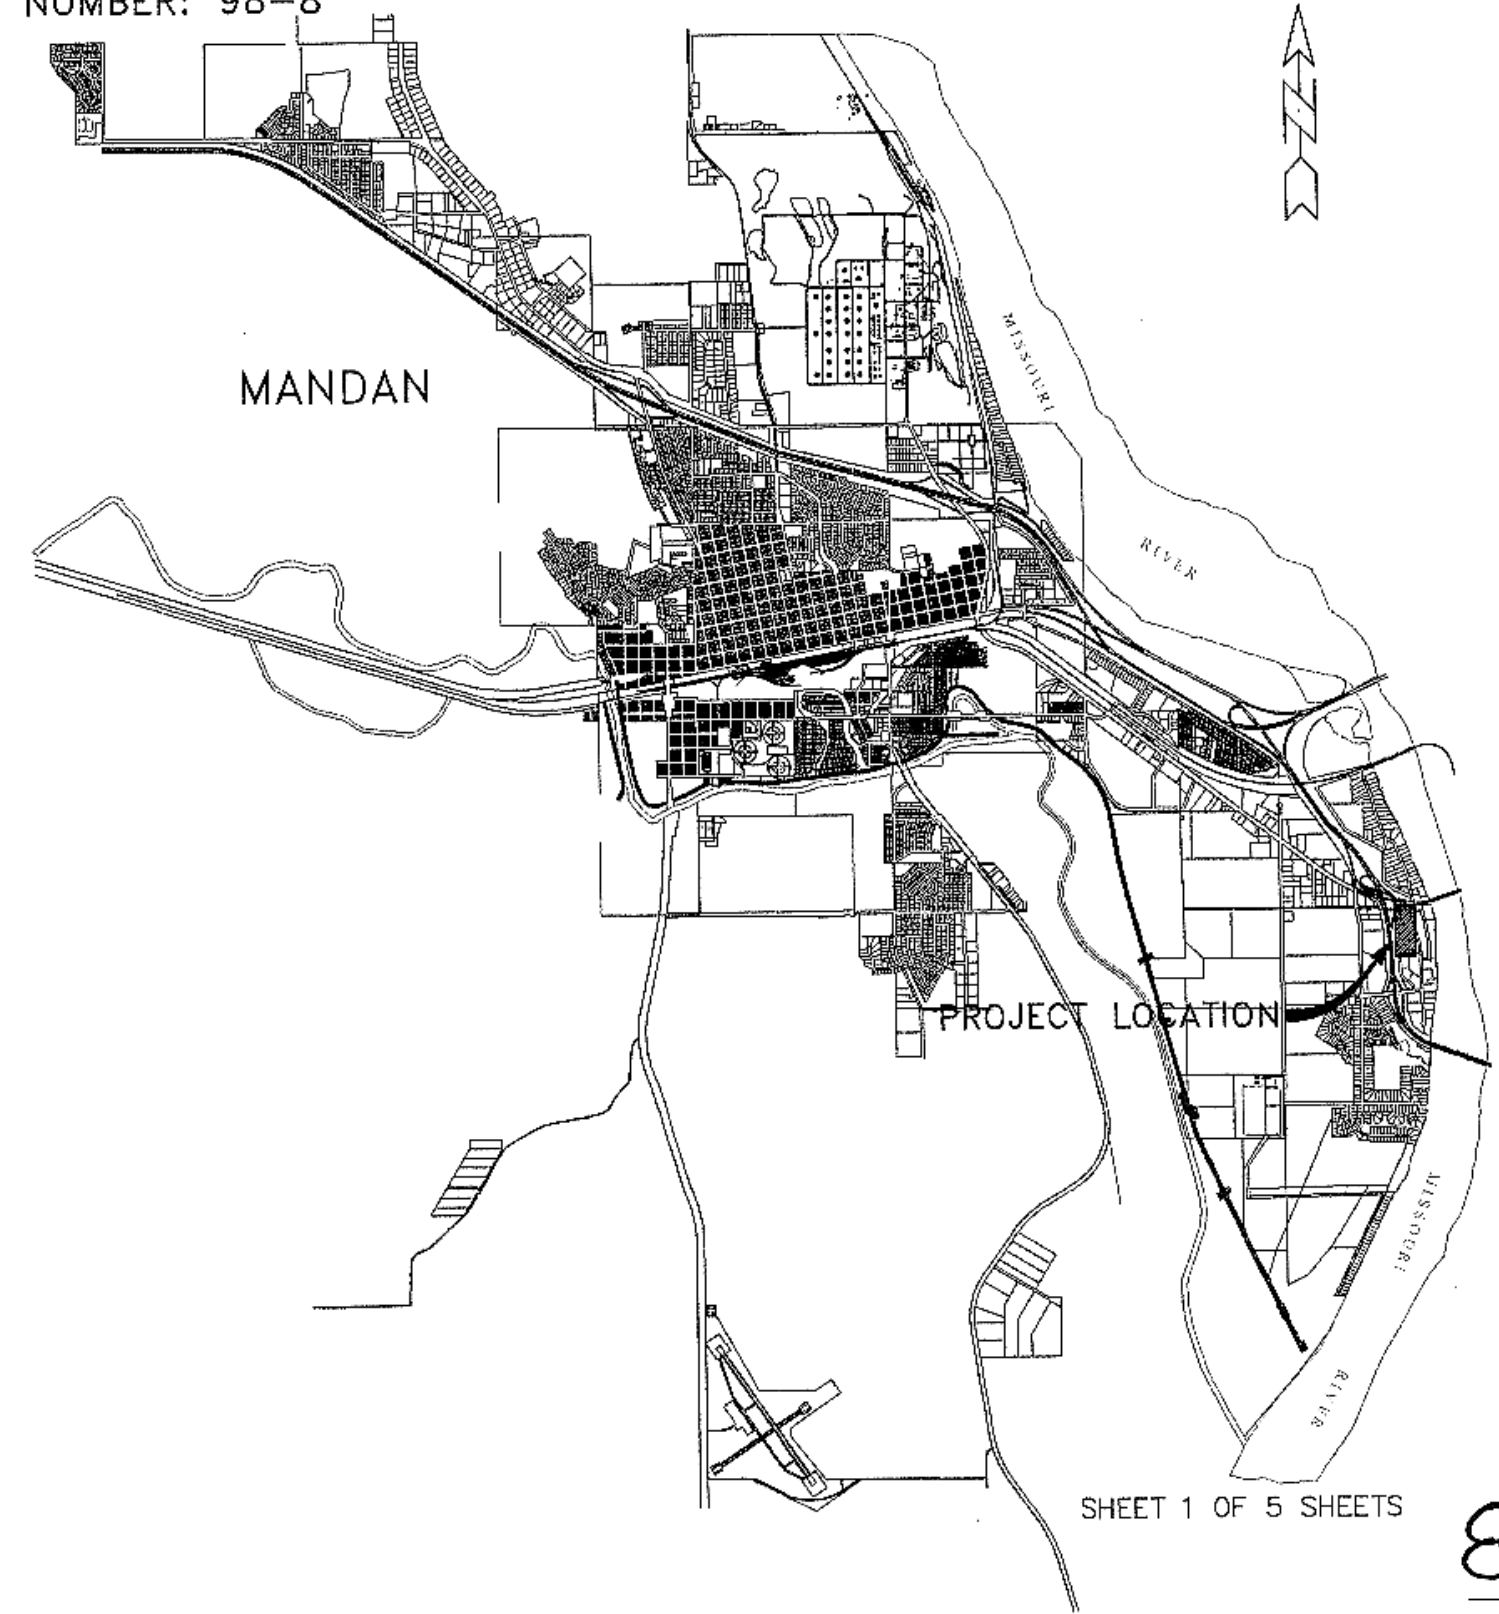

APPROVED: _____ DATE: _____
 THOMAS LITTLE, R.P.E. CITY ENGINEER, MANDAN, NORTH DAKOTA

PREPARED BY:
 TOMAN ENGINEERING

DATE: _____
 RONALD MANCHESTER R.P.E. 3252

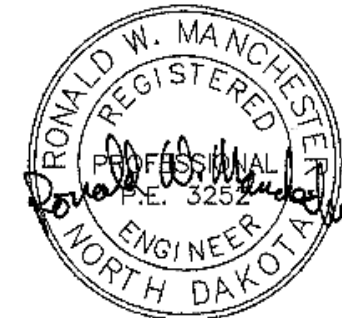

TOMAN ENGINEERING COMPANY
 CONSULTING CIVIL ENGINEERS
 905 2ND ST. N.W. • MANDAN, NORTH DAKOTA 58034 • 701-833-8433

SHEET 1 OF 5 SHEETS

8