BRIDGE CODE	R R BRIDGE NO	FED ROAD DIST NO	STATE PROJ NO	FISCAL YEAR	SHEET NO	TOTAL SHEETS
	199	8	N D MG-1-010 (05) 917		C3	

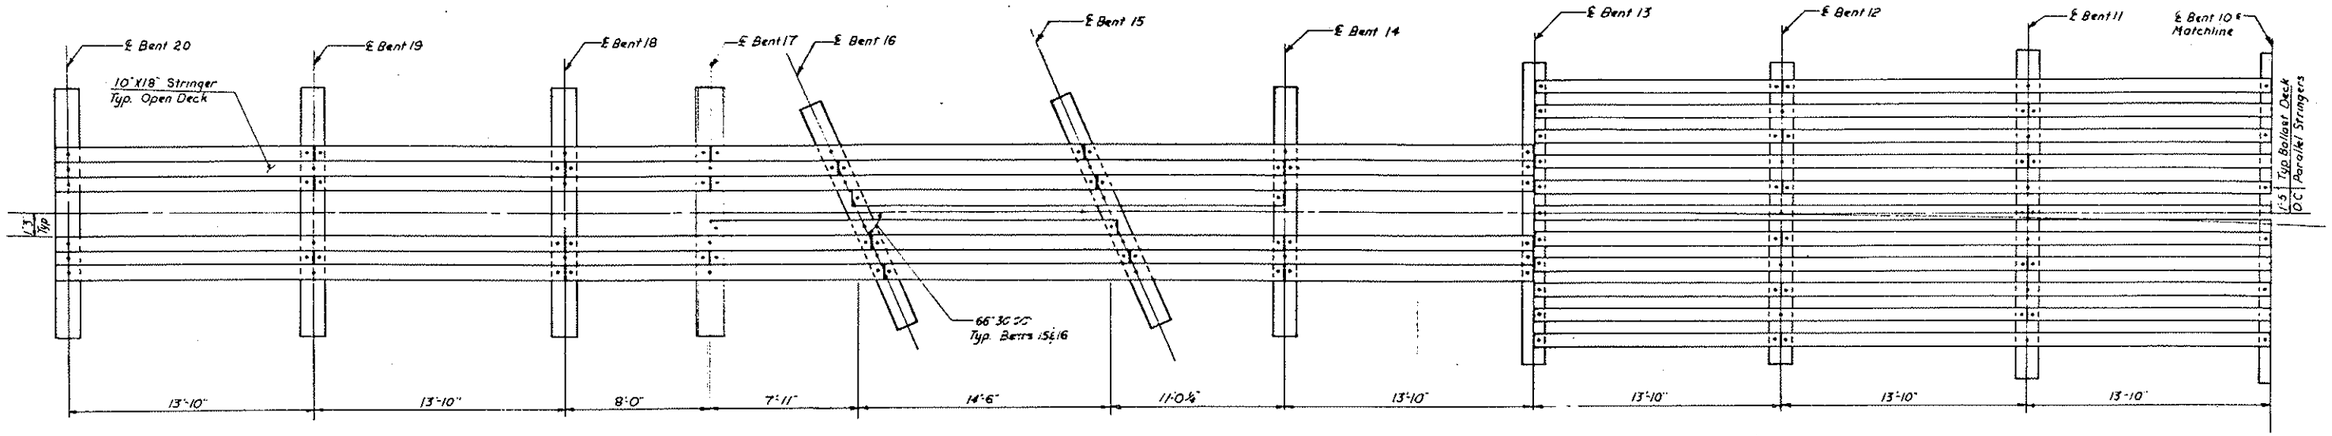

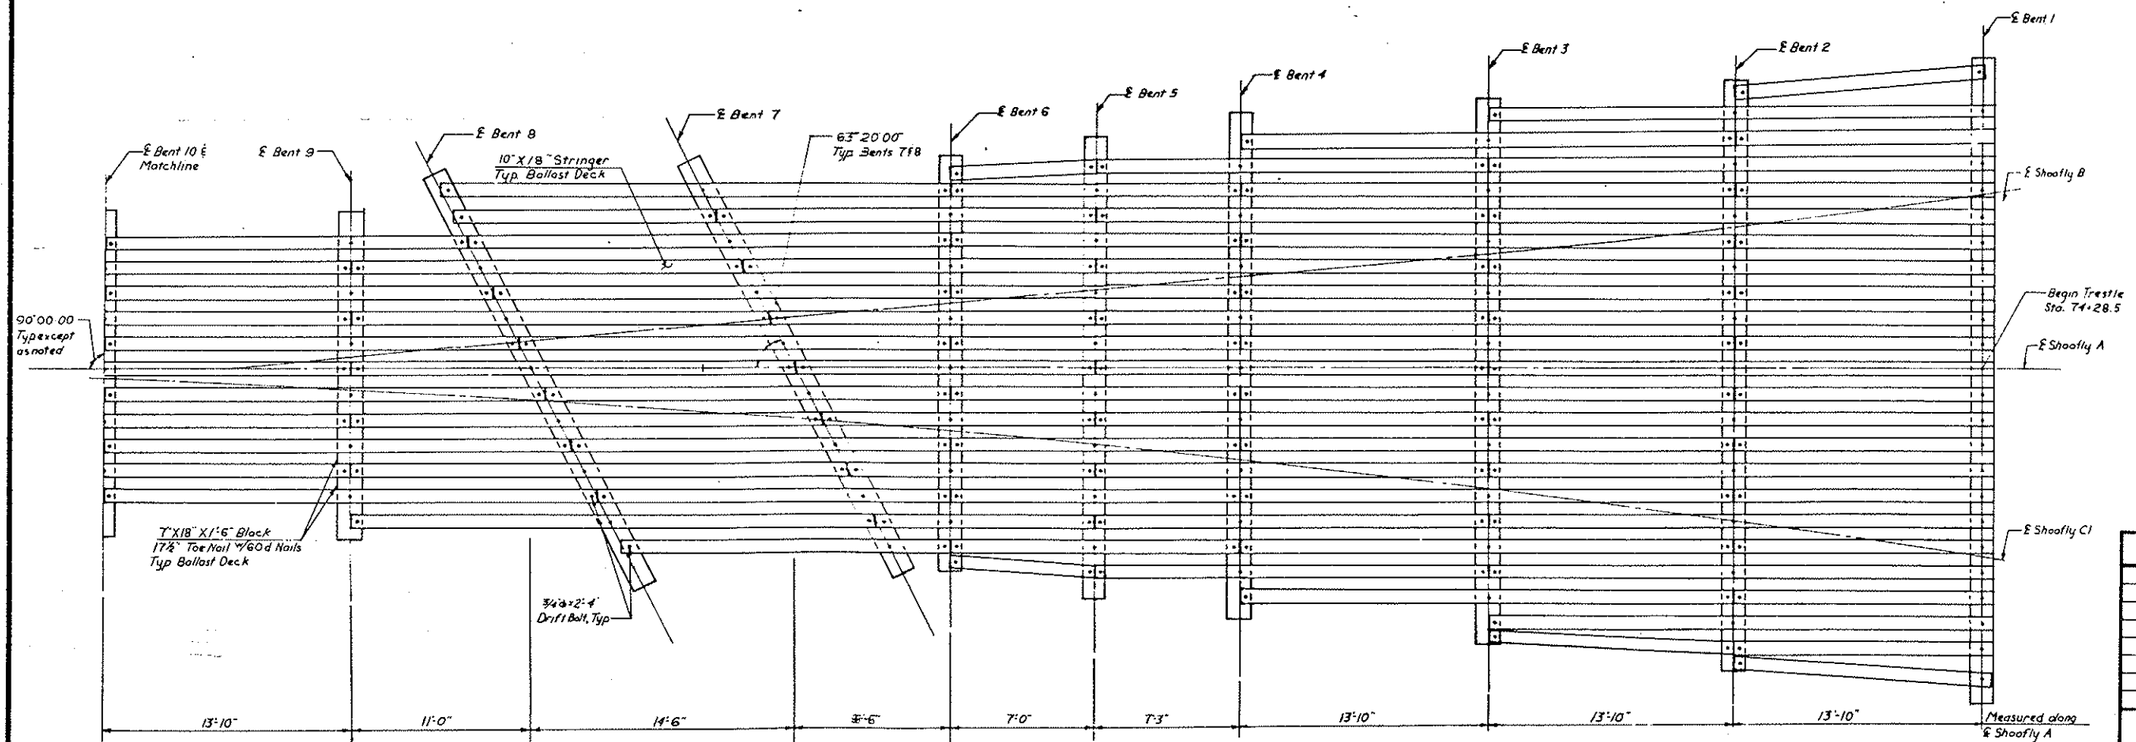

STRINGER PLAN
Scale 1/4" 1'-0"

Note:
Ballast Planking to be attached to stringers with 6" ø x 7" O.G. Spikes.
Stringer Splices to be alternated at bents.

QUANTITIES

STRINGER PLAN
TRESTLE
BURLINGTON NORTHERN, INC.
RAILWAY UNDERPASSES

U.S. HIGHWAY NO. 10
MORTON COUNTY

10-916.95-40