FED. ROAD DIST. NO.	STATE	PROJ. NO.	SHEET NO.	TOTAL SHEETS
8	N. D.	MG-1-0100(051)917	69	

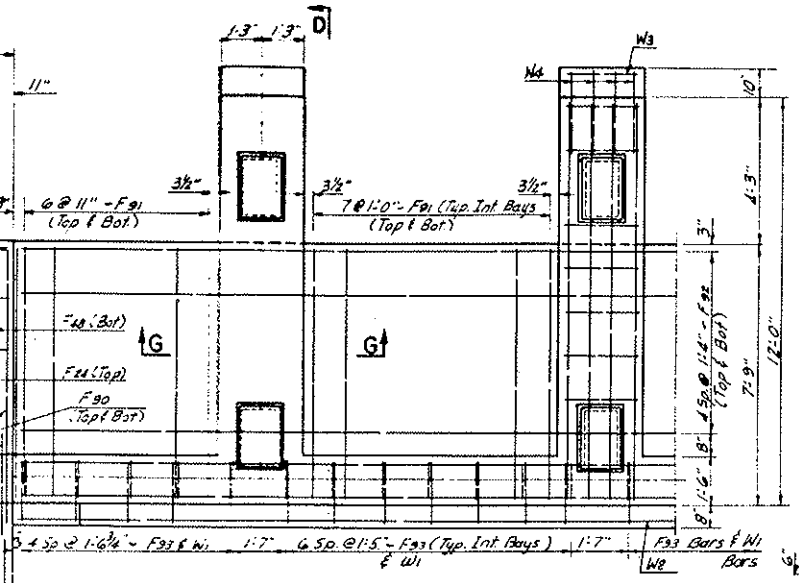

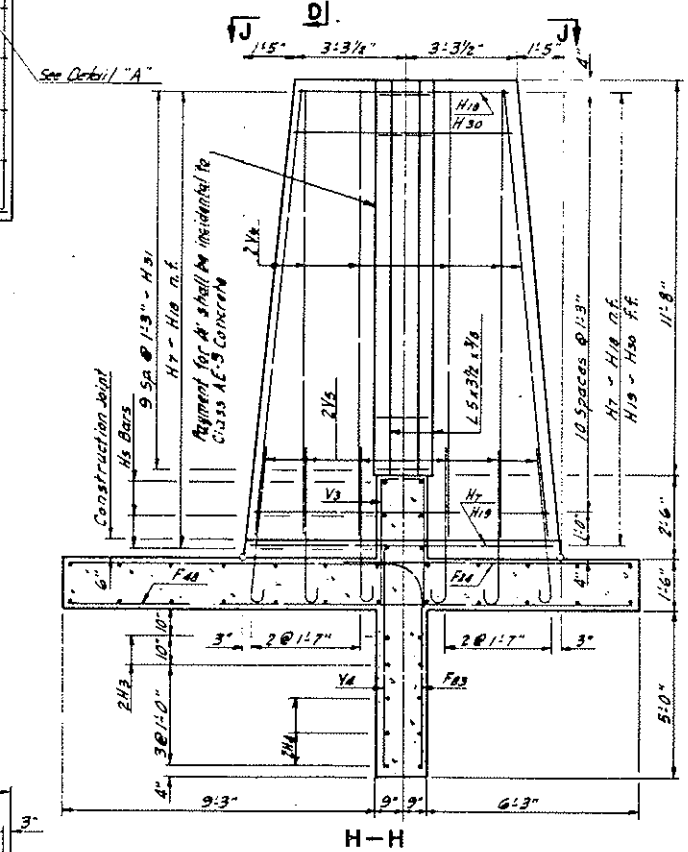

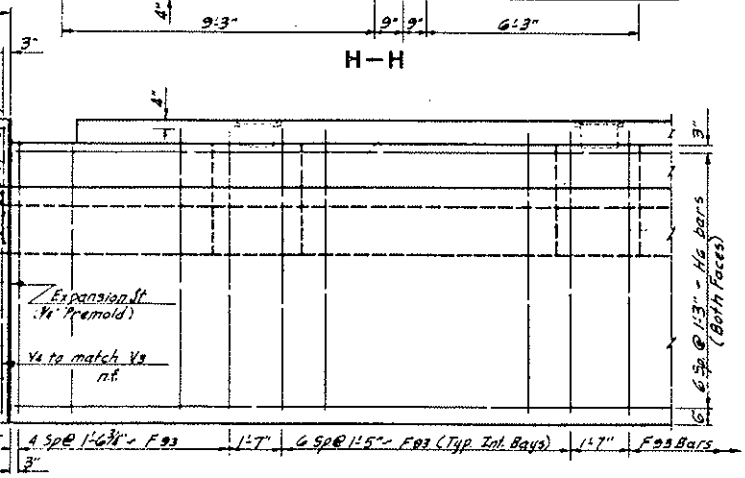

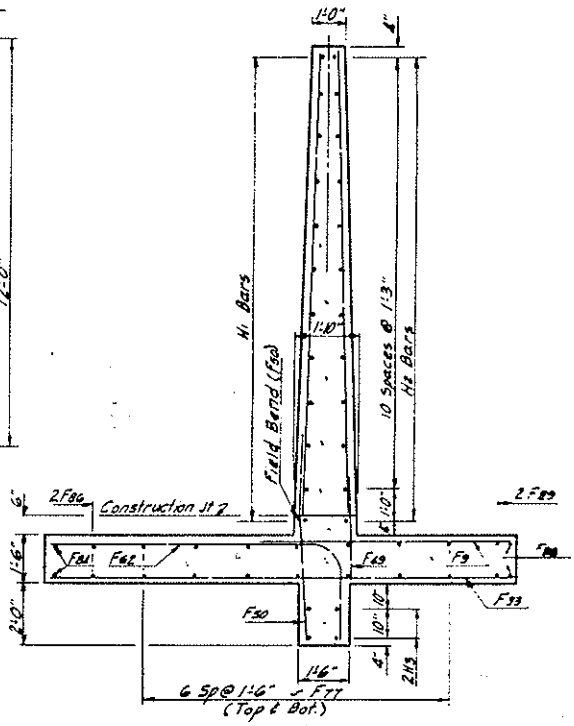

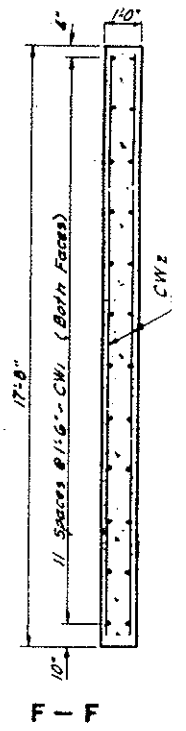

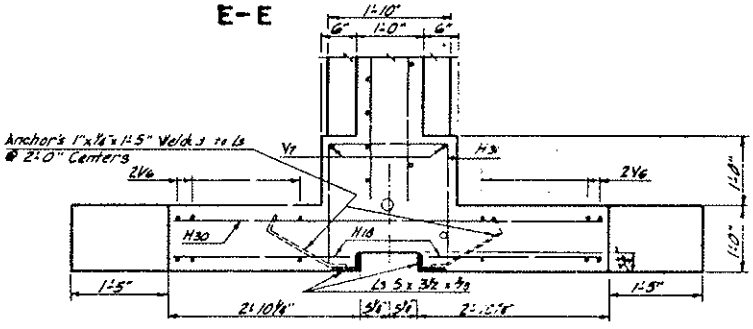

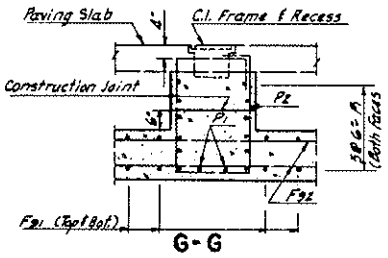

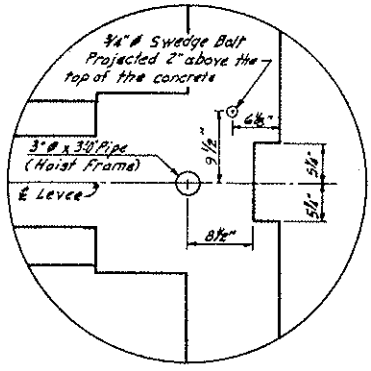

QUANTITIES

MANDAN

STOP-LOG

STRUCTURE

SL-2